


MARKED-UP DRAWING (NOT TO SCALE)

ENX. SK-030

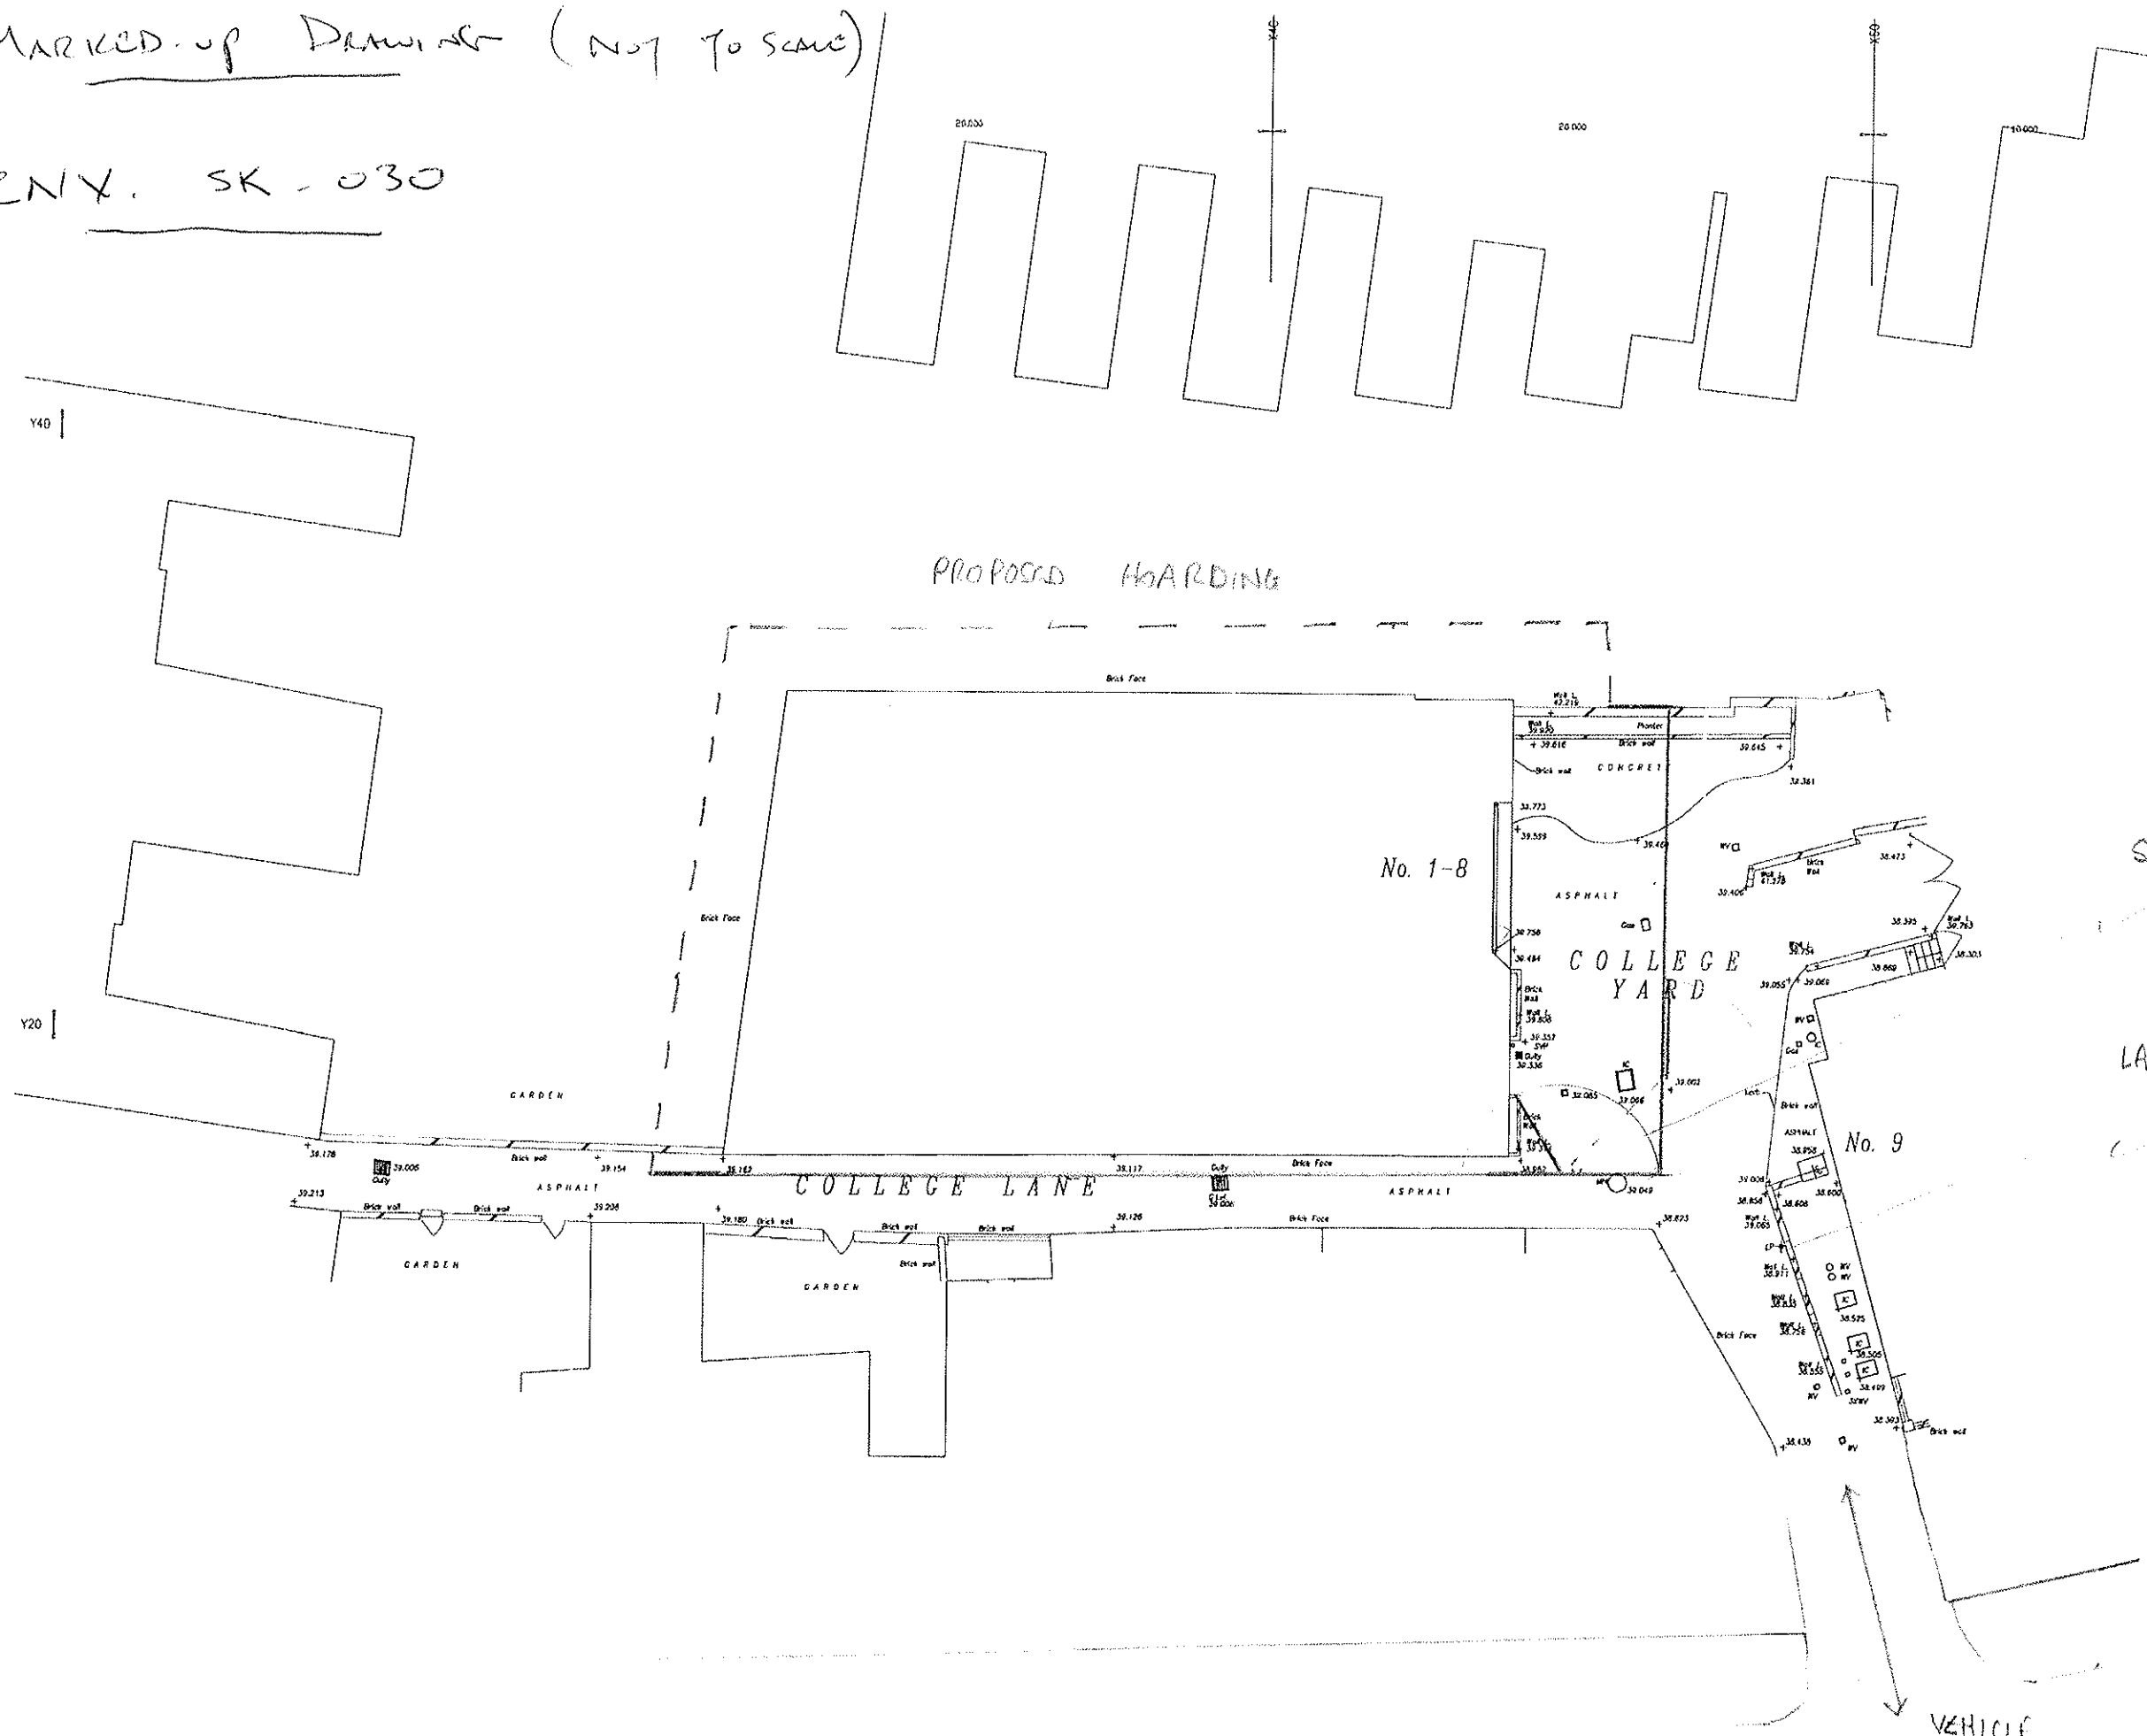

SITE ENTRANCE GATES

LAMP POST RE-POSITIONED

FOR PLANNING

BB PARTNERSHIP LTD
CHARTERED ARCHITECTS
THE PARTNERSHIP, 17 BEDFORD STREET, LONDON WC1R 4EJ
TEL: 020 7336 8555 FAX: 020 7336 8777
e-mail: architect@bbpartnership.co.uk

client	MRS S FADRE
project	1 - 8 COLLEGE YARD LONDON TMS
drawing	MARKED-UP SITE PLAN
date	June 08
scale	NTS
drawn by	st
checked by	rev
ENX SK-030	

do not scale - check all dimensions on site
© 2008 BB PARTNERSHIP LIMITED
ALL RIGHTS RESERVED