



HB MARK UP 28.09.09

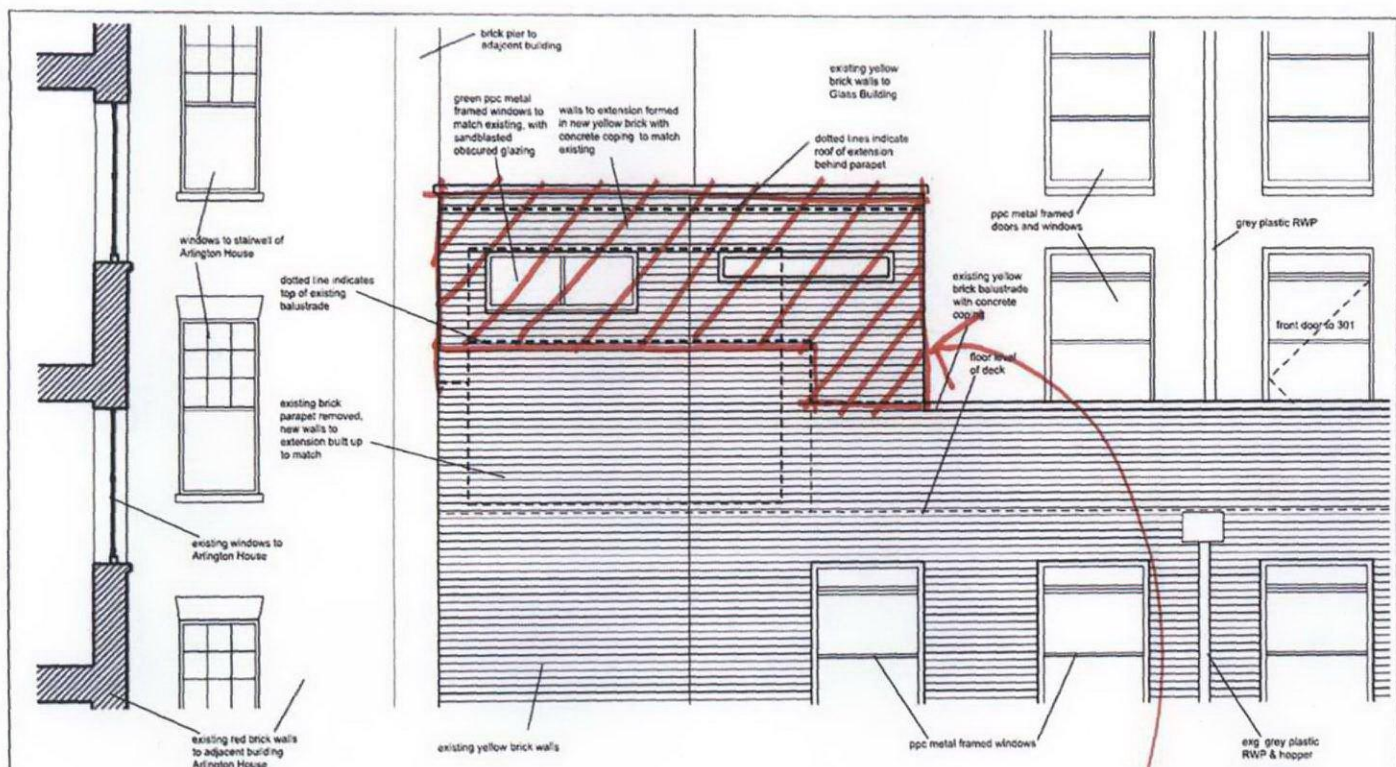

Elevation CC - SKETCH OPTION WITH WINDOW

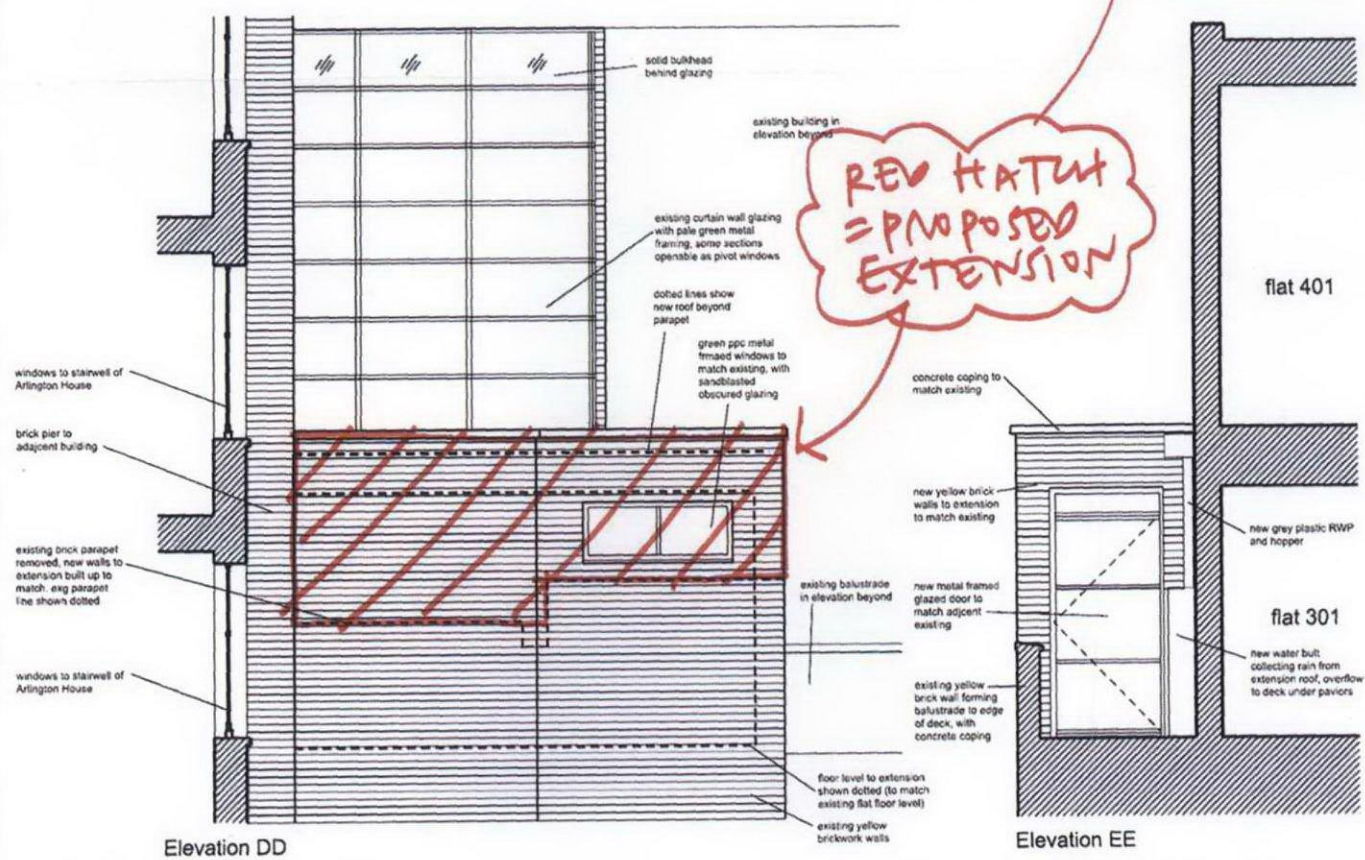

Elevation DD

Elevation EE

NOTE: FOR PLANNING AND COSTING PURPOSES ONLY, DO NOT SCALE

HUGO BRADDICK

07855 447 518

hugobraddick@meadowcroftgriffin.co.uk

REV	DATE	NOTES
A	09.01.09	survey notes amended
B	30.01.09	window added to rear elev

DRAWING TITLE	Proposed Sections / Elevations - Sheet 2		
DRAWING NO./REV	0801 - 06B	DATE	Dec 2008
DRAWING STATUS	Preliminary	SCALE	1:50 @ A3
PROJECT/CLIENT	Atkinson Residence, 301 Glass Building		

RECEIVED 28 SEP 2009