


HB MARK UP 28.09.09

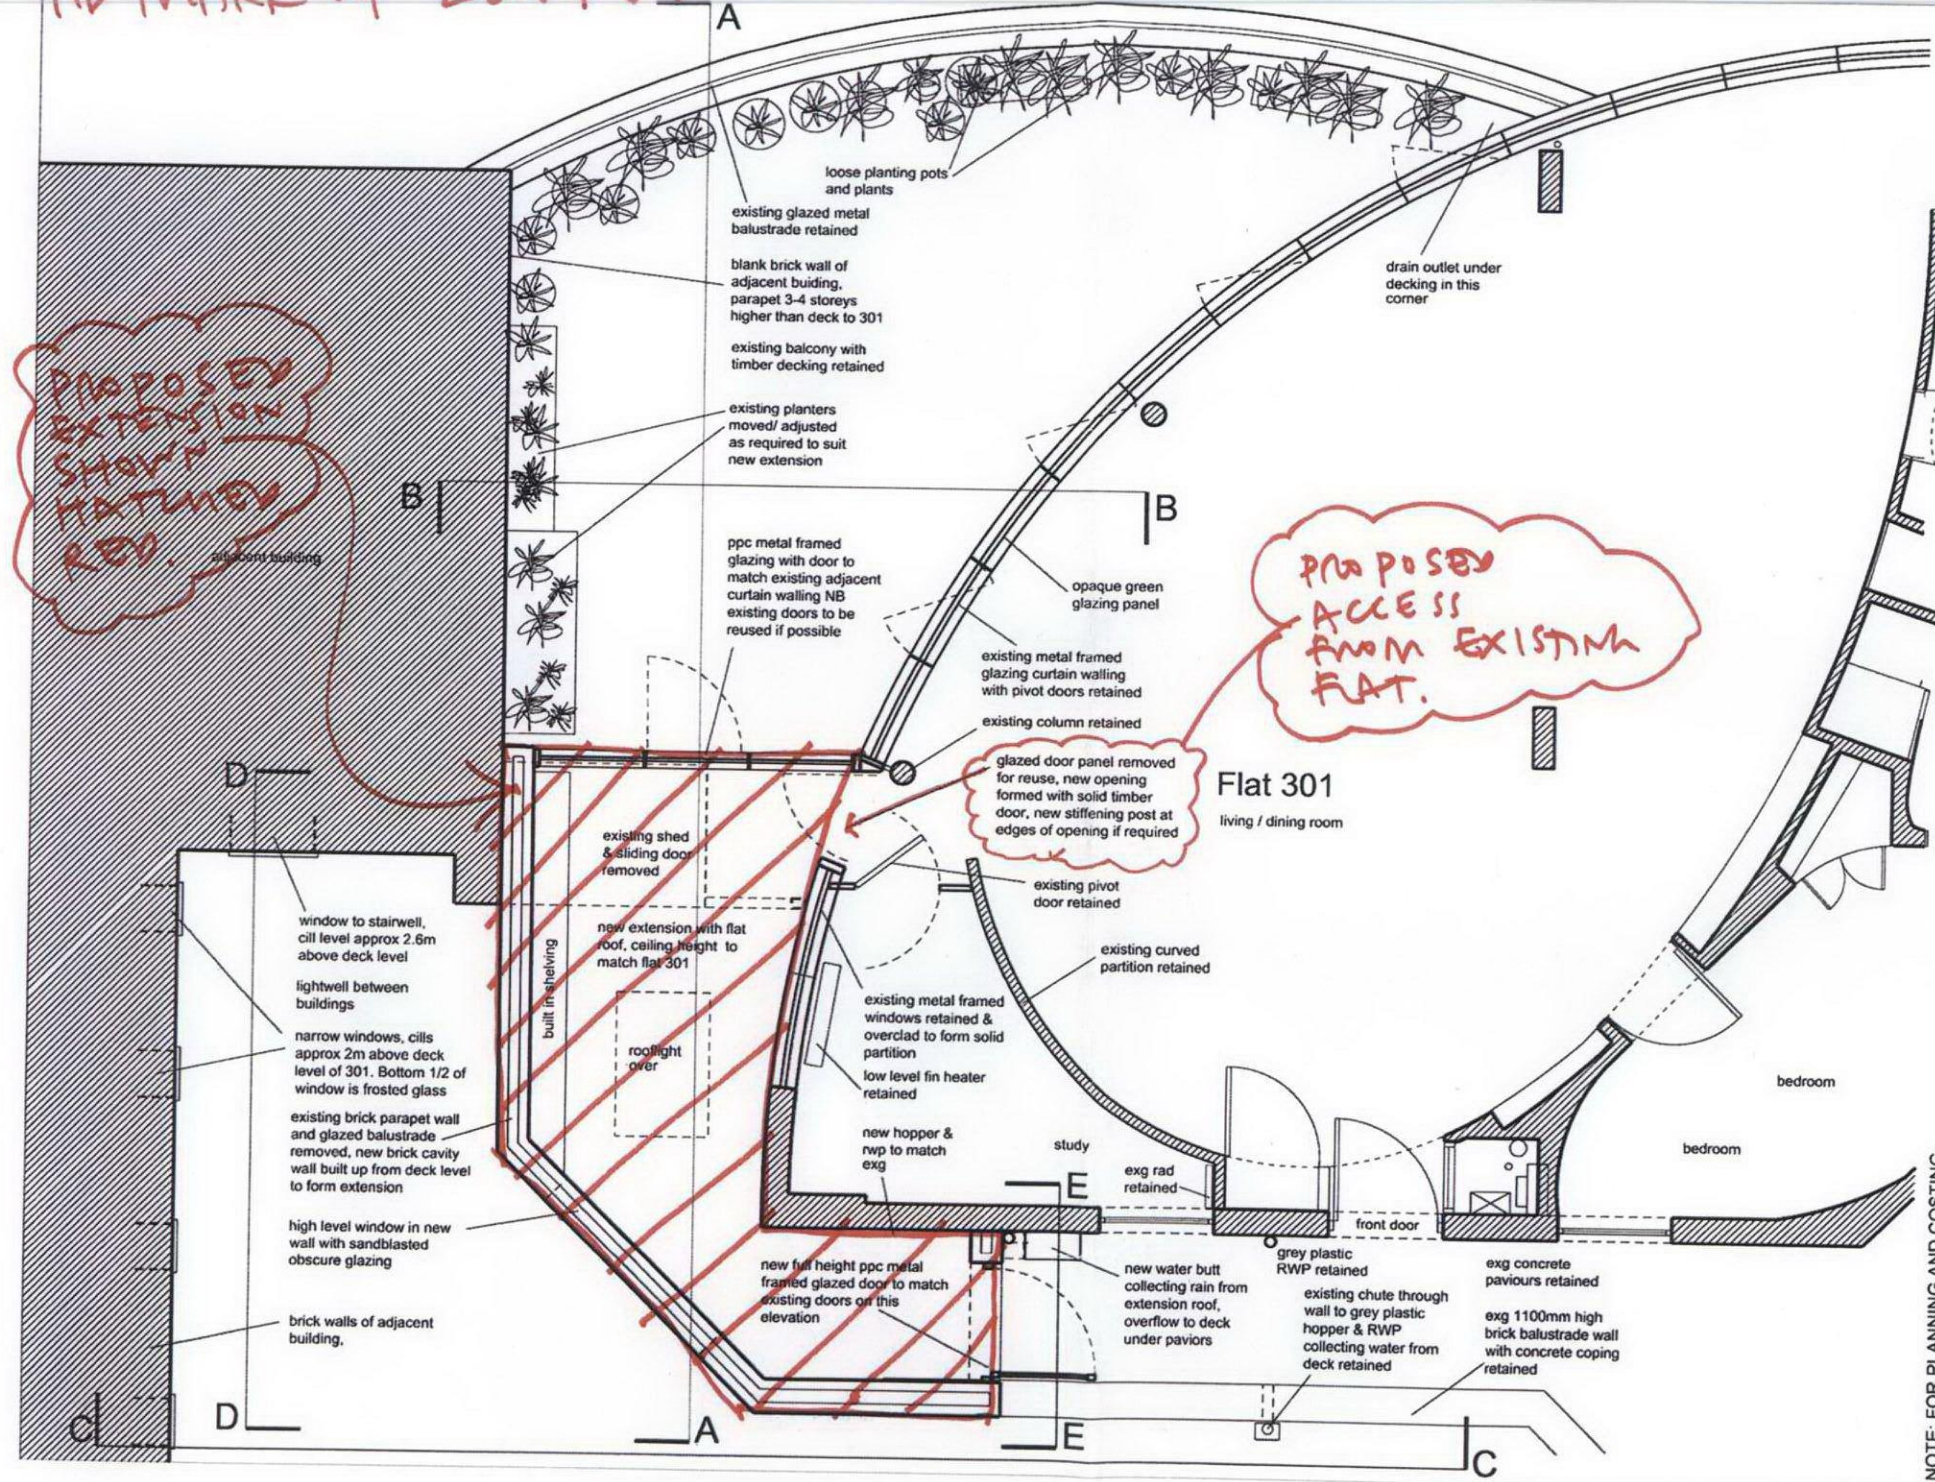

NOTE: FOR PLANNING AND COSTING PURPOSES ONLY, DO NOT SCALE

HUGO BRADDICK m 07855 447 518 e hugobradddick@meadowcroftgriffin.co.uk	REV	DATE	NOTES
	A	09.01.07	notes amended, side wall adjusted
	DRAWING TITLE	Proposed Plan	
	DRAWING NO./REV	0801 - 04A	DATE Dec 2008
PROJECT/CLIENT		DRAWING STATUS	SCALE
Atkinson Residence, 301 Glass Building		Preliminary	1:50 @ A3

RECEIVED 28 SEP 2009

Super