



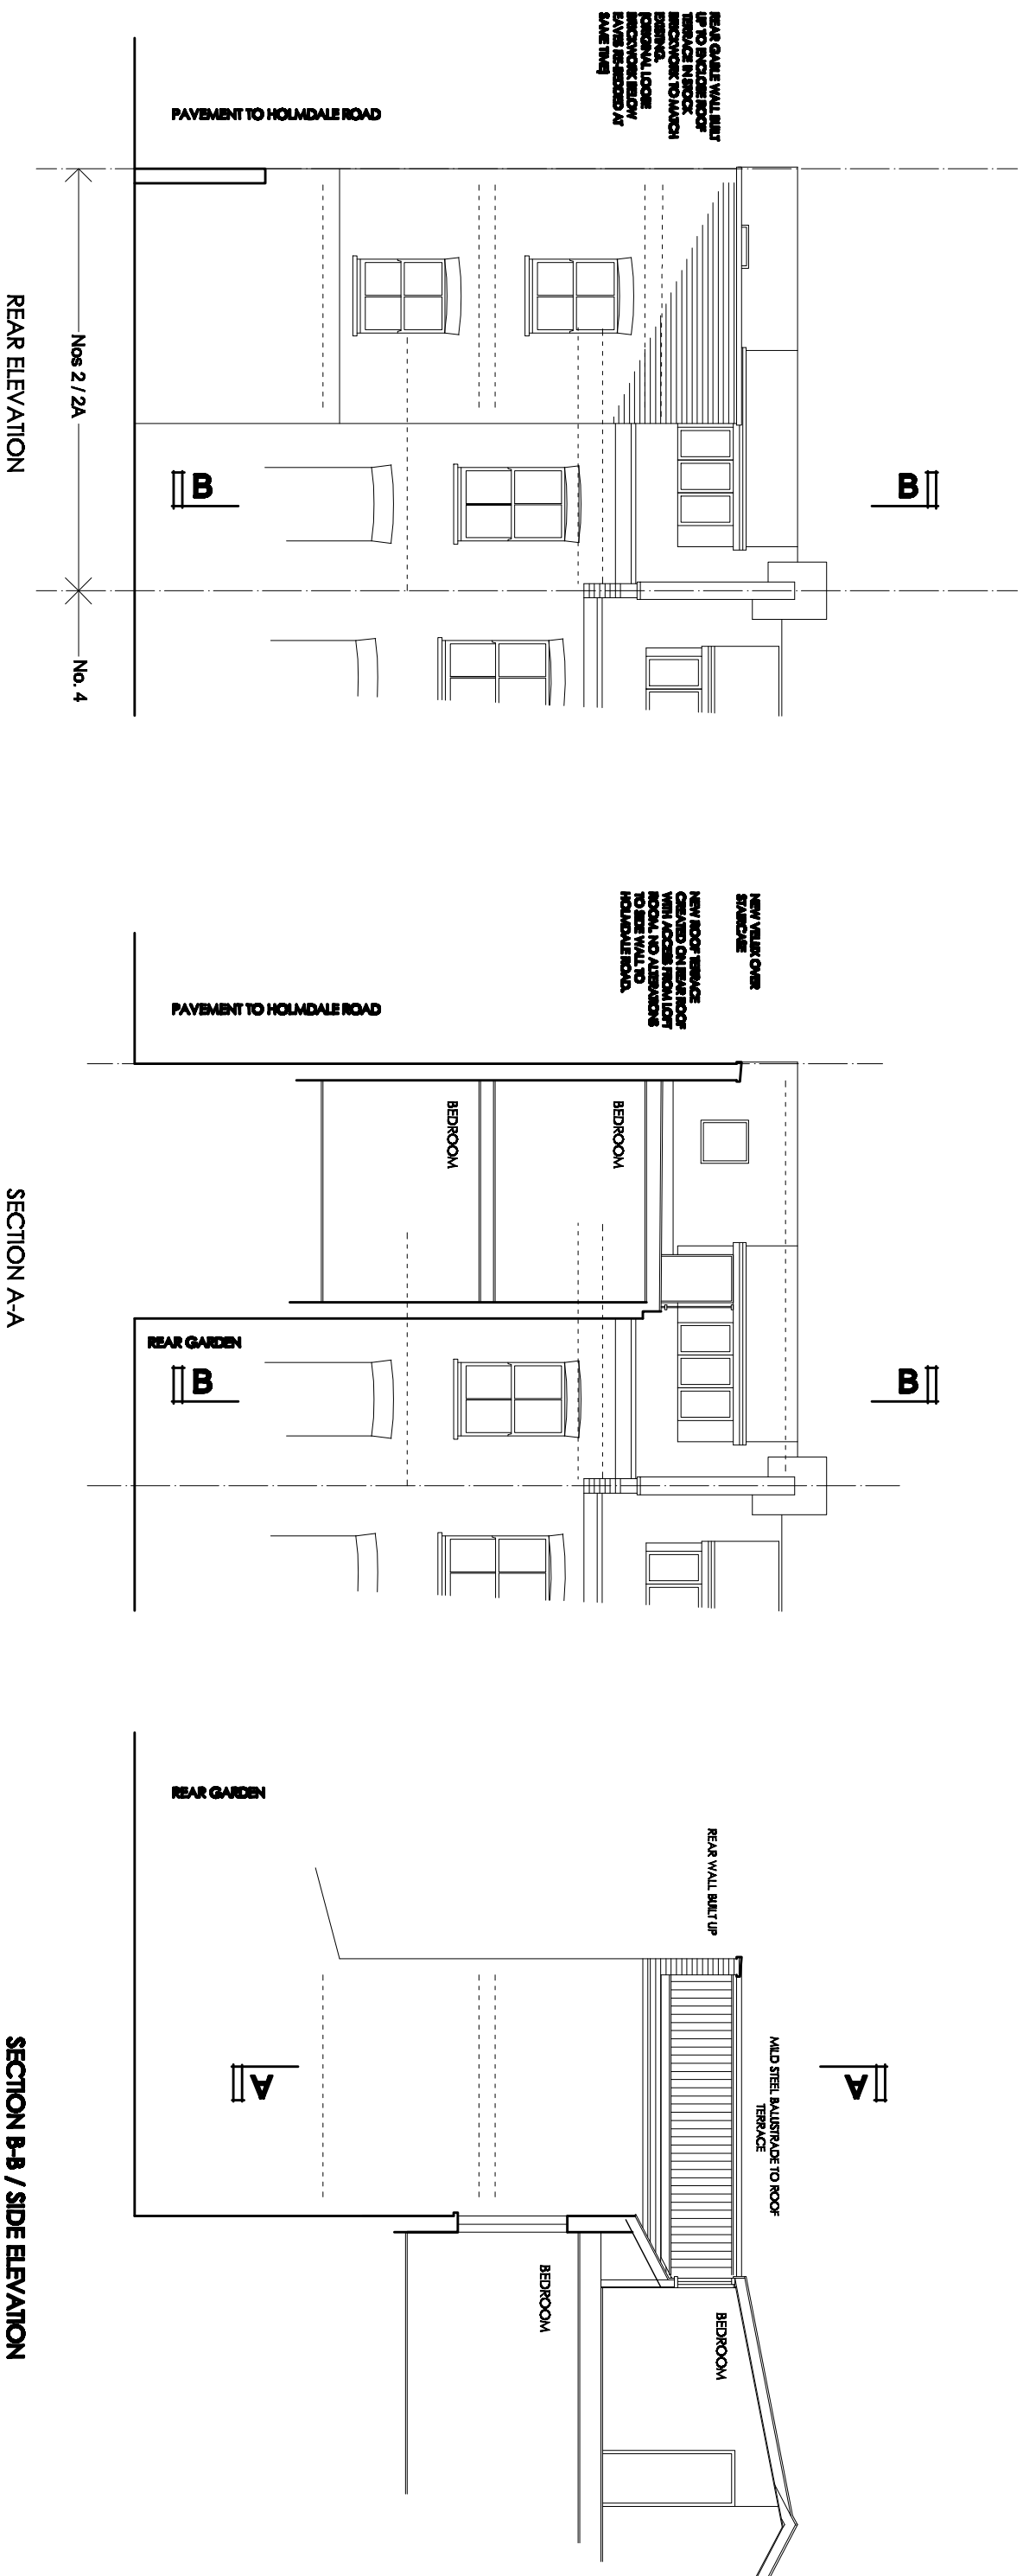

# ASBUILT

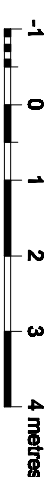

| REVISIONS |      |        |
|-----------|------|--------|
| Rev       | Date | Detail |
| -         | -    | -      |

| NOTES                                                                            |  |
|----------------------------------------------------------------------------------|--|
| 1. ALL DIMENSIONS TO BE CONFIRMED ON SITE                                        |  |
| 2. DRAWINGS TO BE READ IN CONJUNCTION WITH SPECIFICATION AND ENGINEERS DRAWINGS. |  |

| TITLE:                                                         |  |
|----------------------------------------------------------------|--|
| PROPOSED REFURBISHMENT<br>2A PANDORA ROAD<br>LONDON<br>NW6 1TT |  |

| DRAWING:                          |  |
|-----------------------------------|--|
| ELEVATIONS / SECTIONS<br>AS BUILT |  |

| DATE:      |    |
|------------|----|
| 01-05-2009 | SK |

| SCALE:     |   |
|------------|---|
| 1:100 (A3) | - |

| DRAWING NO.: |  |
|--------------|--|
| PA2 - 012    |  |