


A	01/05/09	LOCATION OF UNITS REVISED TO SUIT AS BUILT CONDITION
REV	DATE	AMENDMENT



TITLE
8 Southampton Place
London

LOGO

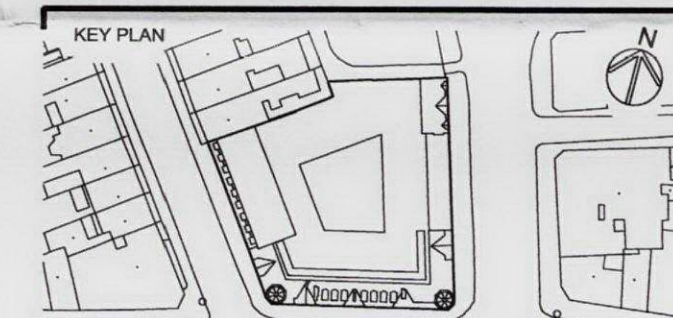

LOCATION: 77 PARKWAY · CAMDEN TOWN · LONDON · NW1 7PU
PHONE: +44 0 20 7504 1700 FAX: +44 0 20 7504 1701
WEBSITE: www.sheppardrobson.com E-MAIL: sr.mail@sheppardrobson.com

DRAWING
8 SOUTHAMPTON PLACE
PROPOSED ROOF PLAN

SCALE @ A1	DATE	ORIGINATOR	CHECKED	AUTHORISED
1: 25	30. 05. 2008	CP	BK	BK

STATUS
INFORMATION

DRAWING NO.	REV
2047 - SK- 559	A

