

NOTES:

1. Use figured dimensions only. Do not scale.
2. Contractors to notify architect immediately of any dimensional discrepancy.

Revisions:

- / - 09.08 - Submitted as part of an Application for Planning Permission
- A - 11.08 - Size of dormer in North- West facing roof slope amended to reflect original size

drawing status:	PLANNING		
job title:	52 Fortune Green Road London, NW3 1UJ		
client:	Michel Dadoun		
drg. title:	ROOF PLAN Existing Layout		
drawn:	audited:	date:	scale:
/	/	09/08	1:50 / A3
job No:	drg. No:	rev:	
0091	PL 05	A	

RECEIVED  
14 NOV 2008

NOTES:

- 1. Use figured dimensions only. Do not scale.
- 2. Contractors to notify architect immediately of any dimensional discrepancy.

Revisions:


- / - 09.08 - Submitted as part of an Application for Planning Permission
- A - 11.08 - Existing dormer shown



SURVEY INFORMATION NOT AVAILIABLE

SURVEY INFORMATION NOT AVAILIABLE, PHOTOGRAPHIC SURVEY ONLY PLEASE SEE DRAWING PL 07

drawing status:			
PLANNING			
job title:			
52 Fortune Green Road London, NW3 1UJ			
client:			
Michel Dadoun			
drg. title:			
REAR ELEVATION Existing Layout			
drawn:	audited:	date:	scale:
/	/	09/08	1:50 / A3
job No:	drg. No:	rev:	
0091	PL 06	A	

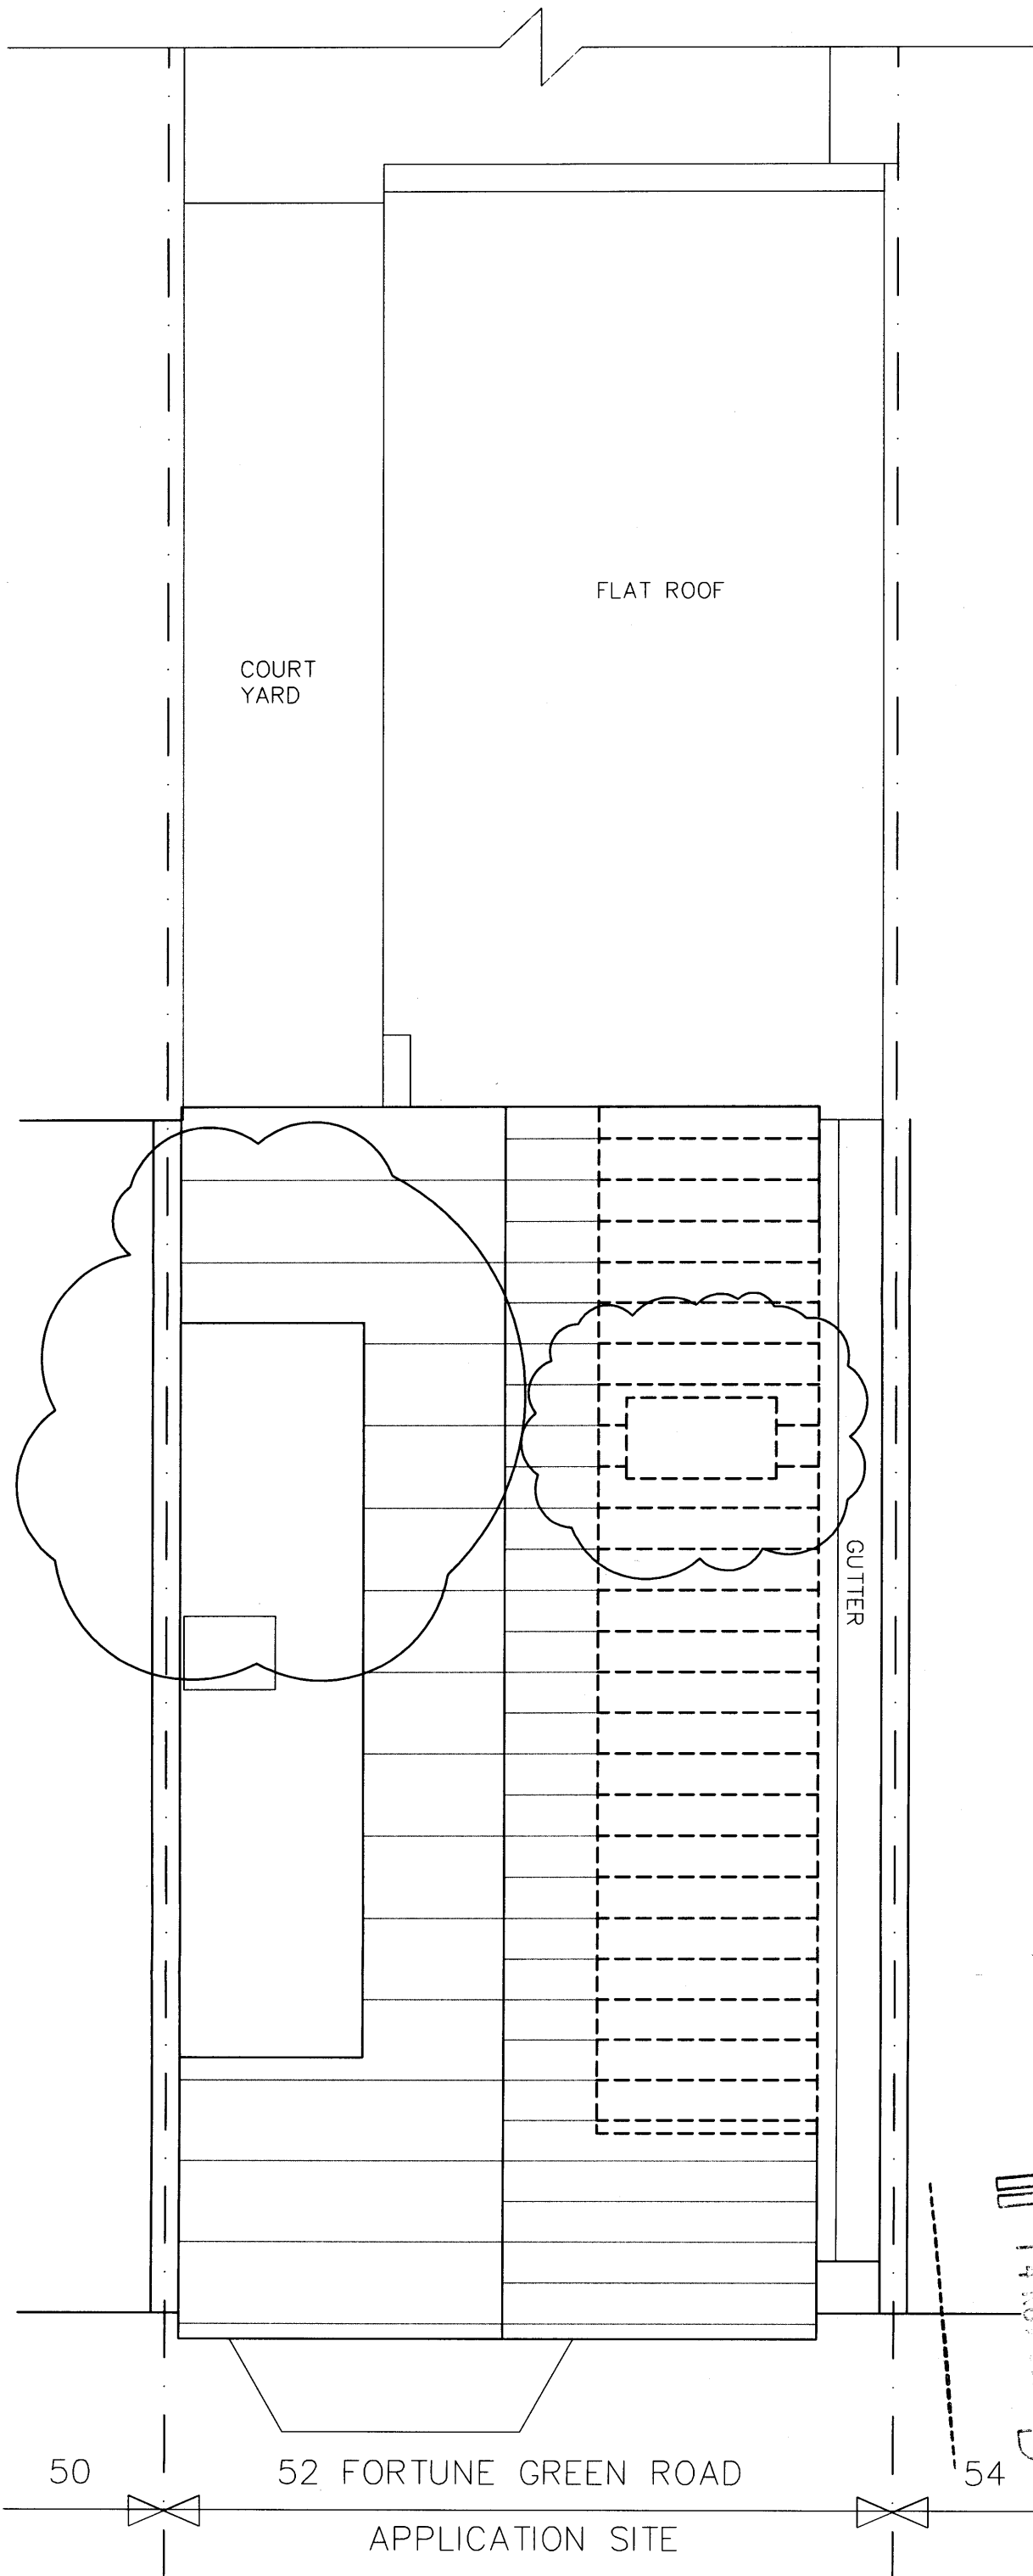

**NOTES:**


1. Use figured dimensions only. Do not scale.
2. Contractors to notify architect immediately of any dimensional discrepancy.

**Revisions:**

- / - 09.08 - Submitted as part of an Application for Planning Permission
- A - 11.08 - Existing dormer shown  
- Size of dormer in North- West facing roof slope amended to reflect original size

--- TO BE DEMOLISHED

drawing status:			
<b>PLANNING</b>			
job title:			
<b>52 Fortune Green Road</b>			
London, NW3 1UJ			
client:			
Michel Dadoun			
drg. title:			
<b>ROOF PLAN</b>			
<b>Demolition Plan</b>			
drawn:	audited:	date:	scale:
/	/	09/08	1:50 / A3
job No:	drg. No:	rev:	
<b>0091</b>	<b>PL 12</b>	<b>A</b>	

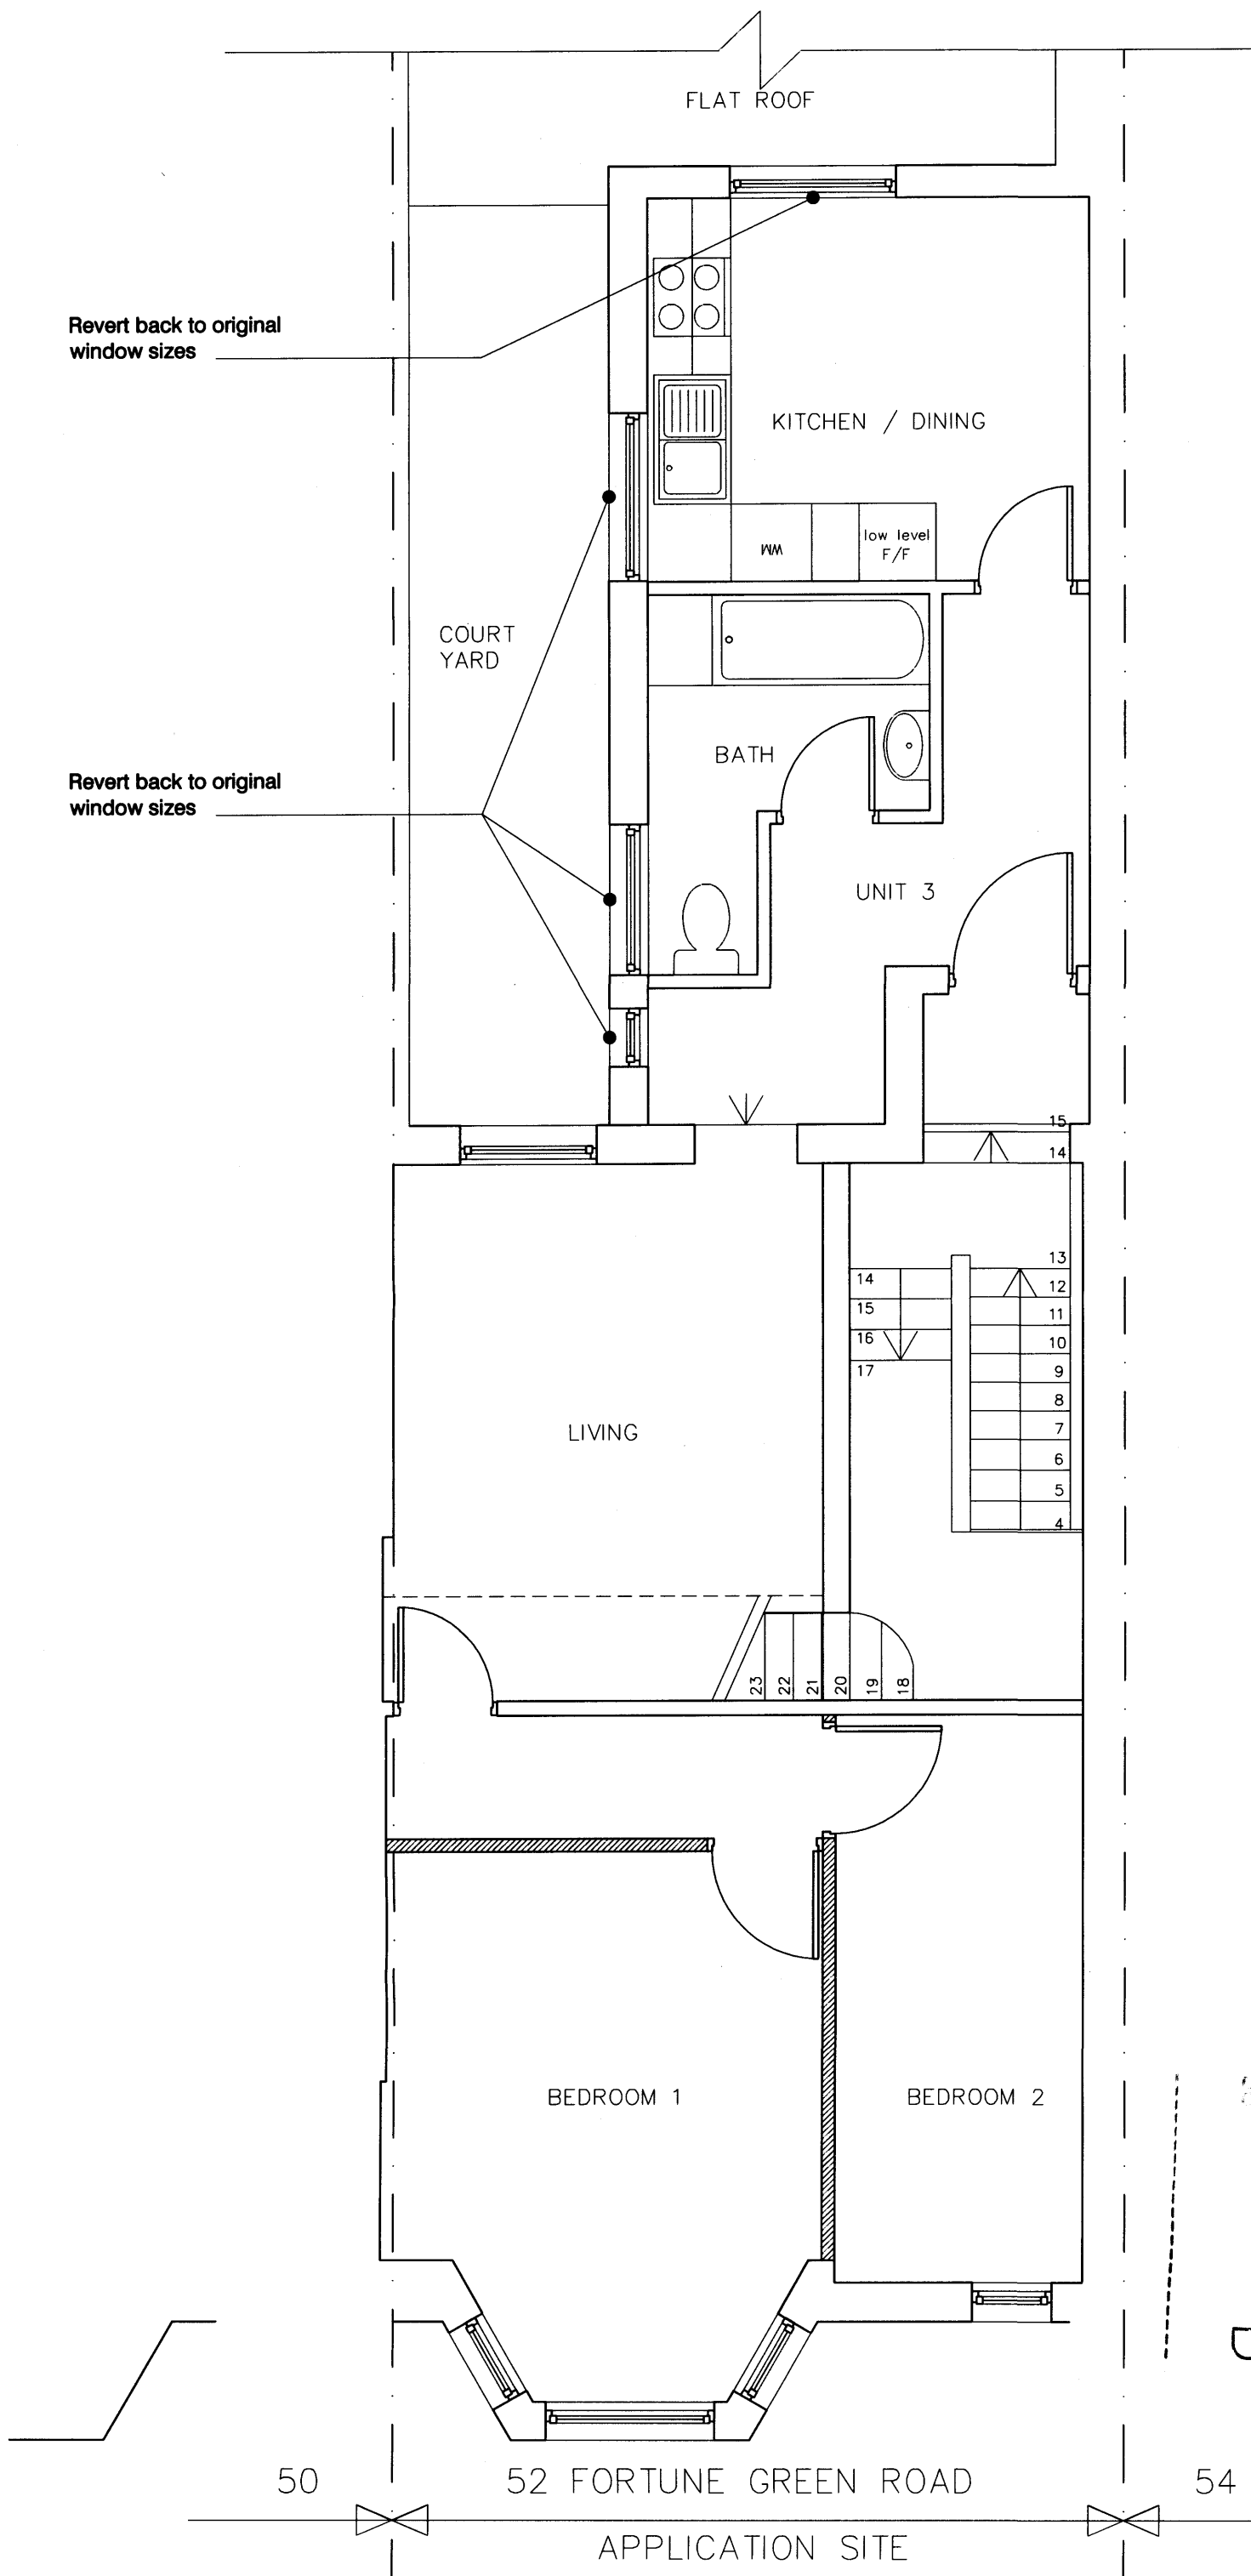

**NOTES:**

1. Use figured dimensions only. Do not scale.
2. Contractors to notify architect immediately of any dimensional discrepancy.

**Revisions:**

- / - 09.08 - Submitted as part of an Application for Planning Permission
- / - 11.08 - Submitted as additional information to an Application for Planning Permission

**NEW WALLS**

drawing status: **PLANNING**


job title: **52 Fortune Green Road  
London, NW3 1UJ**

client: **Michel Dadoun**

drg. title: **FIRST FLOOR PLAN  
Proposed Layouts**

drawn: / / date: **09/08** scale: **1:50 / A3**

job No: **0091** | drg. No: **PL 15** | rev: **A**

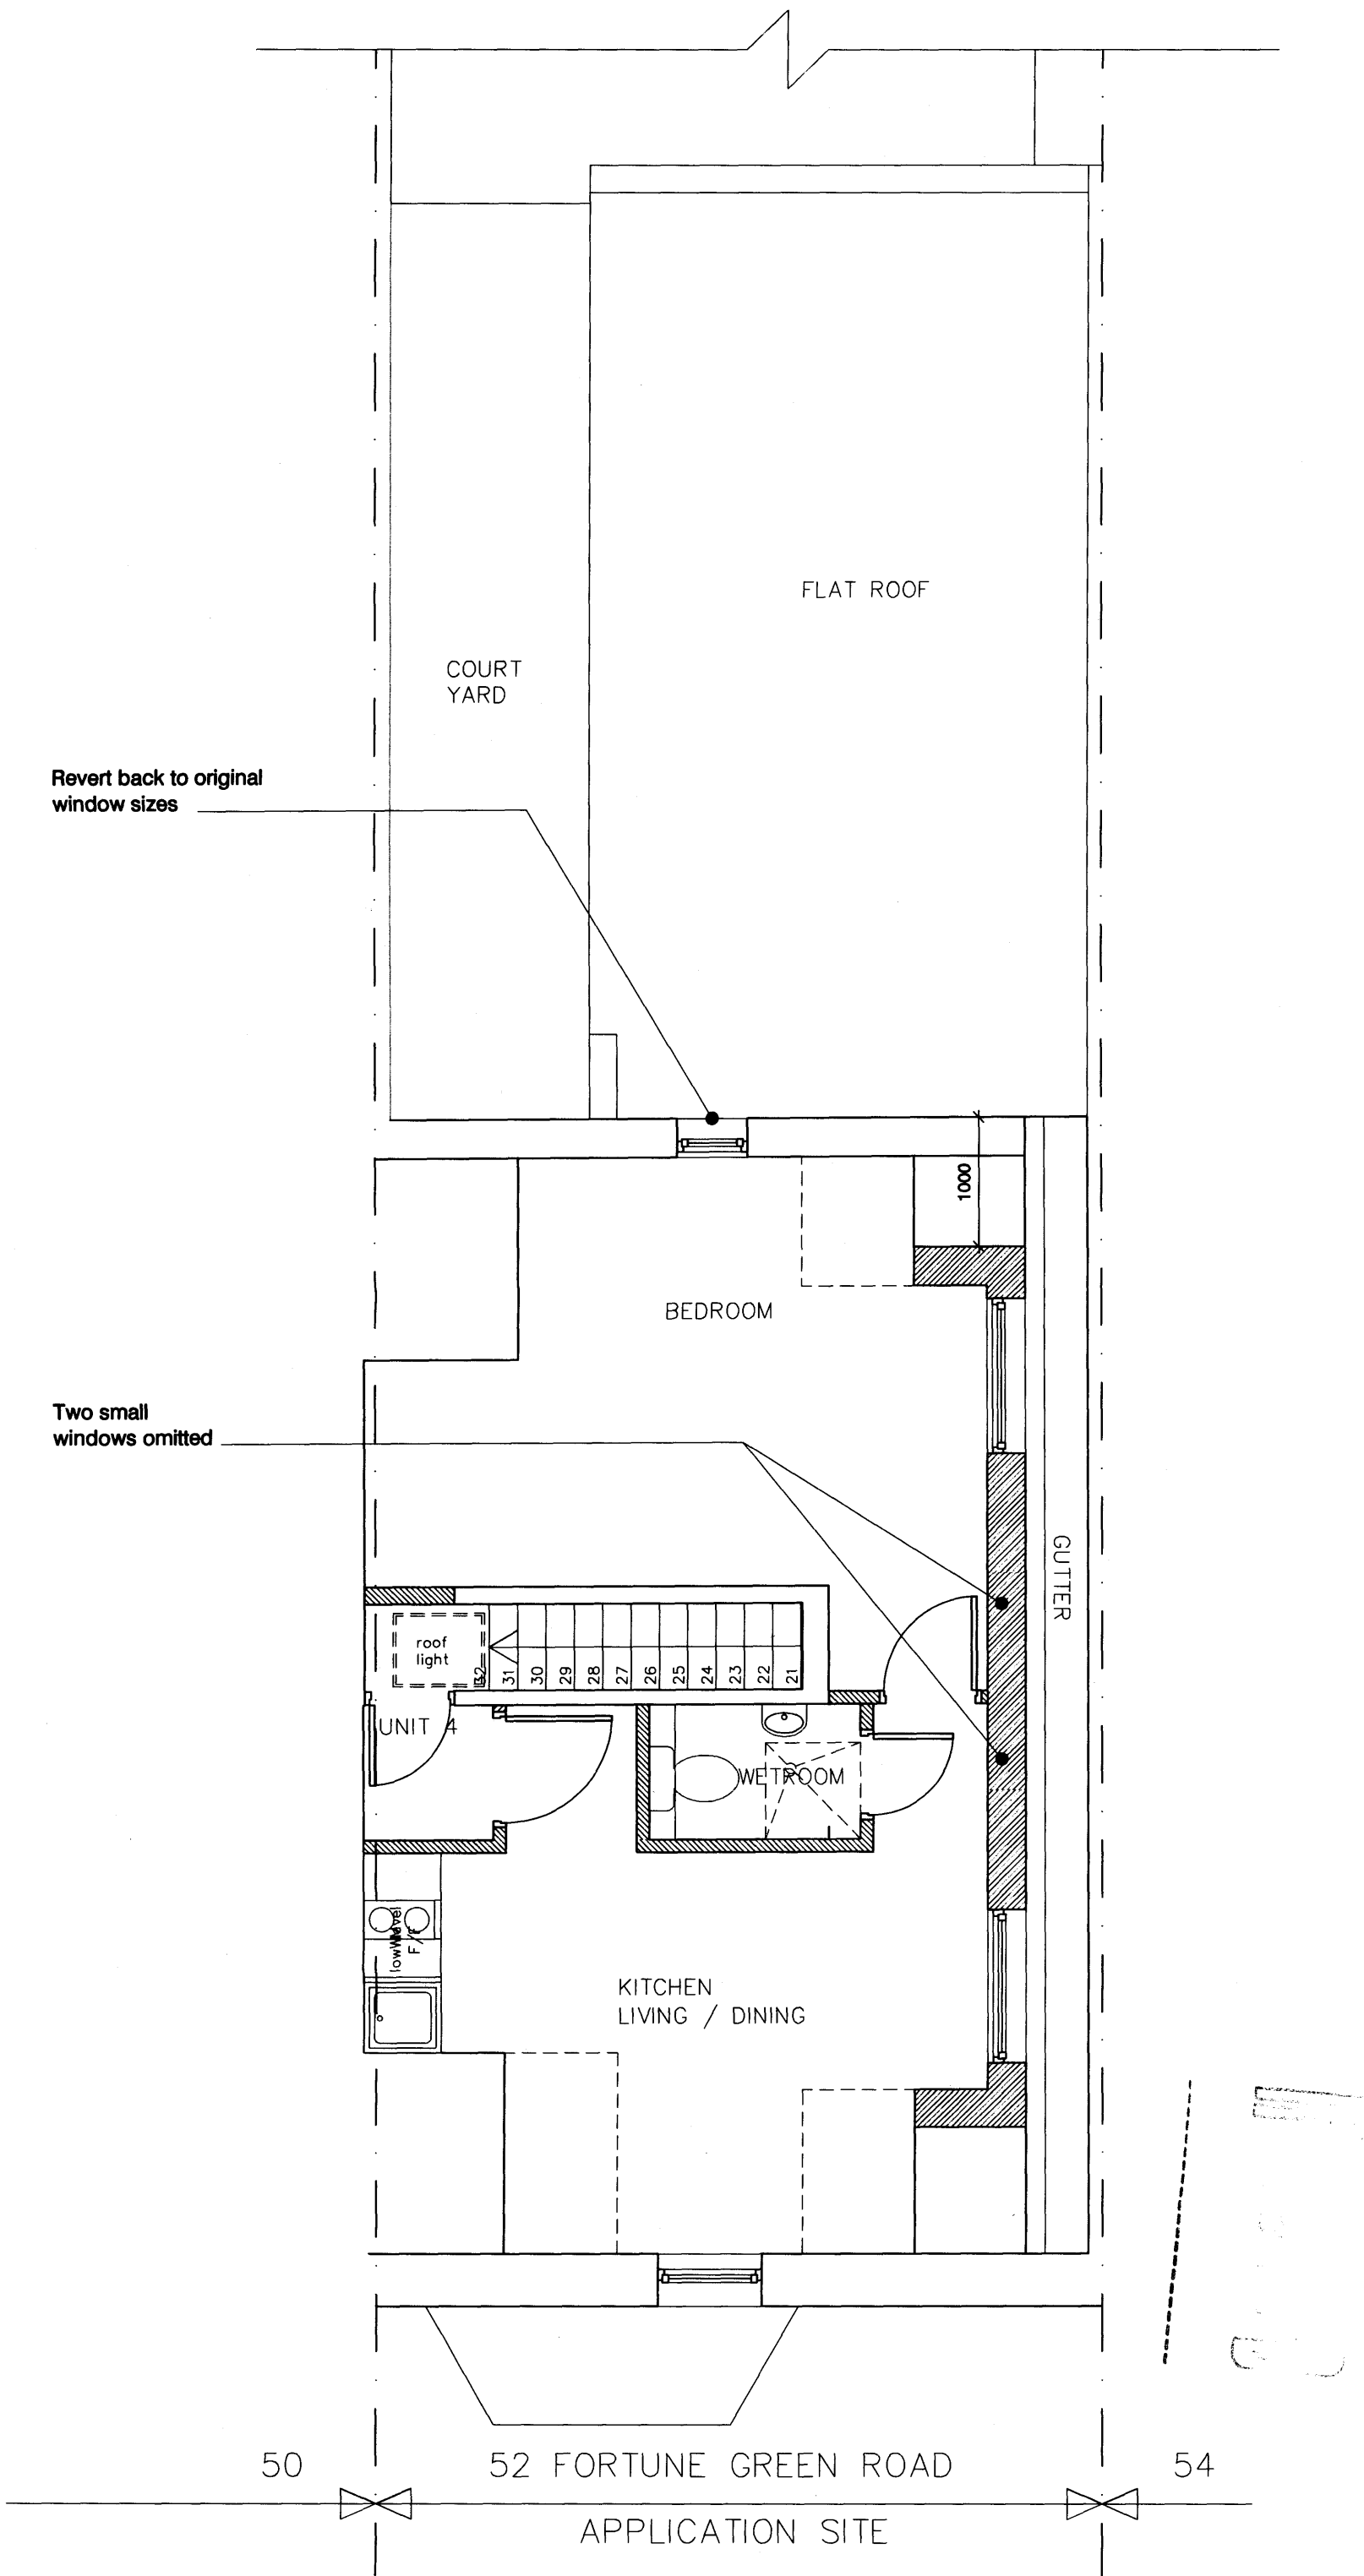

NOTES:

1. Use figured dimensions only. Do not scale.
2. Contractors to notify architect immediately of any dimensional discrepancy.

Revisions:

/ - 09.08 - Submitted as part of an Application for Planning Permission

NEW WALLS

drawing status:

PLANNING

job title:

**52 Fortune Green Road**  
London, NW3 1UJ

client:

Michel Dadoun

drg. title:

**SECOND FLOOR PLAN**  
Proposed Layouts

drawn:

/

date:

09/08

scale:

1:50 / A3

job No:


**0091**

drg. No:

**PL 16**

rev:

/

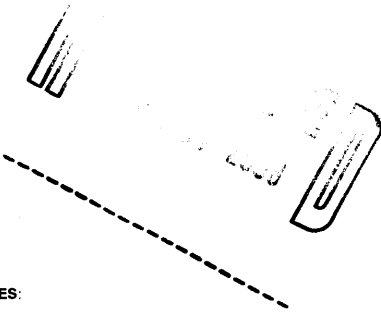


NOTES:

- 1. Use figured dimensions only. Do not scale.
- 2. Contractors to notify architect immediately of any dimensional discrepancy.

Revisions:

- / - 09.08 - Submitted as part of an Application for Planning Permission
- / - 11.08 - Submitted as additional information to an Application for Planning Permission

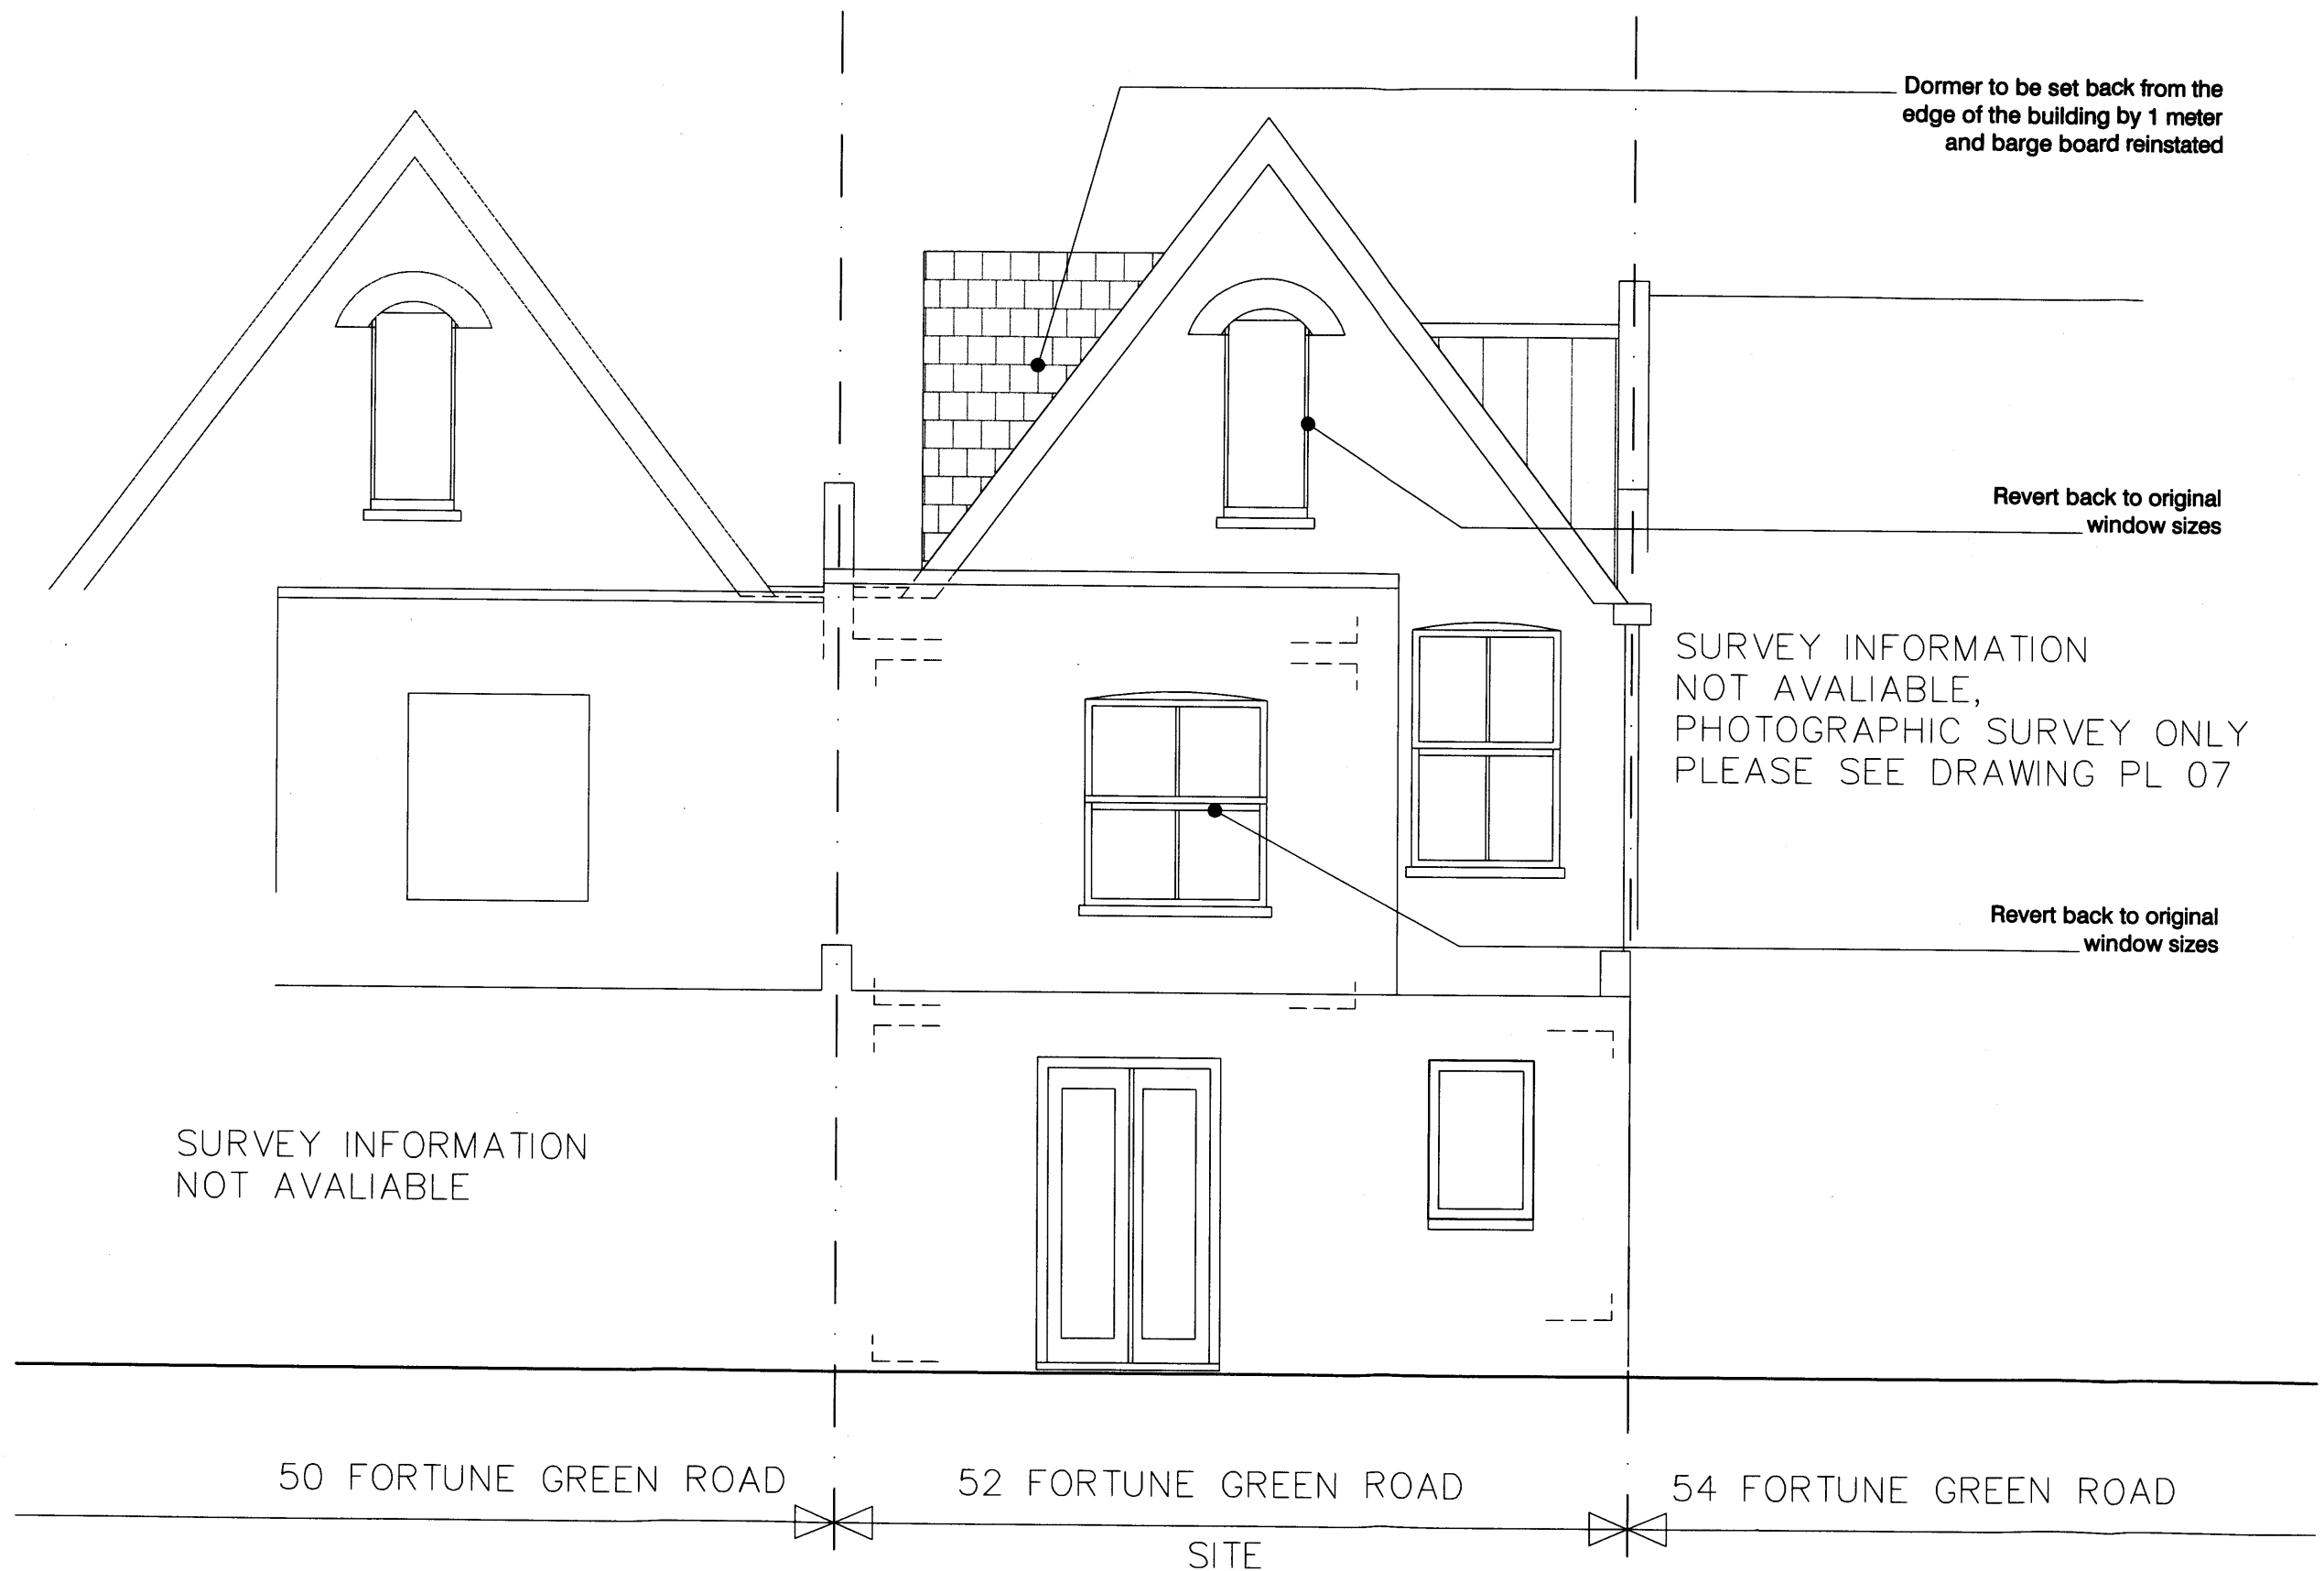

drawing status: **PLANNING**

job title: **52 Fortune Green Road**  
London, NW3 1UJ

client: **Michel Dadoun**

drg. title: **REAR ELEVATION**  
Proposed Layouts

drawn:	audited:	date:	scale:
	/	09/08	1:50 / A3

job No:	drg. No:	rev:
<b>0091</b>	<b>PL 18</b>	<b>A</b>


REVISIONS

NOTES:


- 1. Use figured dimensions only. Do not scale.
- 2. Contractors to notify architect immediately of any dimensional discrepancy.

Revisions:

/ - 11.08 - Submitted as additional information to an Application for Planning Permission

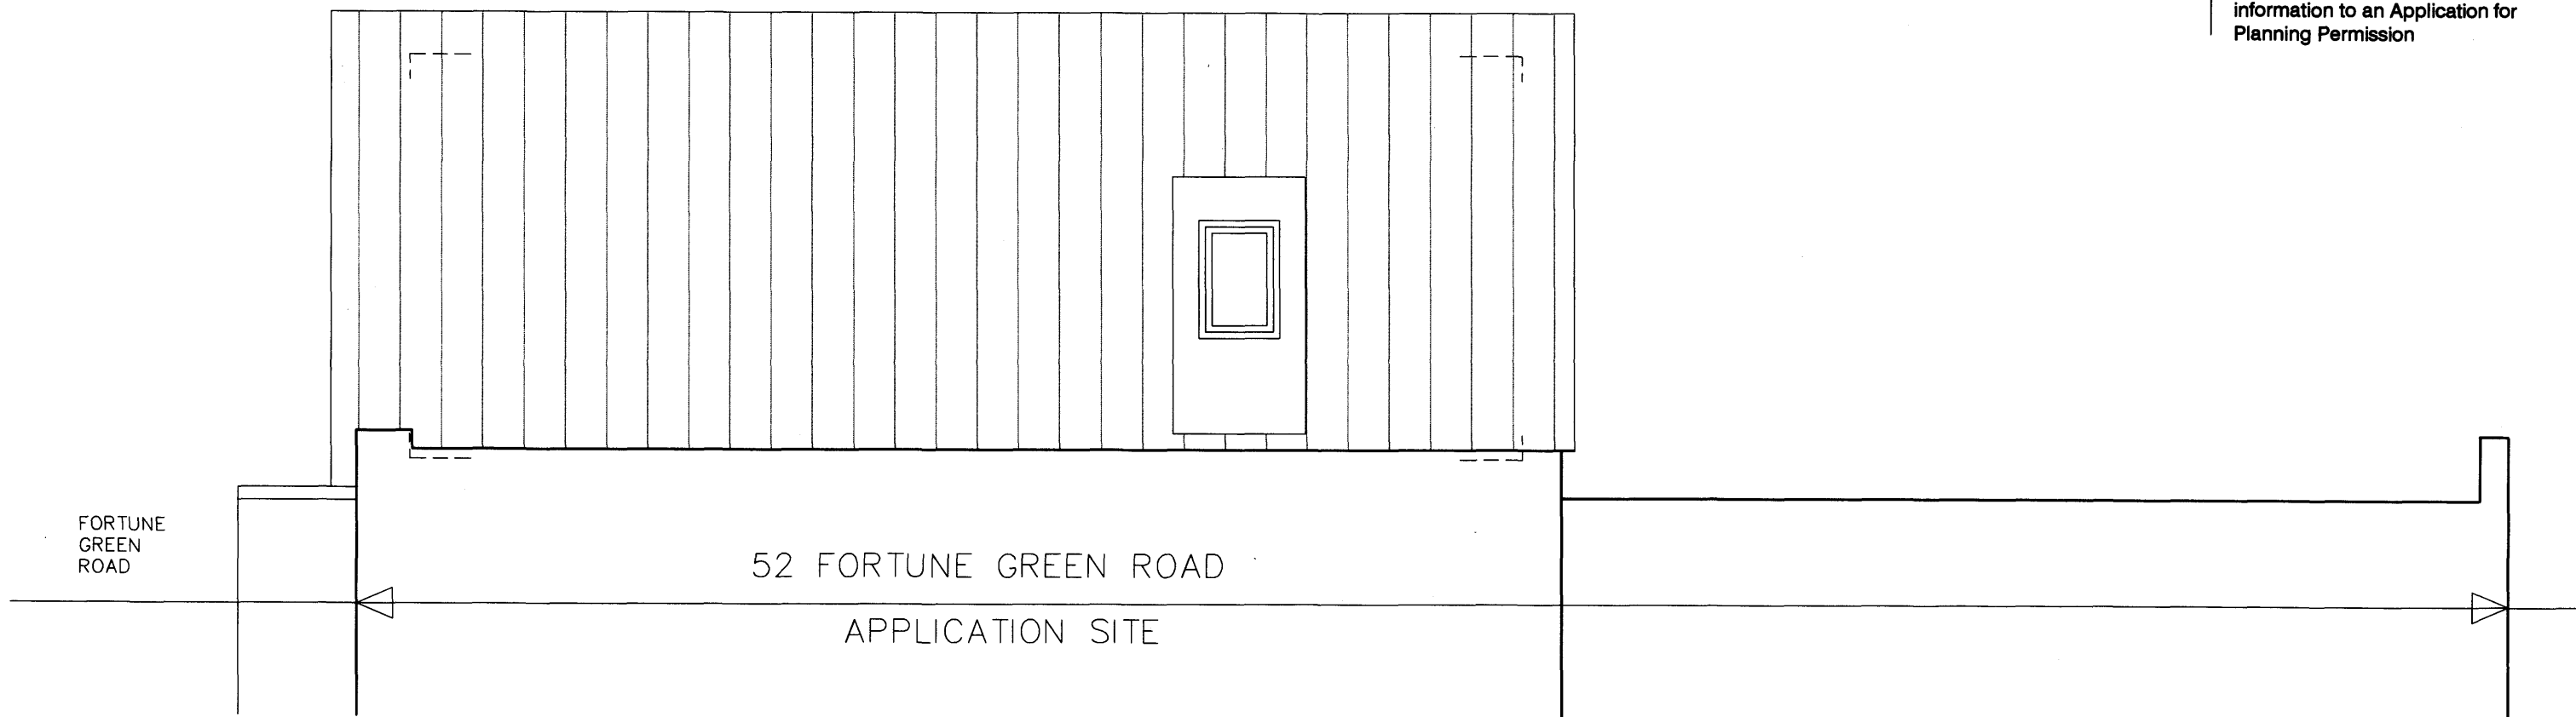

drawing status:				PLANNING	
job title:				52 Fortune Green Road London, NW3 1UJ	
client:				Michel Dadoun	
drg. title:				DORMER WINDOW IN ELEVATION Existing Layout	
drawn:	audited:	date:	11/08	scale:	1:50 / A3
	/				
job No:	0091	drg. No:	PL 21	rev:	/

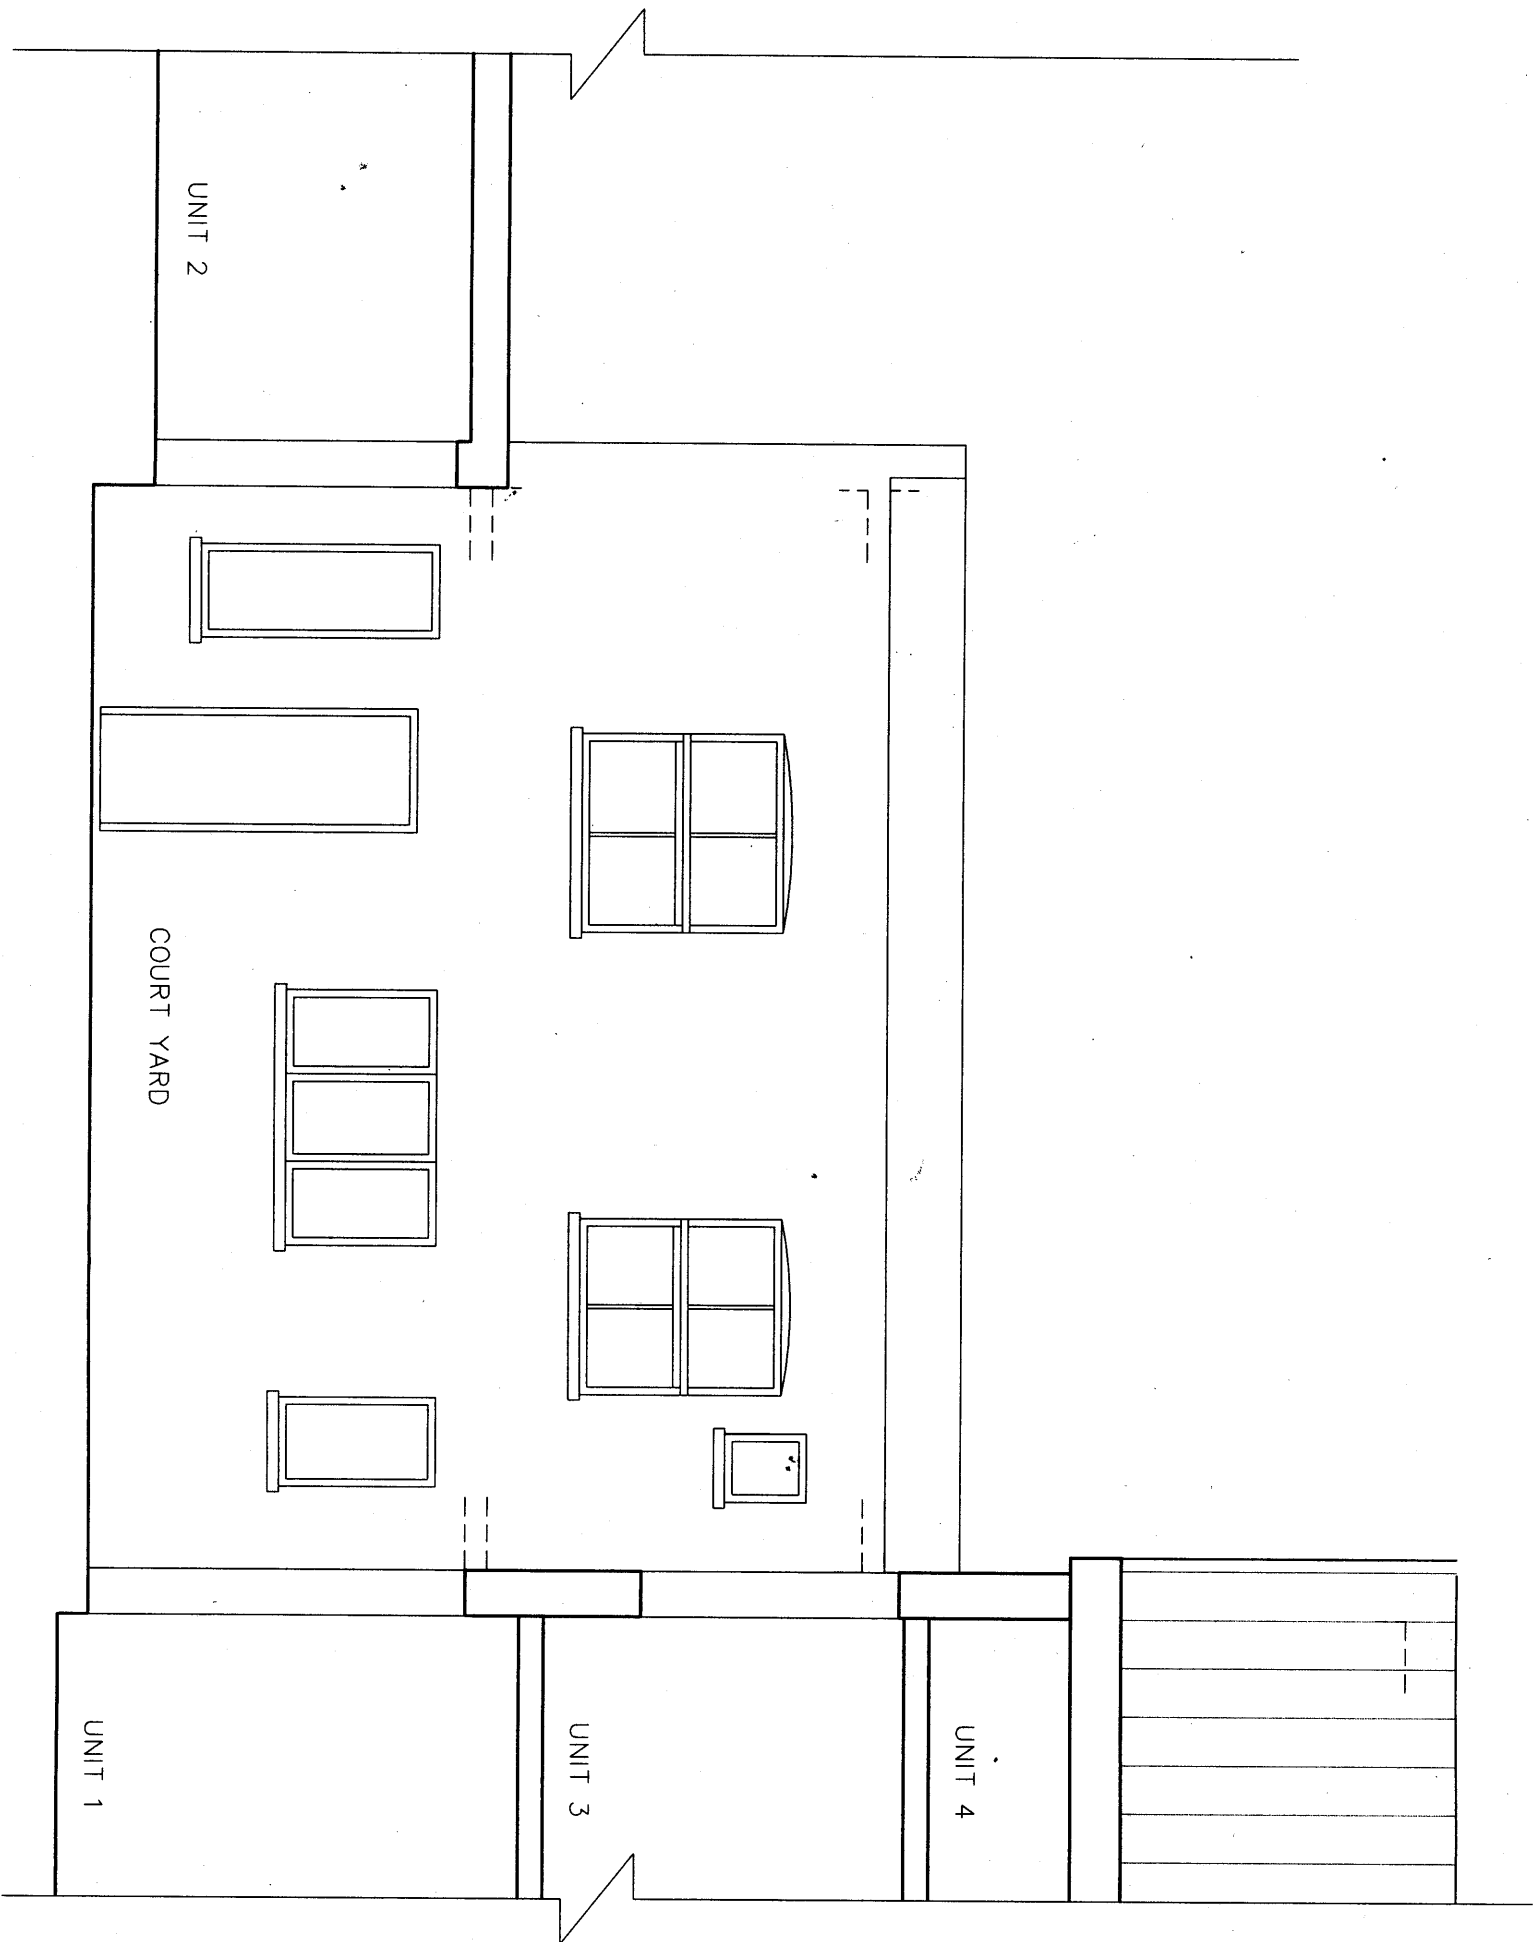

11000

NOTES:

1. Use figured dimensions only. Do not scale.
2. Contractors to notify architect immediately of any dimensional discrepancy.

Revisions:

/ - 11.08 - Submitted as additional information to an Application for Planning Permission

drawing name: **PLANNING**

job title: **52 Fortune Green Road**  
 London, NW3 1UJ


client: **Michel Dadoun**

drawing title: **COURTYARD ELEVATION**  
 Original Layout

drawn:	audited:	date:	scale:
/	/	11/08	1:50 / A3

job No: **0091** | drawing No: **PL 22** | rev: **/**



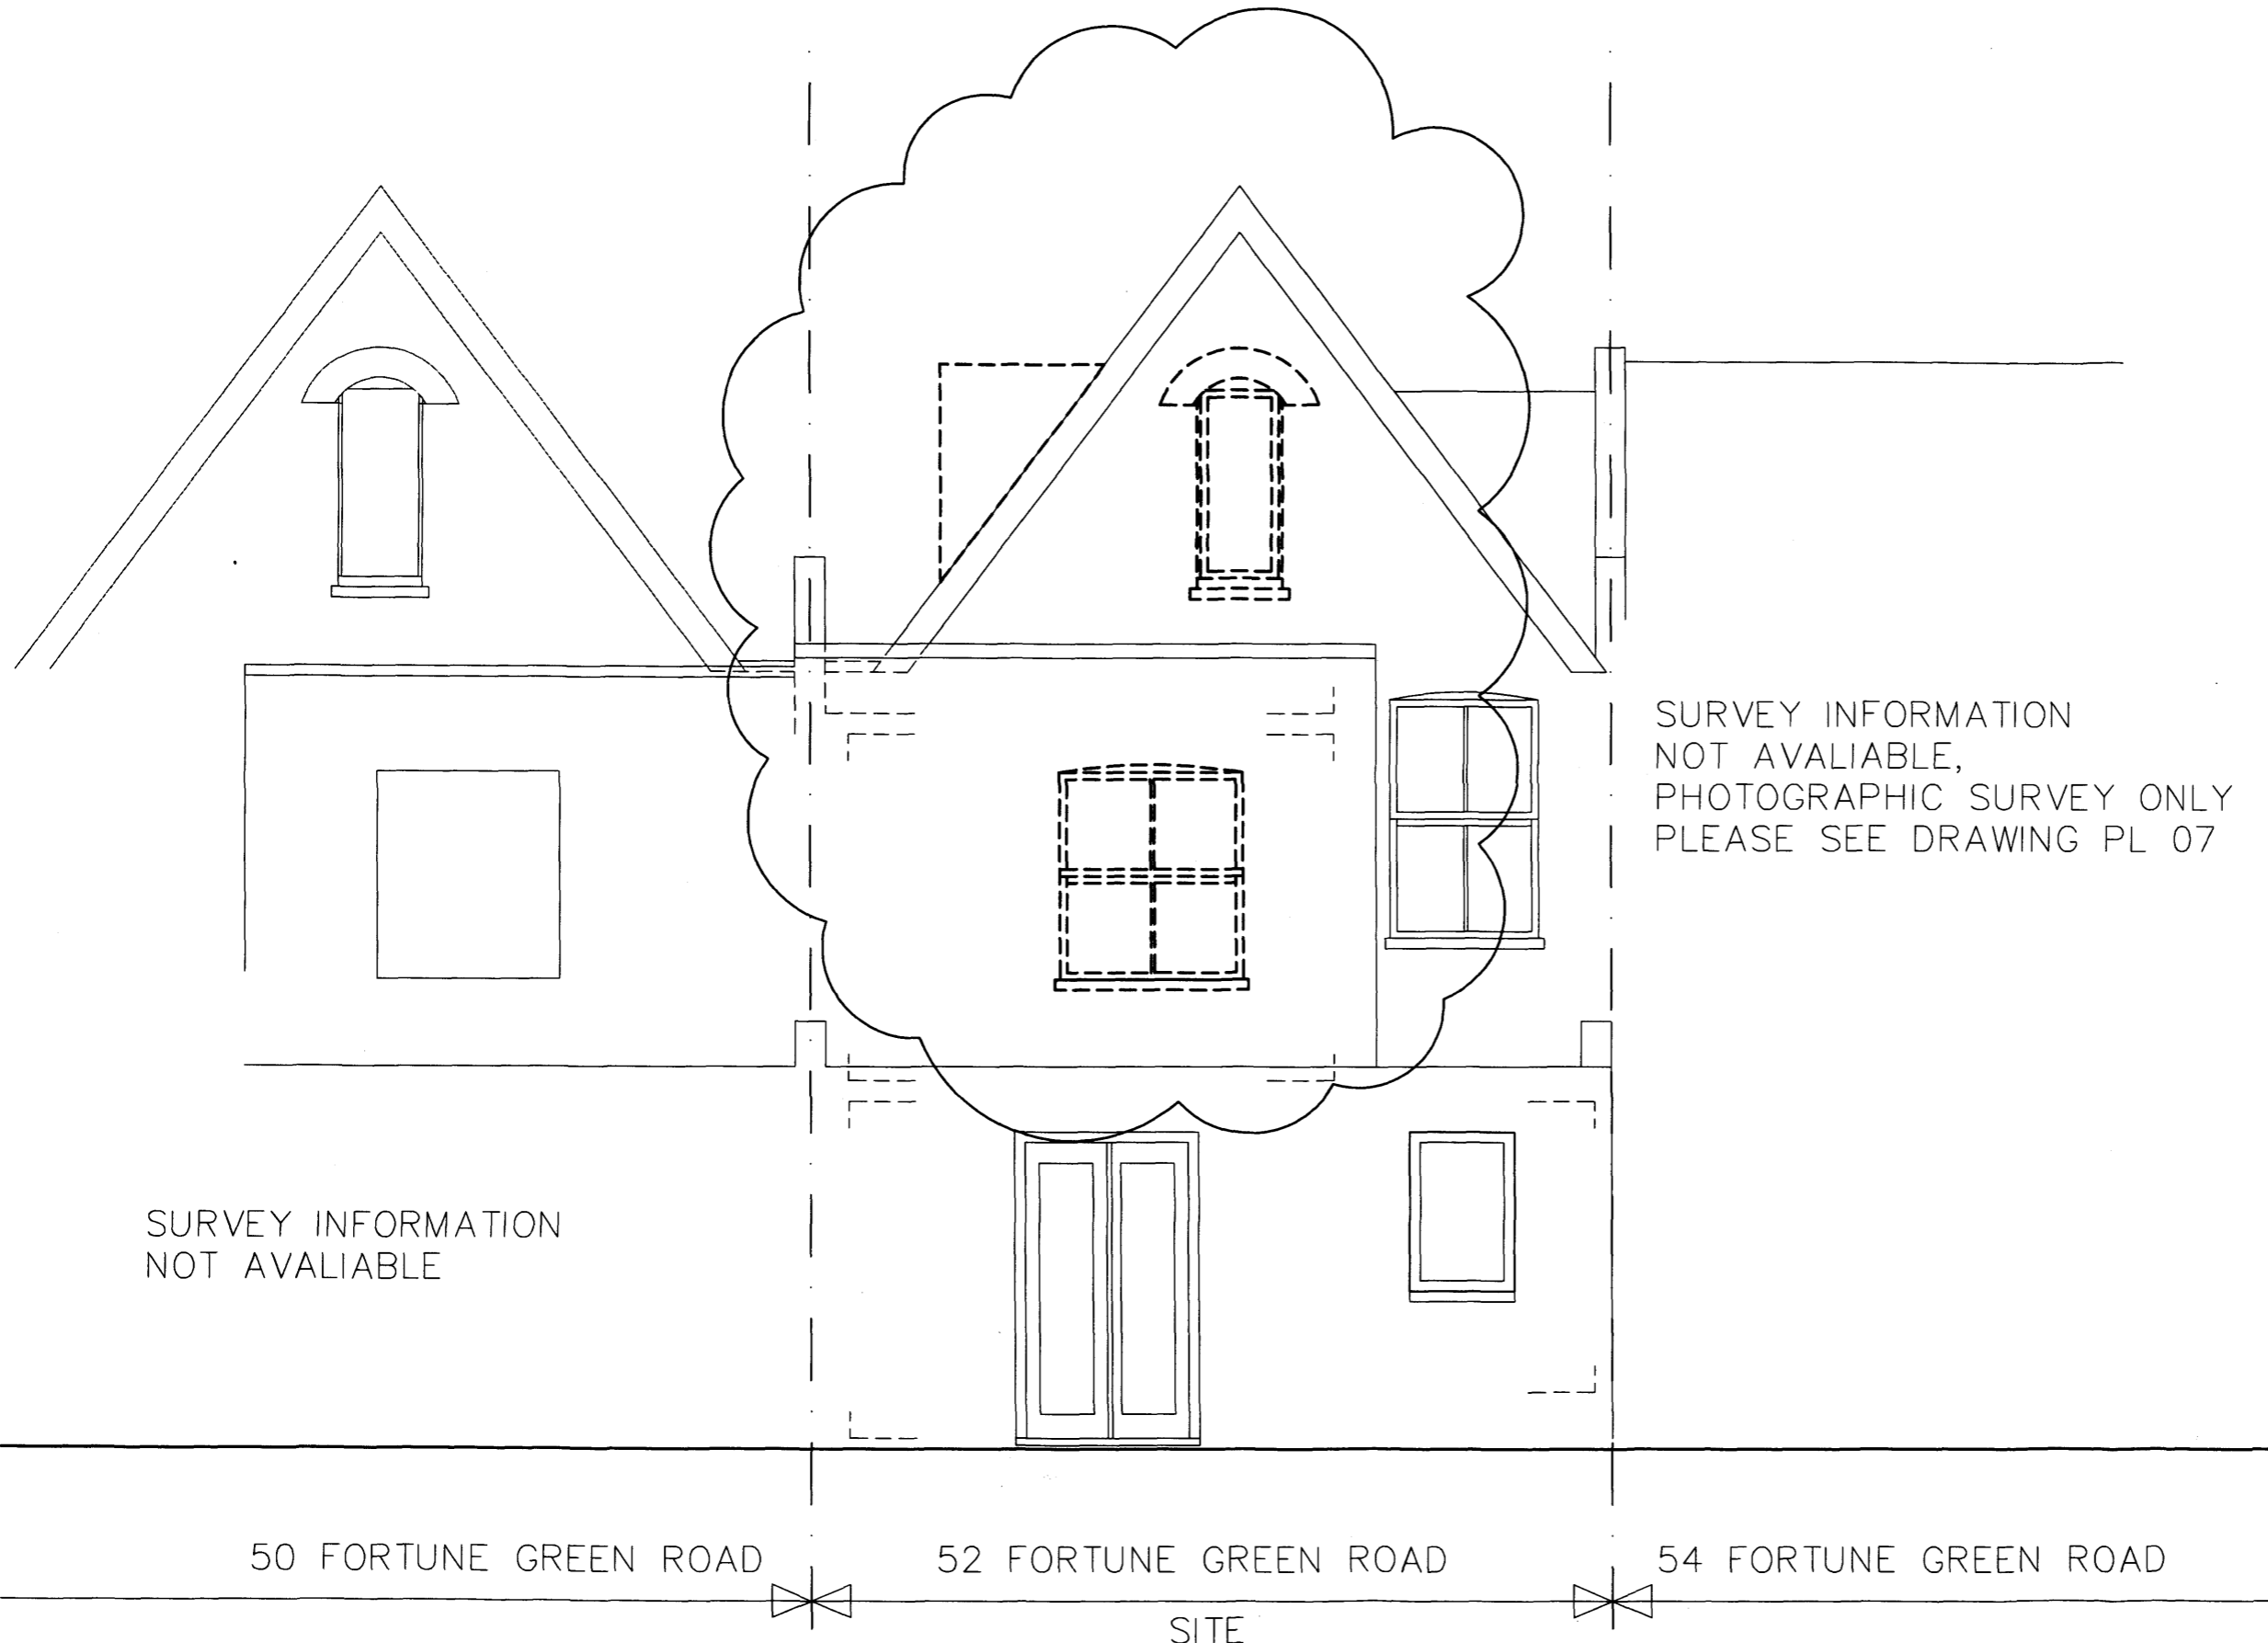

NOTES:

1. Use figured dimensions only. Do not scale.
2. Contractors to notify architect immediately of any dimensional discrepancy.

Revisions:

/ - 11.08 - Submitted as additional information to an Application for Planning Permission

--- TO BE DEMOLISHED

drawing status: **PLANNING**

job title: **52 Fortune Green Road**  
London, NW3 1UJ

client: **Michel Dadoun**

drp. title: **REAR ELEVATION**  
**Demolition Plan**

drawn:	checked:	date:	scale:
/	/	11/08	1:50 / A3

job No:	drp. No:	rev:
0091	PL 23	/


RECEIVED  
14 NOV 2008

NOTES:

1. Use figured dimensions only. Do not scale.
2. Contractors to notify architect immediately of any dimensional discrepancy.


Revisions:

/ - 11.08 - Submitted as additional information to an Application for Planning Permission  
Windows amended in size or replaced

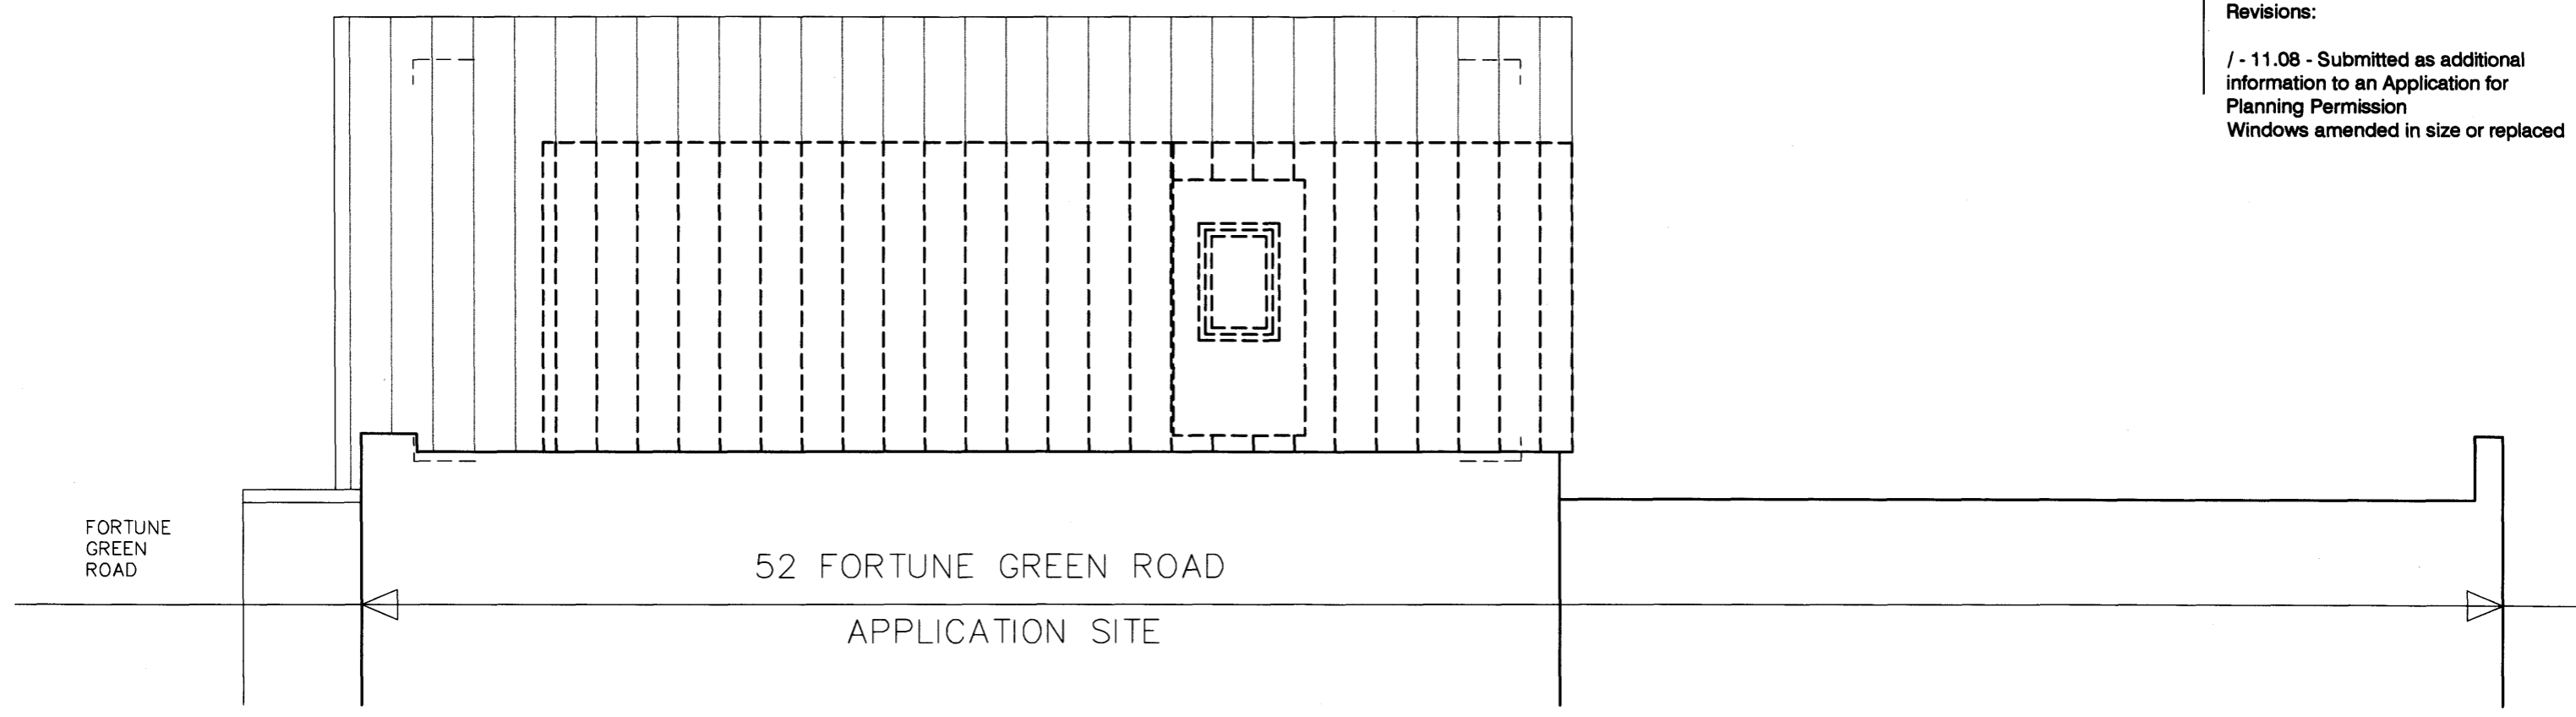

--- TO BE DEMOLISHED

drawing status:				<b>PLANNING</b>			
job title:				<b>52 Fortune Green Road</b> London, NW3 1UJ			
client:				Michel Dadoun			
drg. title:				<b>DORMER WINDOW IN ELEVATION</b> Demolition Plan			
drawn:	audited:	date:	scale:	drawn:	audited:	date:	scale:
/	/	11/08	1:50 / A3				
job No:		drg. No:		rev:			
0091		PL 24		/			

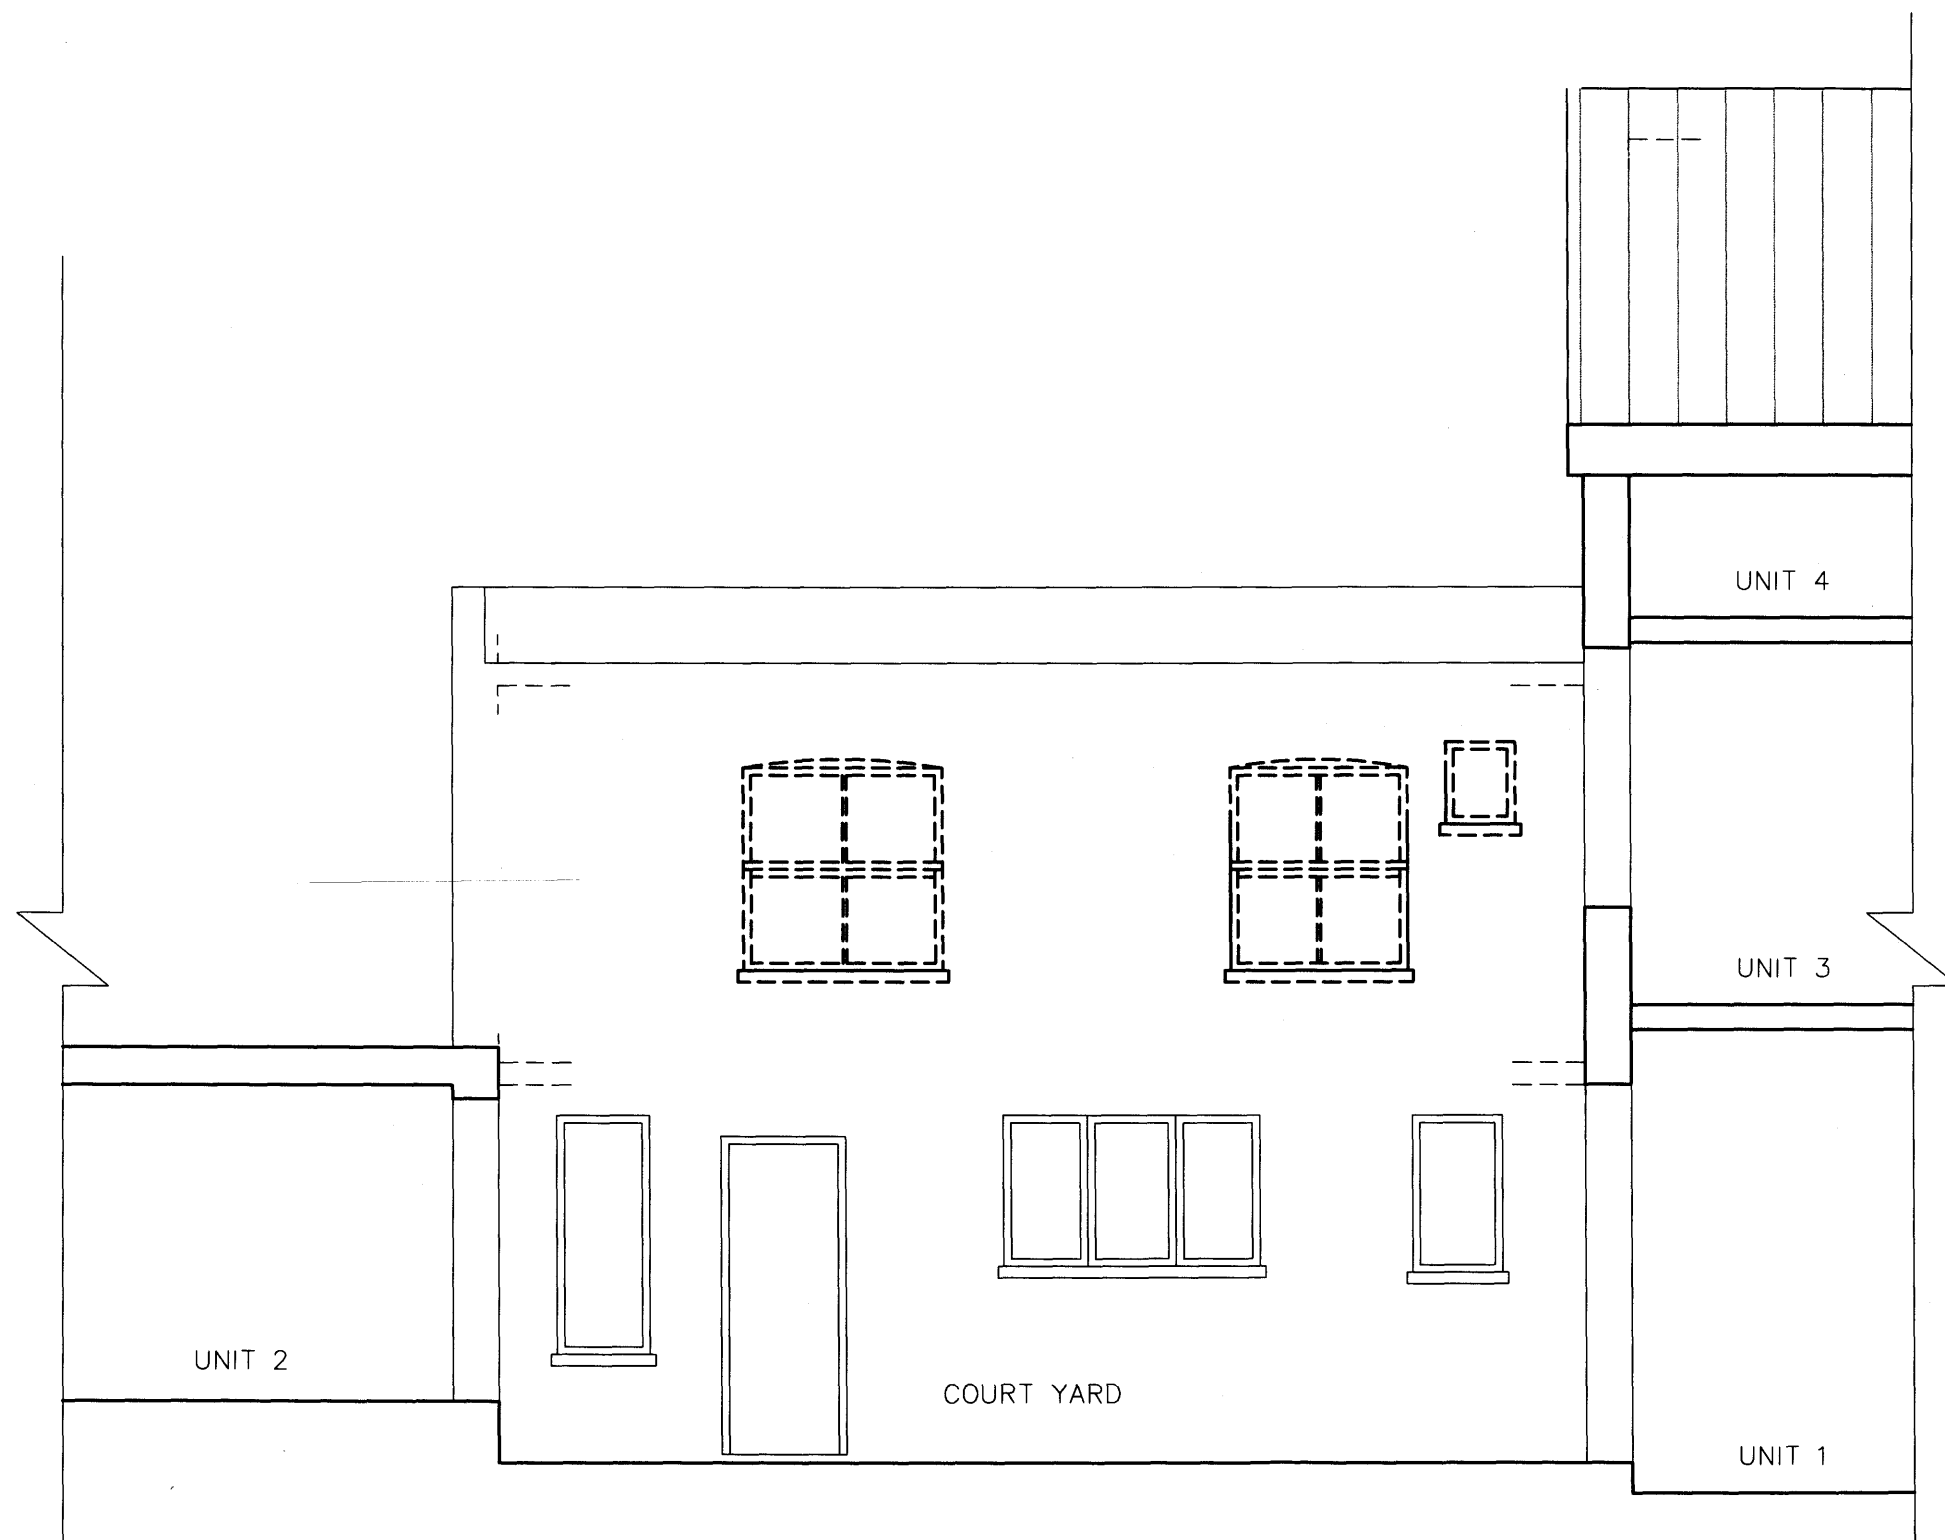

NOTES:

1. Use figured dimensions only. Do not scale.
2. Contractors to notify architect immediately of any dimensional discrepancy.

Revisions:

/ - 11.08 - Submitted as additional information to an Application for Planning Permission  
 Windows amended in size or replaced

--- TO BE DEMOLISHED

drawing status: **PLANNING**


job title: **52 Fortune Green Road**  
 London, NW3 1UJ

client: **Michel Dadoun**

drg title: **COURTYARD ELEVATION**  
 Demolition Plan

drawn:	auth'd:	date:	scale:
/	/	11/08	1:50 / A3

job No:	drg. No:	rev:
0091	PL 25	/

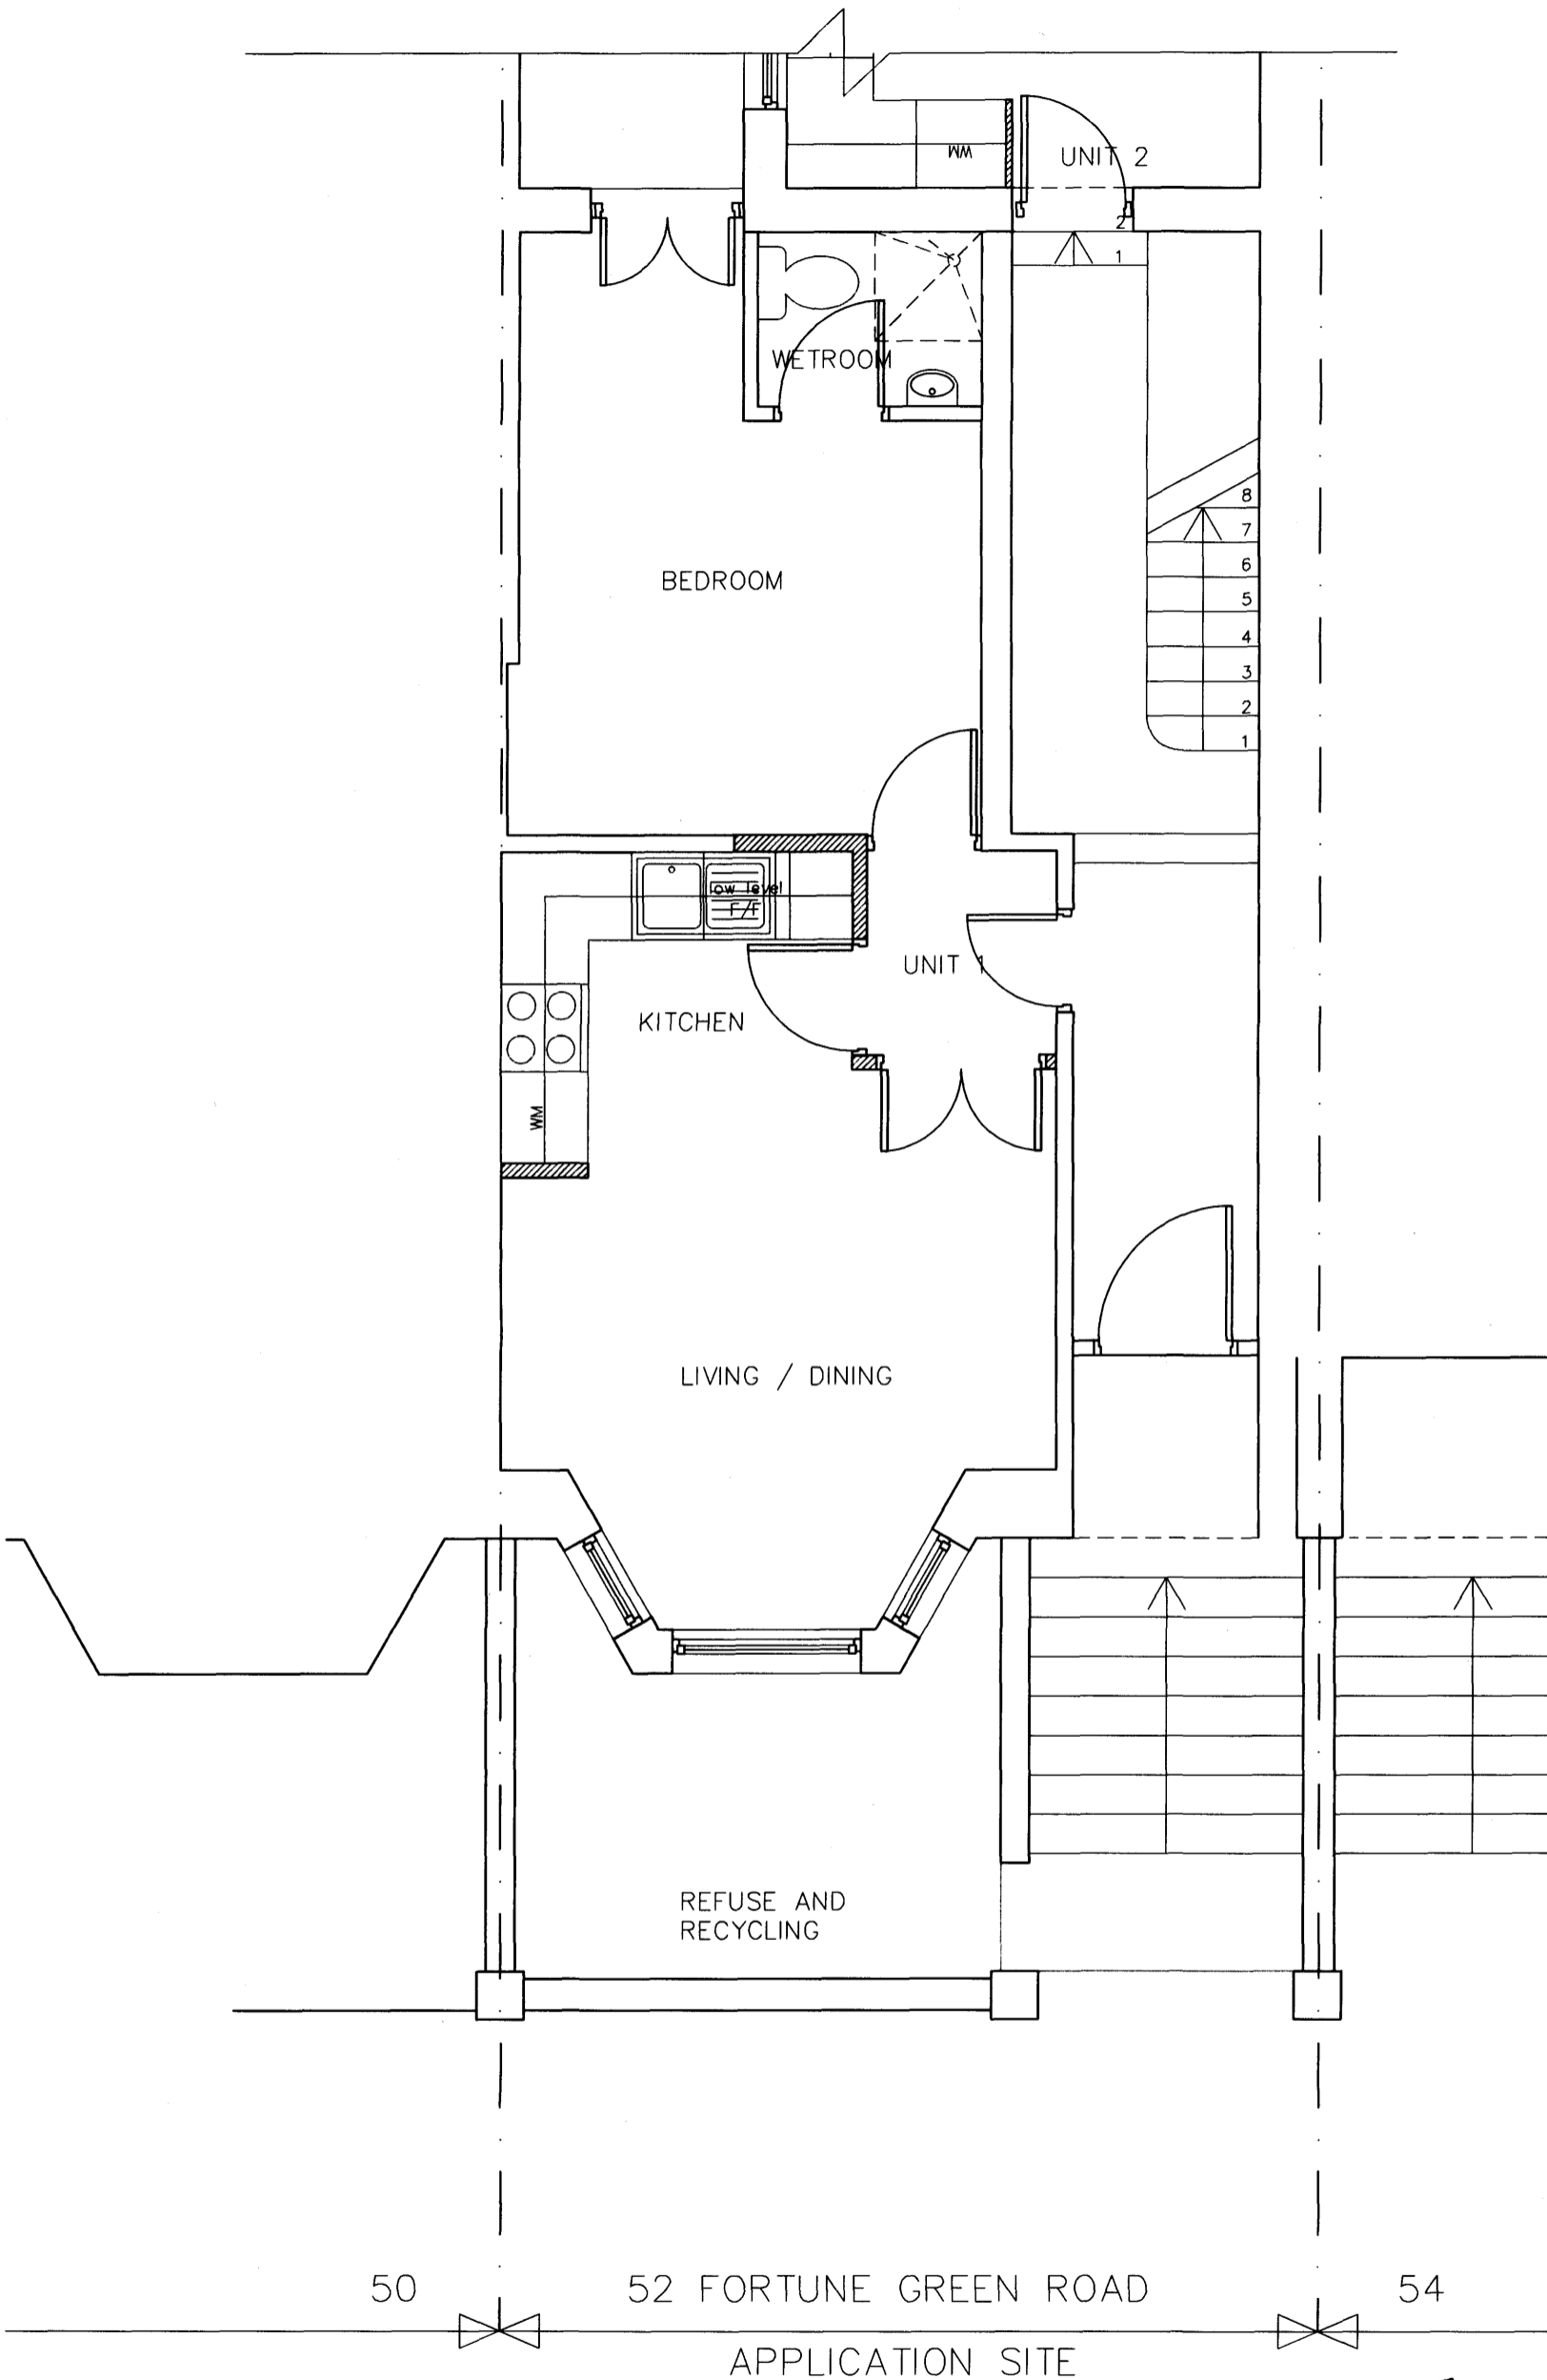

**NOTES:**

1. Use figured dimensions only. Do not scale.
2. Contractors to notify architect immediately of any dimensional discrepancy.

**Revisions:**

/ - 11.08 - Submitted as additional information to an Application for Planning Permission

**NEW WALLS**

drawing status:

**PLANNING**

job title:

**52 Fortune Green Road  
London, NW3 1UJ**

client:

**Michel Dadoun**

drg. title:

**GROUND FLOOR SHEET 1  
As Built**


drawn:	audited:	date:	scale:
/	/	11/08	1:50 / A3

job No:	drg. No:	rev:
<b>0091</b>	<b>PL 26</b>	/

PL26  
01

**GROUND FLOOR PLAN  
FRONT UNIT**

RECEIVED  
 11 NOV 2008

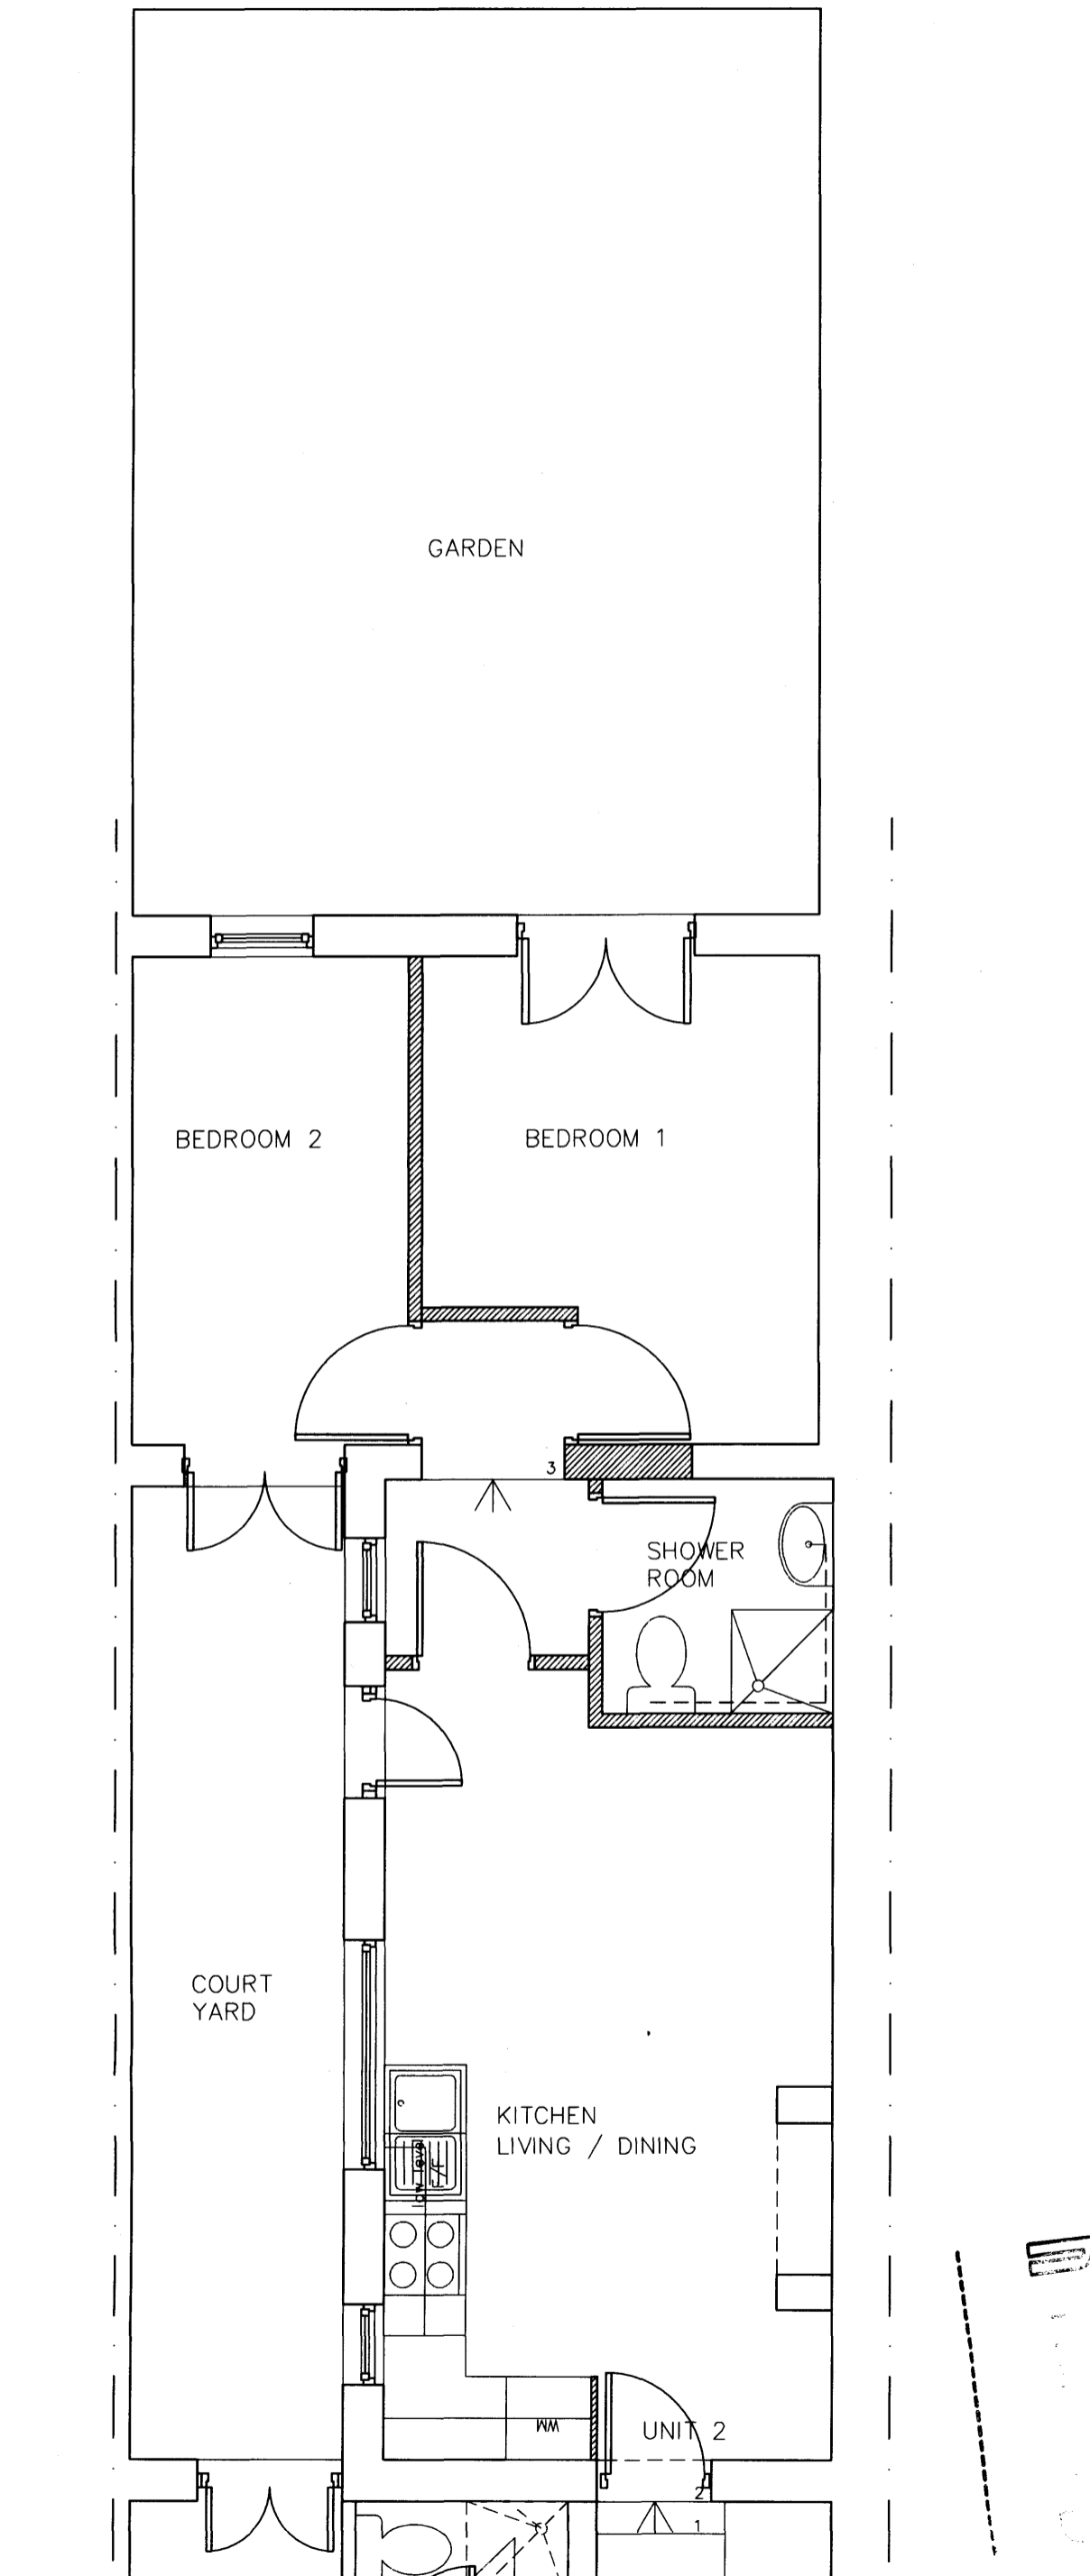

PL 27  
01

**GROUND FLOOR PLAN  
REAR UNIT**

**NOTES:**

1. Use figured dimensions only. Do not scale.
2. Contractors to notify architect immediately of any dimensional discrepancy.

**Revisions:**

/ - 11.08 - Submitted as additional information to an Application for Planning Permission

 **NEW WALLS**

drawing status:

**PLANNING**

job title:

**52 Fortune Green Road  
London, NW3 1UJ**

client:

**Michel Dadoun**

drg. title:

**GROUND FLOOR SHEET 2  
As Built**

drawn:

audited:

date:

11/08

scale:

1:50 / A3

job No:


**0091**

drg. No:

**PL 27**

rev:

/

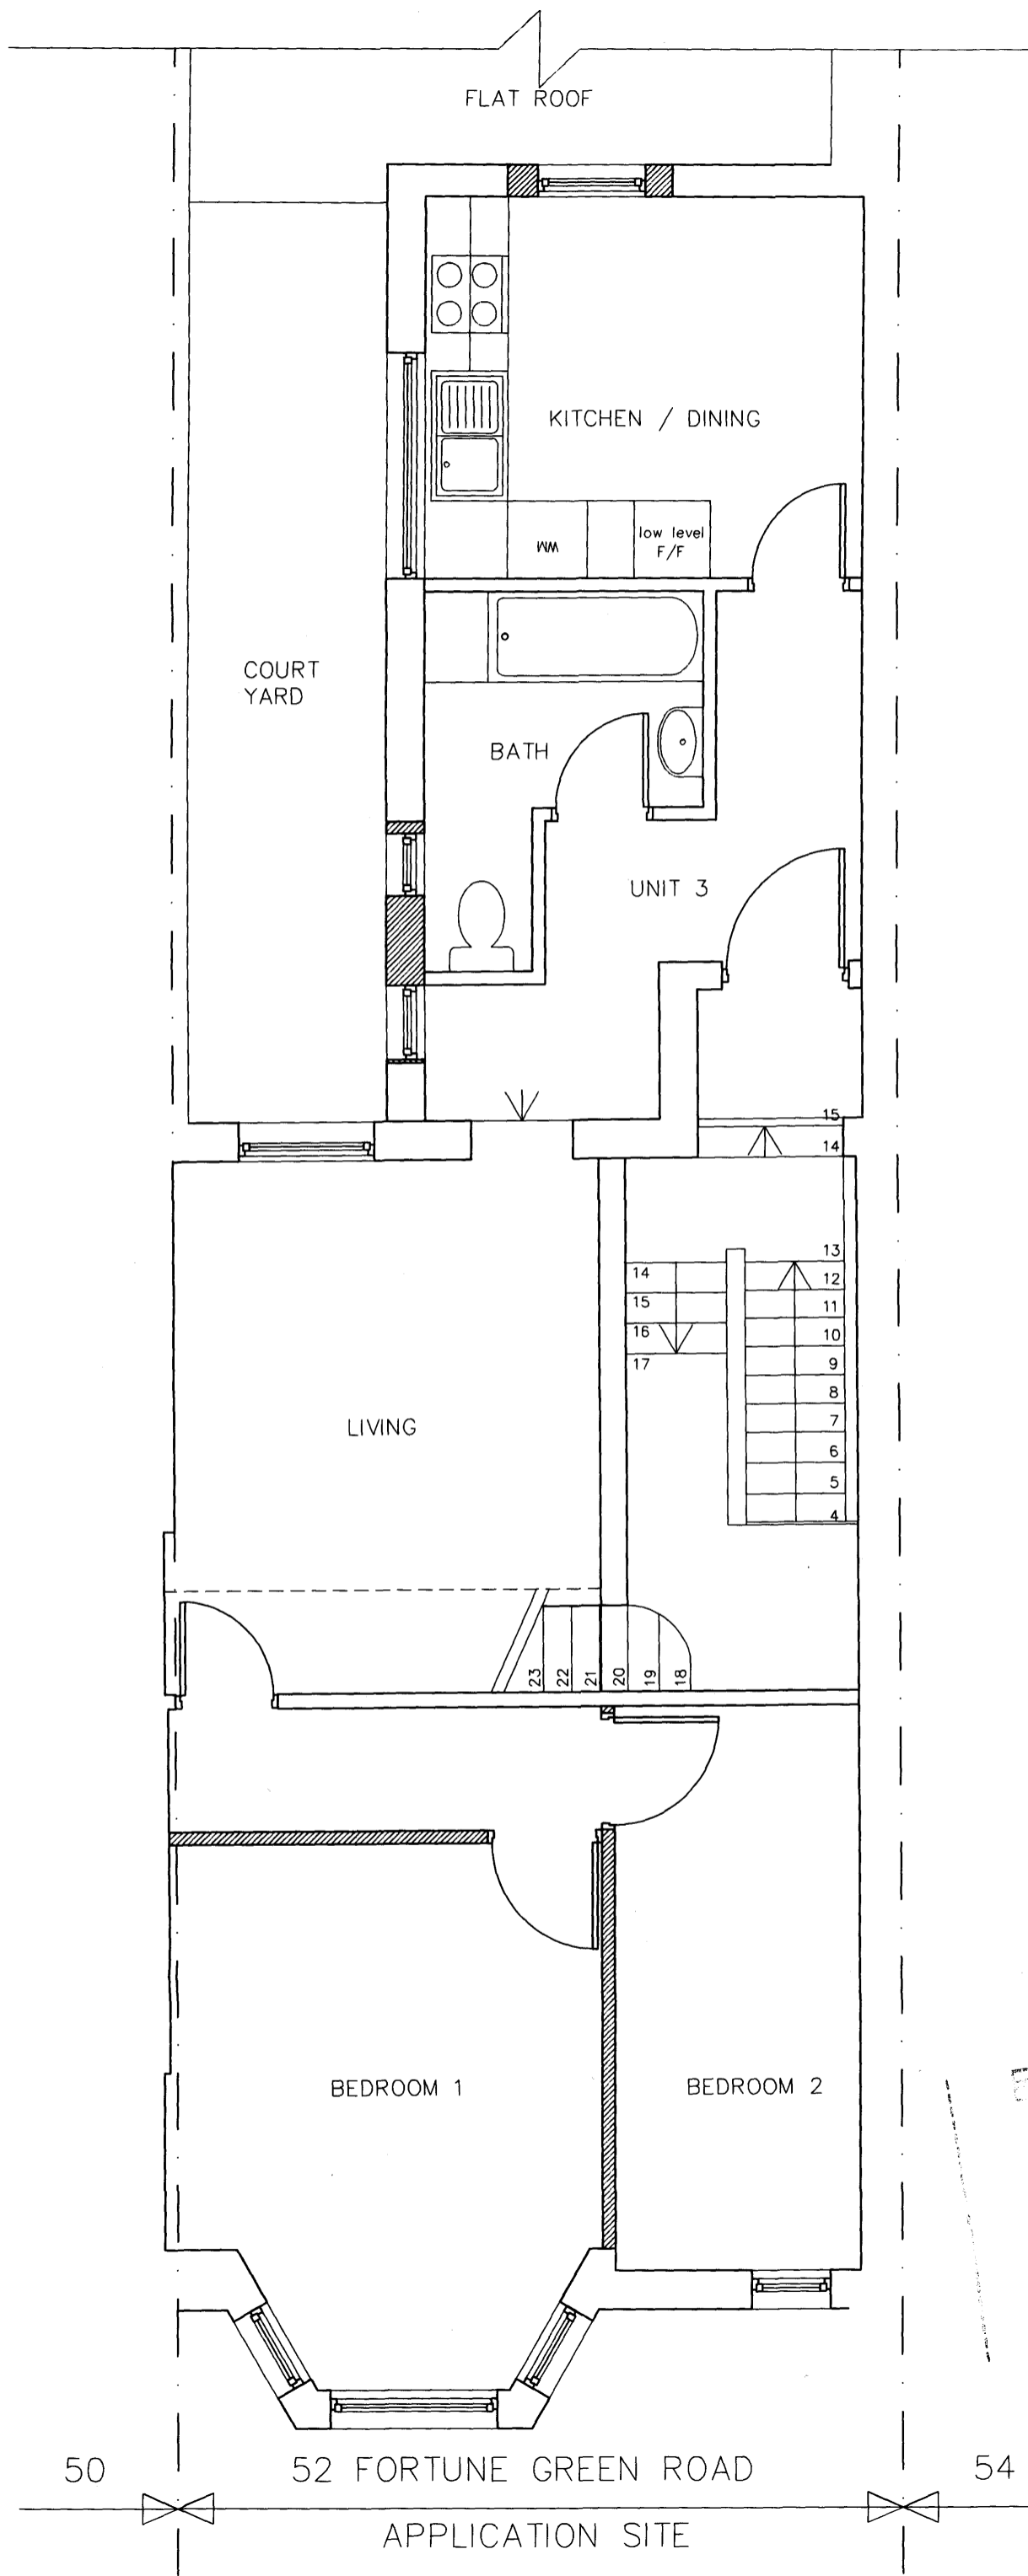

NOTES:

1. Use figured dimensions only. Do not scale.
2. Contractors to notify architect immediately of any dimensional discrepancy.

Revisions:

/ - 11.08 - Submitted as additional information to an Application for Planning Permission

NEW WALLS

drawing status:

**PLANNING**

job title:

**52 Fortune Green Road  
London, NW3 1UJ**

client:

**Michel Dadoun**

drg. title:

**FIRST FLOOR PLAN  
As Built**

drawn:

audited:

date:

11/08

scale:

1:50 / A3

job No:

**0091**

drg. No:

**PL 28**

rev:


/

50

52 FORTUNE GREEN ROAD

54

APPLICATION SITE

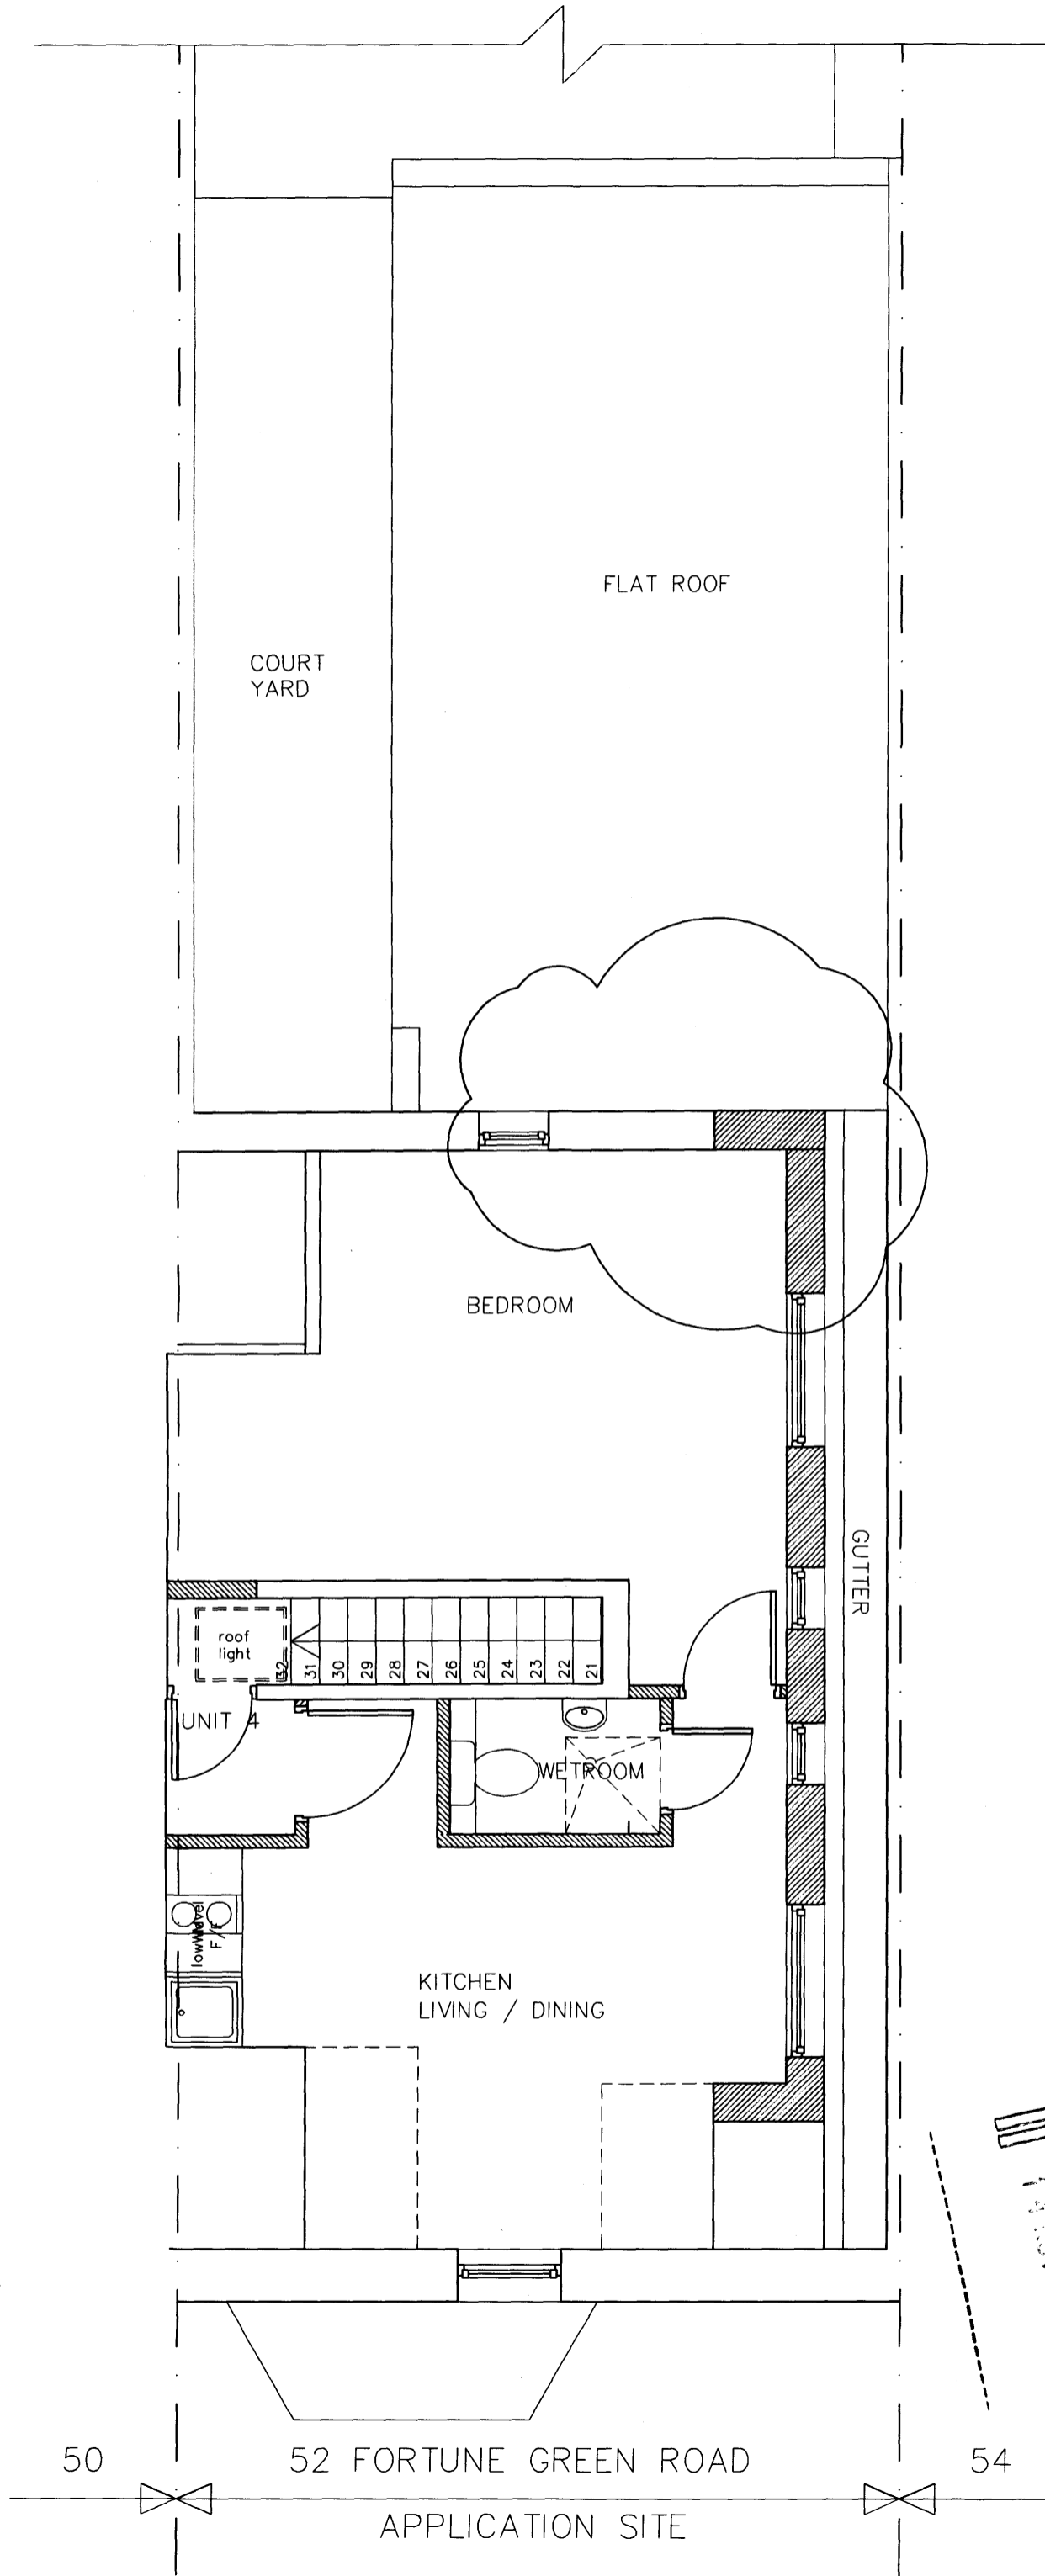

NOTES:

- 1. Use figured dimensions only. Do not scale.
- 2. Contractors to notify architect immediately of any dimensional discrepancy.


Revisions:

/ - 11.08 - Submitted as additional information to an Application for Planning Permission

NEW WALLS

drawing status:			
<b>PLANNING</b>			
job title:			
<b>52 Fortune Green Road</b> London, NW3 1UJ			
client:			
<b>Michel Dadoun</b>			
drg. title:			
<b>SECOND FLOOR PLAN</b> As Built			
drawn:	audited:	date:	scale:
/	/	11/08	1:50 / A3
job No:	drg. No:	rev:	
<b>0091</b>	<b>PL 29</b>	/	

REVISION  
14/11/08  
Michel Dadoun

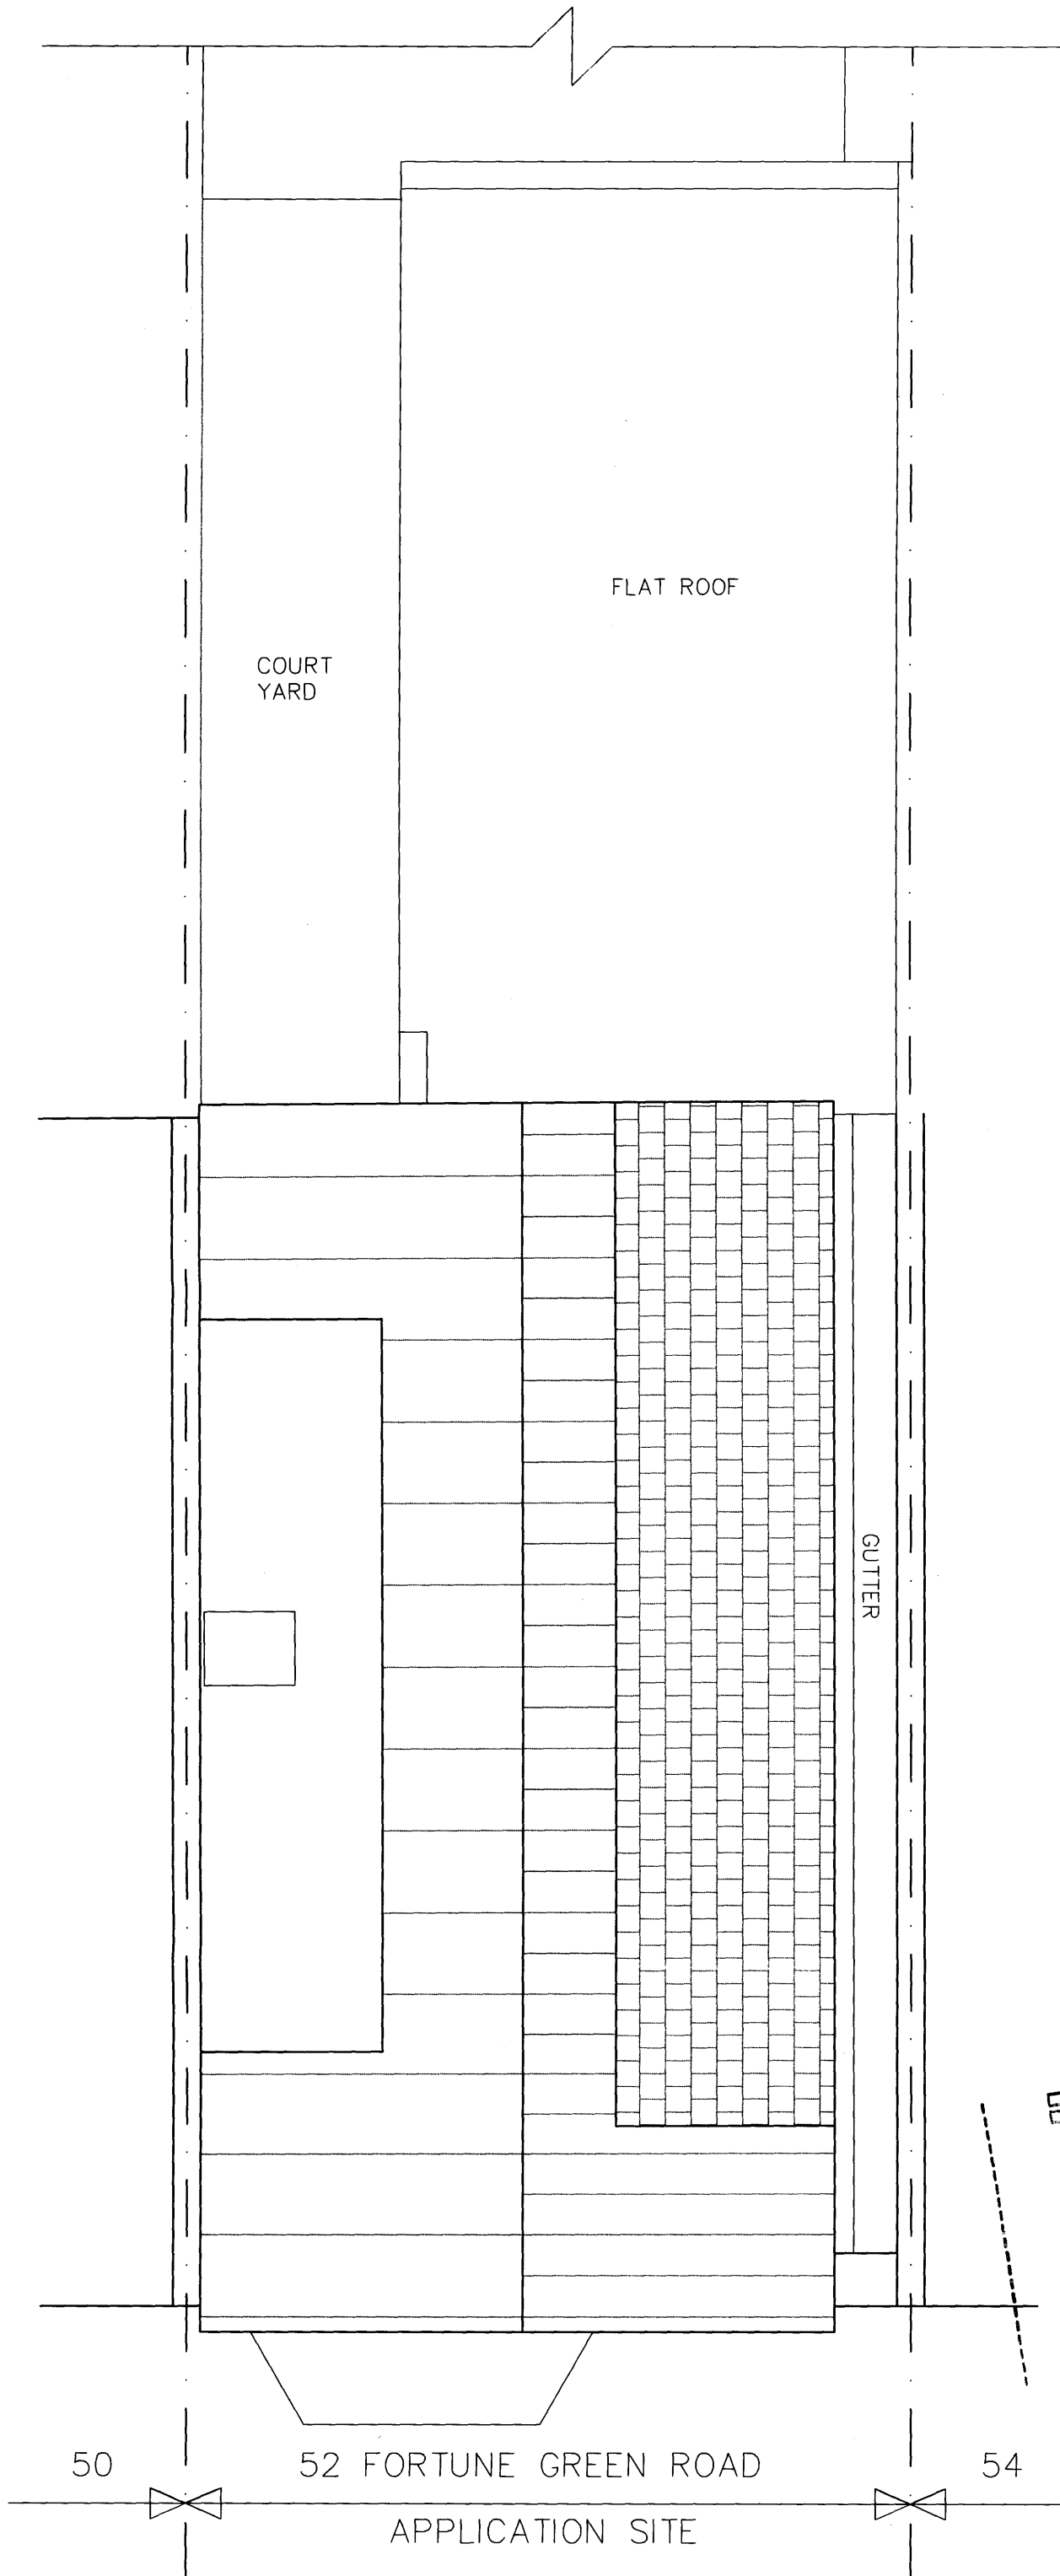

**NOTES:**

1. Use figured dimensions only. Do not scale.
2. Contractors to notify architect immediately of any dimensional discrepancy.

**Revisions:**

/ - 11.08 - Submitted as additional information to an Application for Planning Permission

drawing status:

**PLANNING**

job title:

**52 Fortune Green Road**  
London, NW3 1UJ

client:

**Michel Dadoun**

dig. title:

**ROOF PLAN**  
**As Built**

drawn:

audited:

date:

11/08

scale:

1:50 / A3

job No:

**0091**


dig. No:

**PL 30**

rev:

/



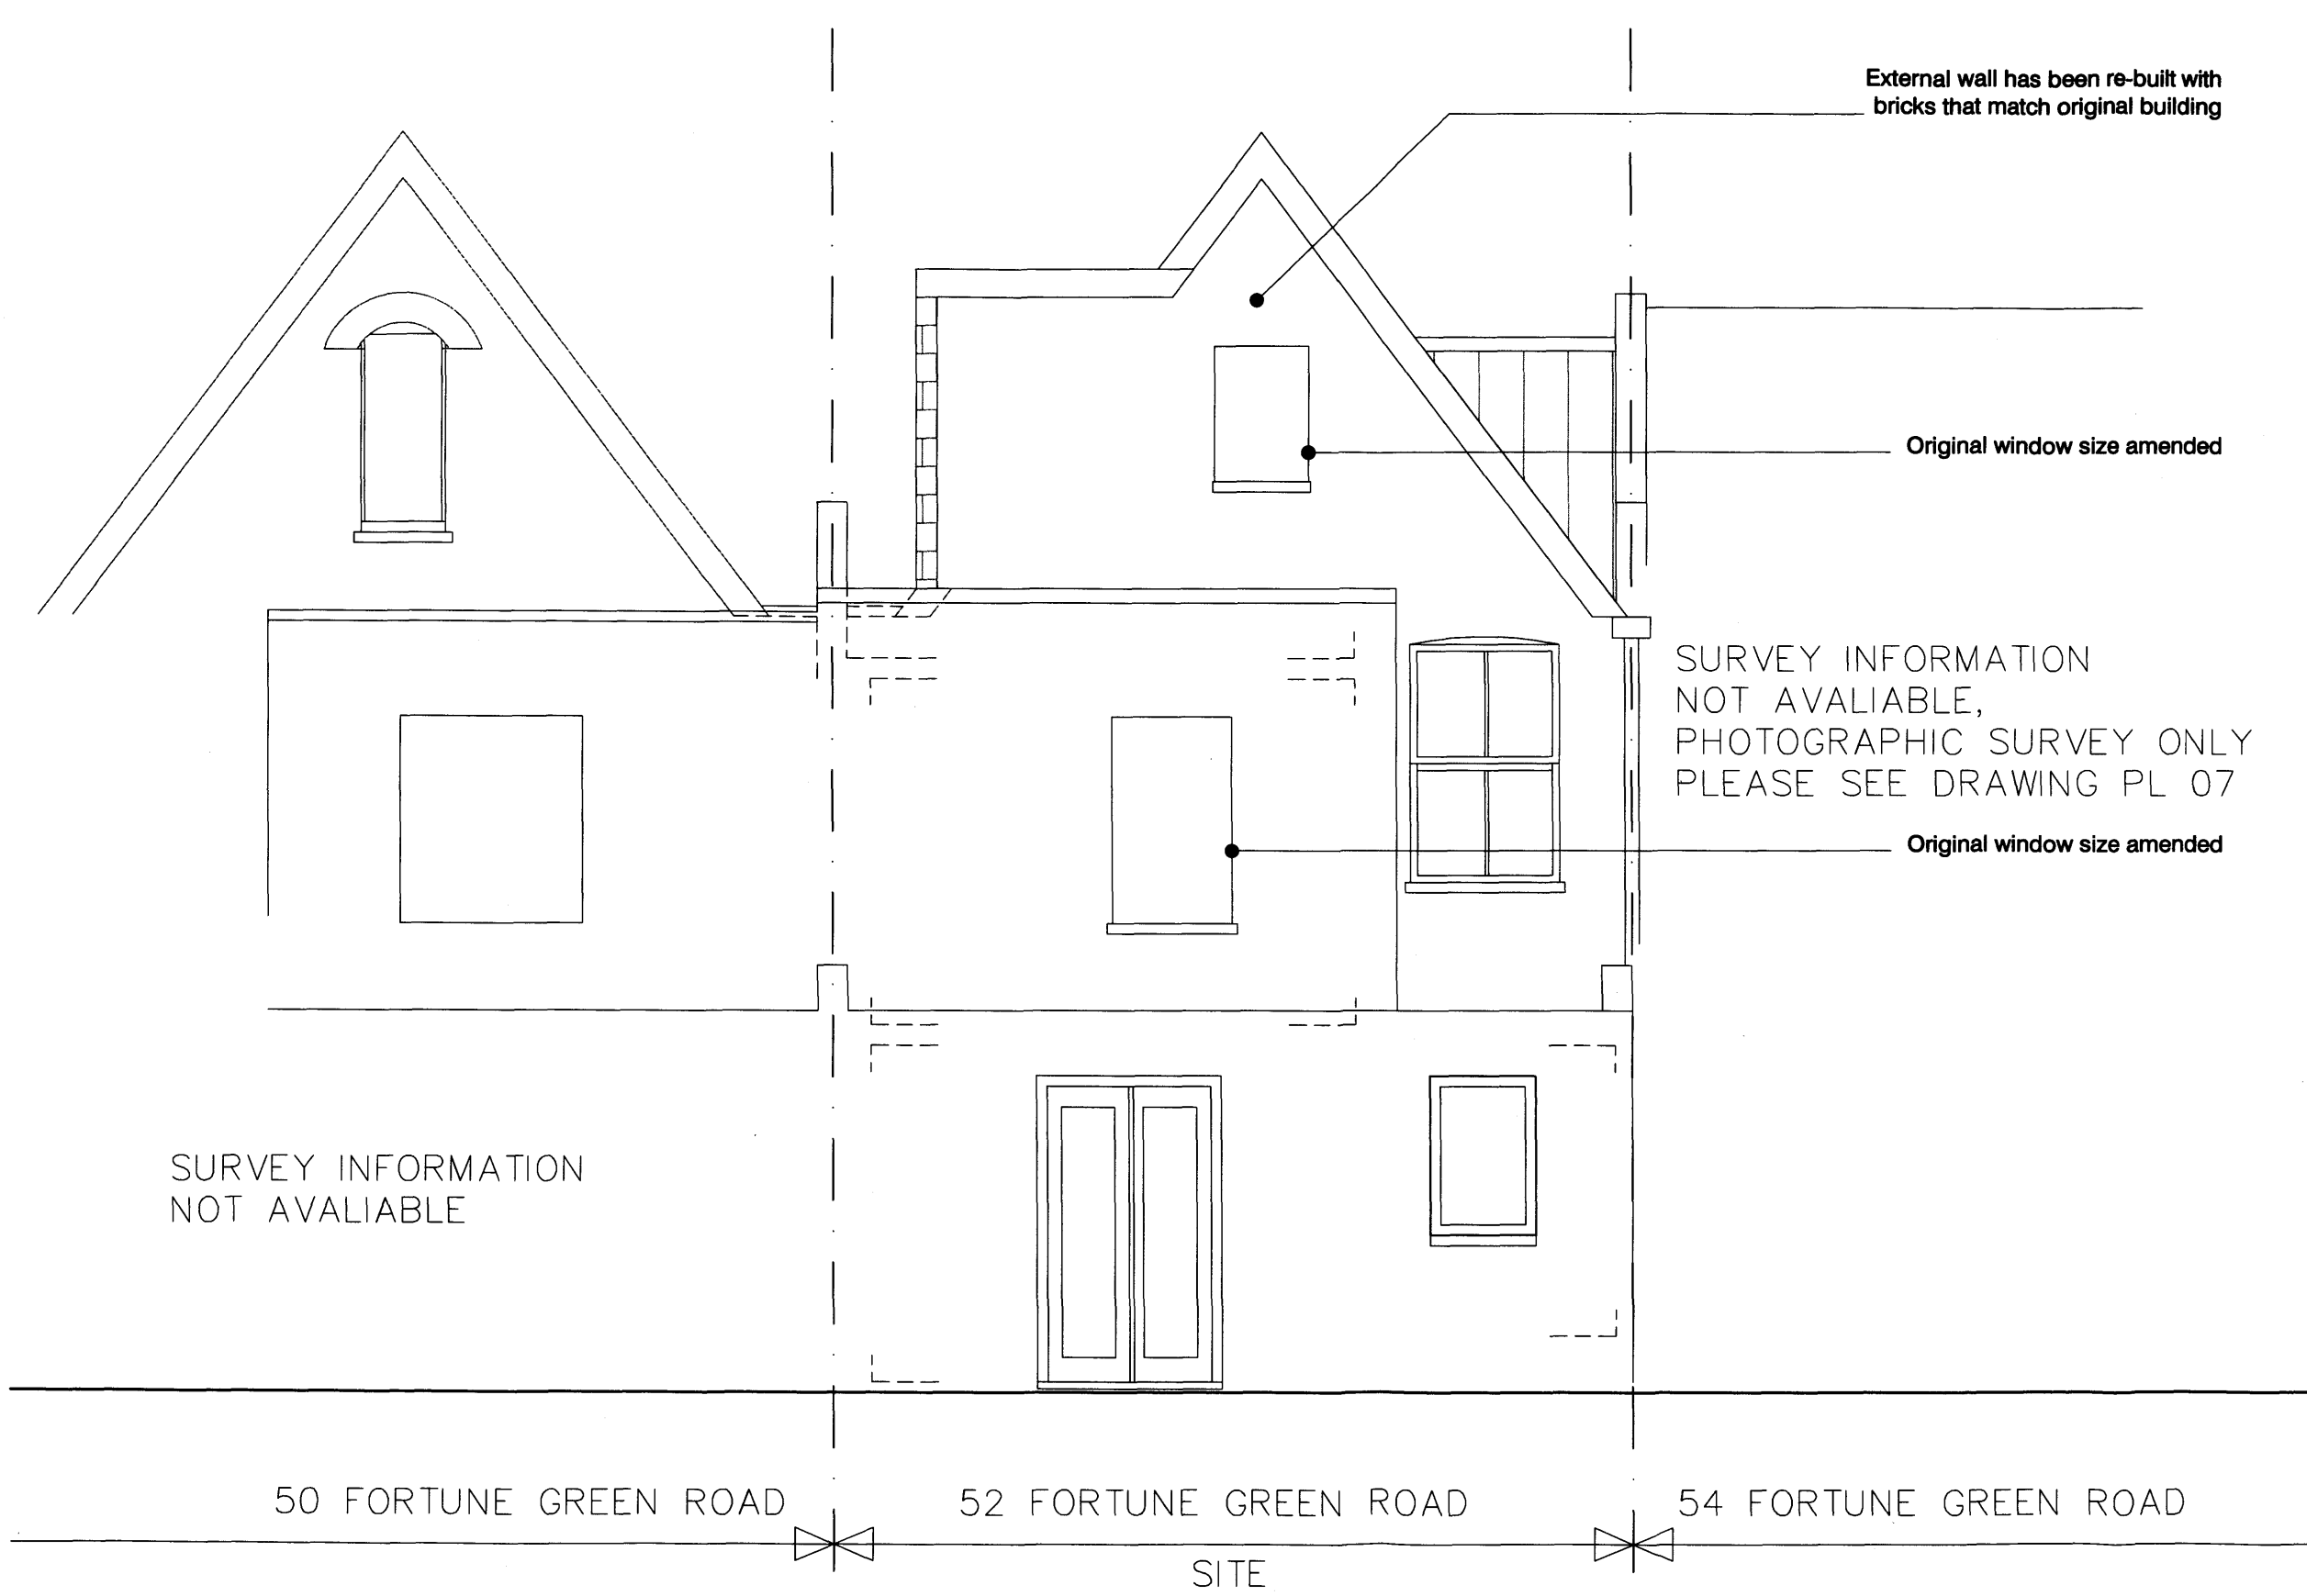

NOTES:

1. Use figured dimensions only. Do not scale.
2. Contractors to notify architect immediately of any dimensional discrepancy.

Revisions:

/ - 11.08 - Submitted as additional information to an Application for Planning Permission

drawing status:			
<b>PLANNING</b>			
job title:			
<b>52 Fortune Green Road</b> London, NW3 1UJ			
client:			
Michel Dadoun			
drg. title:			
<b>REAR ELEVATION</b> As Built			
drawn:	audited:	date:	scale:
/	/	11/08	1:50 / A3
job No:		drg. No:	rev:
0091		PL 31	/

**RECORDED**  
14 NOV 2008

NOTES:


1. Use figured dimensions only. Do not scale.
2. Contractors to notify architect immediately of any dimensional discrepancy.

Revisions:

/ - 11.08 - Submitted as additional information to an Application for Planning Permission



drawing status:				PLANNING	
job title:					
<b>52 Fortune Green Road</b>					
London, NW3 1UJ					
client:					
Michel Dadoun					
dig. title:					
<b>DORMER WINDOW IN ELEVATION</b>					
As Built					
drawn:	audited:	date:	scale:		
/		11/08	1:50 / A3		
job No:		dig. No:		rev:	
0091		PL 32		/	

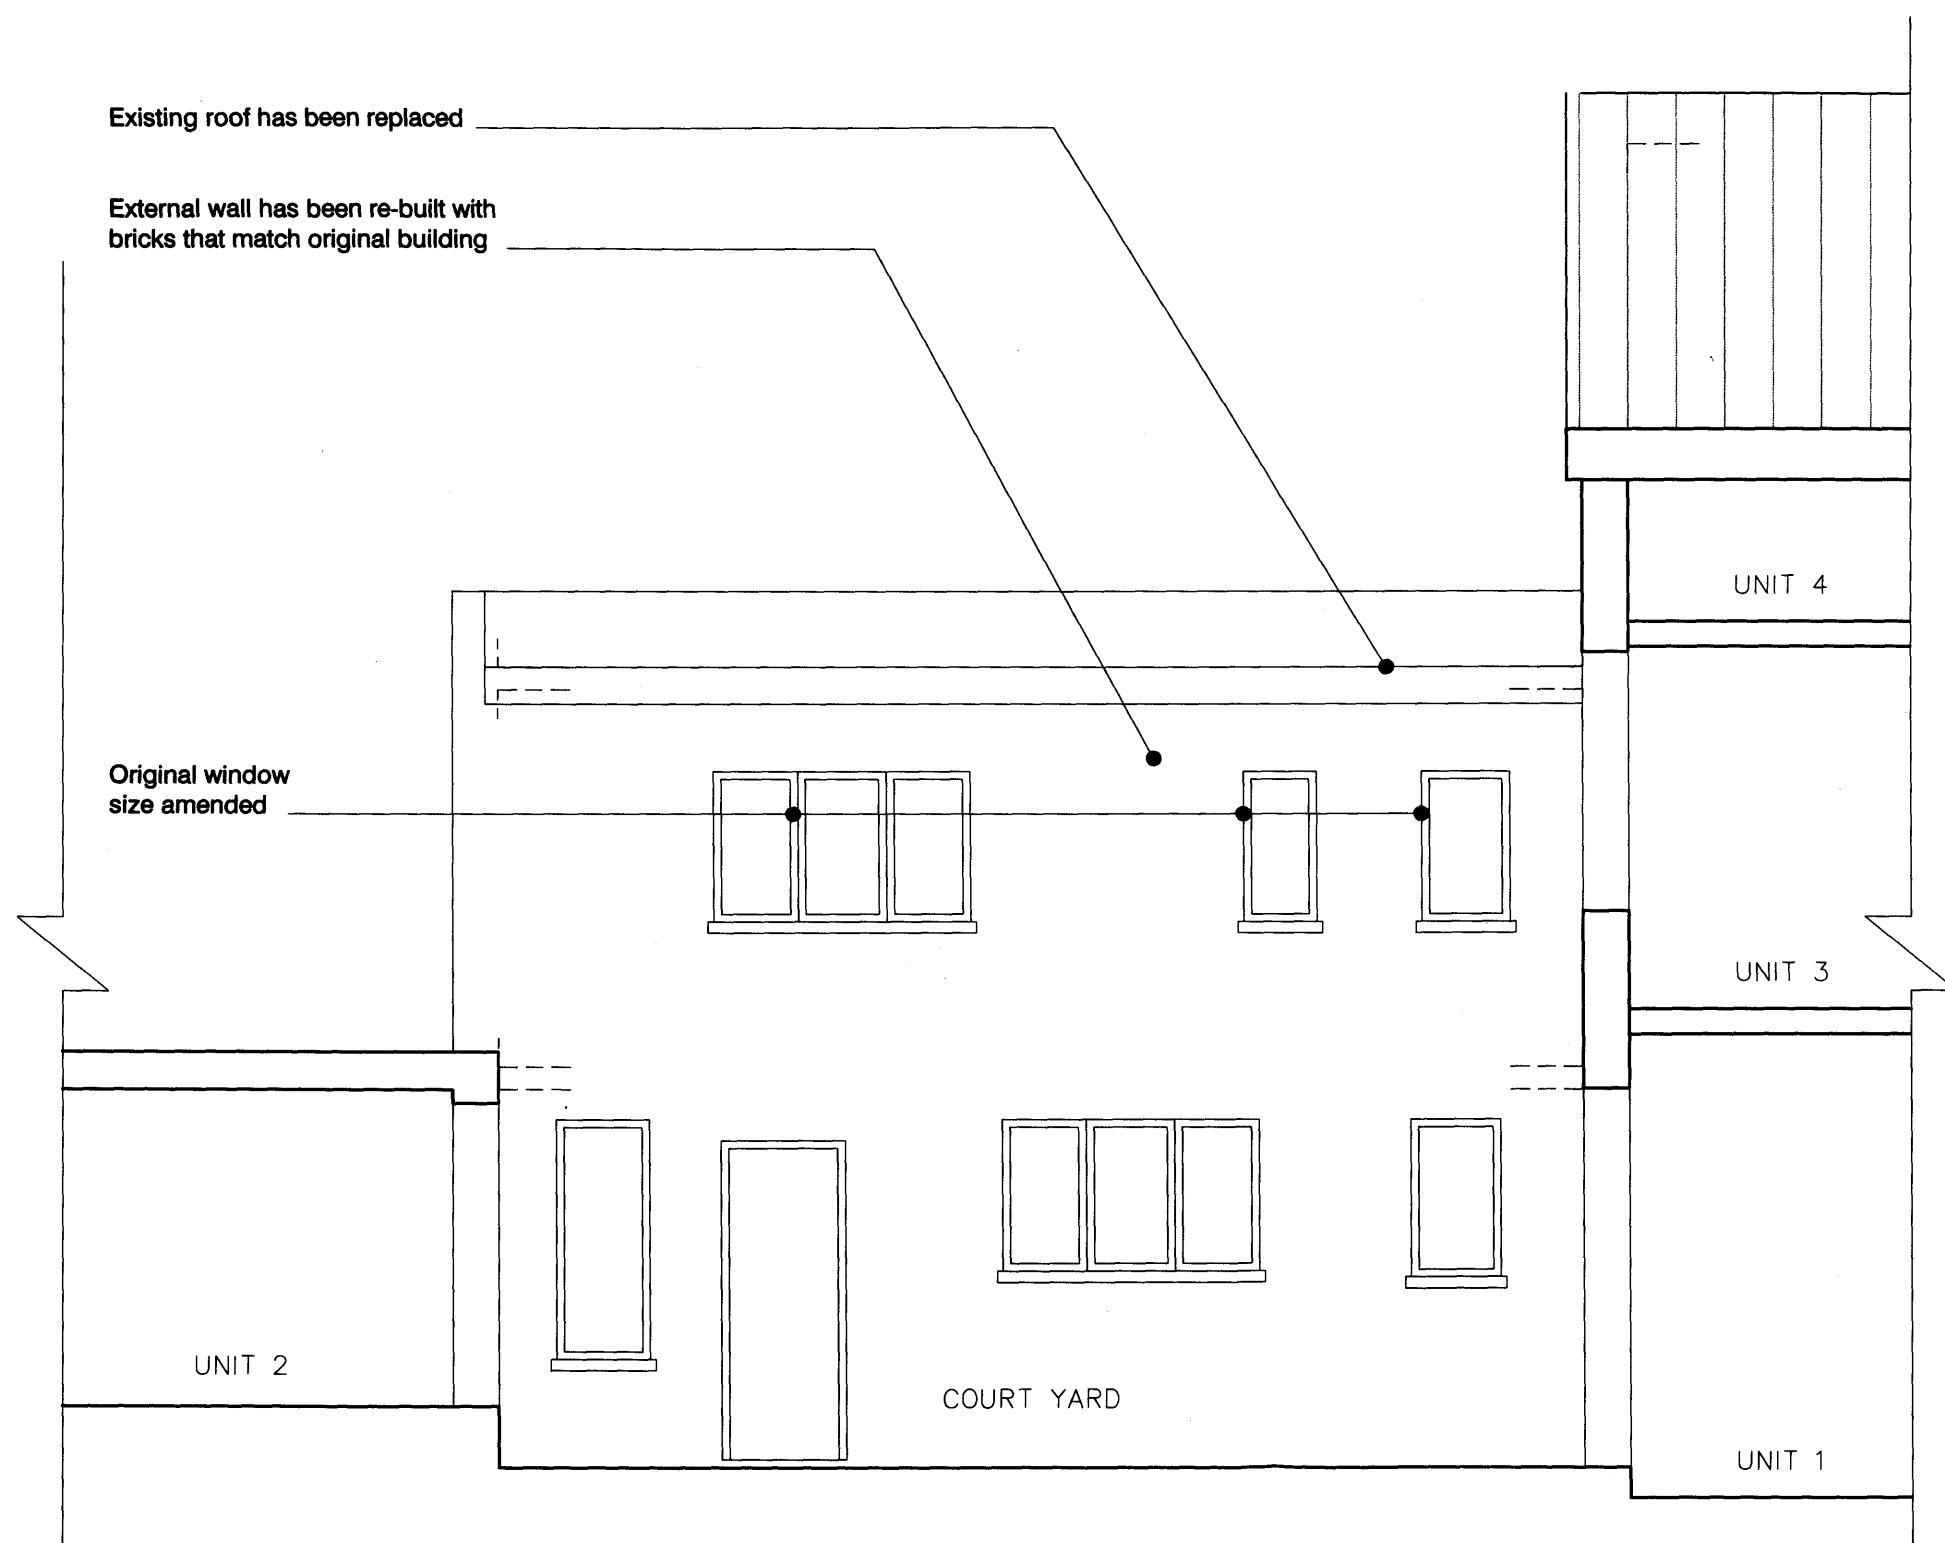

Existing roof has been replaced

External wall has been re-built with bricks that match original building

Original window size amended

UNIT 4

UNIT 3

UNIT 2

COURT YARD

UNIT 1

NOTES:


1. Use figured dimensions only. Do not scale.
2. Contractors to notify architect immediately of any dimensional discrepancy.

Revisions:

/ - 11.08 - Submitted as additional information to an Application for Planning Permission

drawing status:				<b>PLANNING</b>	
job title:				<b>52 Fortune Green Road London, NW3 1UJ</b>	
client:				Michel Dadoun	
drg. title:				<b>COURTYARD ELEVATION As Built</b>	
drawn:	audited:	date:	11/08	scale:	1:50 / A3
job No:	0091	drg. No:	PL 33	rev:	/

Revert back to original window sizes

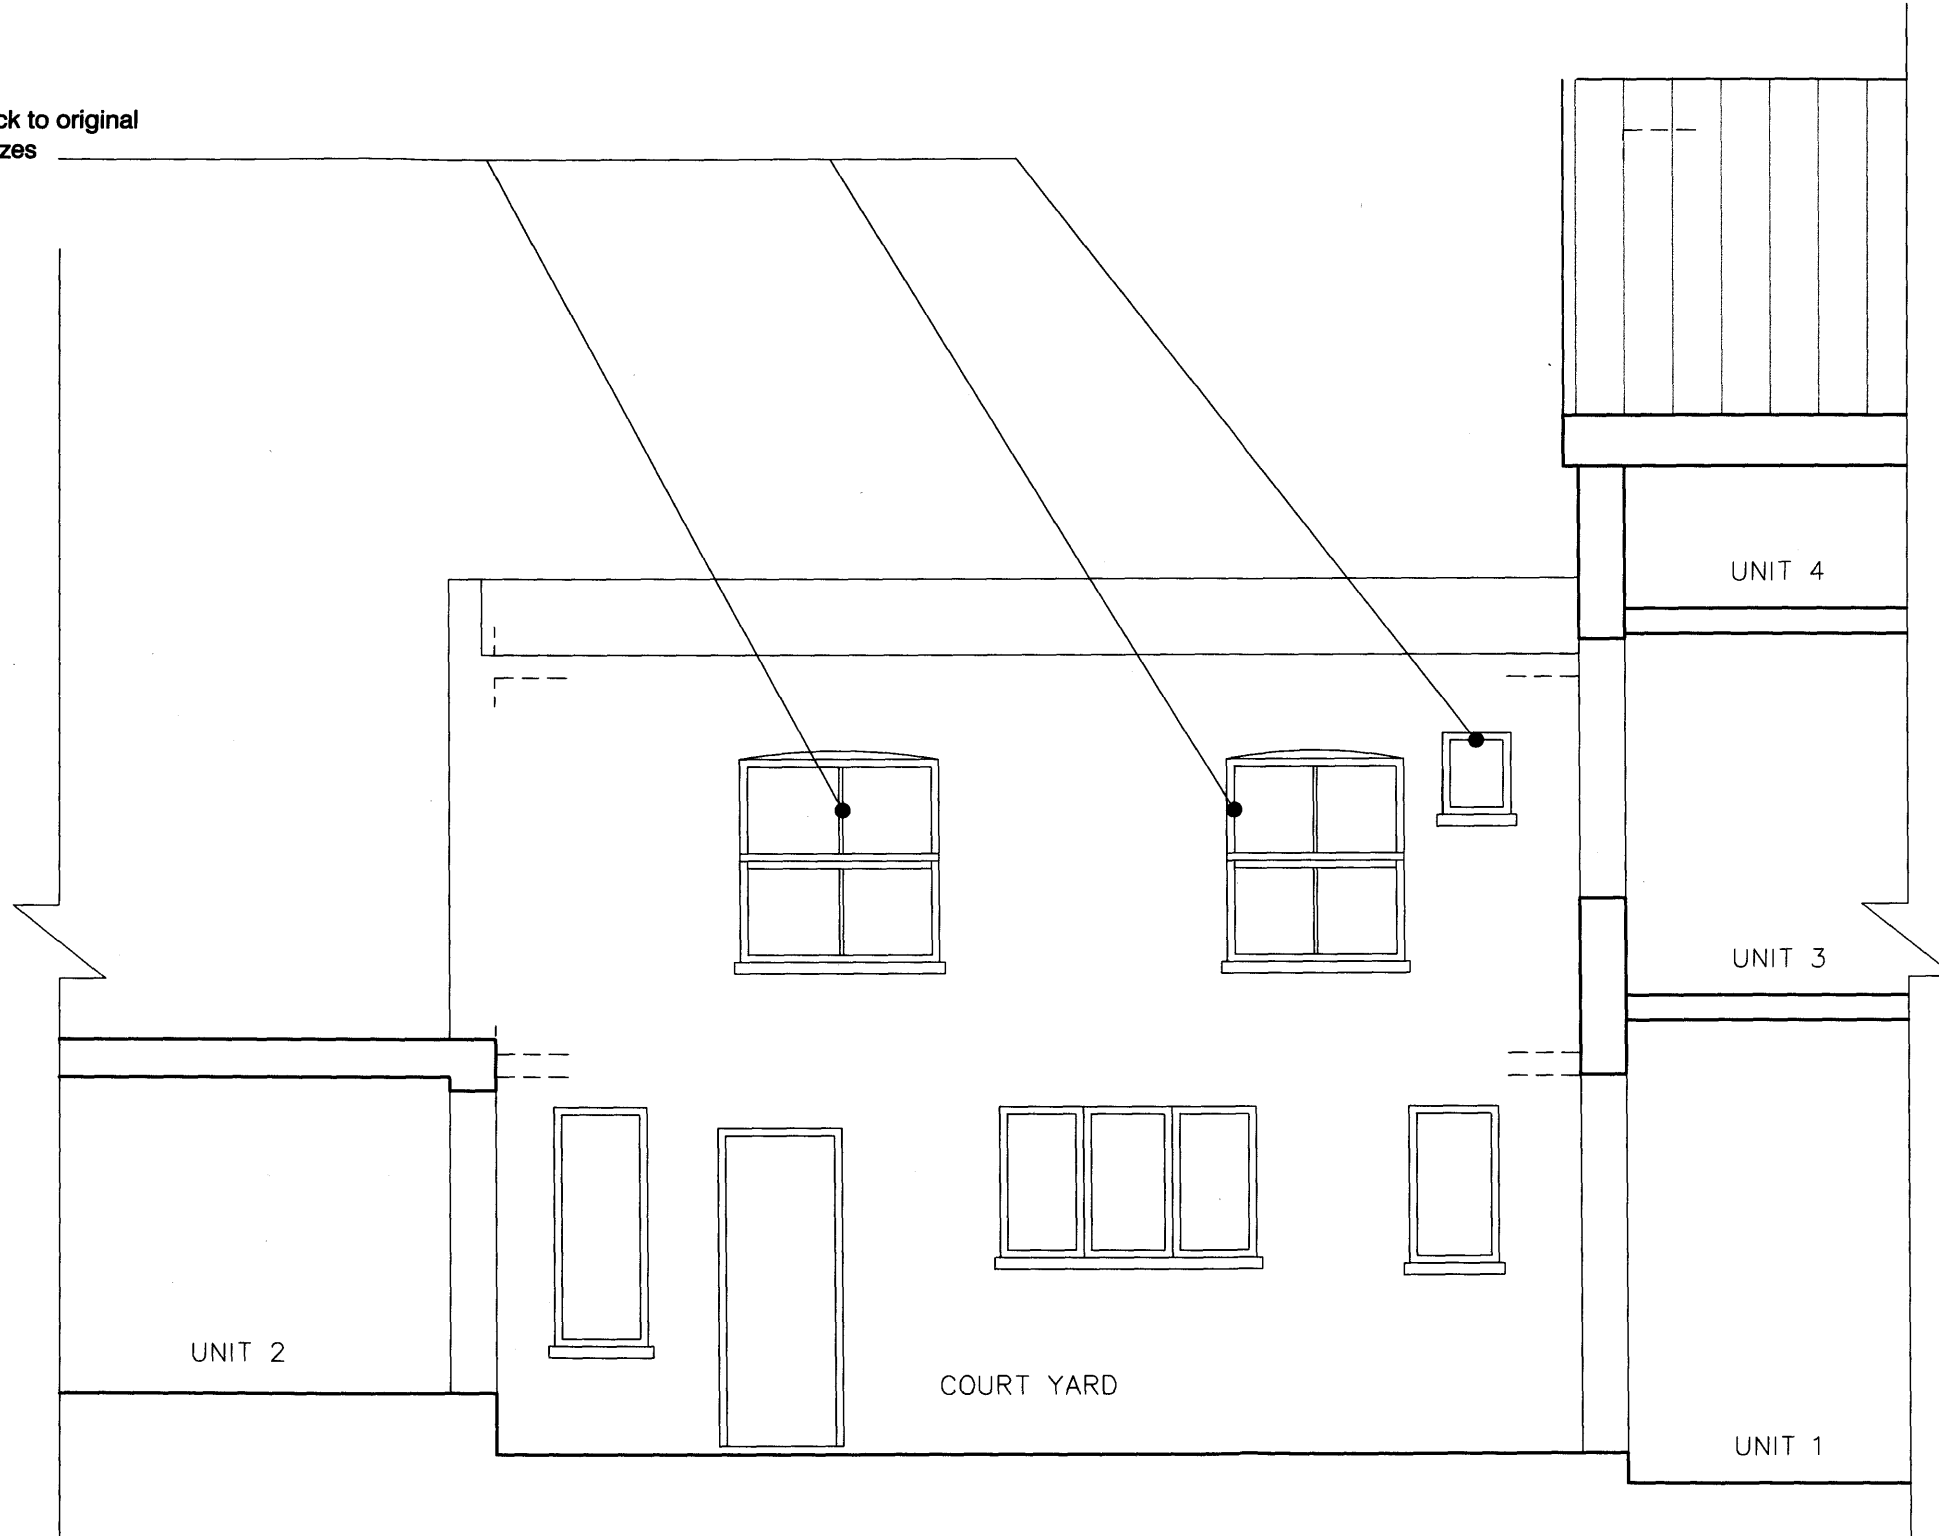

NOTES:

- 1. Use figured dimensions only. Do not scale.
- 2. Contractors to notify architect immediately of any dimensional discrepancy.

Revisions:

/ - 11.08 - Submitted as additional information to an Application for Planning Permission

drawing status:				PLANNING	
job title:				52 Fortune Green Road London, NW3 1UJ	
client:				Michel Dadoun	
drg. title:				COURTYARD ELEVATION Proposed Layouts	
drawn:	audited:	date:	11/08	scale:	1:50 / A3
/	/				
job No:	drg. No:	rev:	0091	PL 34	/