




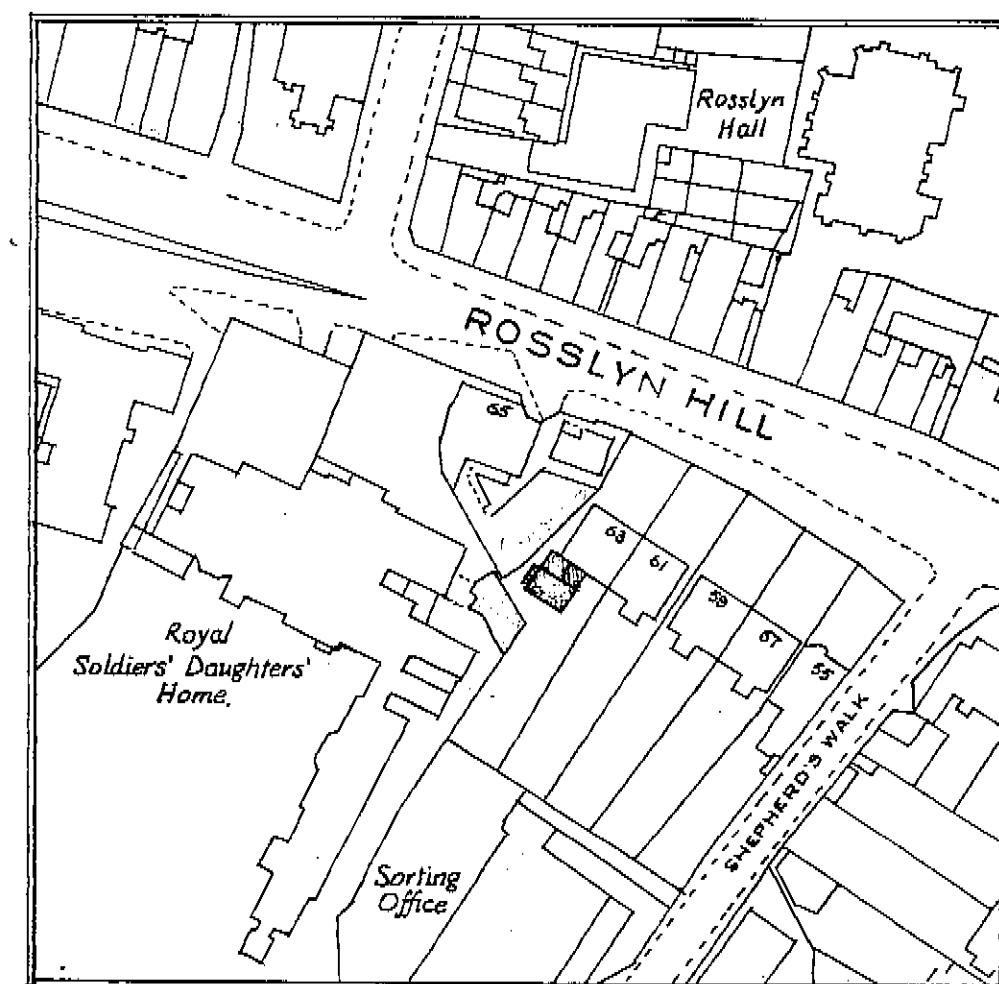


KEY PLAN

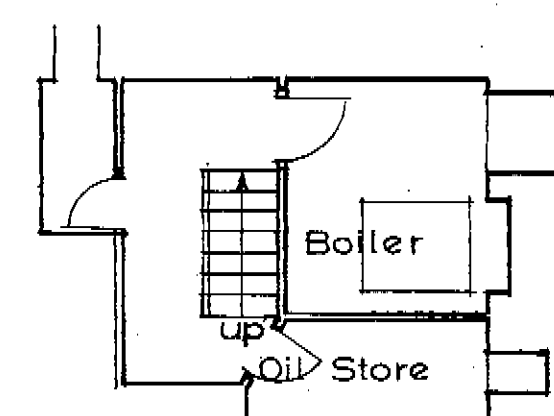


BASEMENT

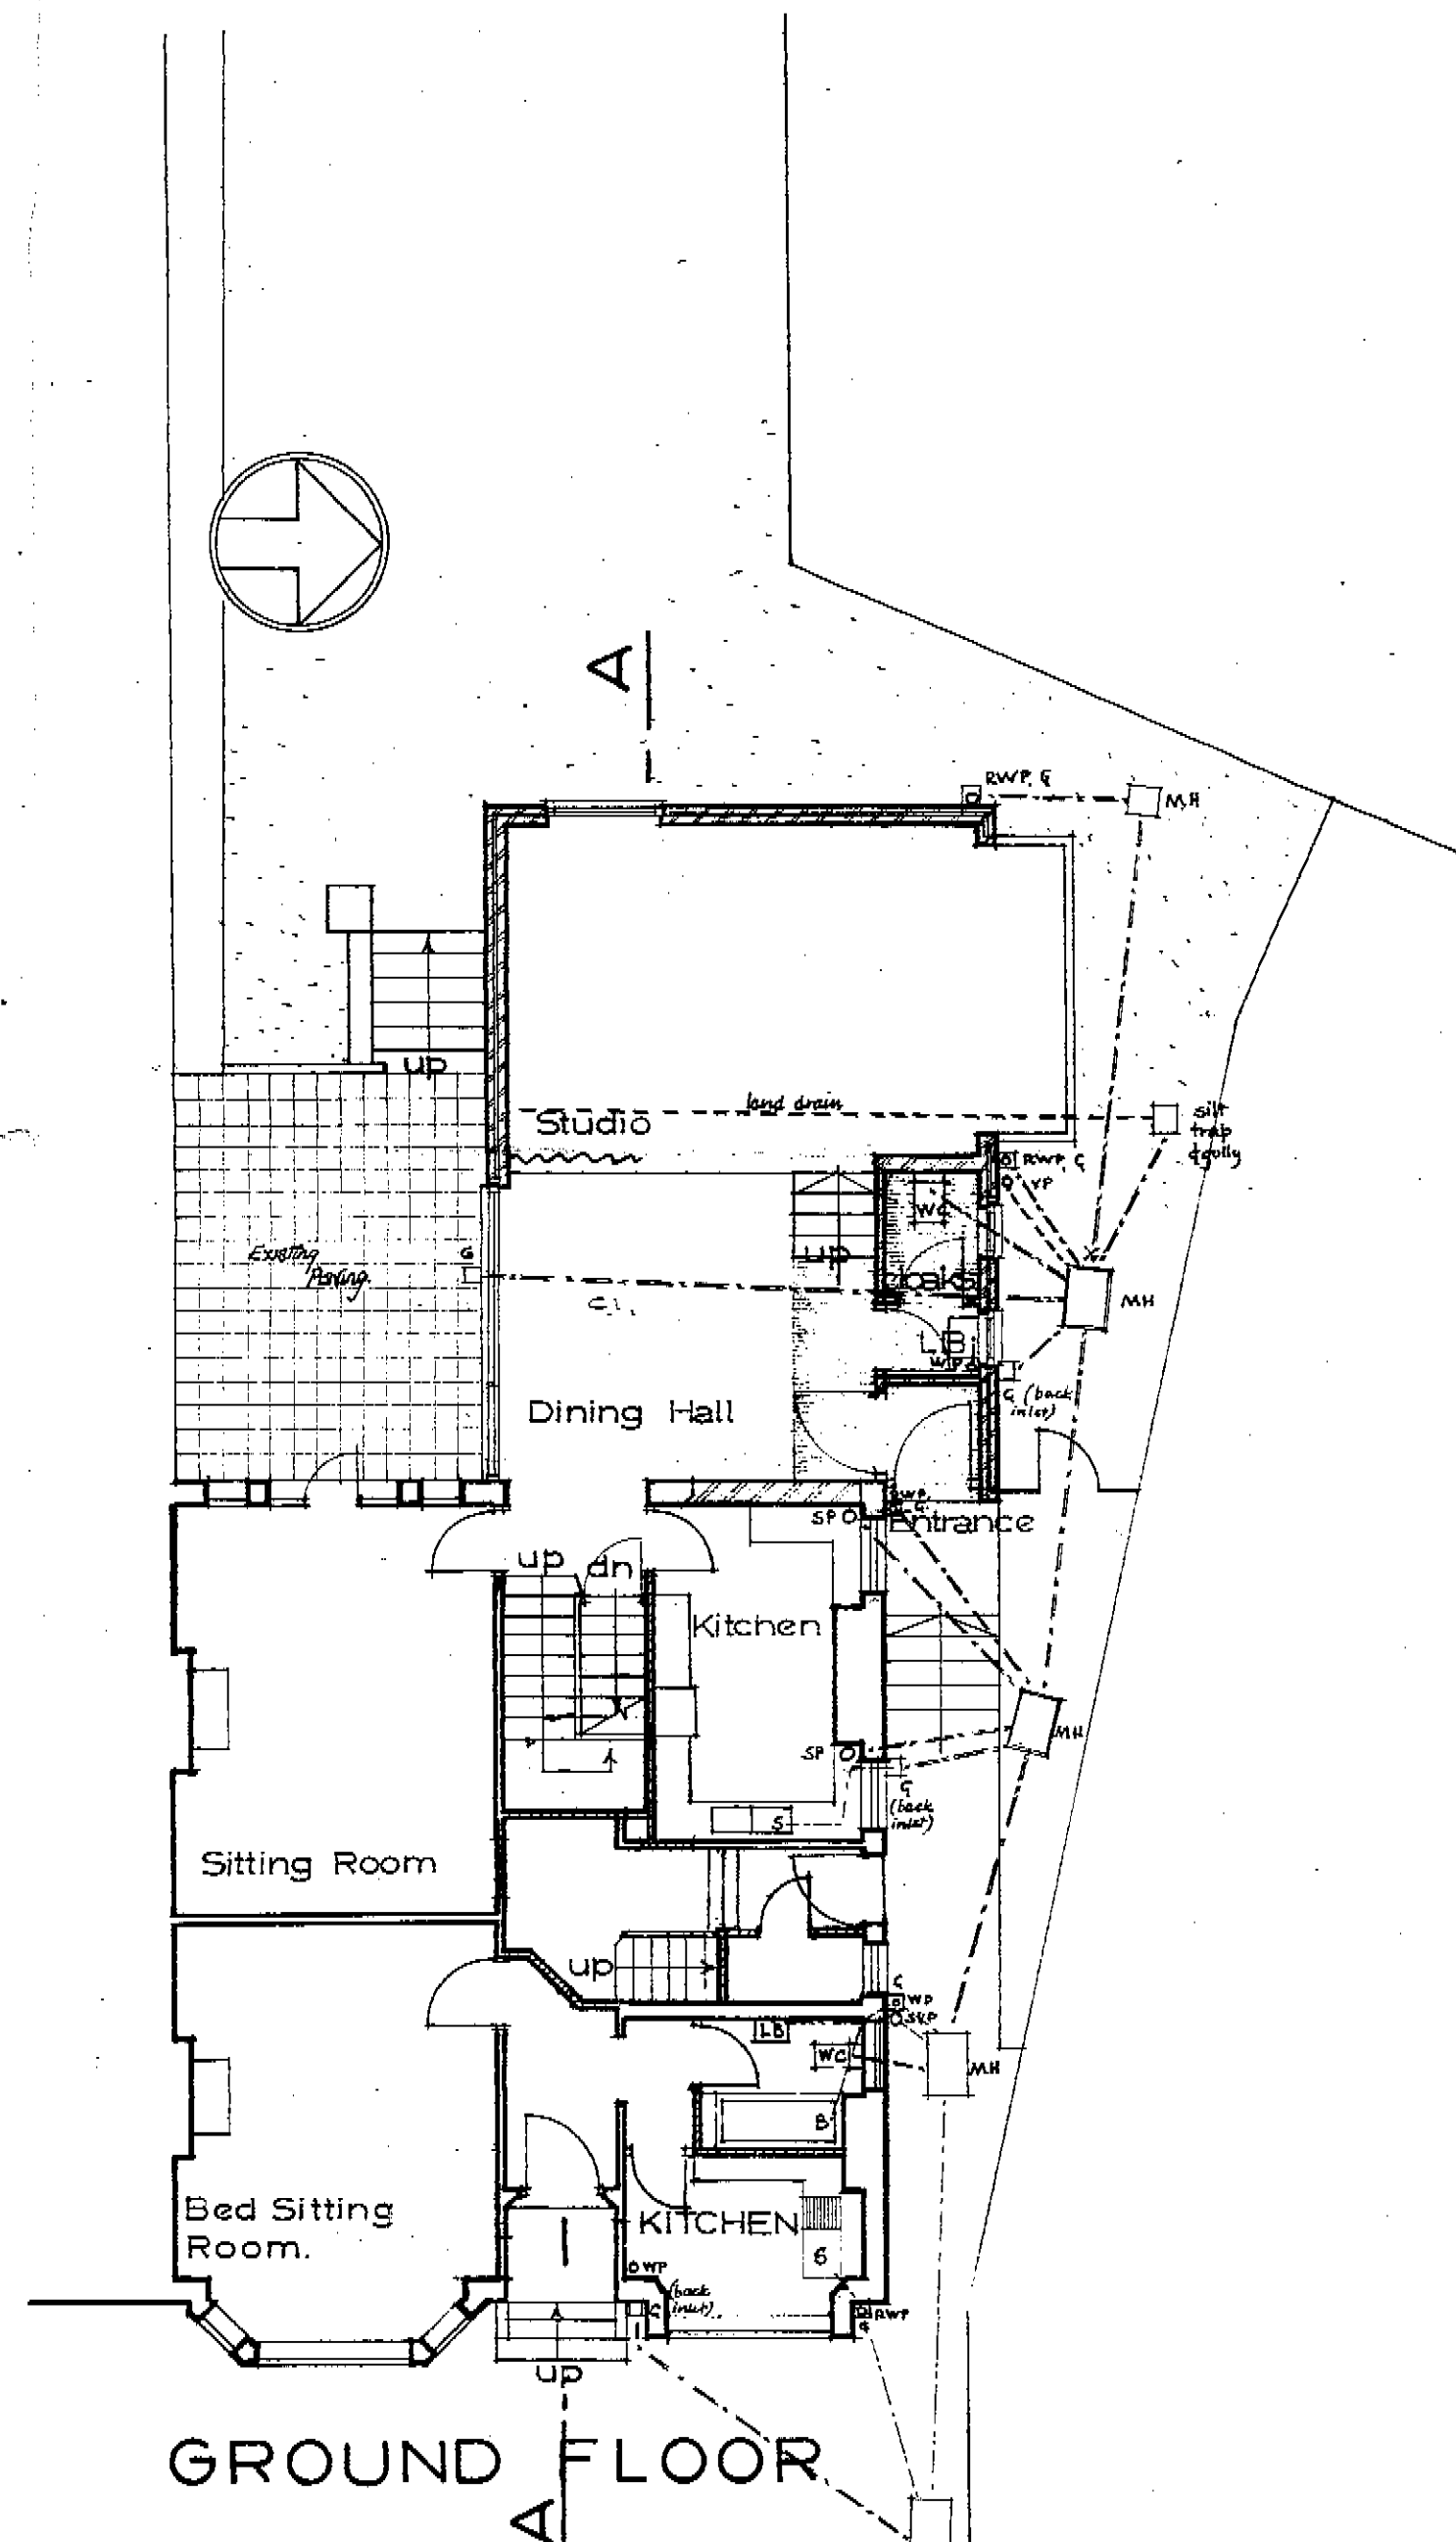


GROUND FLOOR

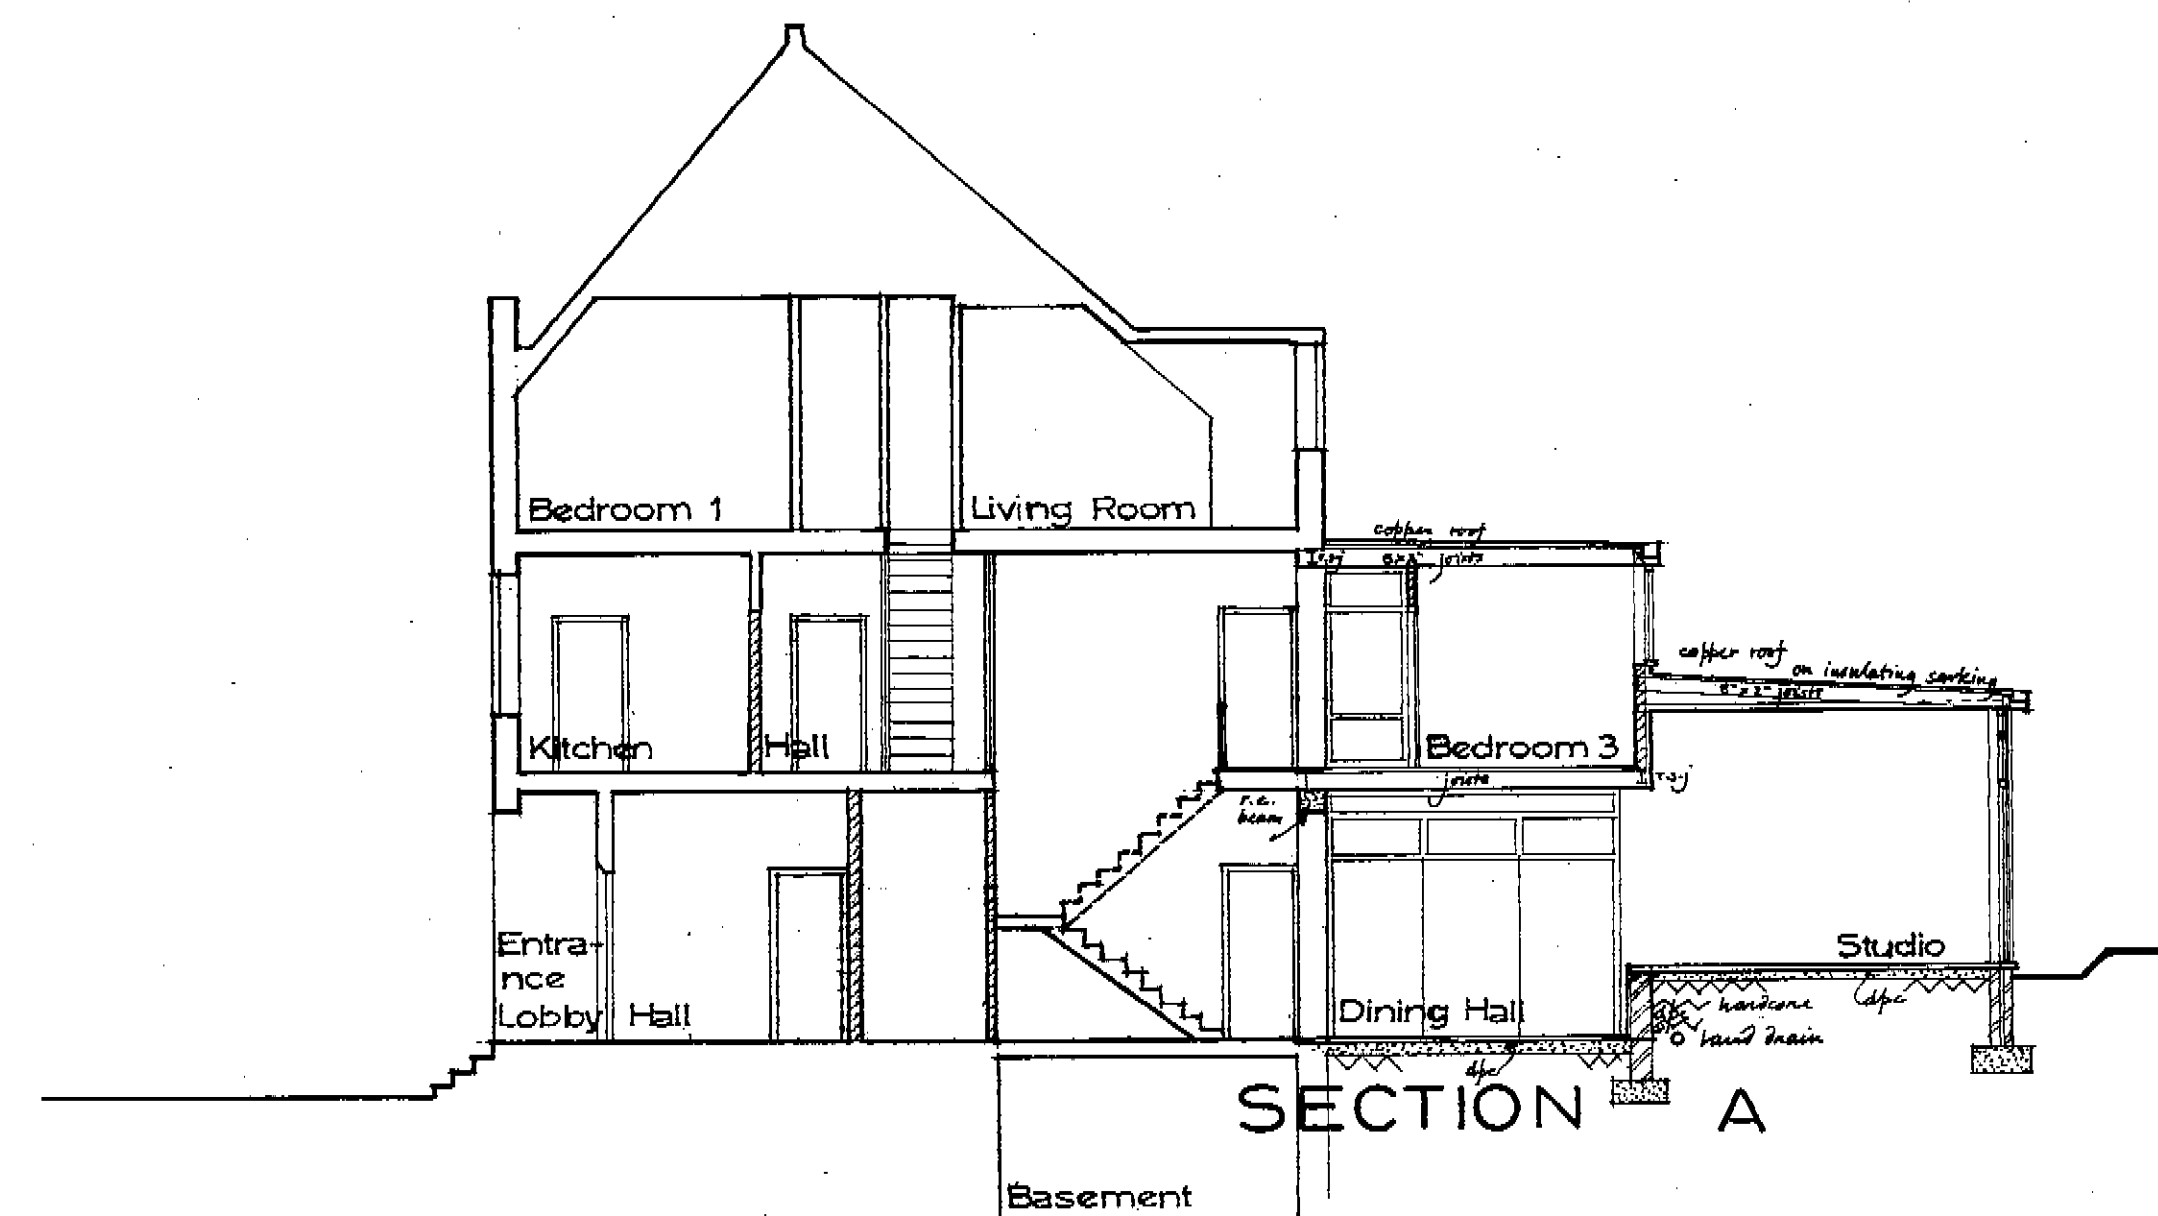

SECTION A

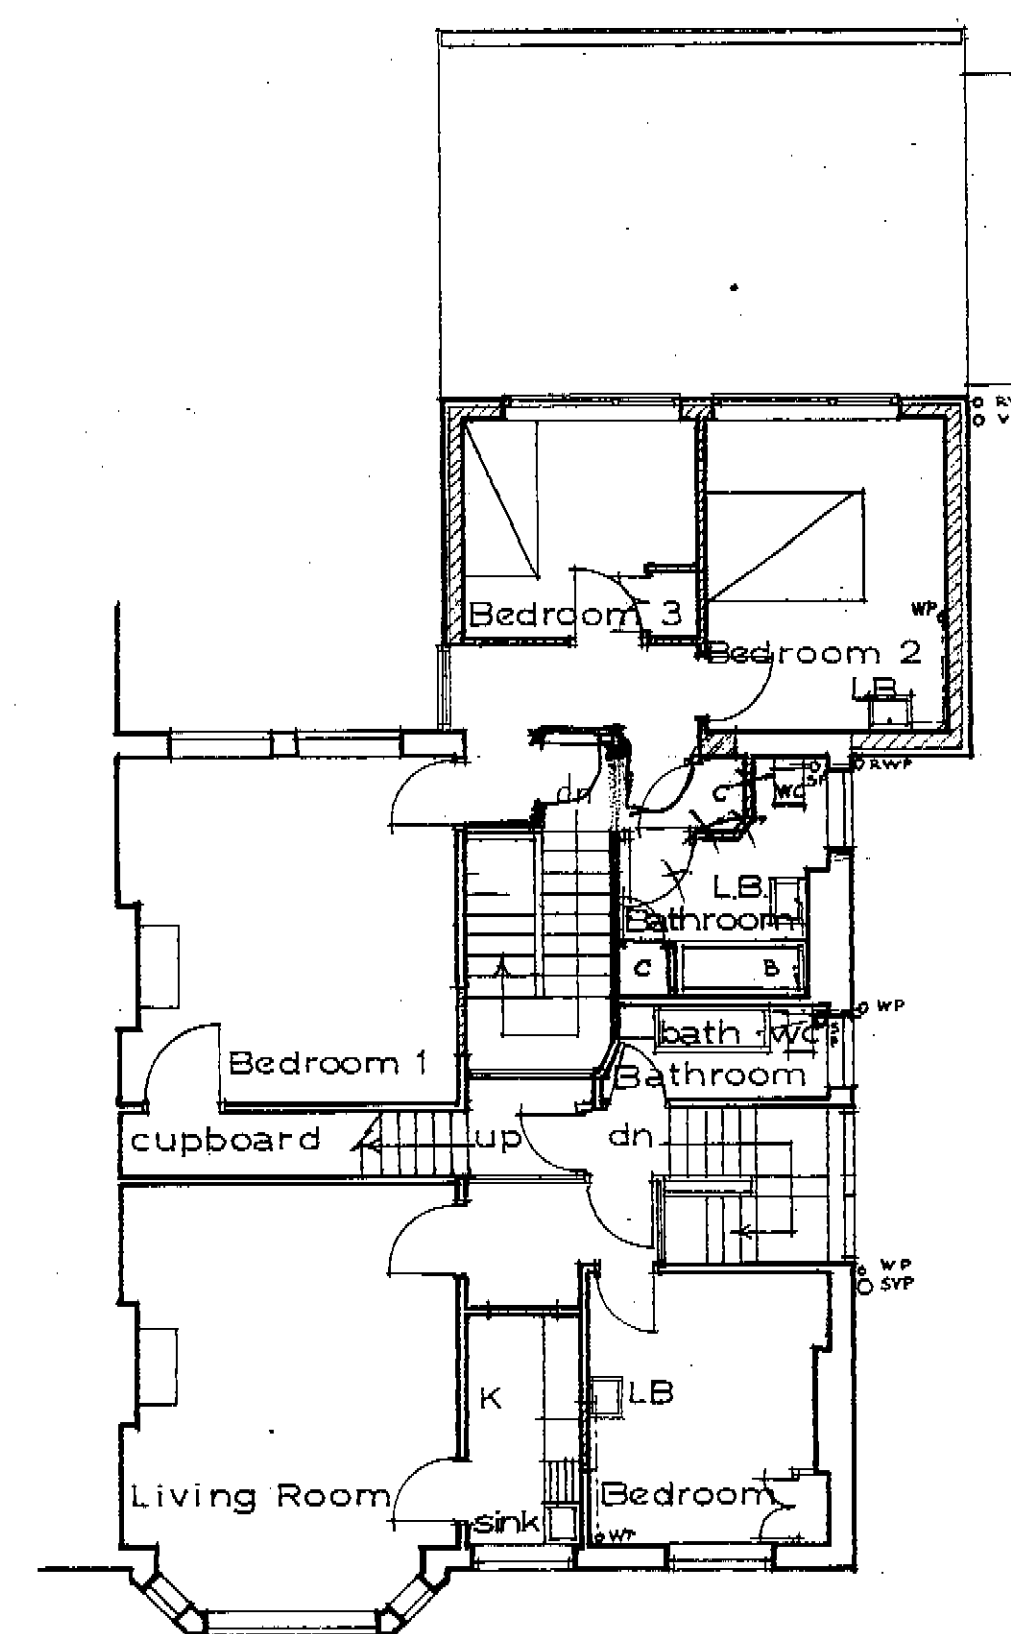

FIRST FLOOR

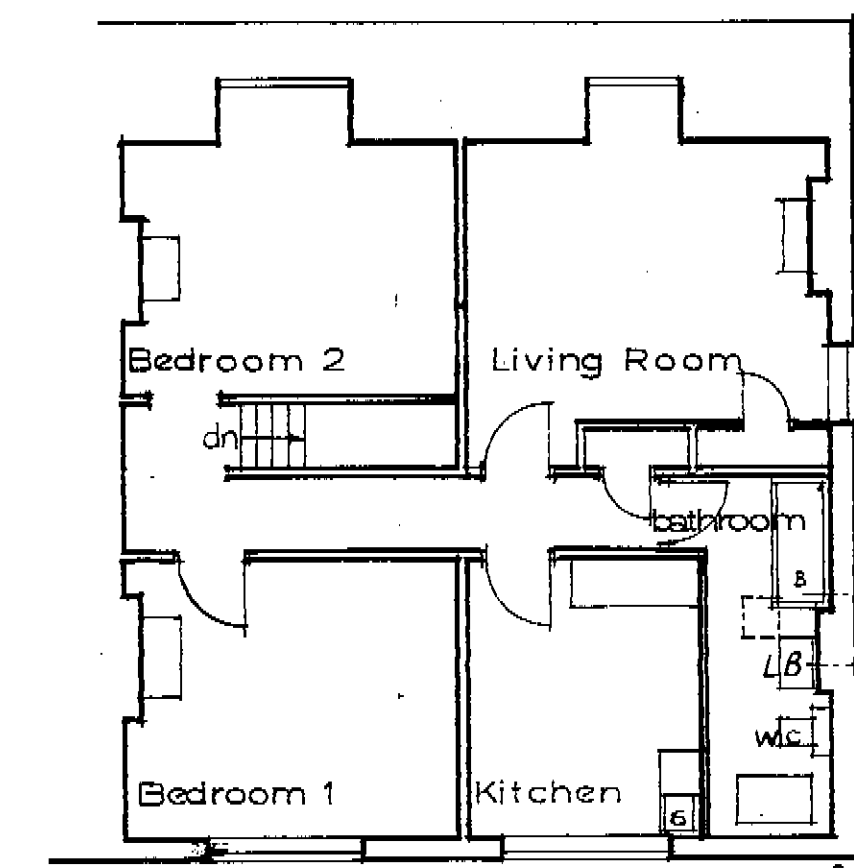

SECOND FLOOR

1291

12 APR 1961


Amendments in red ink
Ansell & Bailey
25-11-61.

DRAWING NO JF2^D
PRINT NO 6
SCALE 1/8" to 1'-0"
DATE February 1961


HOUSE AT ROSSLYN HILL HAMPSTEAD

ANSELL AND BAILEY
CHARTERED ARCHITECTS
12 GRAYS INN SQUARE
LONDON W.C.1.

3/0 32

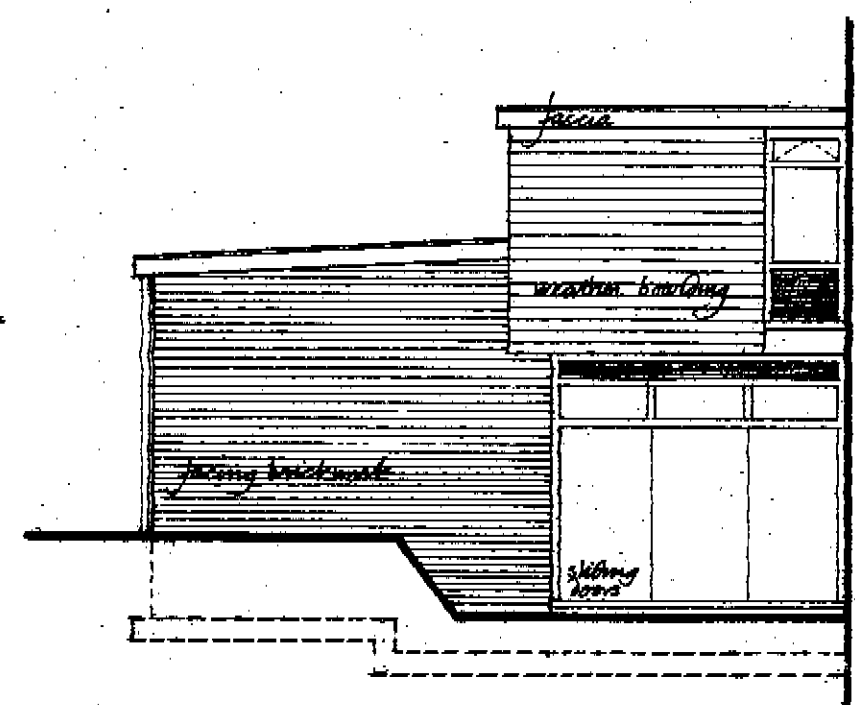


SOUTH
ELEVATION

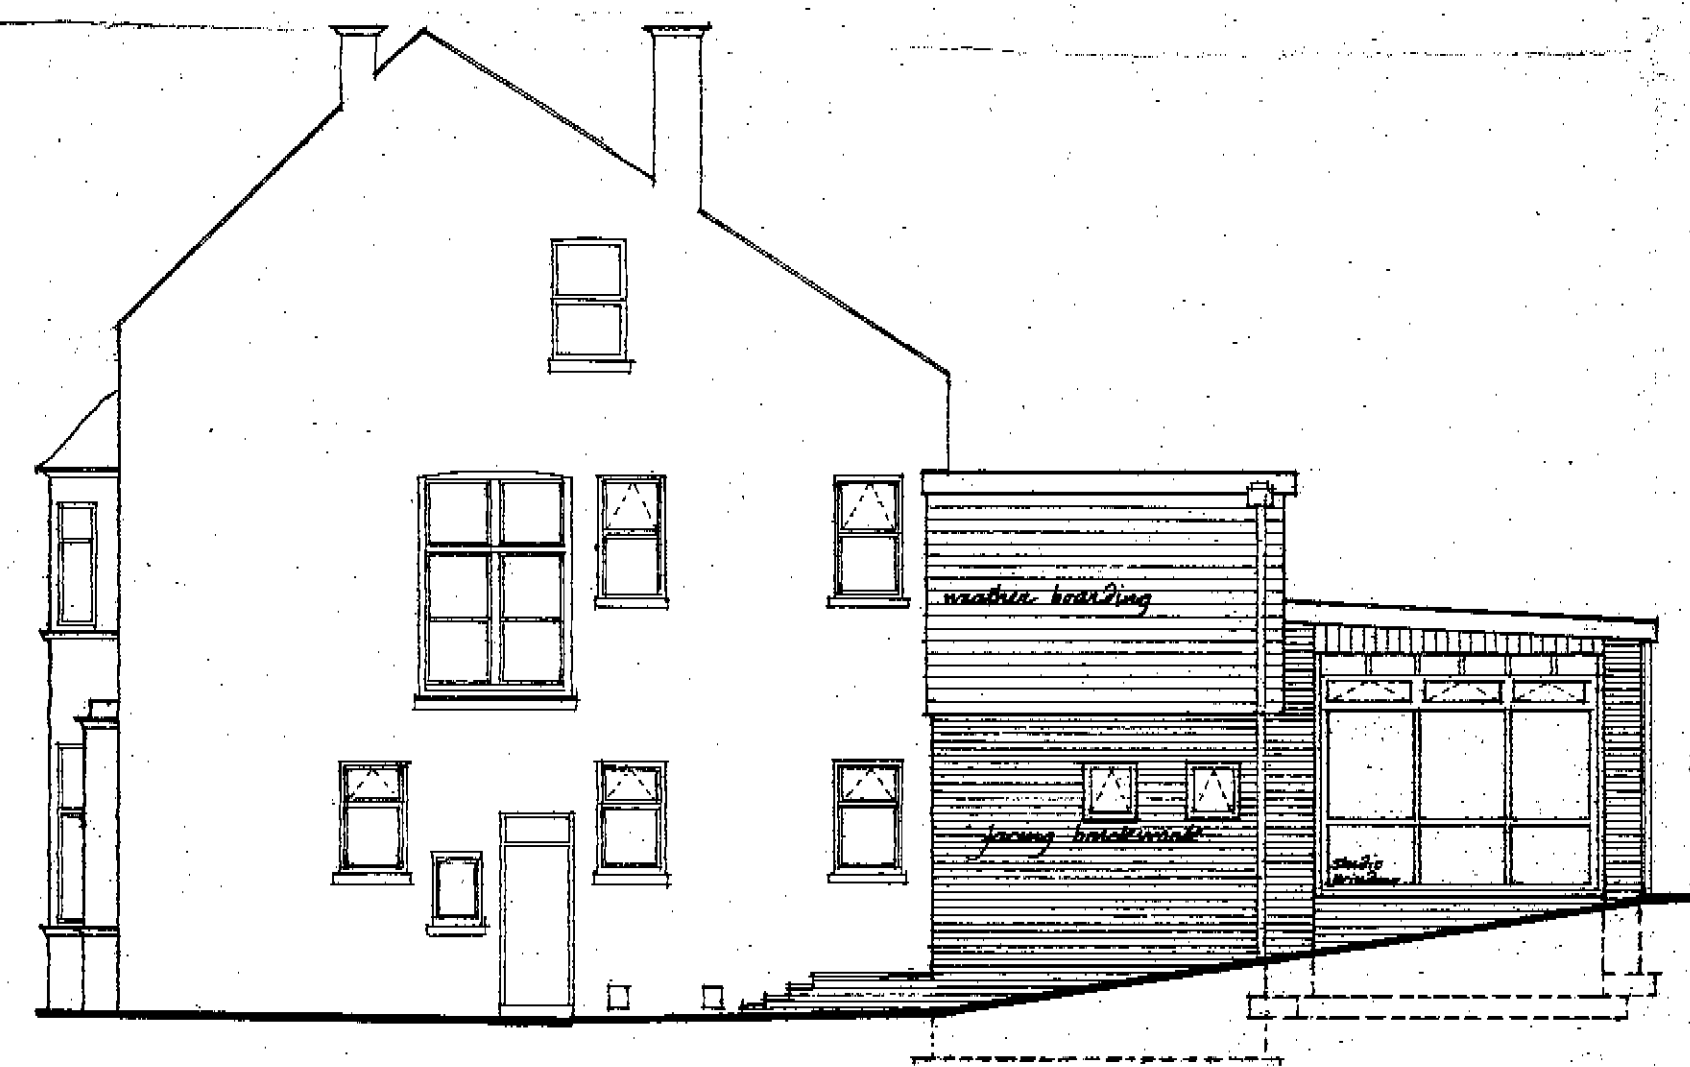

NORTH
ELEVATION



FRONT
ELEVATION

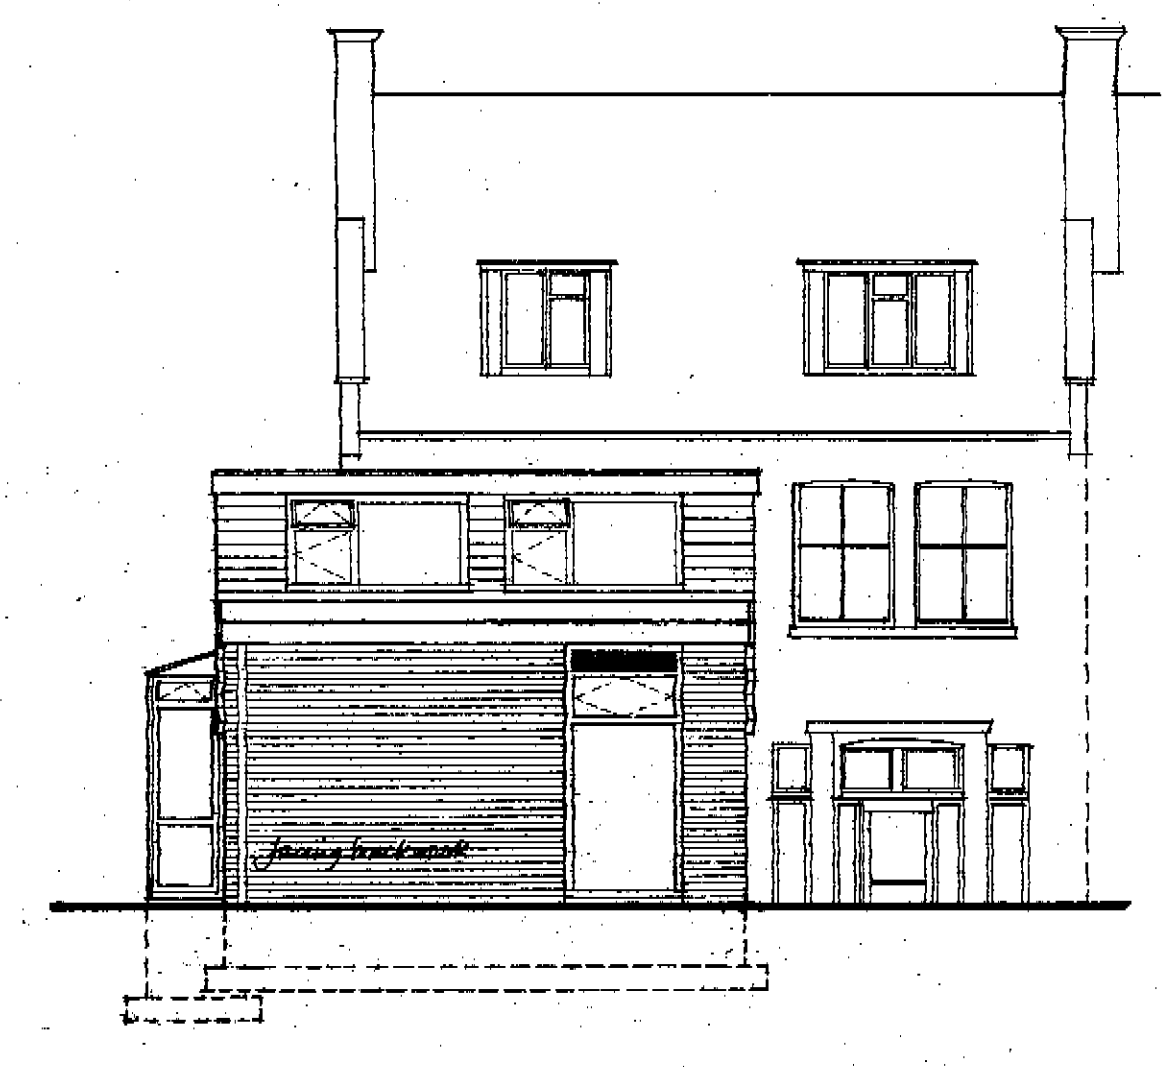

REAR
ELEVATION

1201
17 APR 1961

DRAWING No J.F. 4.
PRINT No 10
SCALE 1/8" TO 1'-0"
DATE APRIL 1960

HOUSE AT ROSSLYN HILL HAMPSTEAD

ANSELL & BAILEY
CHARTERED ARCHITECTS
12 GRAYS INN SQUARE
LONDON, W.C.1.