

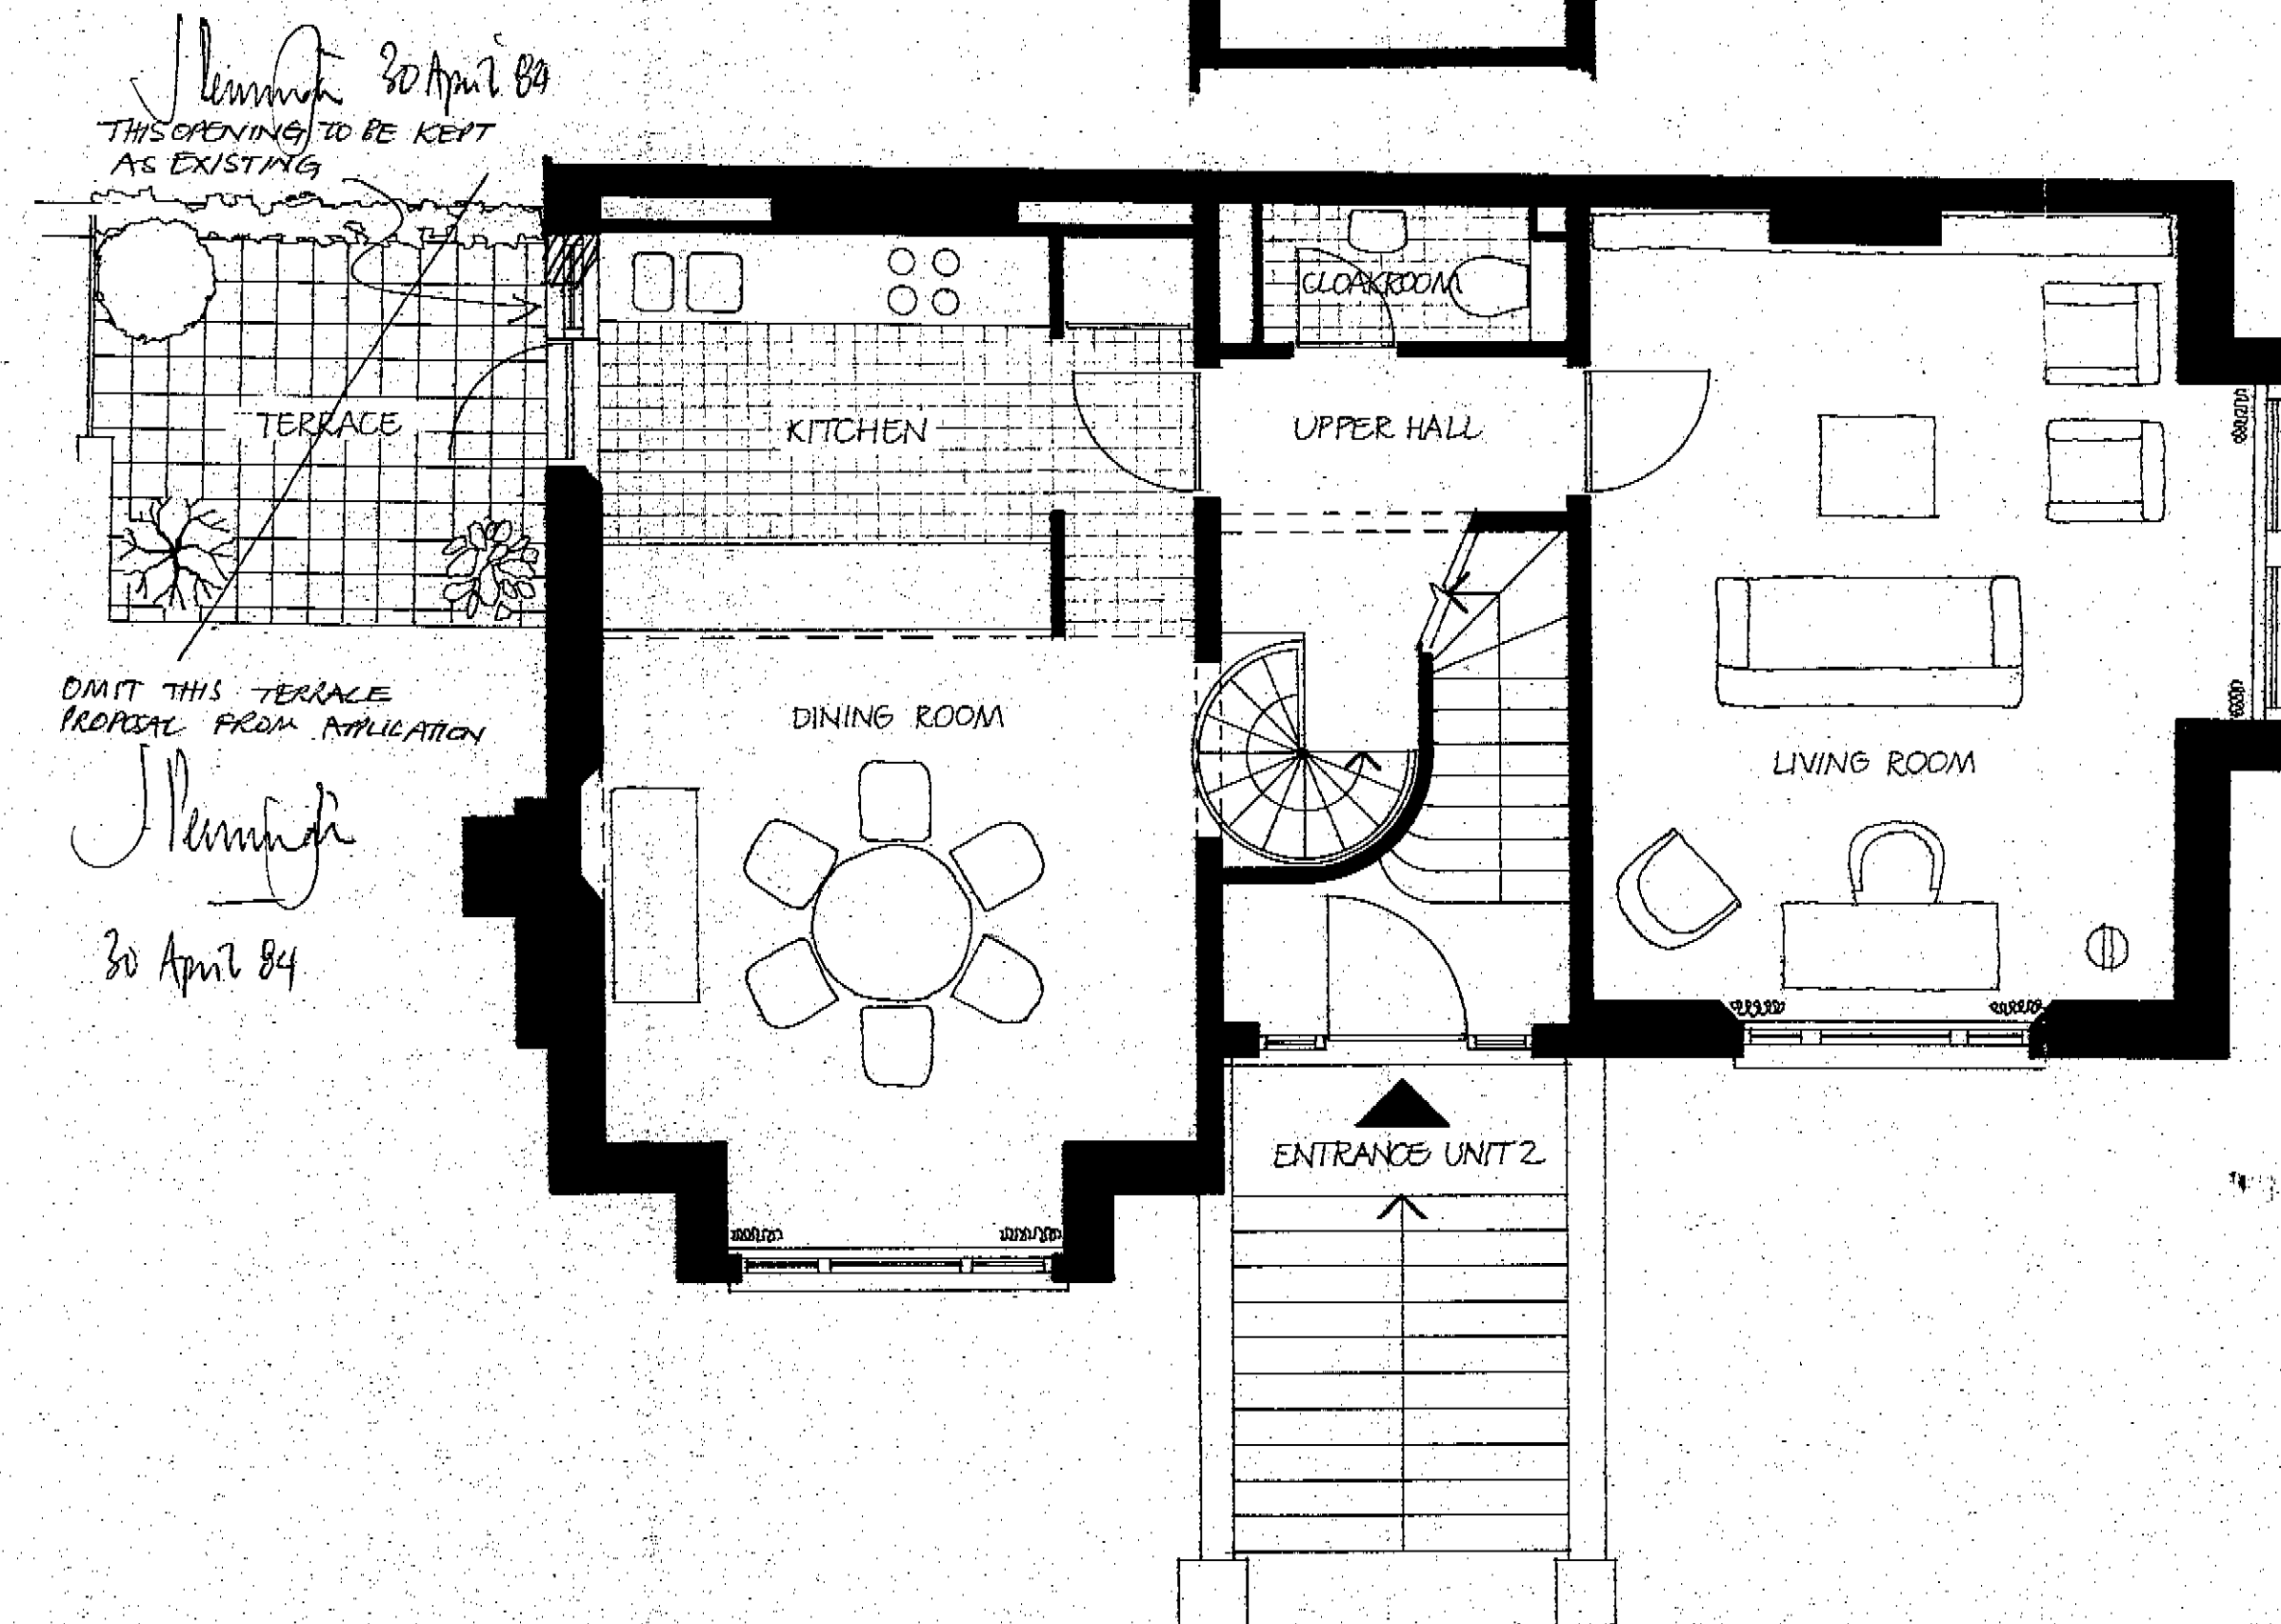


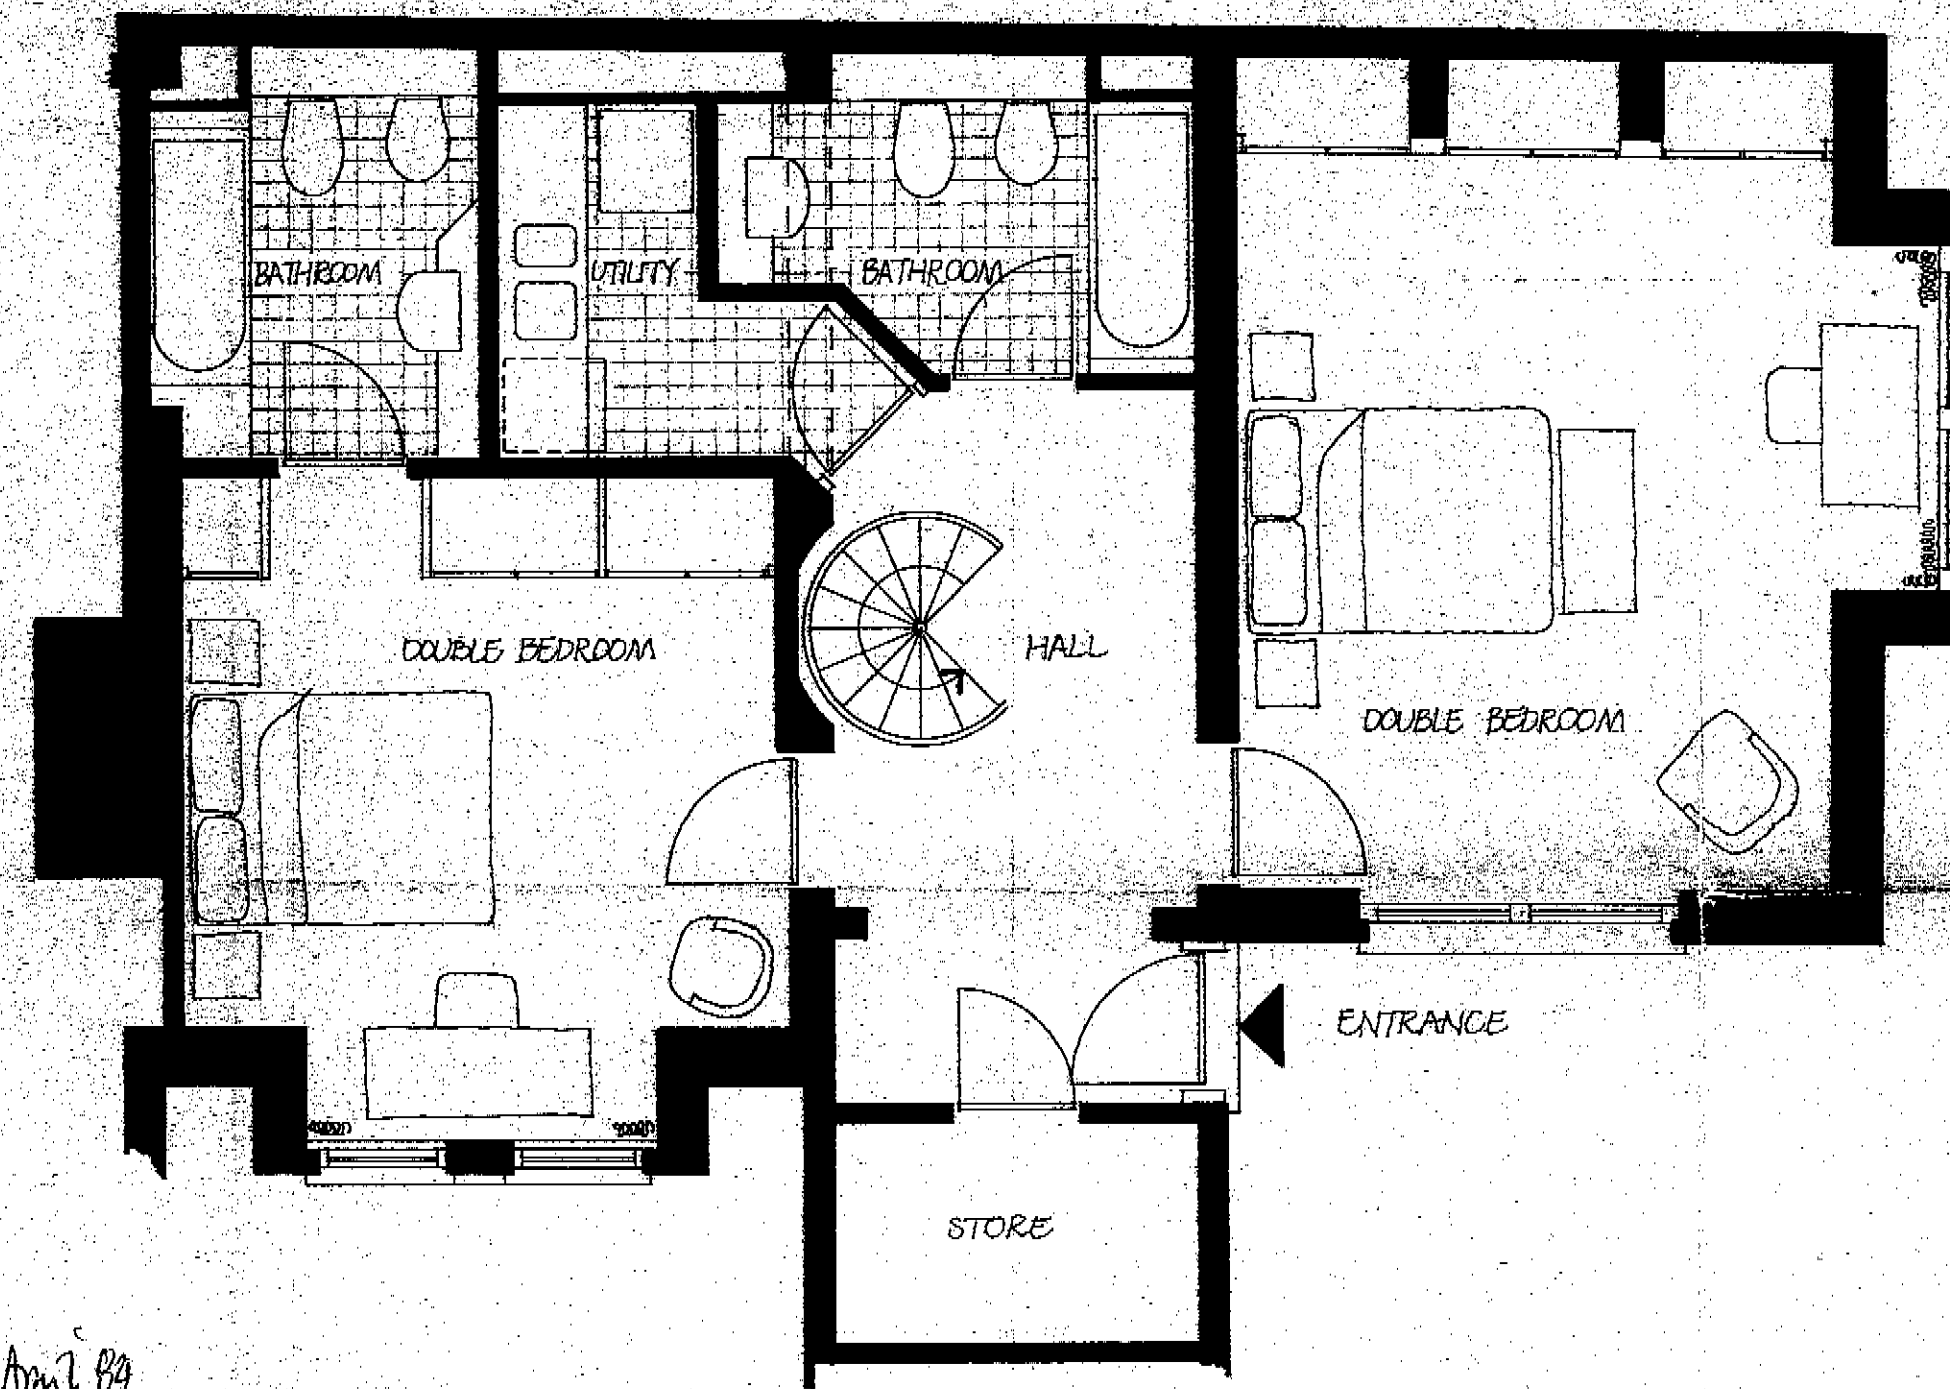


LONDON BOROUGH OF CAMDEN
TOWN AND COUNTRY PLANNING ACTS
- 9 MAY 1984
PLANS ~~NOT APPROVED~~ APPROVED
ON BEHALF OF THE COUNCIL

PLANNING AND COMMUNICATION
DEPARTMENT
CTP/ET/16/8/8400401
VOL. _____
ACK. _____
REFERRED TO _____

date	revision
Client THE STUART CHILDREN TRUST	
Job CONVERSION 10 WILLOUGHBY ROAD PAMPSTEAD LONDON NW3	
Dwg. PROPOSED LOWER GROUND FLOOR PLAN	
scale 1:50	date FEBRUARY 1984
BENNETT & PENNINGTON 122 Tottenham Avenue London NW5 2RY 01 267 4233	
Dwg. no.	WR:110

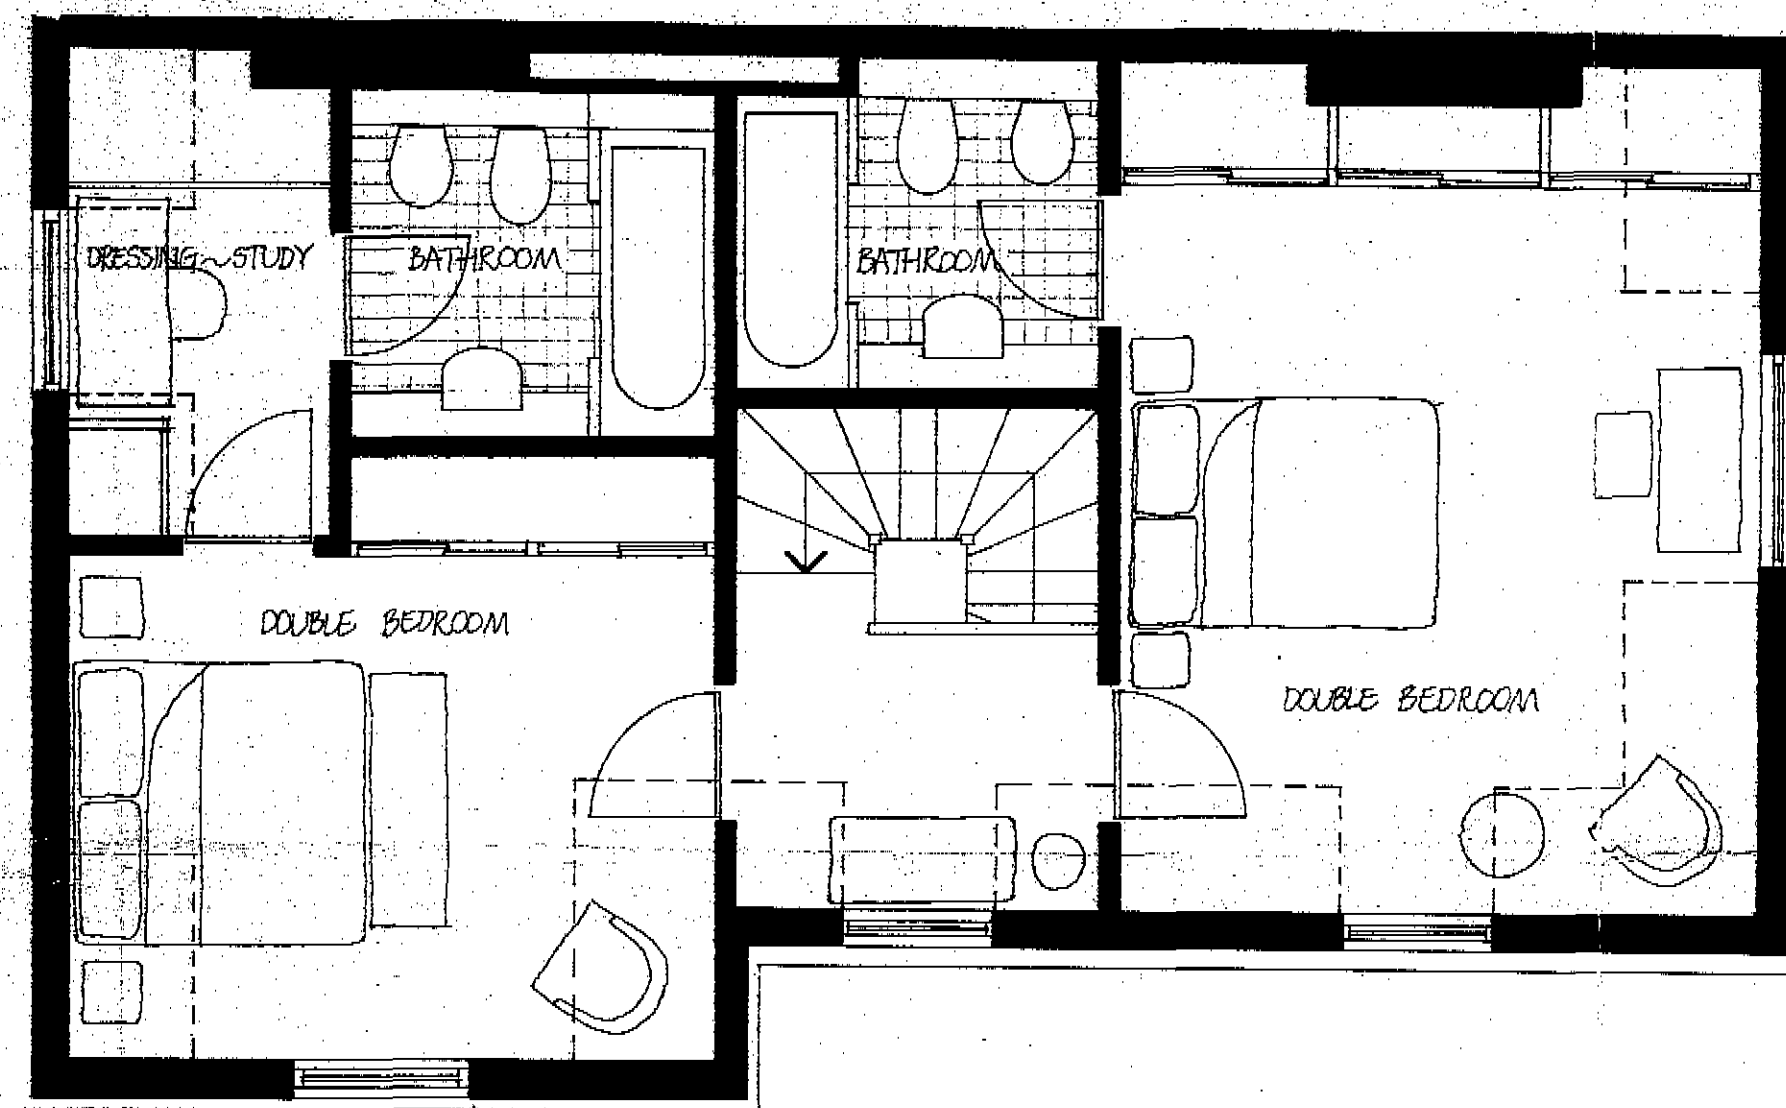

SECOND FLOOR PLAN

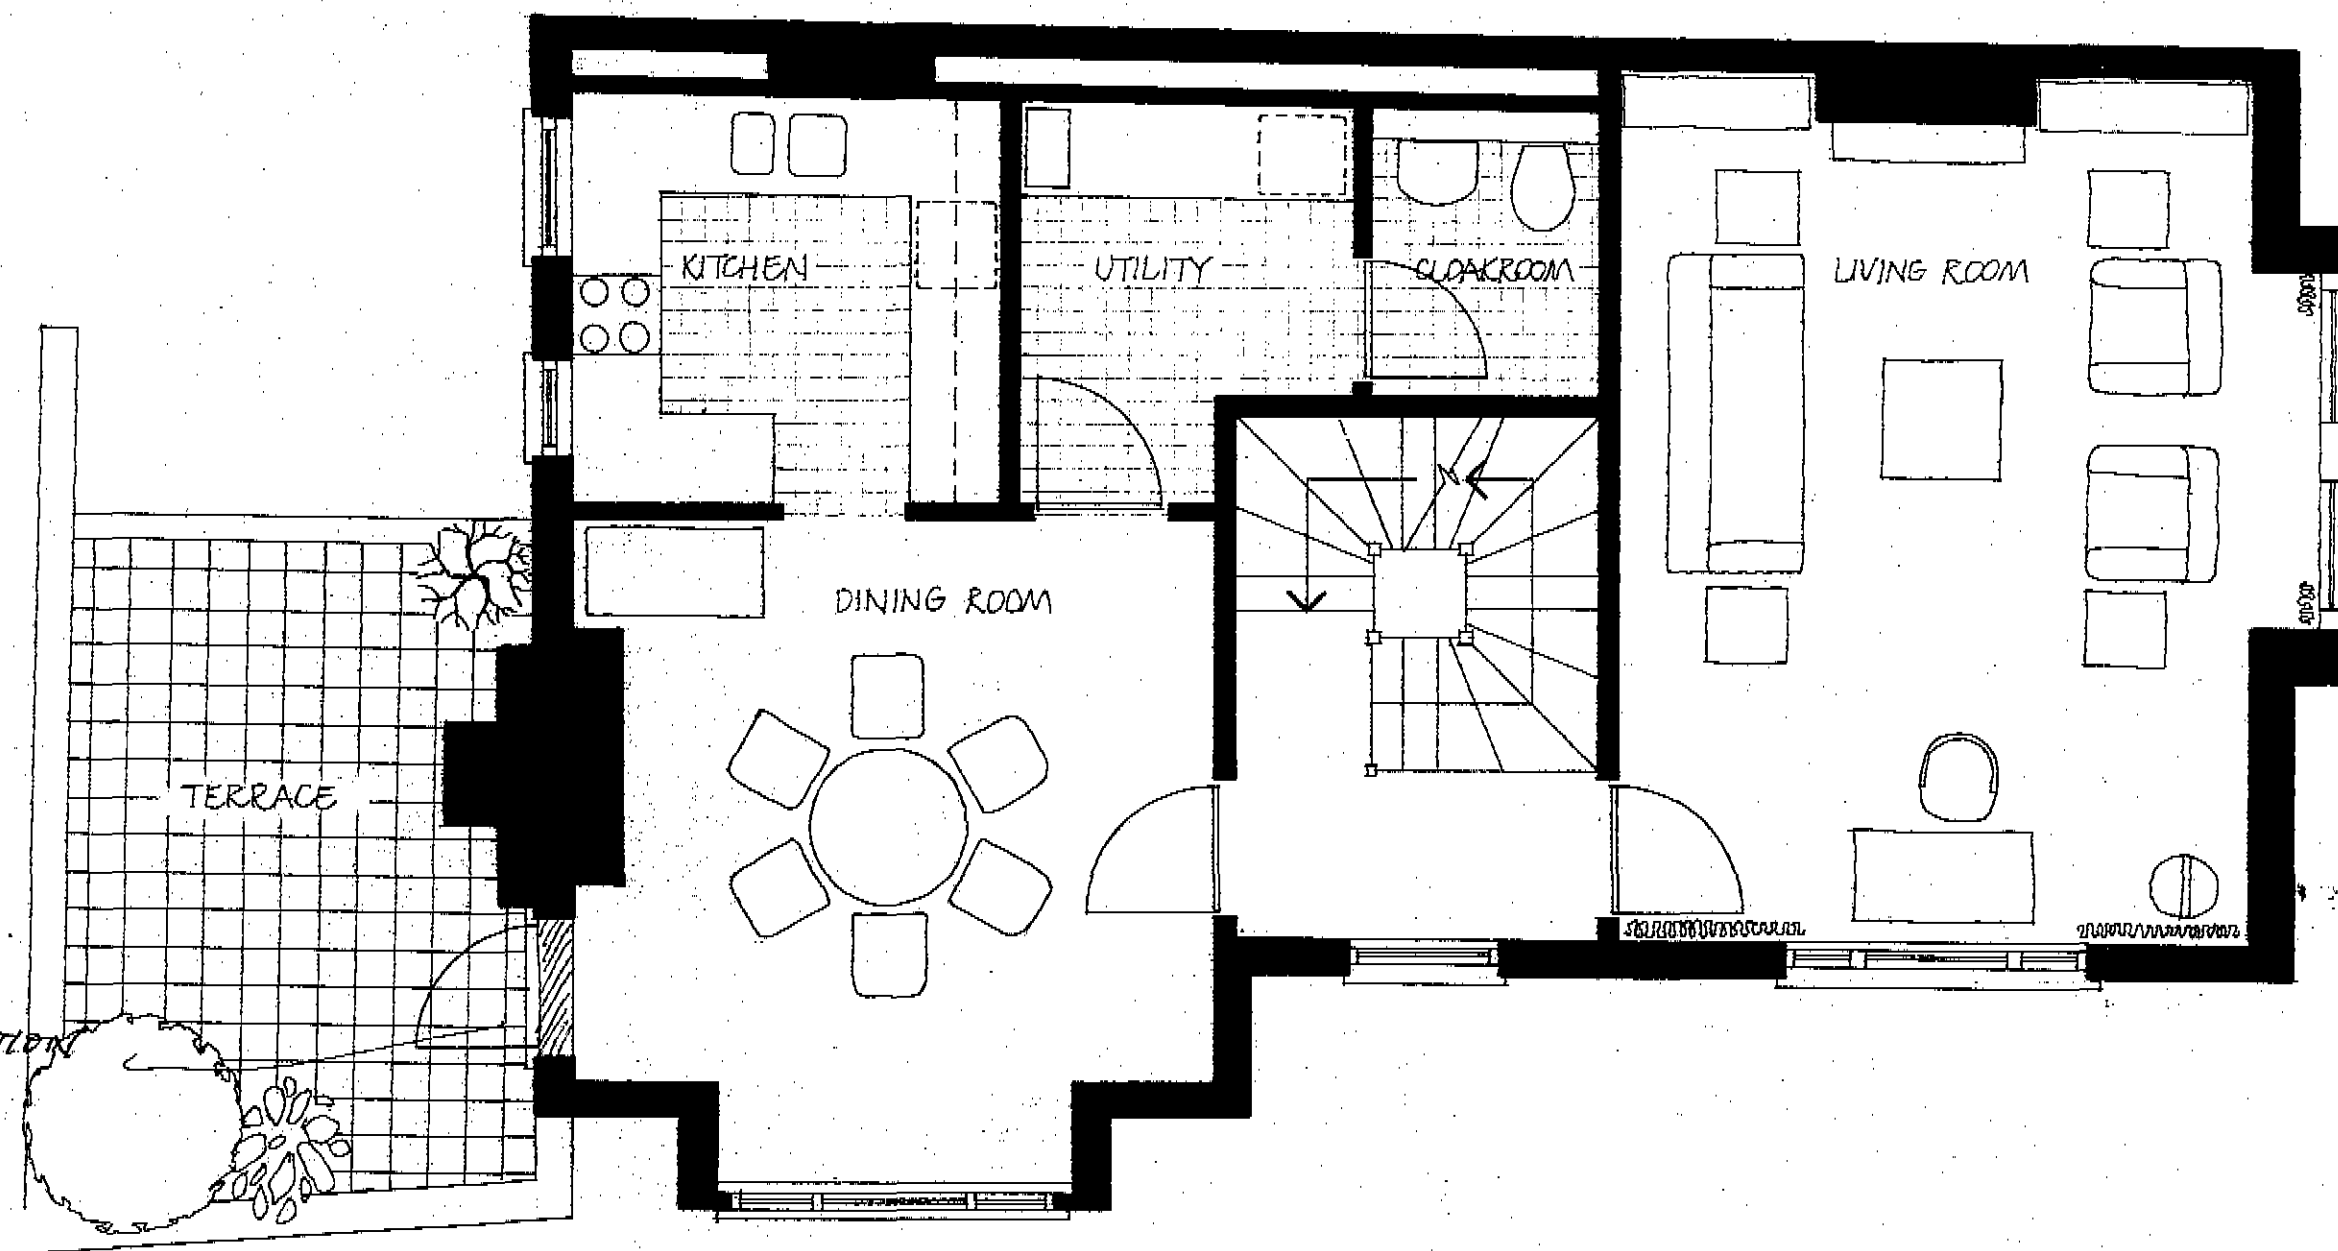

FIRST FLOOR PLAN

OMIT TERRACE &
PROPOSED ACCESS
FROM THIS APPLICATION
J. Pennington
30 April '84

LONDON BOROUGH OF CAMDEN
TOWN AND COUNTRY PLANNING ACTS
- 9 MAY 1984
PLANS ~~NOT APPROVED~~ APPROVED
ON BEHALF OF THE COUNCIL

E7/16/B/8400401.
(R1)
PLANNING AND COMMUNICATIONS
DEPARTMENT
CAMDEN
- 2 MAR 1984
VOL.
ACK.
REFERRED TO:

date	revision
	Client THE STUART CHILDREN TRUST
	Job CONVERSION 16 WILLOUGHBY ROAD HAMPSTEAD LONDON NW3
	Dwg. PROPOSED 1ST & 2ND FLOORS UNIT 2
scale 1:50	date FEBRUARY 1984
BENNETT & PENNINGTON 122 Torrington Avenue London NW5 2RY 01-267 4733	
Dwg. no.	WR:111