

hick?

DIAGRAMATIC ELEVATION OF ENTRANCE SCREEN WALL



REG 31/67

PRESENTED TO
28 MAR 1968
TOWN PLANNING AND BUILDING
REGULATION COMMITTEE

REGD No. 4577

Nº 1 Nº 2 & 3 Nº 4

FL AT FRONT
(HERE)

FL AT FRONT
(HERE)

2nd (Top) FL

1st FL

GV FL

FRONT ELEVATION

ELEVATION TO HEATH

Nº 4 Nº 2 & 3 Nº 1

Bylaw 39
Compliance with (2)
offered except at 1st story
of back elevation

Relief from Bylaw

FL

Ceiling height?

39(2) and (3)
wrought iron balustrade

2) and (3)

Concrete Band

2nd (Top) FL

OPEN

1st FL

GV FL

ELEVATION TO GARDENS

BACK ELEVATION

Bylaw 39

Bylaw 39

(1) 2nd floor area
(2) 2nd floor area
(3) 2nd floor area

See attached 19/3/68

WR 37


CLIENT: CONTEMPORARY CONSTRUCTION LTD
JOB: 1-4 WILLOW ROAD, HAMPSTEAD
DRAWING: ELEVATIONS
SCALE: 1/8" = 1' 0"
DRAWN BY: R.S.T
CHECKED BY:
DATE: 23.2.38

FRANK GOLDBERGER D.P.L.C.
GERALD ELLIOTT A.M.I.E.A. (ARCHITECTS)
1, 2, 3, 99, 100

PRESENTED TO
28 MAR 1938
TOWN PLANNING AND BUILDING
REGULATION COMMITTEE.
REGD No. 4577


L.C.C.
ARCHITECTS DEPT
16 MAR 1938 - 041158

Superintending Architect
E. P. L. G.
4/5/38

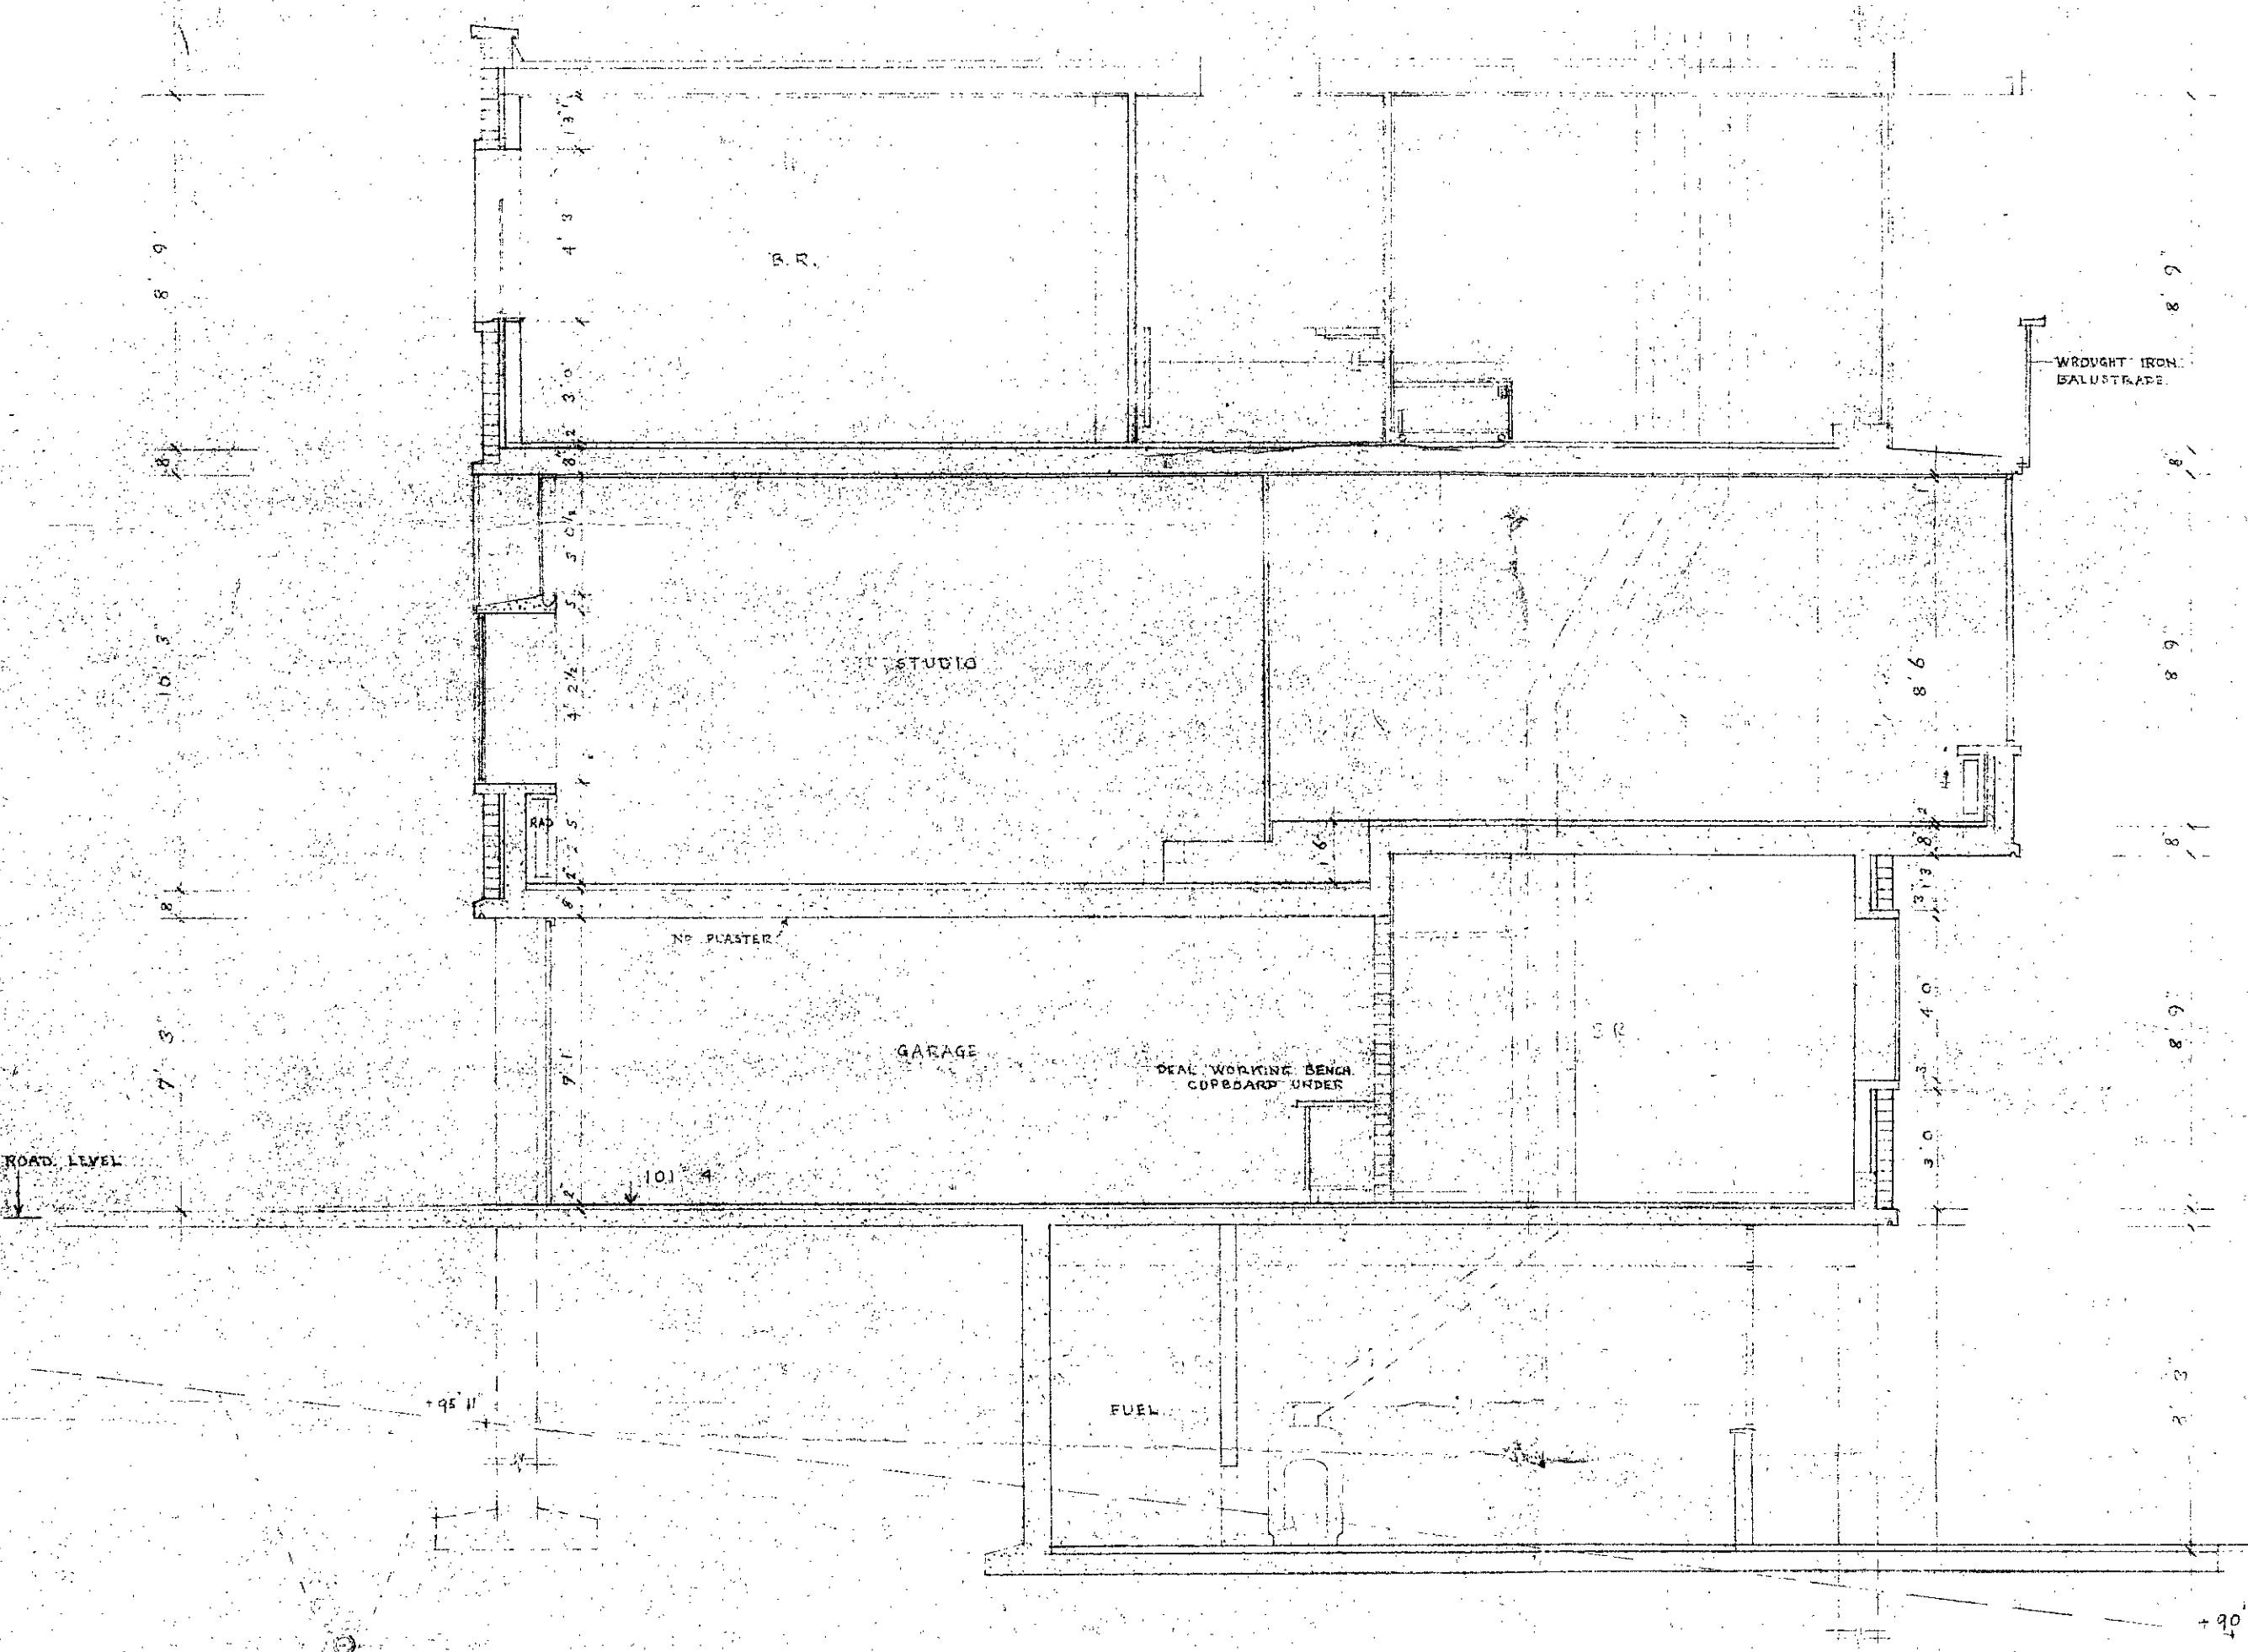

SECTION ~~BB~~ A-A

PARTY WALL
8" REINFORCED CONCRETE
PLASTER
FIXED WINDOW
OPENING WINDOW
1" SCALE SECTION OF PARTY WALL AT Y-Y

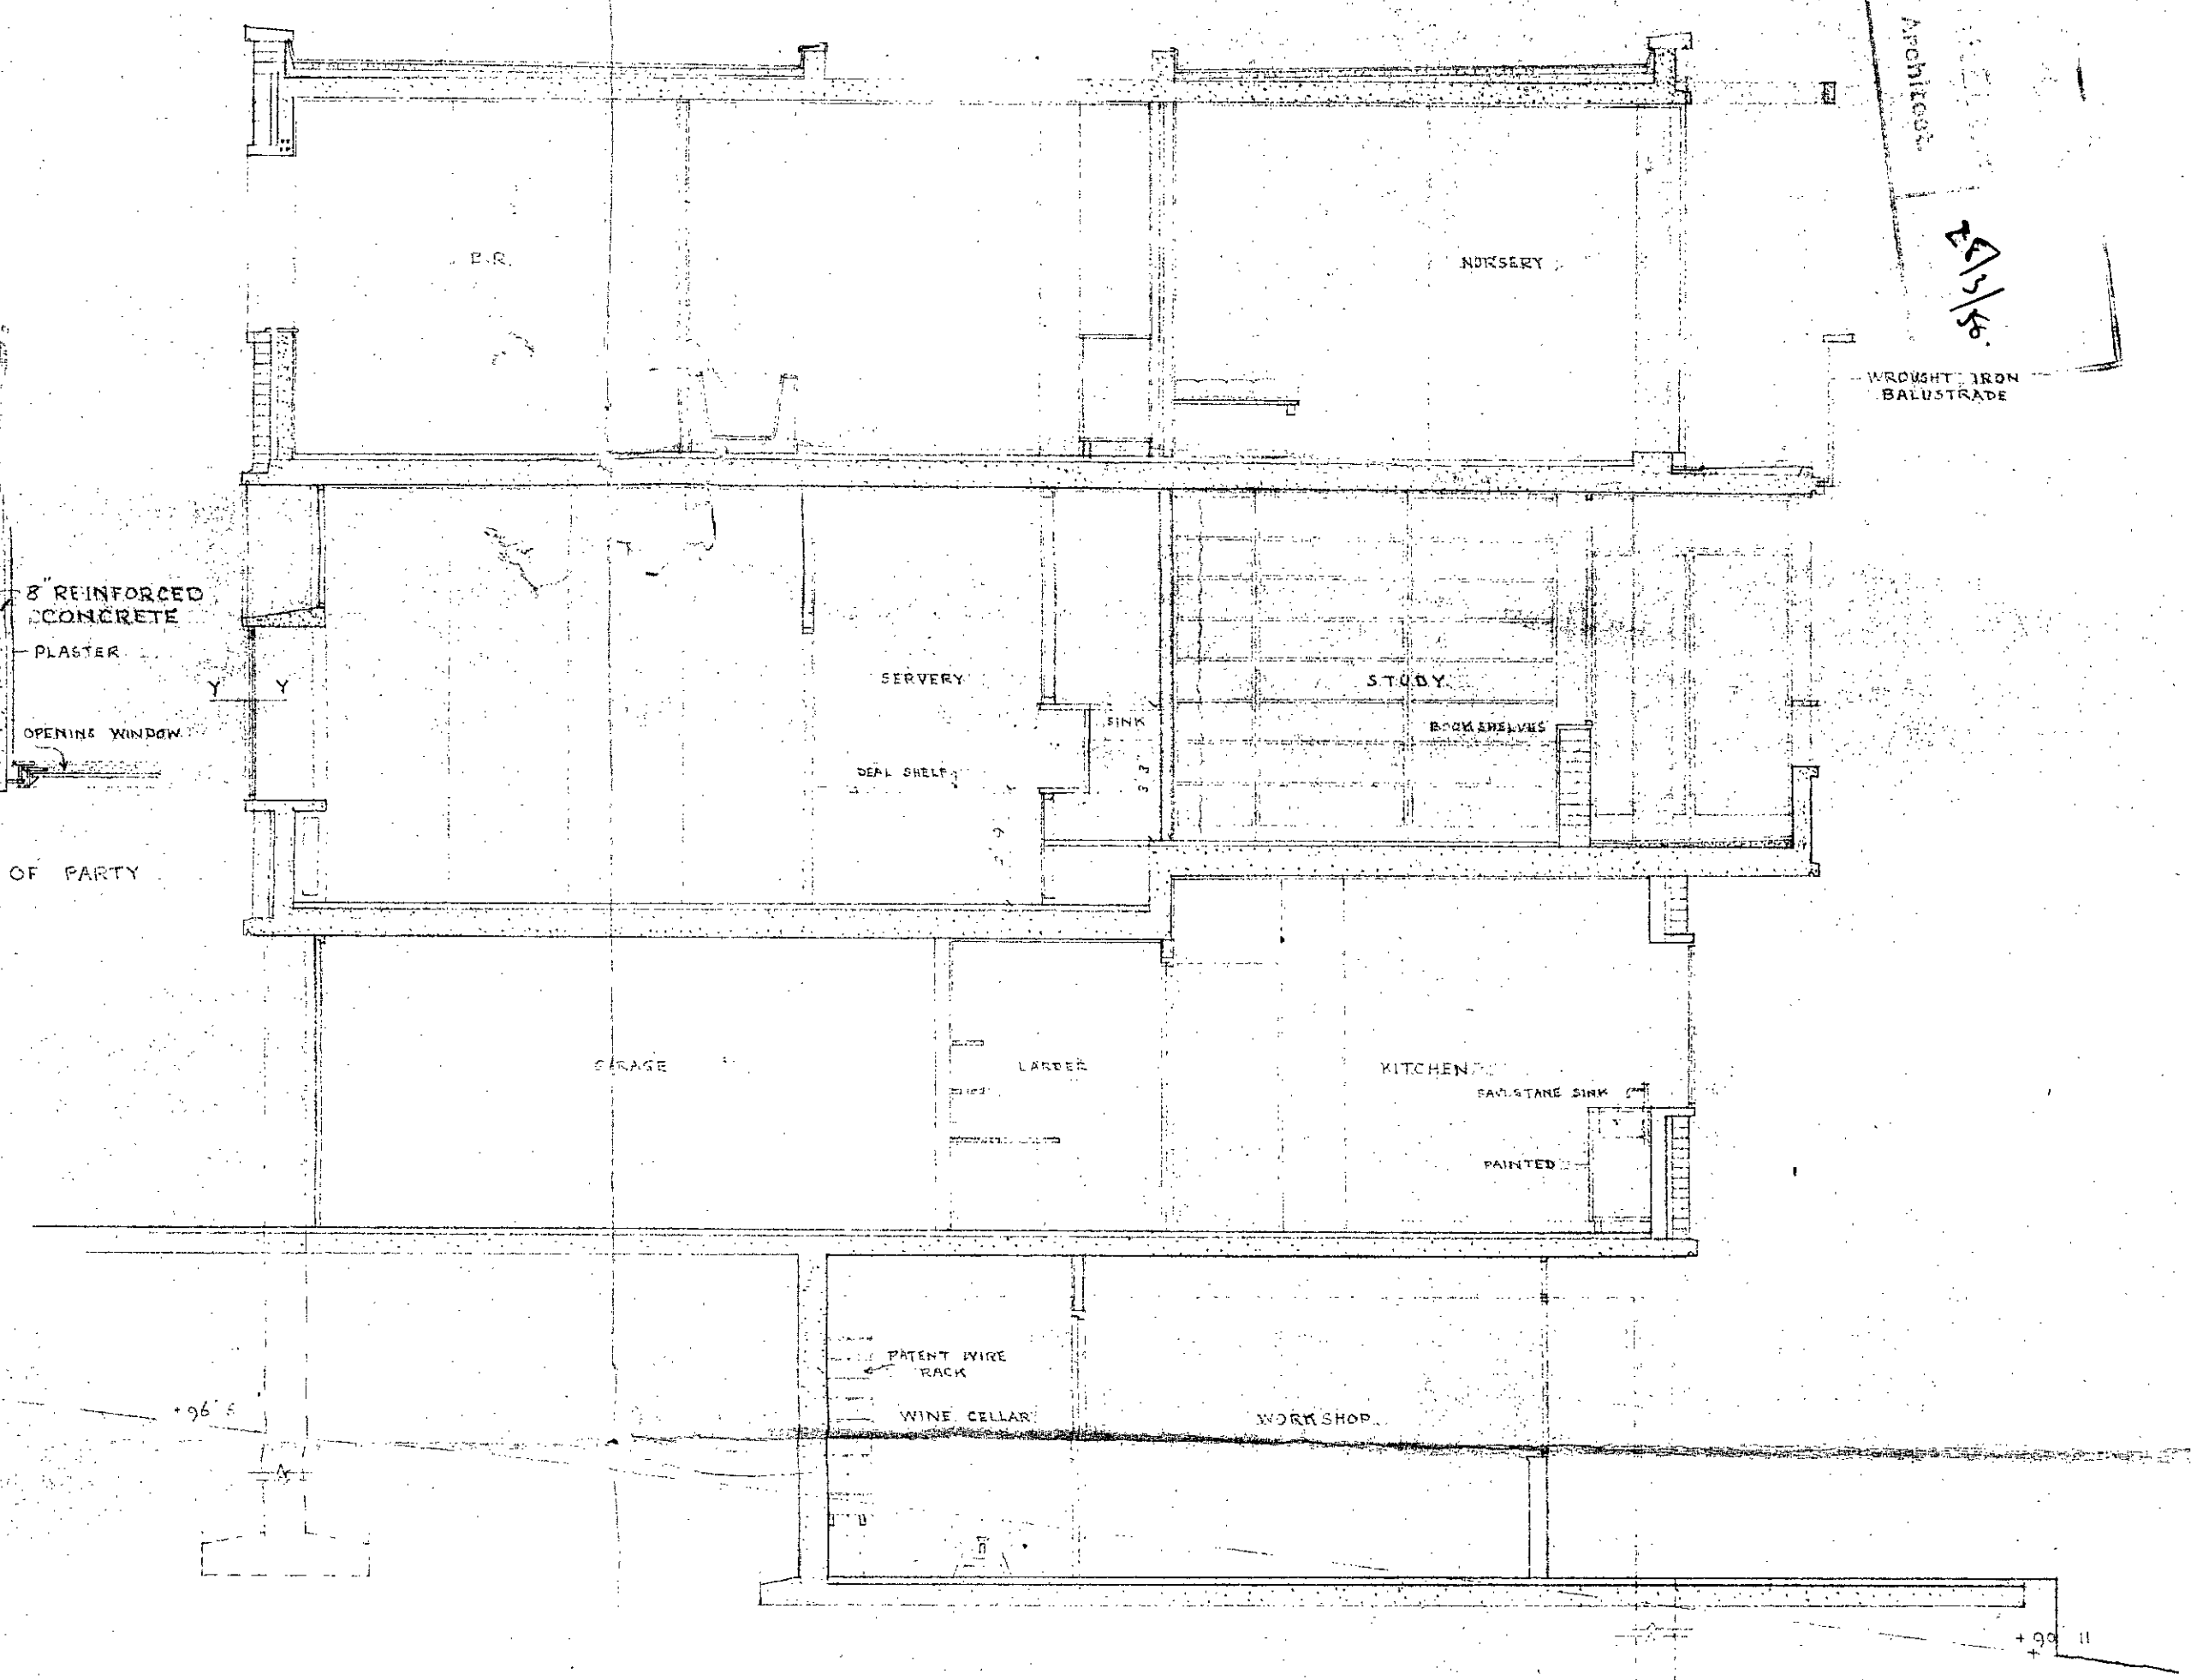

SECTION ~~AA~~ B-B

N.W.R. 39

CLIENT: CONTEMPORARY CONSTRUCTION LTD
JOB: 1-4, WILLOW ROAD, HAMPSTEAD.
DRAWING: SECTIONS: CENTRAL HOUSE
SCALE: 1/4" = 1' 0"
DRAWN BY: R.S.T.
CHECKED BY:
DATE: 1.3.38
ERNO GOLDFINGER, D.P.L.G.
GERALD FLOWER, A.R.I.B.A. ARCHITECTS,
7, BEDFORD SQUARE, LONDON, W.C.1.