


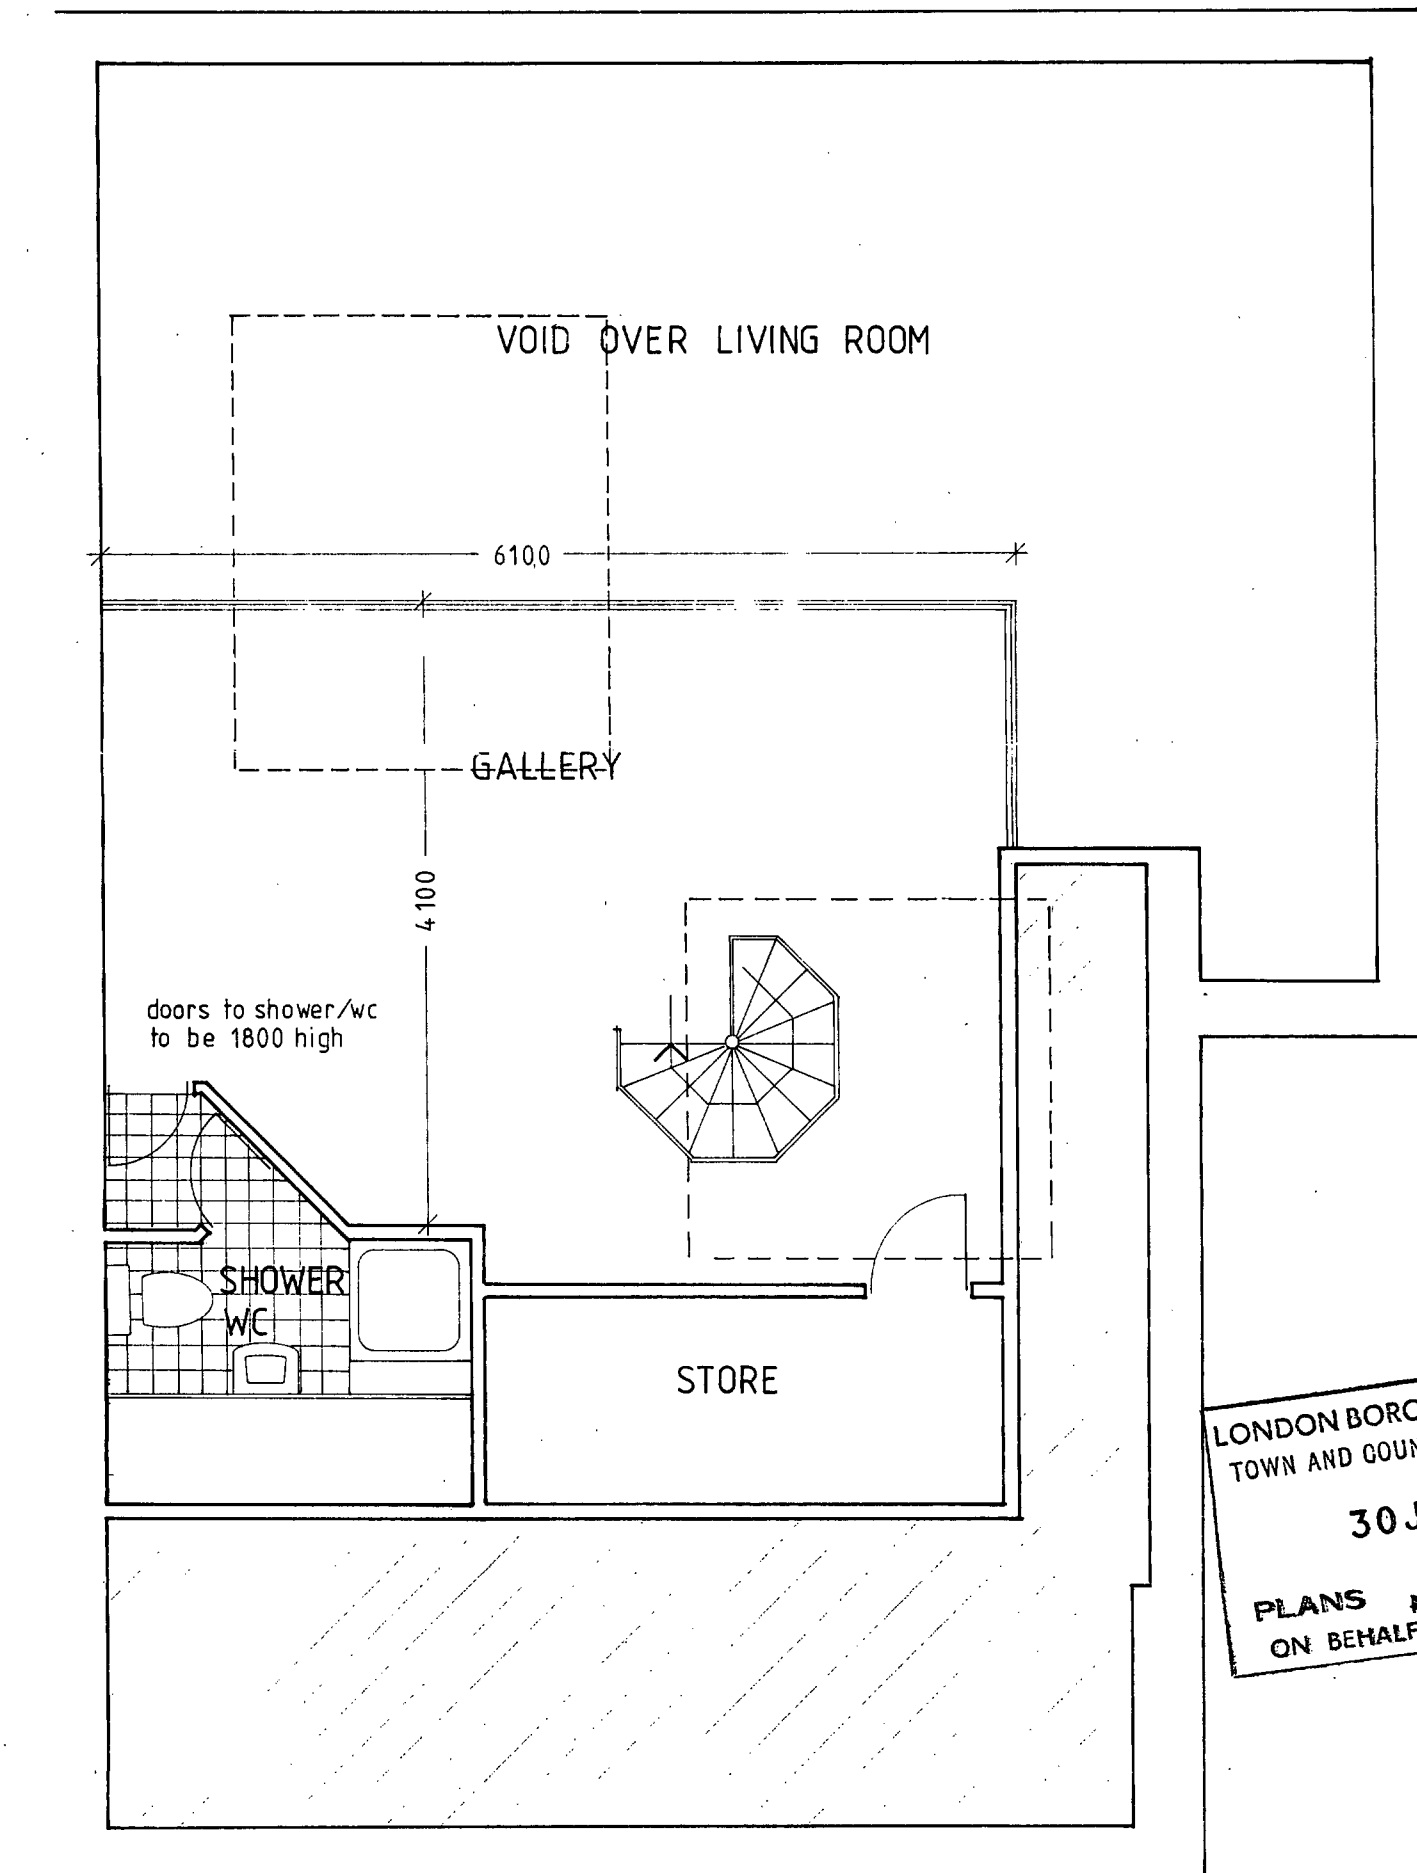

LONDON BOROUGH OF CAMDEN
TOWN AND COUNTRY PLANNING ACTS
30 JUL 1985
APPROVED
PLANS ~~NOT APPROVED~~
ON BEHALF OF THE COUNCIL


LONDON BOROUGH OF CAMDEN
PLANNING AND COMMUNICATIONS
DEPARTMENT
3 JUL 1985 (A.M.)
RECEIVED
REF. TO: 10

GALLERY LEVEL PLAN

7 BUCKLAND CRESCENT
Proposed plan (1 of 1)
Scale : 1 : 50

TPP 85300 455 13

A

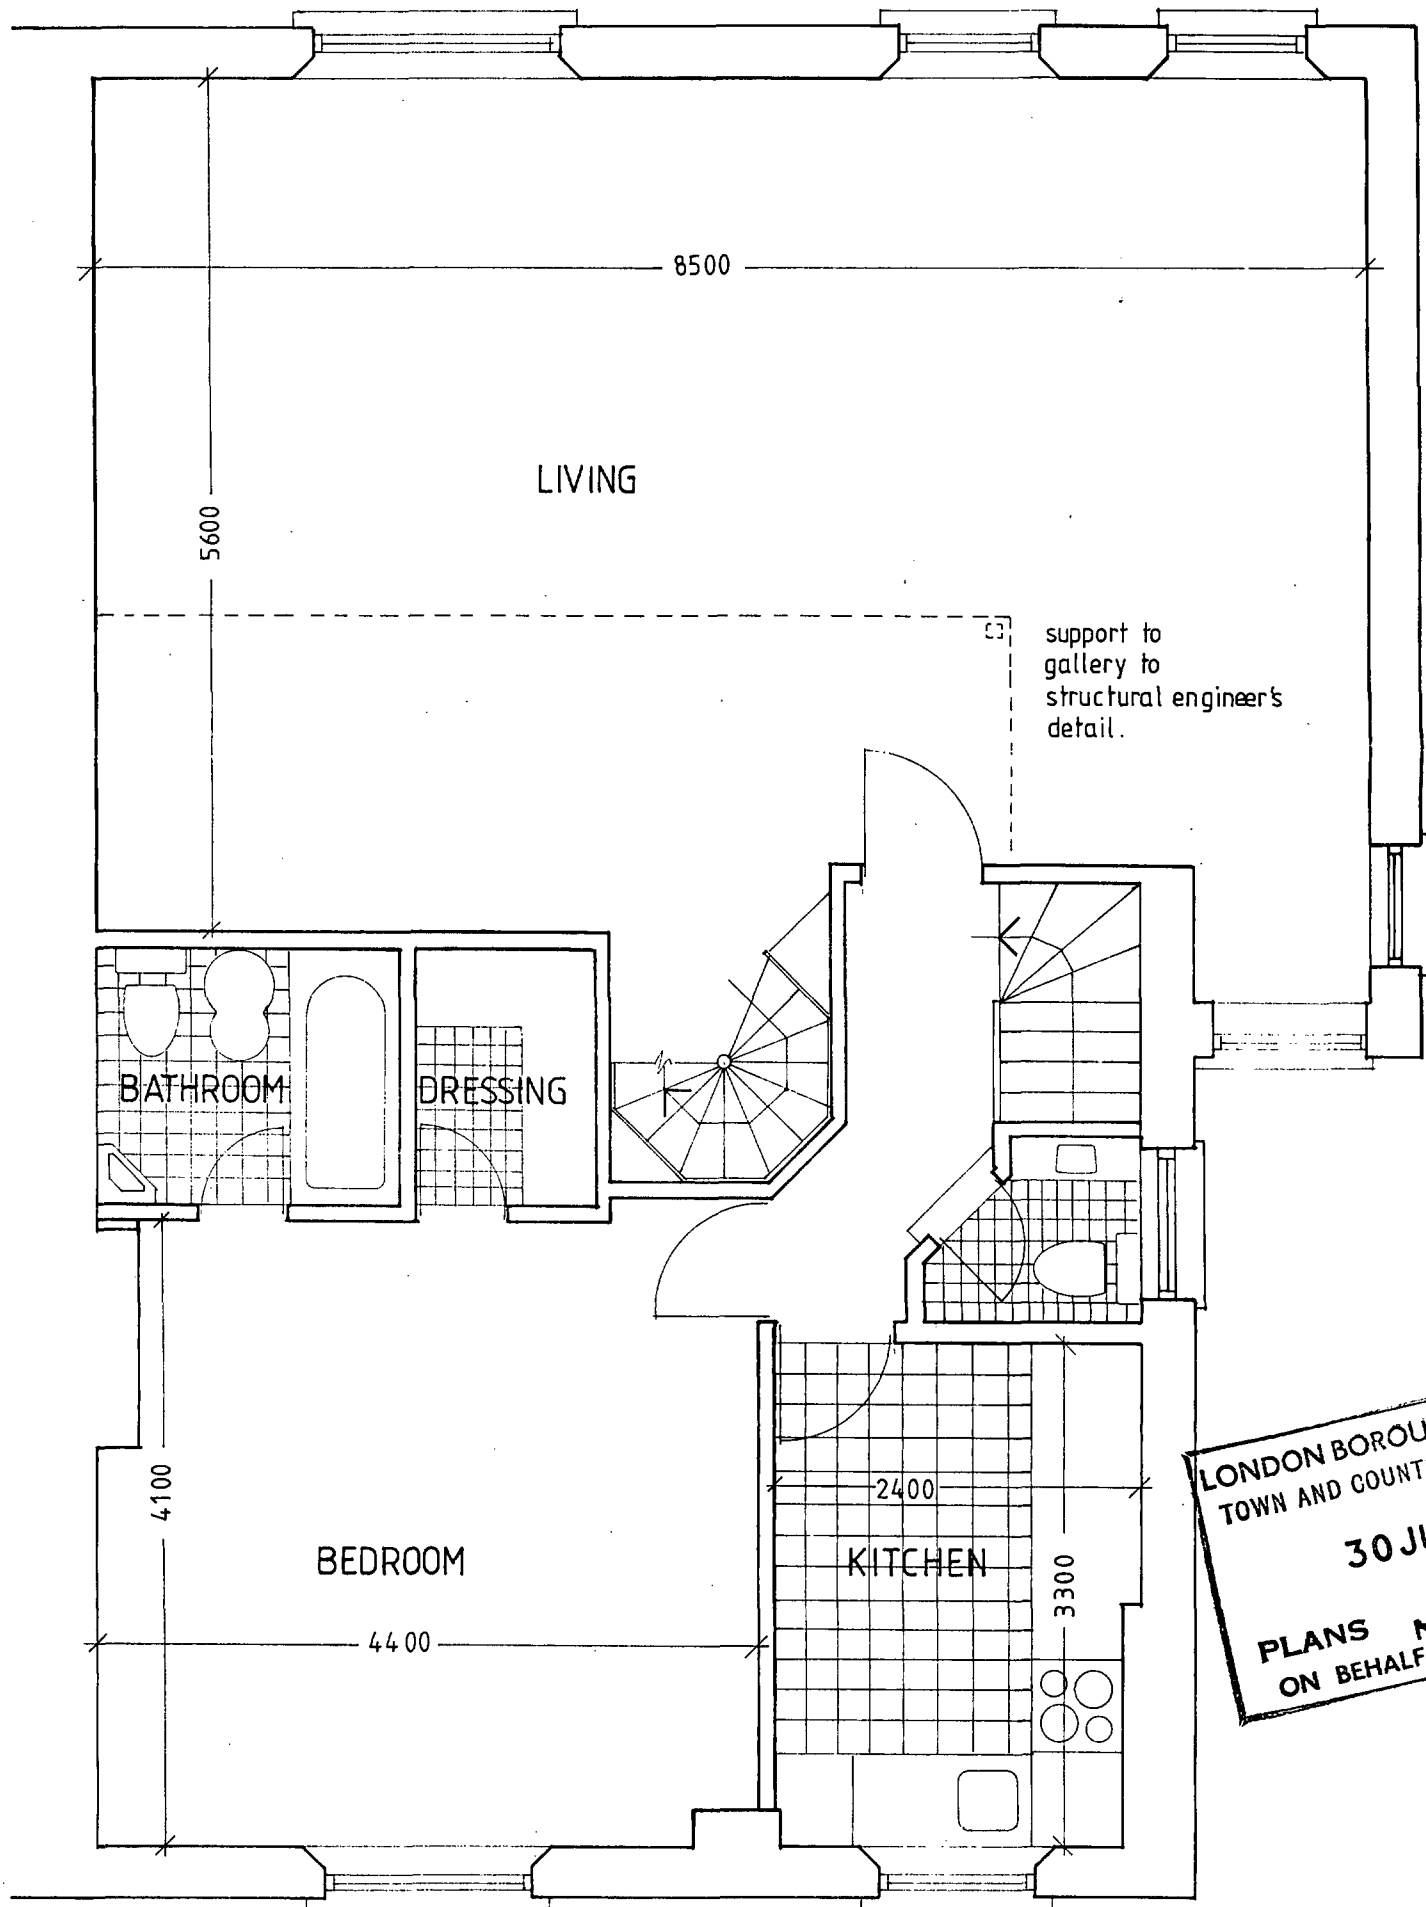


TOP FLOOR PLAN

LTP 8500145 R3

A

7 BUCKLAND CRESCENT
Proposed plan
Scale : 1 : 50

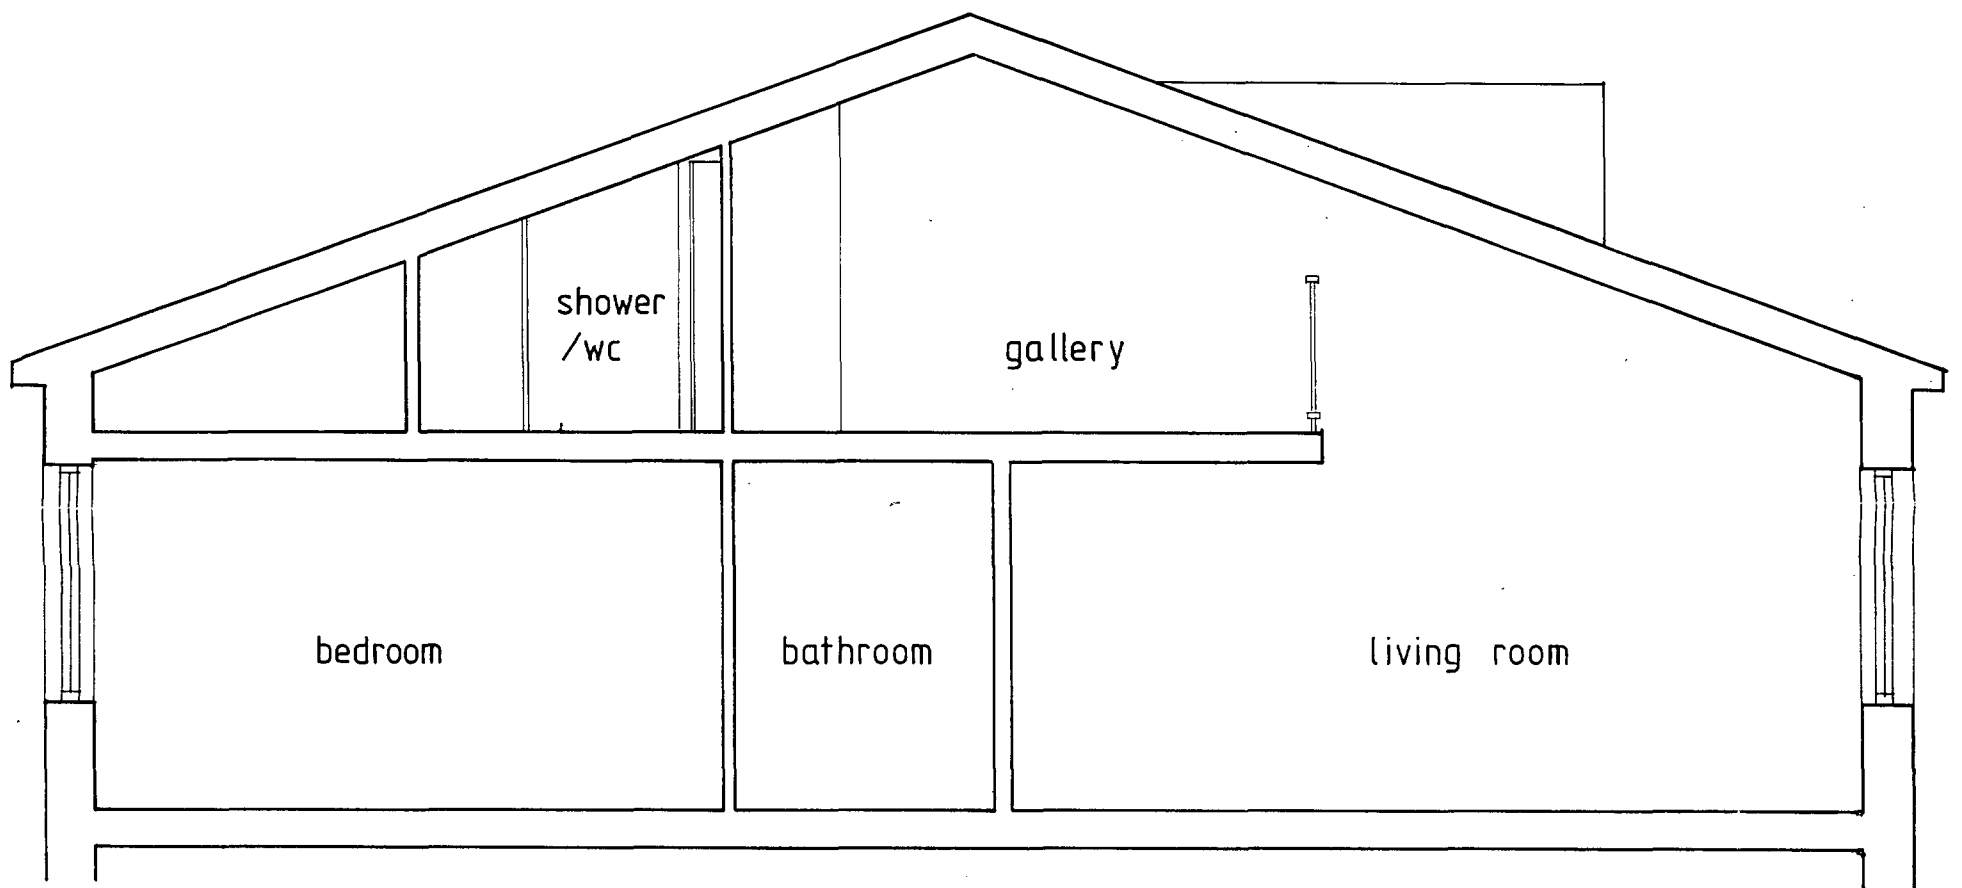


SECTION

LONDON BOROUGH OF CAMDEN
TOWN AND COUNTRY PLANNING ACTS
30 JUL 1985
APPROVED
PLANS ~~NOT APPROVED~~
ON BEHALF OF THE COUNCIL


LTP 8500145 R3

A

7 BUCKLAND CRESCENT
Proposed section
Scale: 1 : 50

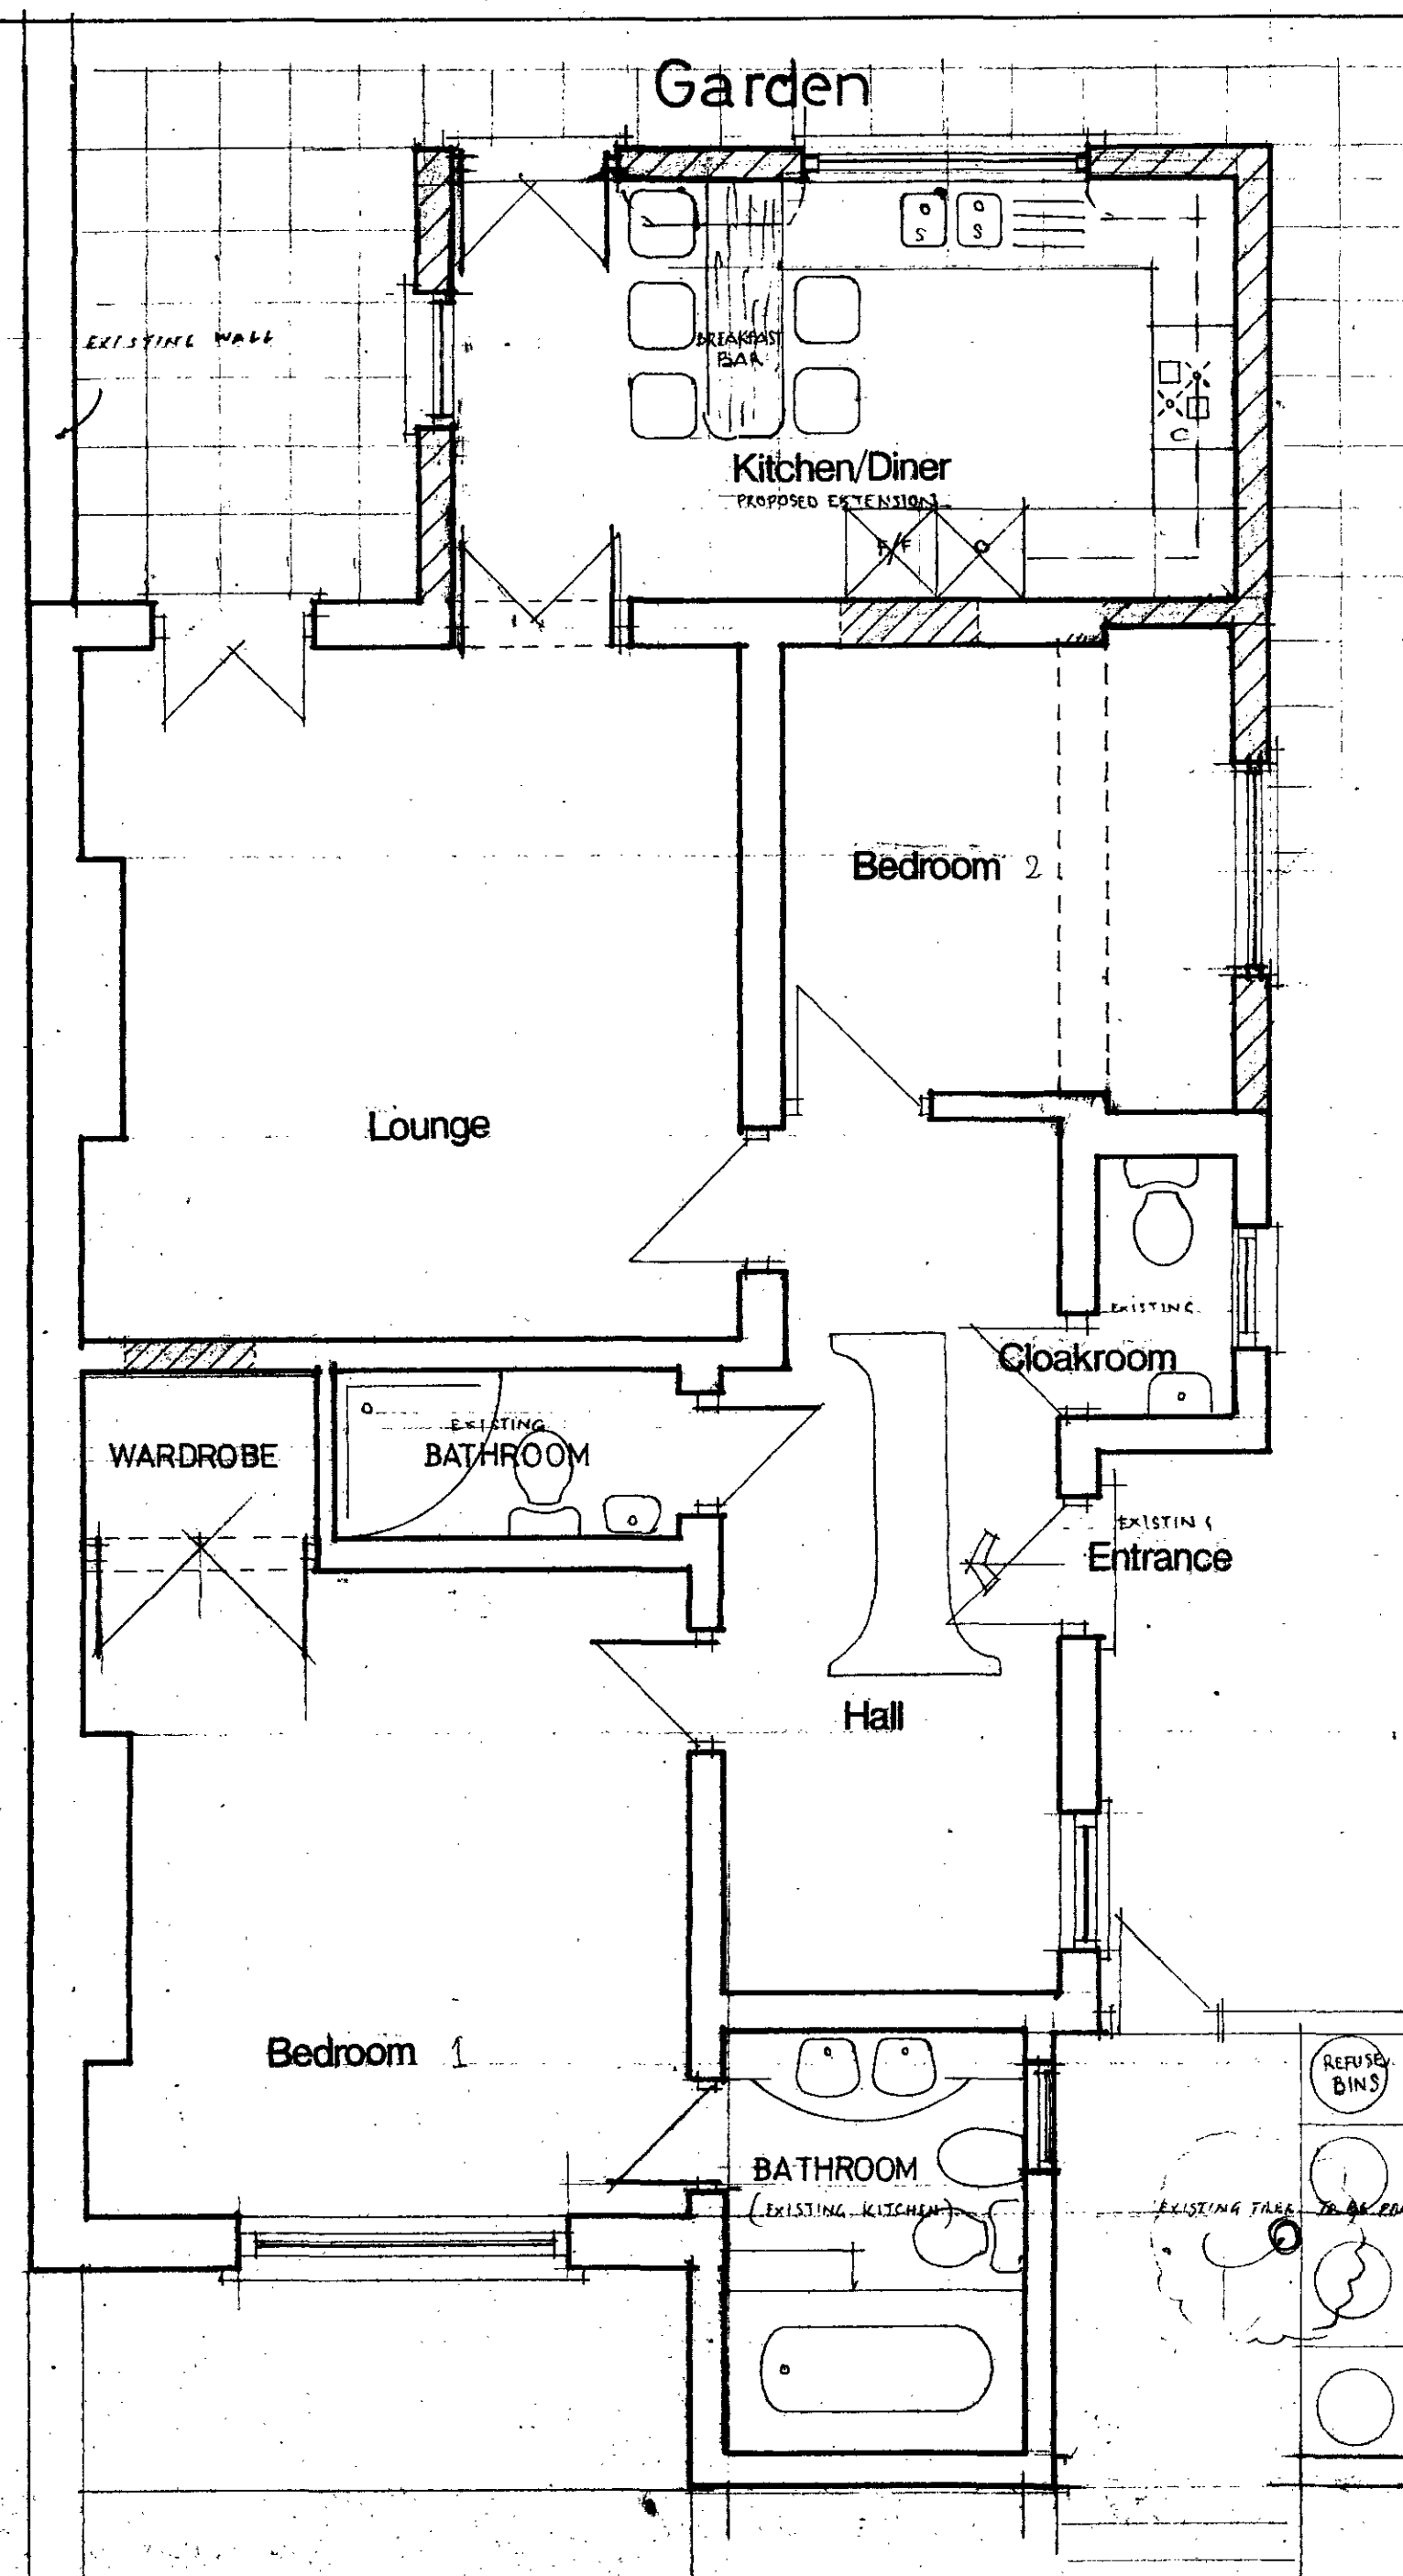

LOWER GROUND FLOOR PLAN

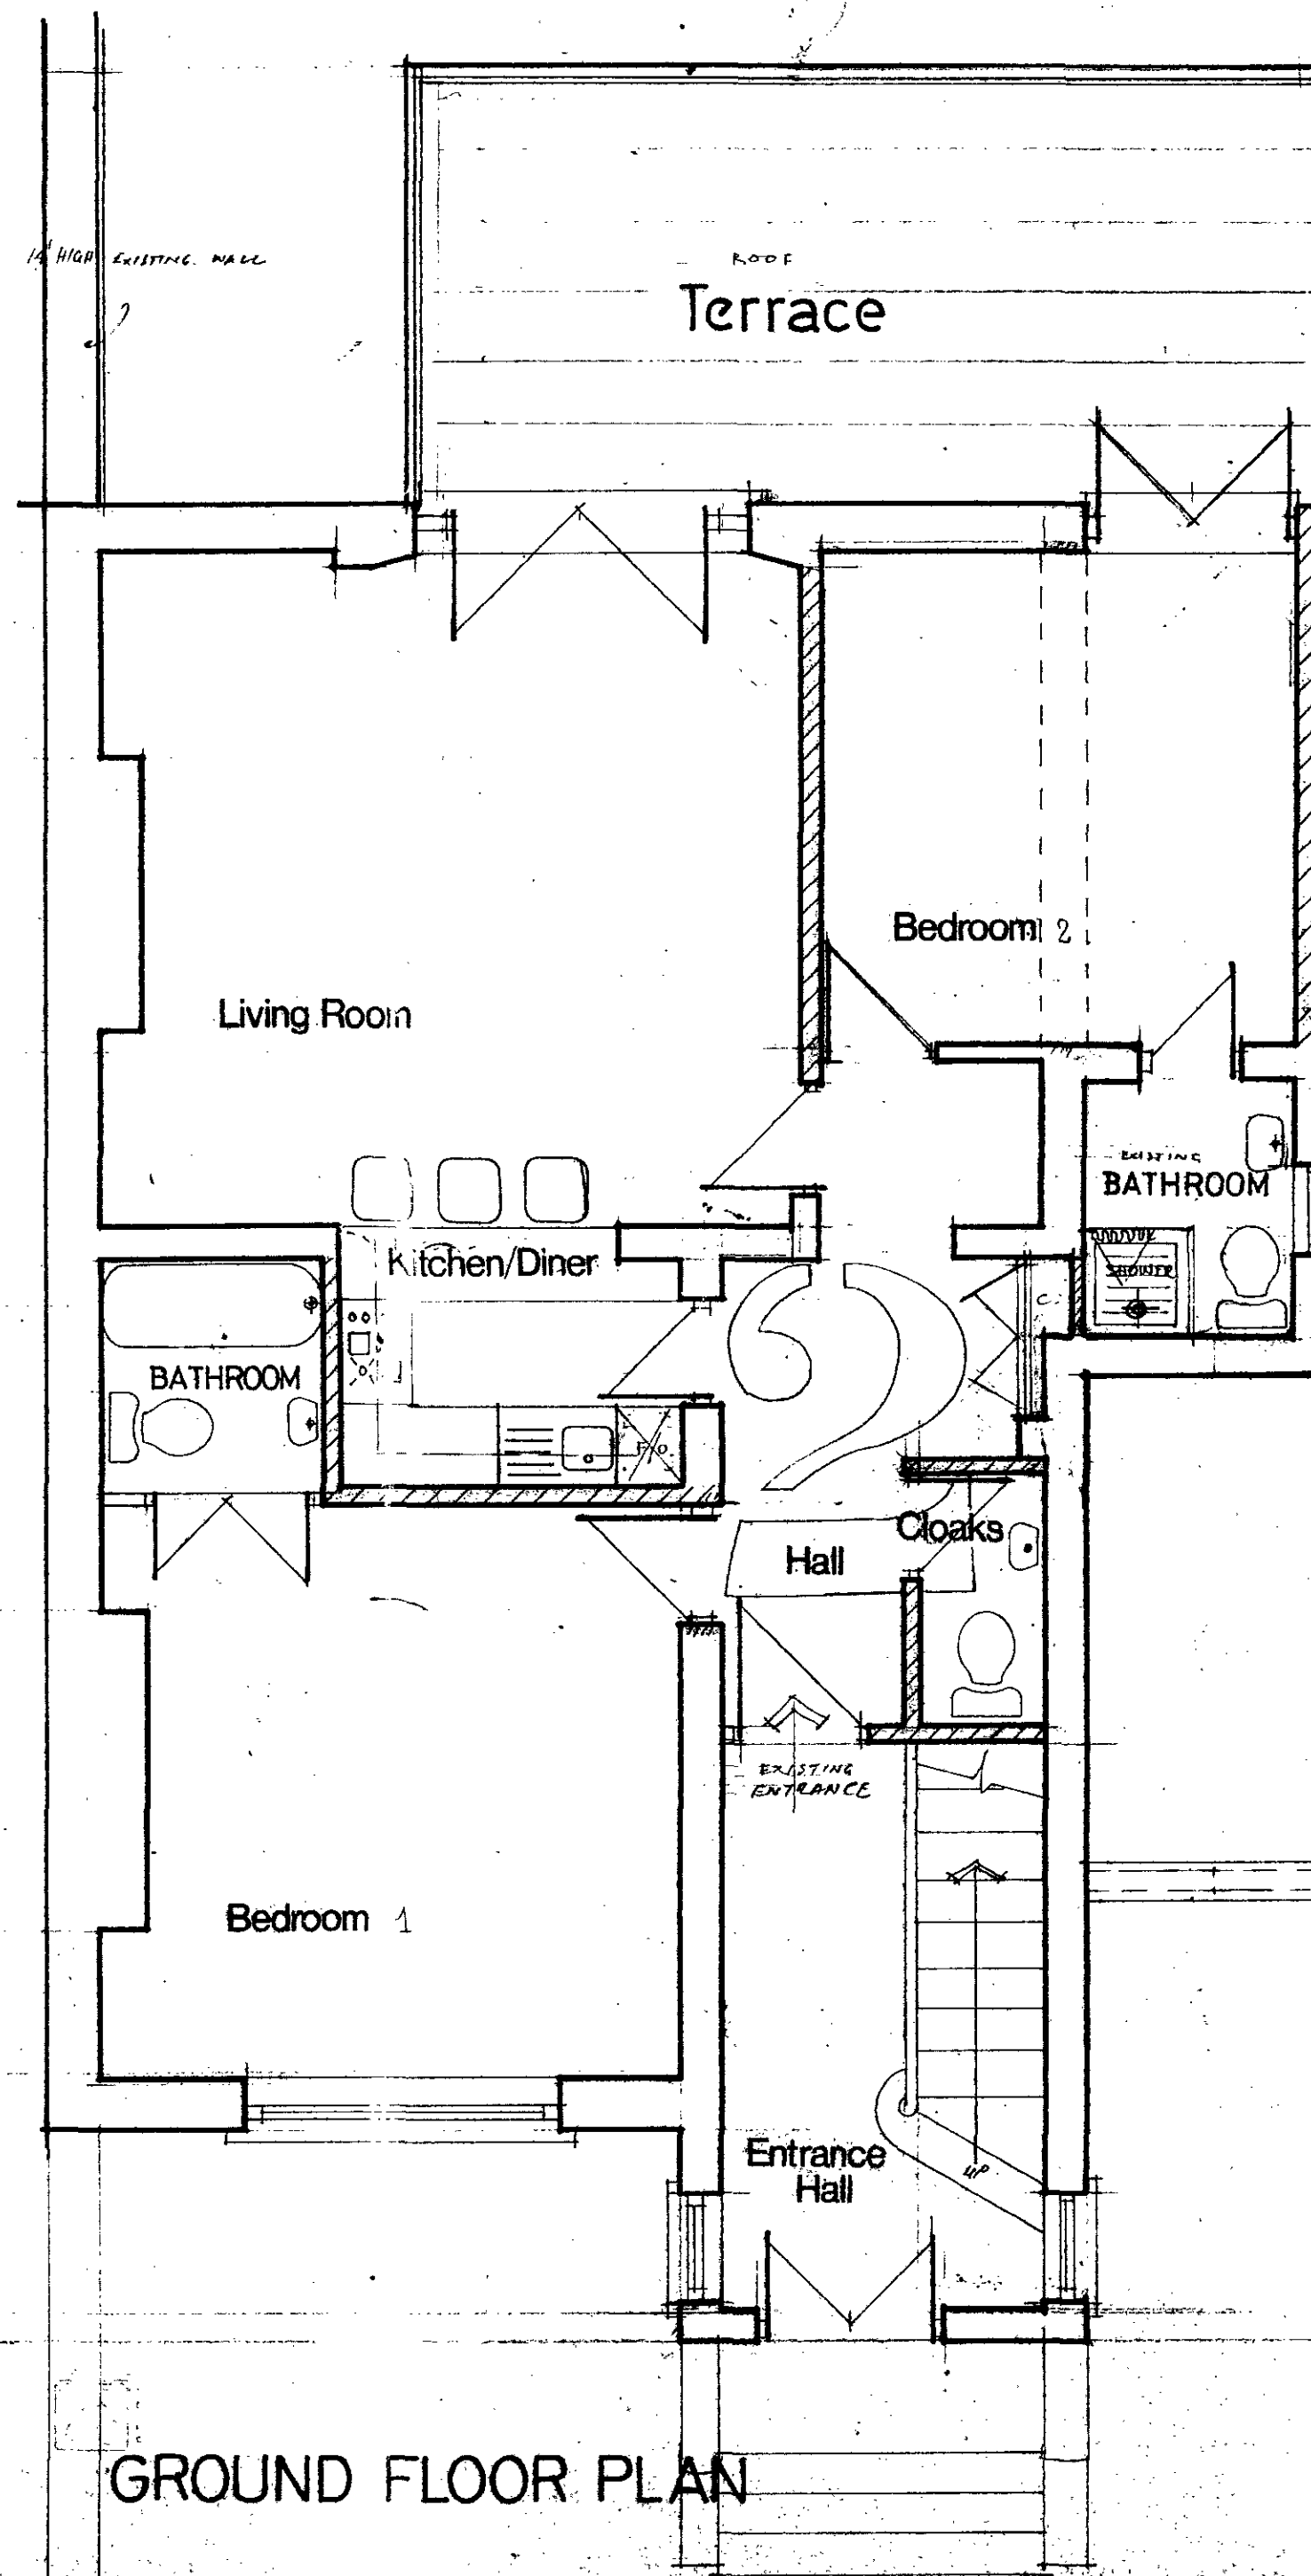


GROUND FLOOR PLAN

NOTES

ALL DETAILS AND DIMENSIONS TO BE CHECKED ON SITE

TP 8500145

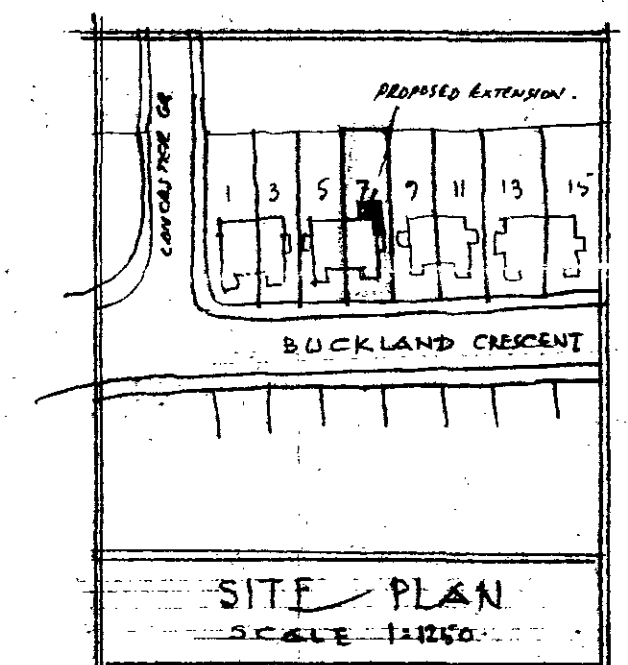

7 BUCKLAND CR.
NW3
Proposed Conv.
in to
FLATS


SCALE : 1:50
DATE : JAN 1985
REV : A

DESIGN ASSOCIATES ARCHITECTS
75 ABBEY ROAD LONDON, NW8
TEL: 01-625 5471


Job Ref 148/1

NOTES

ALL DETAILS AND DIMENSIONS
TO BE CHECKED ON SITE

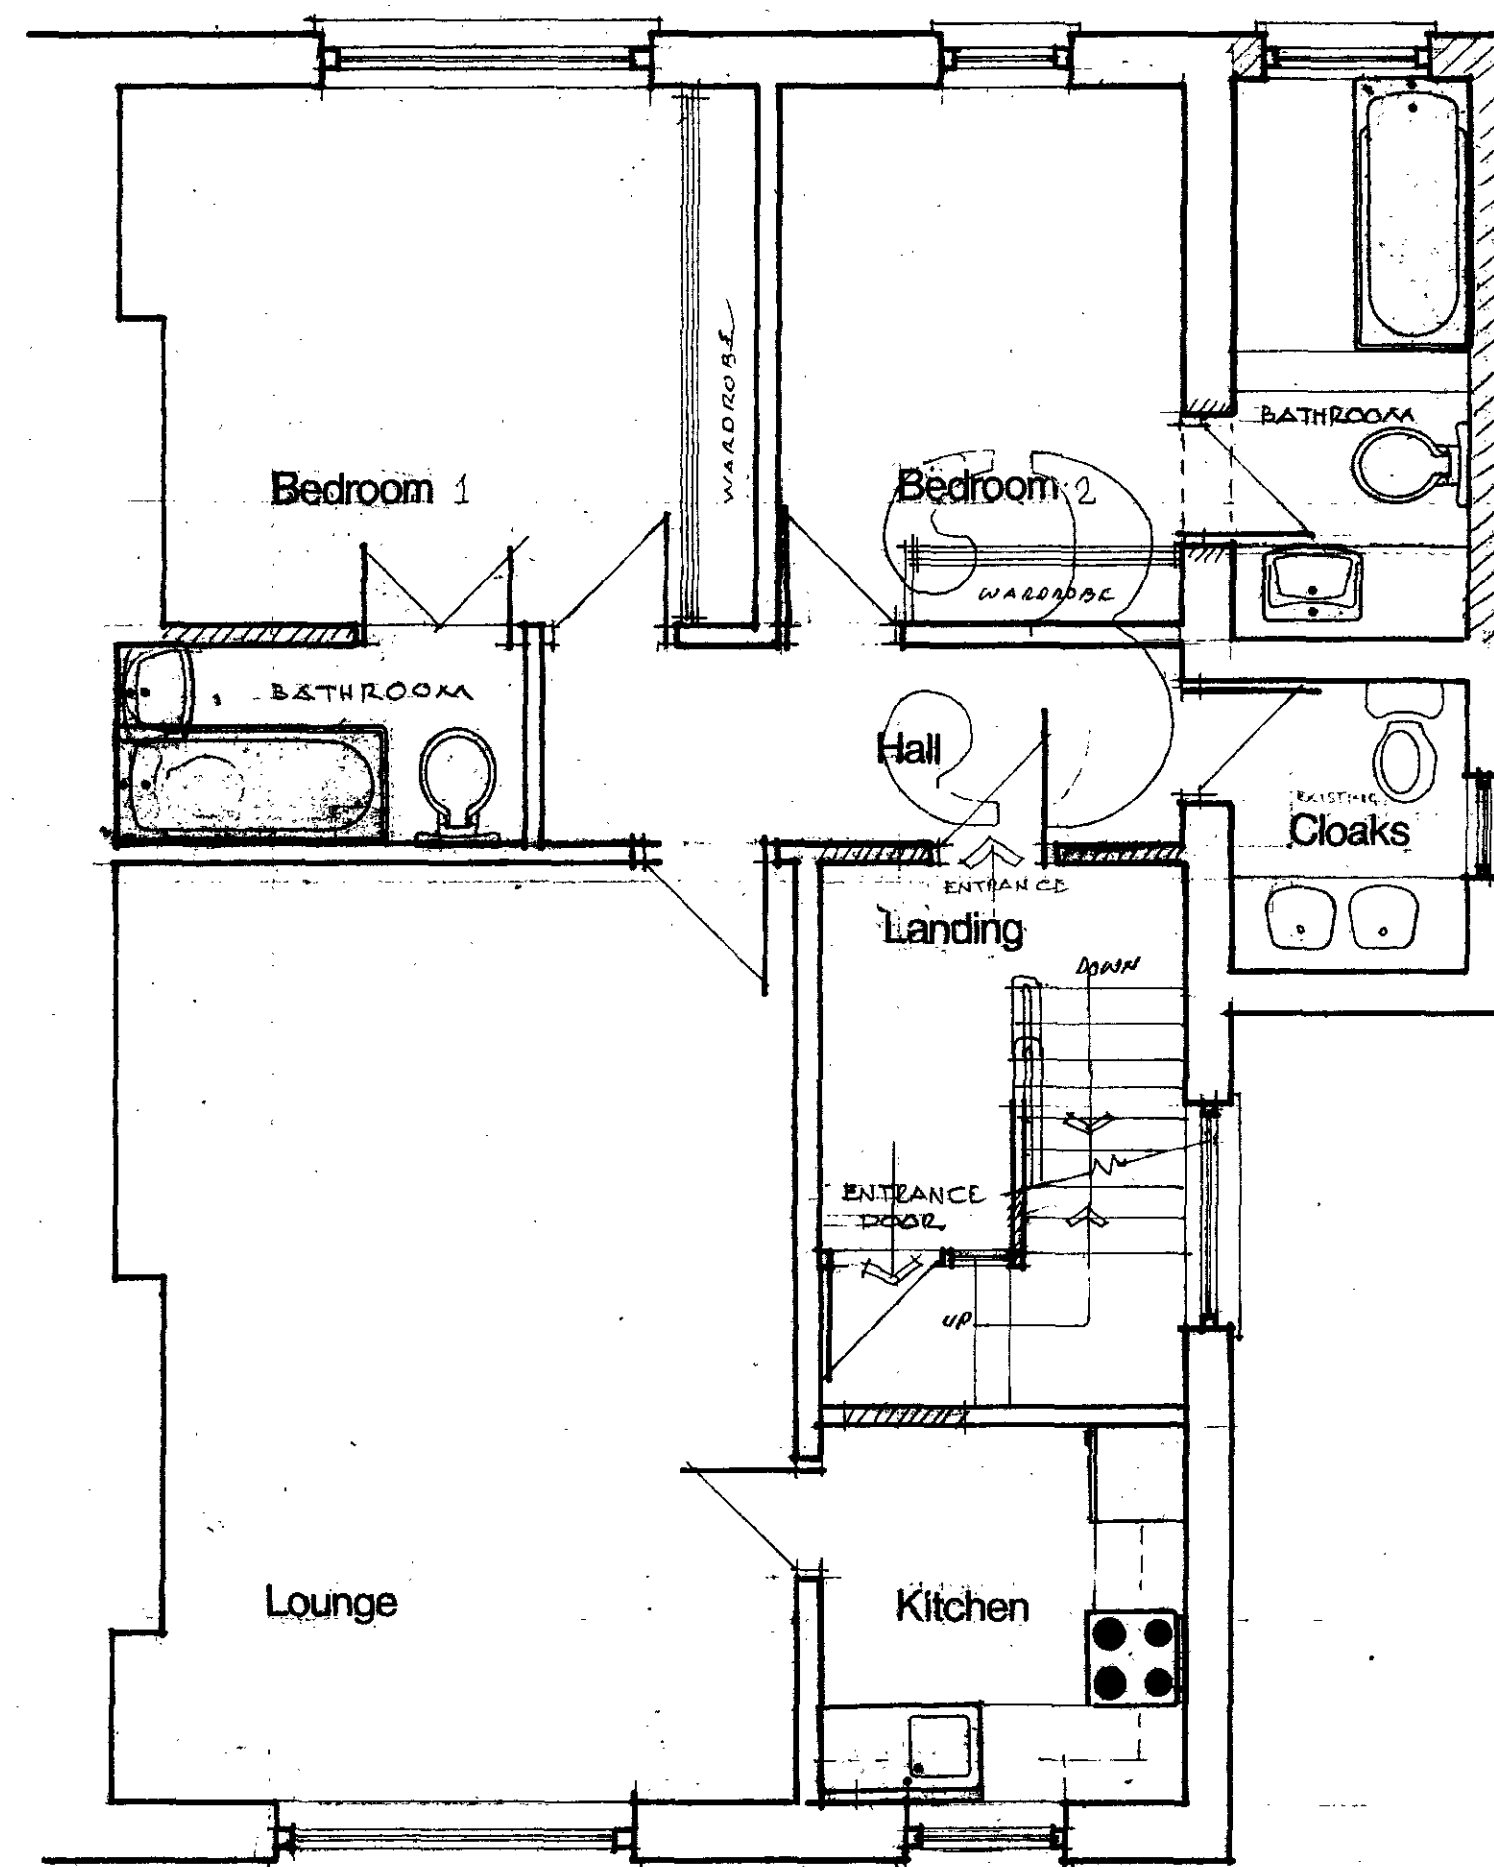

FIRST FLOOR PLAN

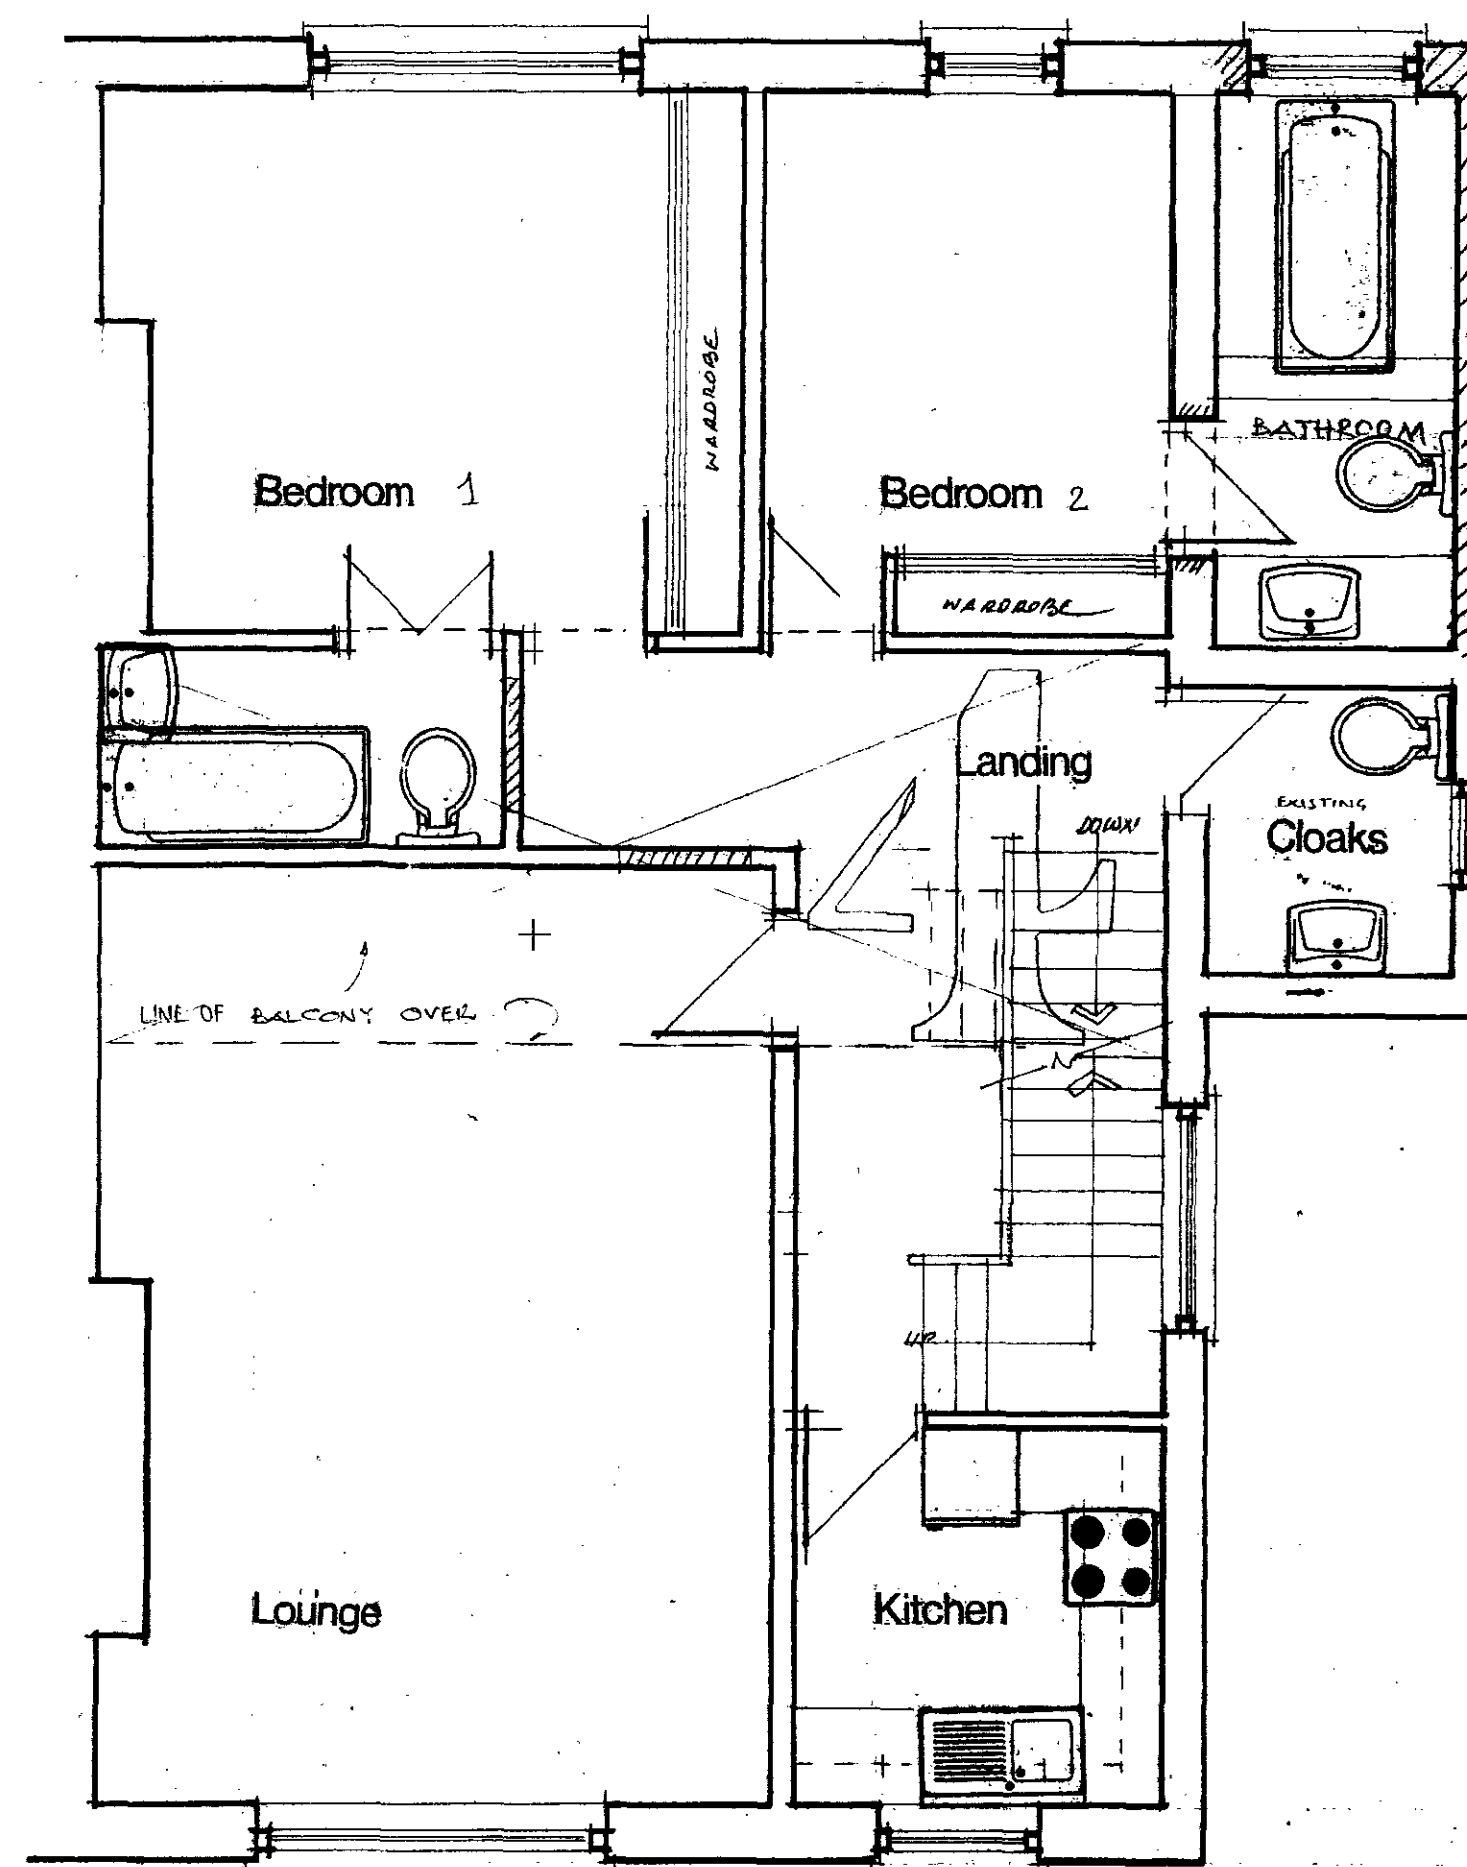

SECOND FLOOR PLAN

TP8500145

7 BUCKLAND CR.
NW3
Proposed Conv.
in to
FLATS

SCALE: 1:50

DATE: JAN. 1985

REV: 'A'

DESIGN ASSOCIATES
CHARTERED ARCHITECTS
75 ABBEY ROAD, LONDON NW8
TEL 01-625 6471


JOB REF 148/2

NOTES:

ALL DETAILS AND DIMENSIONS TO BE CHECKED ON SITE

ACK
RECEIVED
LONDON BOROUGH OF CAMDEN
PLANNING
DEPARTMENT
10/1/85

TP 8500145 D7

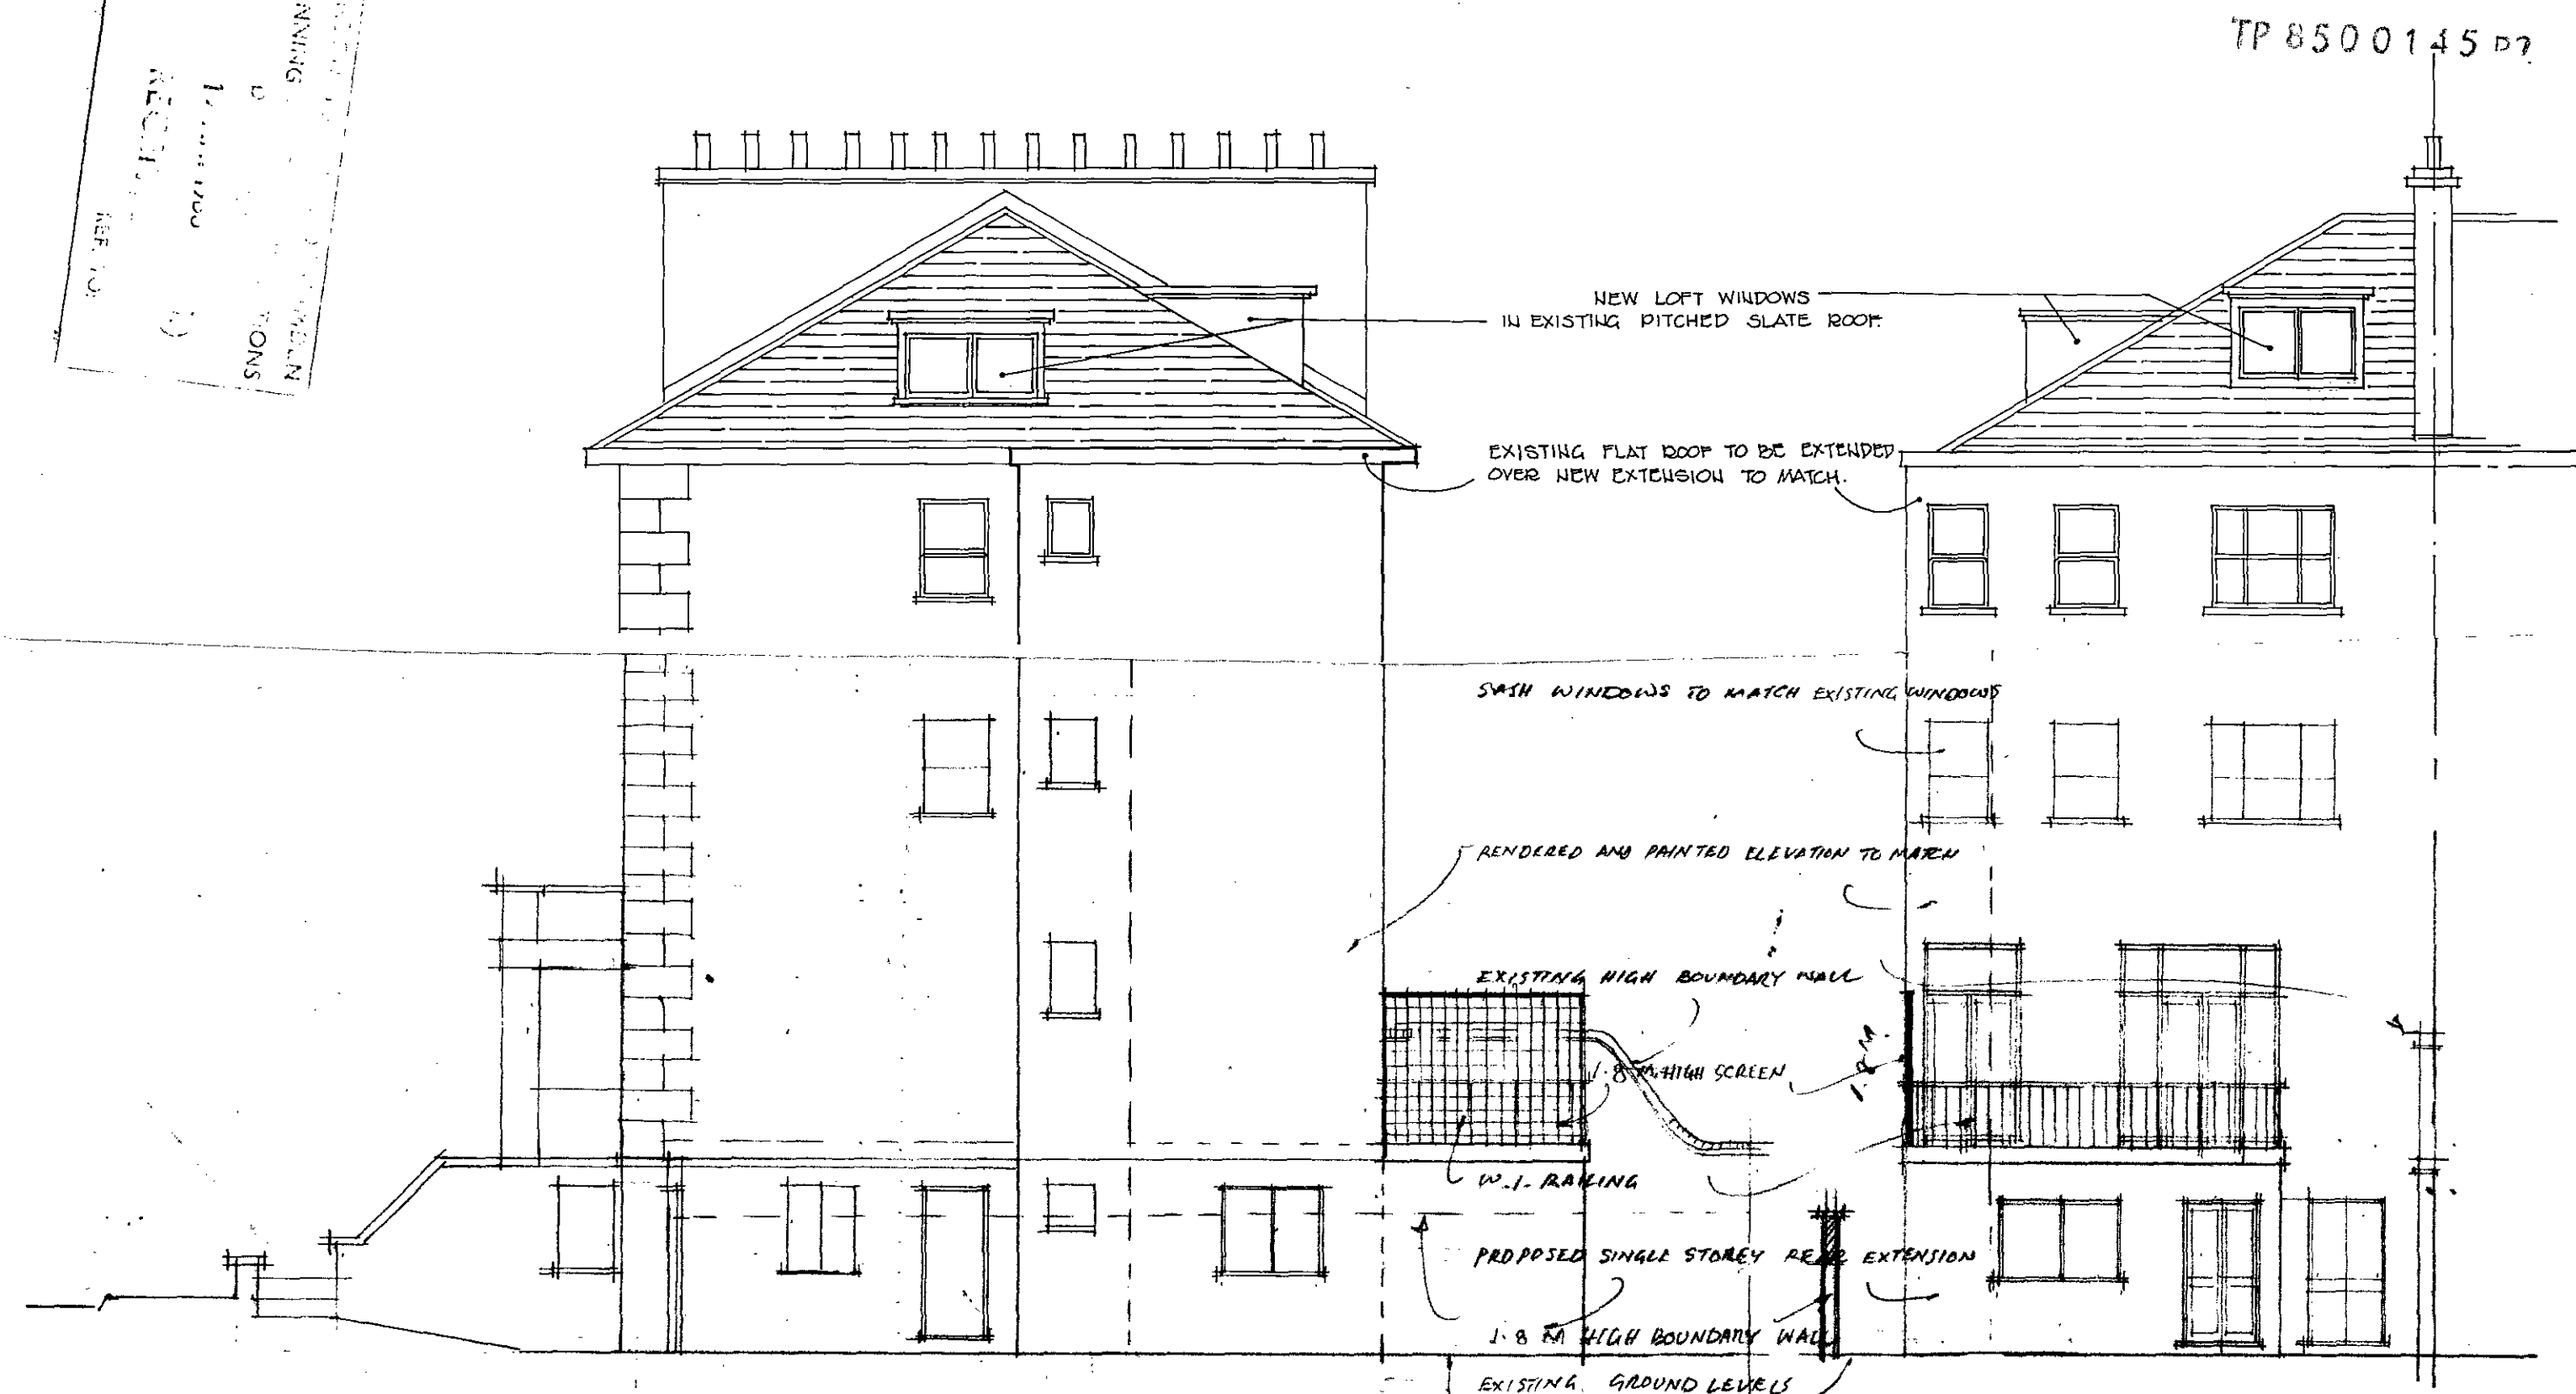

SIDE ELEVATION

REAR ELEVATION

LONDON BOROUGH OF CAMDEN
TOWN AND COUNTRY PLANNING ACTS
30 JUL 1985
APPROVED
PLANS ~~NOT APPROVED~~
ON BEHALF OF THE COUNCIL

REV. B BOUNDARY WALL TO BE RAISED
SCREEN ADDED TO TERRACE

7 BUCKLAND CR.
LONDON NW3

PROPOSED CONVERSION
INTO SELF CONTAINED FLATS

SCALE : 1/100
DATE : 2 JAN 85
REV : 2 X B

DESIGN ASSOCIATES
ARCHITECTS
75 ABBEY ROAD NW8
TEL: 01-625 5471
JOB REF. 148/3