

22768 (R1)⁴
①

Job No 12021
Date:- MAY 1976

- NOTES**
- * All work to Local Authority requirements, Building Regulations and latest Codes of Practice.
 - * Drainage works to C.P. 301, Plumbing works to C.P. 302. Foundations to bridge drains with lintols, and drains under extension encased in 6" in 6" concrete.
 - * 2 No. 6"x4 1/2" lintols + 3 No. 1/2" bars in each to all openings. D.P.C. to all reveals and lintols.
 - * Duct through underfloor ventilation.
 - * Damp proof courses and membranes to overlap all board.
 - * Prime all skirtings, fascias etc. before fixing.
 - * 3" fibre glass insulation to all exposed roof faces.
 - * Take site measurements and not scale plans.
 - * Roof covering to B.S. 147 and hot bonded to C.P. 144.
 - * Ventilation to rooms 8% of floor area.
 - * 2" deep seal traps to all fittings.
 - * CRICK BLOCKS TYPE 'B' TO B.S. 2028
 - * 41 KEPTONS/M.M. 7 TO C.P. 114 LAMB REPAIR WALLS, CAPACITY 6000 lbs/ft. RUN
 - * U-value - 15, 'U' value 74W/M² °C.

LONDON BOROUGH OF CROYDON
TOWN AND COUNTRY PLANNING ACT

28 SEP 1976
PLANS ~~NOT APPROVED~~ APPROVED
ON BEHALF OF THE COUNCIL

AMENDMENT
SLOPE TO ROOF 19.7.76
REDUCE ROOM SIZE 11.8.76




Client:- MR. L.R. ELLIOTT

PROPOSED
STUDY

EXTENSION
22 QUICKSWOOD NW3

Plans by:- M. Leatherby

Scales:- 1/4" = 1'0" to 1'-0"

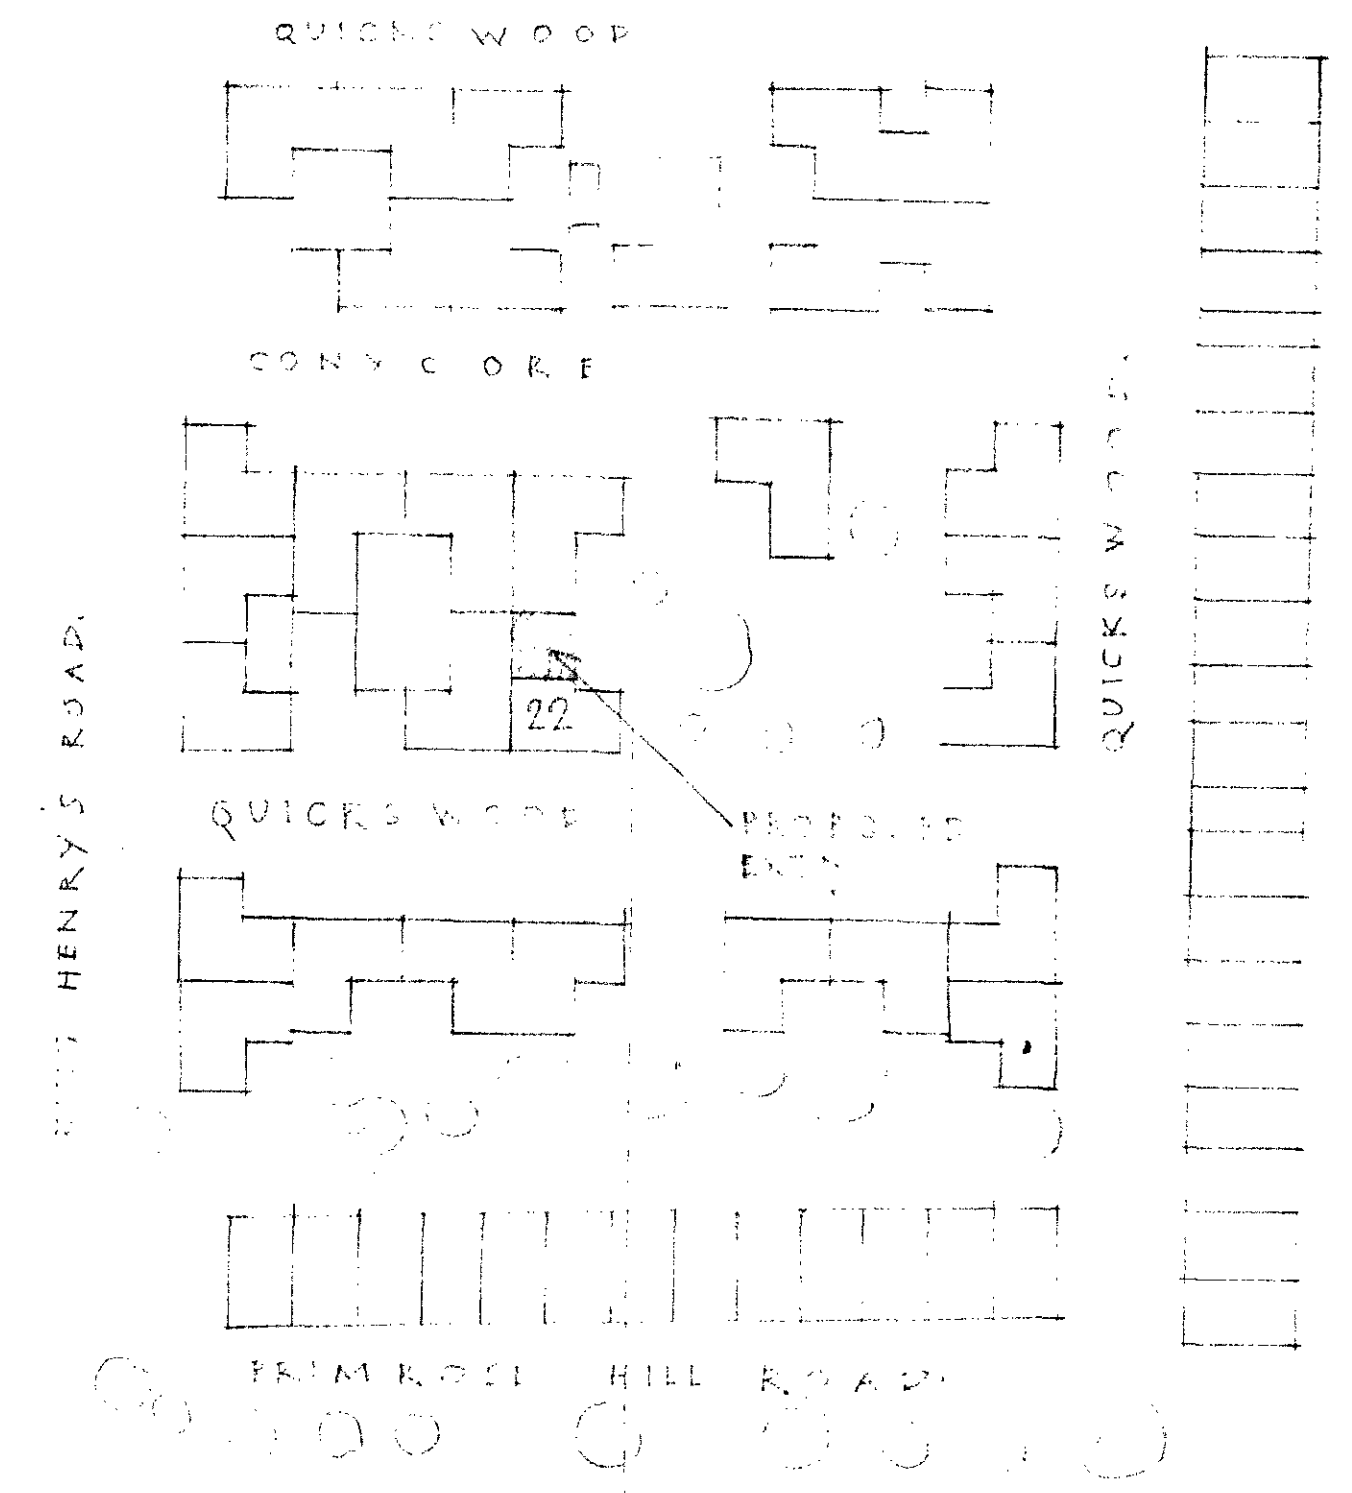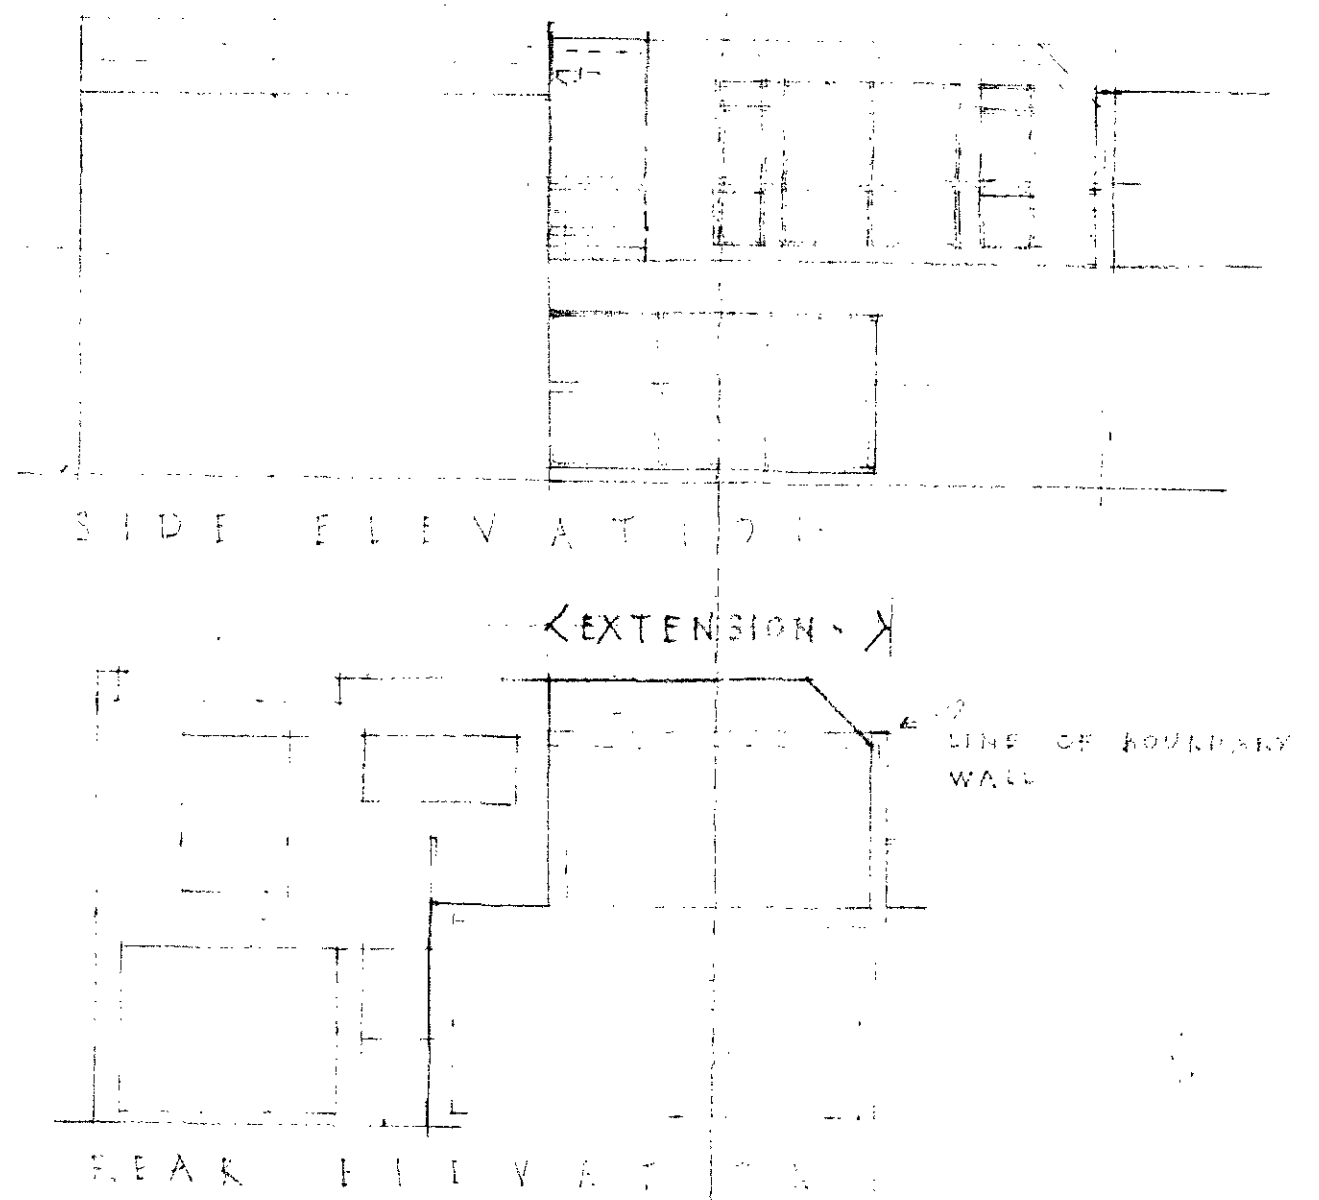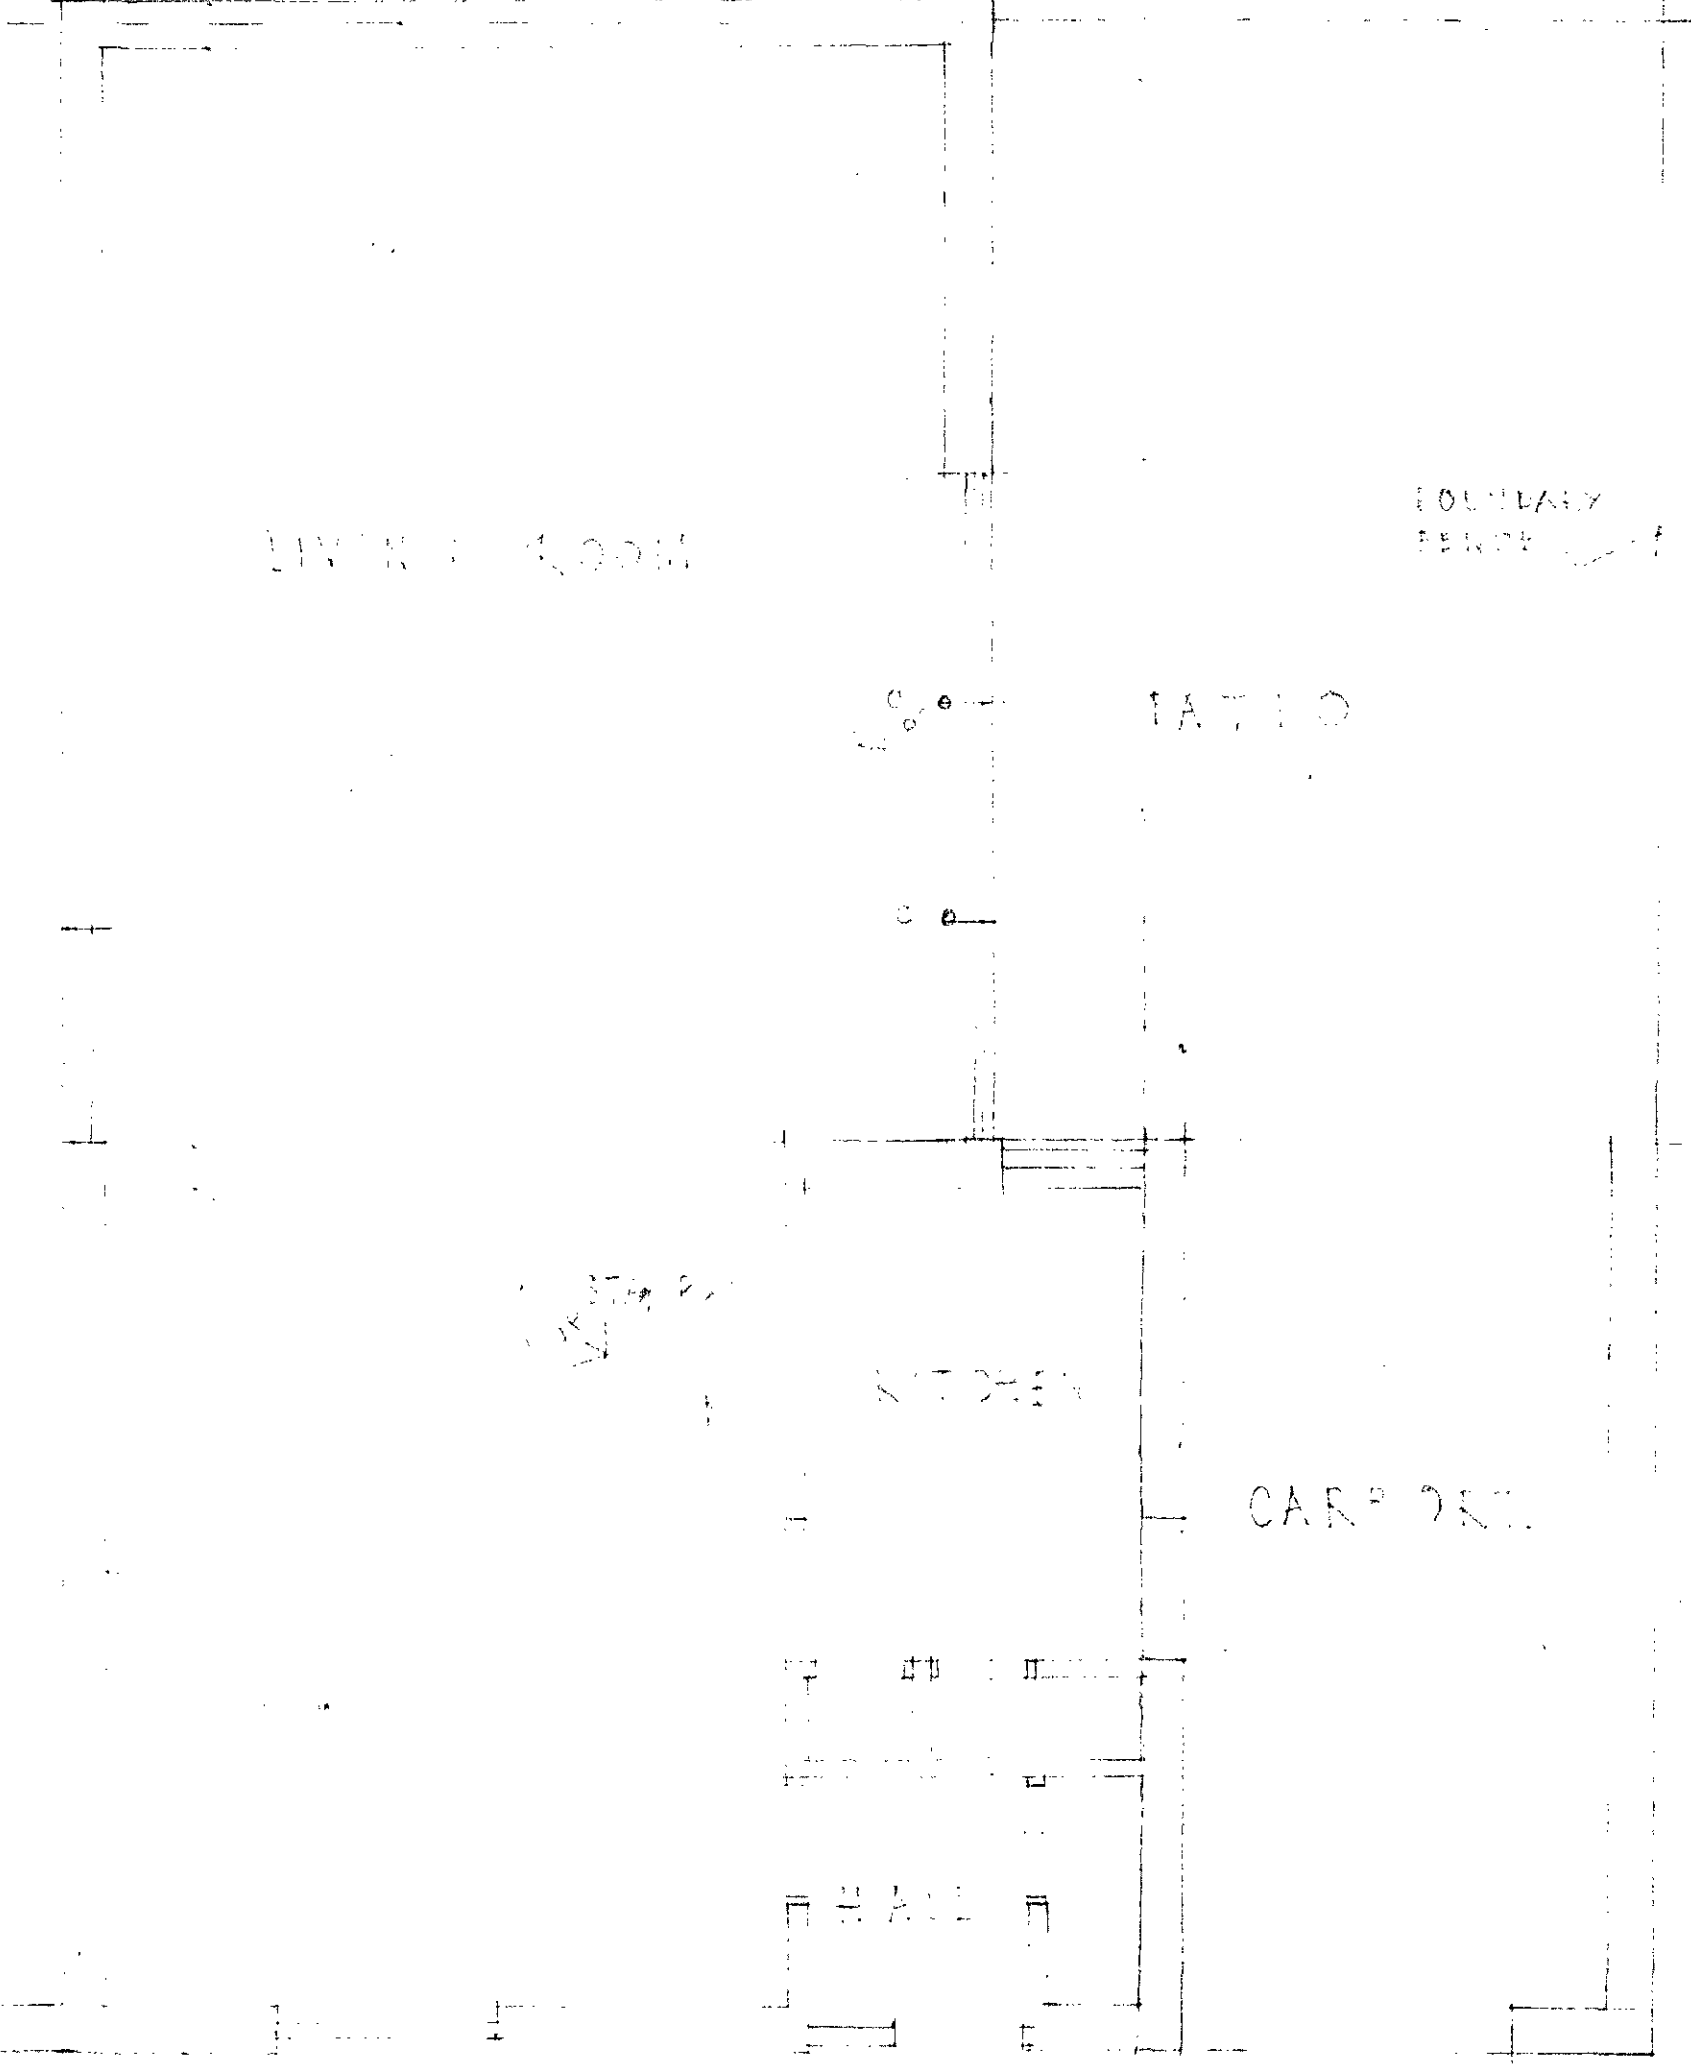

SUNNYSIDE HOME EXTENSIONS LTD.

3, QUEX ROAD, N.W.6

01-328-7248/49

(2)

Date:- MAY 1976

NOTES

- All work to Local Authority requirements, Building Regulations and latest Codes of Practice.
- Drainage works to C.P.301, Plumbing works to C.P.308, Foundations to bridge drains with lintols, and drains under extension located in "in" to "out" line.
- 2 No. 6" x 4" lintols - 3 No. 8" bars in each at all openings. D.R.C. to all reveals and lintols.
- Duct through under floor ventilation.
- Bump proof courses and membranes to overlap all boards.
- Prime all skirtings, fascias etc. before fixing.
- 2" Fibre glass insulation to all exposed roof faces.
- Take site measurements and not scale plans.
- 2" deep cuttings to B.S.747 and not bonded to C.P.146.
- Ventilation to rooms 80% of floor area.
- 2" deep seal tops to all fittings.
- CRUCON blocks type 'B' to S.S.2028
- CRUCON type 'A' to C.P.146 before any work.
- CRUCON capacity 500 litres for 2000 W.H.U.
- W.H.U. value - 19, U value - 74% W.H.U.

AMENDMENT.
SLOPE TO ROOF 19.7.76
REDUCE ROOM SIZE 11.8.76

BUILDING
DESIGN




3, QUEX ROAD,
LONDON, N.W.6.
tel:- 01-328-7240

Client:- MR LR. ELLIOTT

PROPOSED STUDY
EXTENSION.
22 QUICKSTART NWS

Plans by:- M. Leatherby

Scales:- $\frac{1}{4}" + \frac{1}{8}"$ to 1'-0"

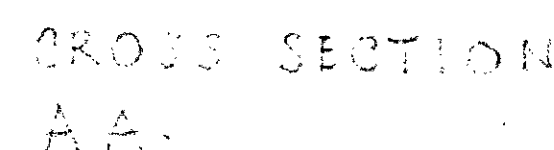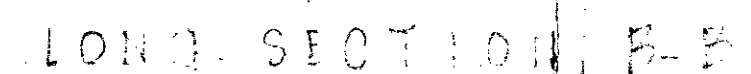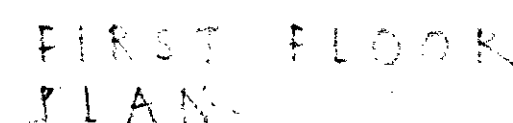

LONDON BOROUGH OF CAMDEN
TOWN AND COUNTRY PLANNING ACTS

28 SEP 1976

PLANS ~~NOT APPROVED~~ APPROVED
ON BEHALF OF THE COUNCIL

CTP/H8/11X A(xiv)/82768(R)

SUNNYSIDE HOME EXTENSIONS LTD.

3. QUEX ROAD, N.W.6

01-328-7248/49