


25356

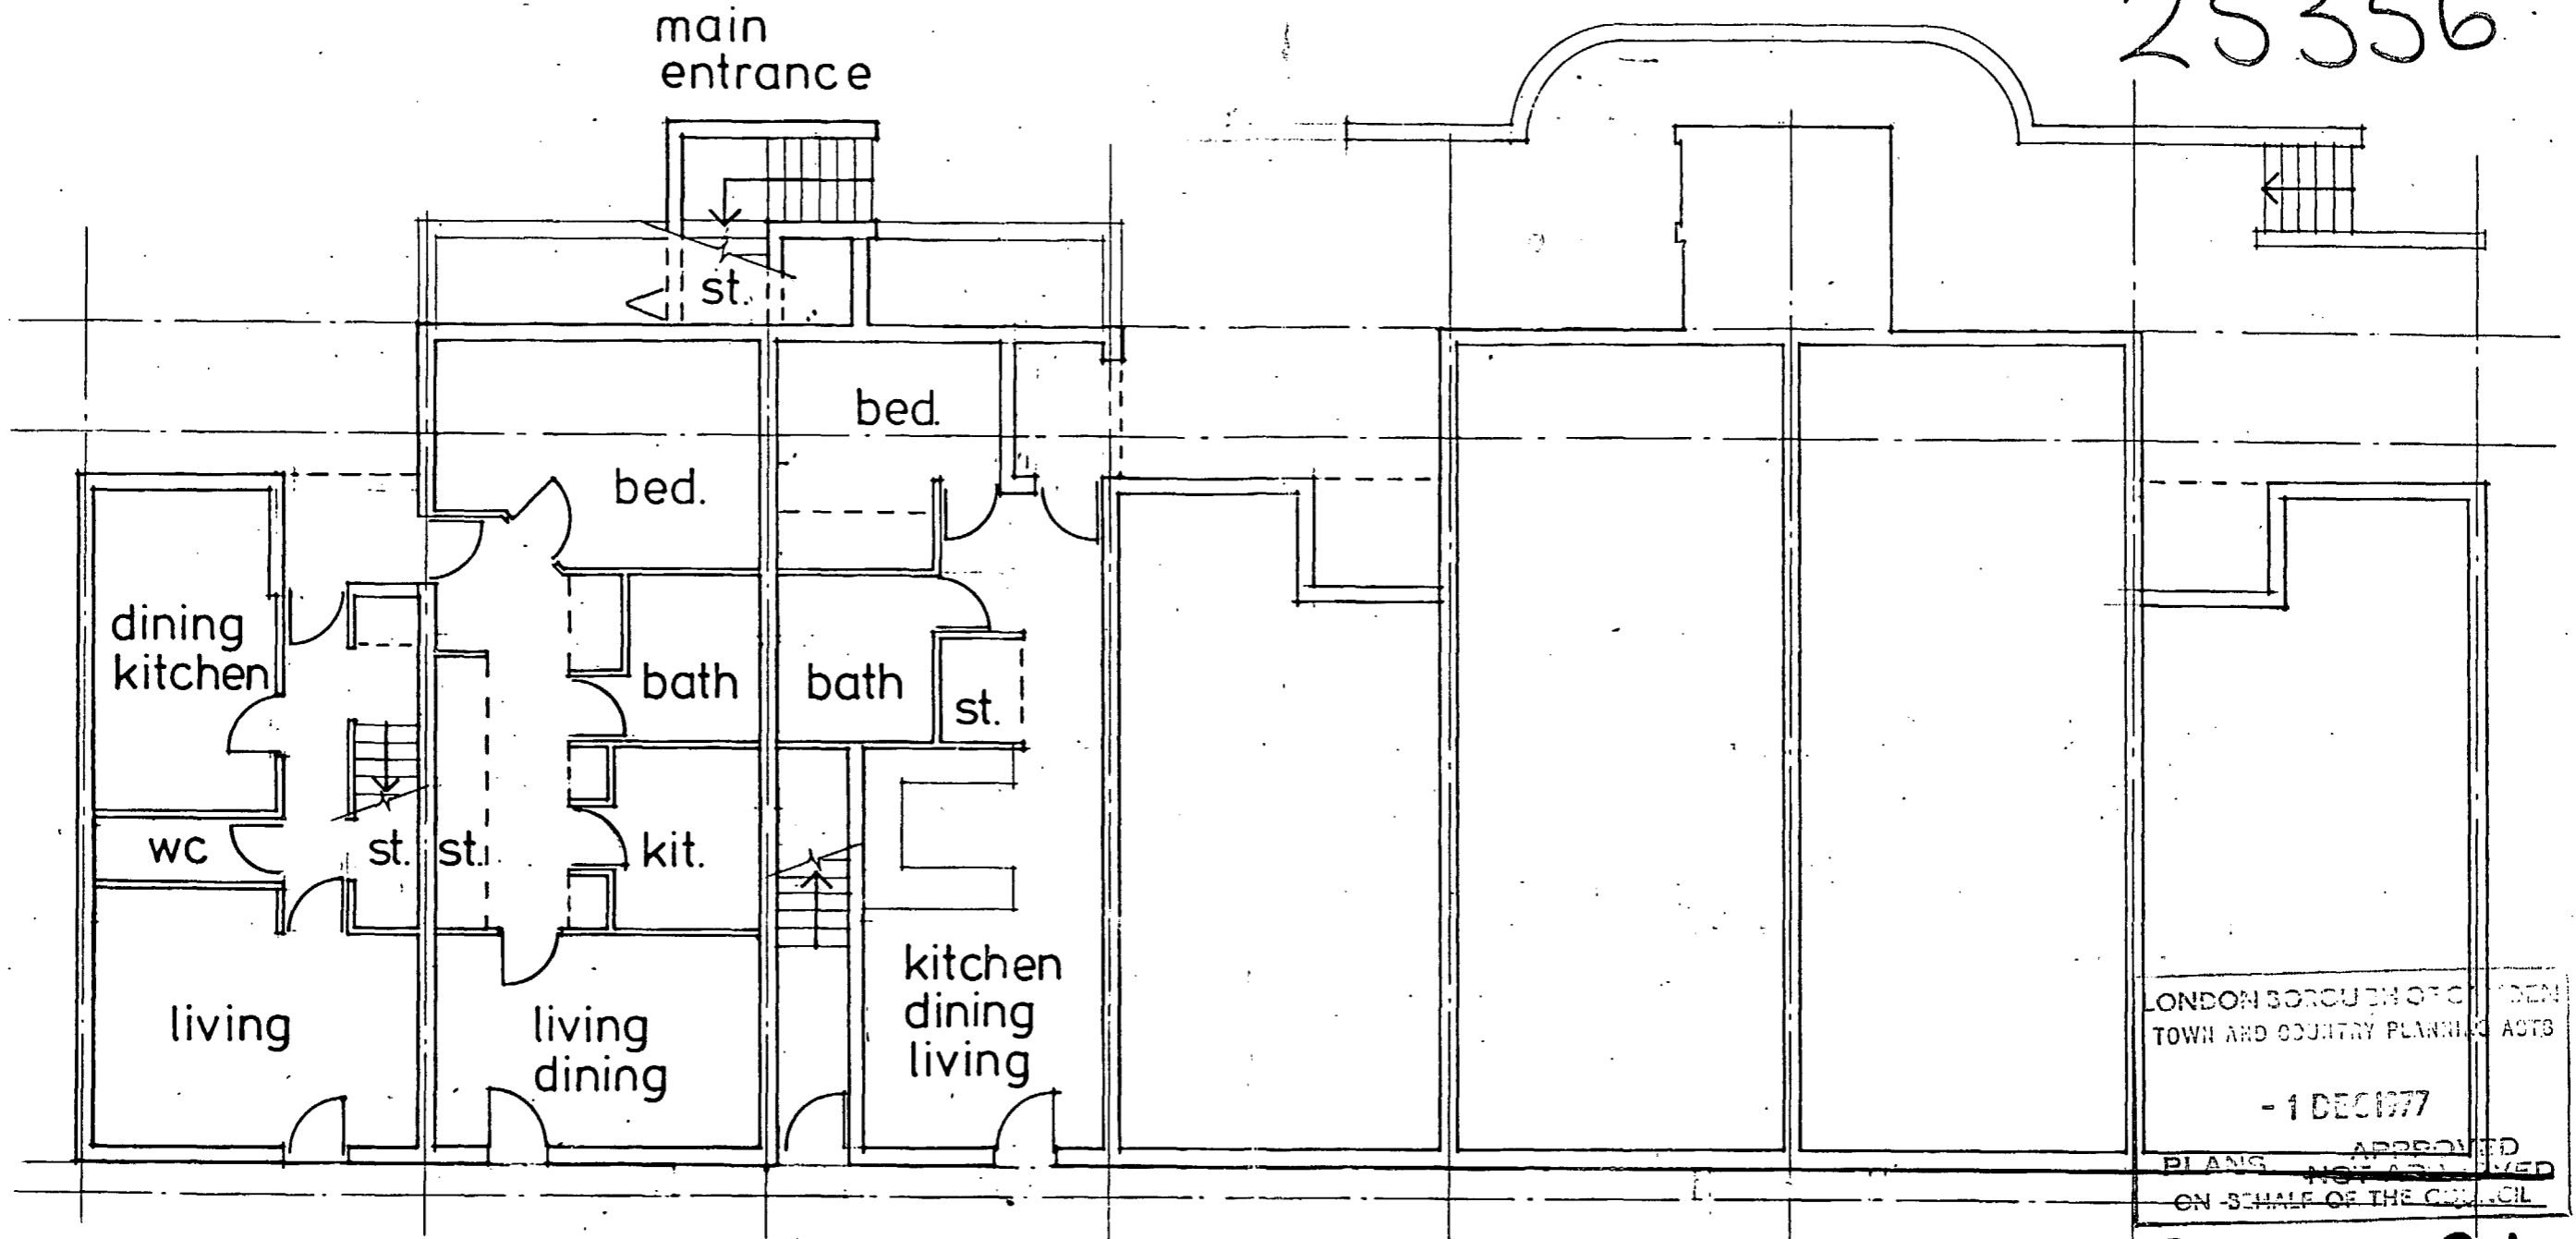

5 p maisonette
85.5 m²

2p flat
54.2 m²
(w'chair)

1 p flat
43.8 m²
(w'chair)


5p maisonette
85.5 m²

1p flat
43.8 m²
(w'chair)

2p flat
54.2 m²
(w'chair)

5p maisonette
85.5 m²

CASE COPY.

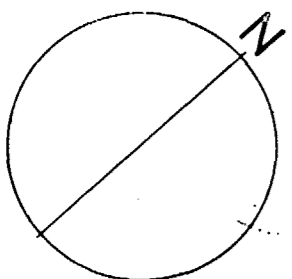

rear garden

(A) PLANS AND AREAS REVISED. 25 AUG. 1977.

Keith Roberts and Associates. Architects.
31 Murray Mews London NW1 9RH Telephone 01-485 9292


CTF/HB/3/A/25356.

Client	SHA	Scale	1:100	Drawing title	ground floor
Date	22 JUN 1977	Drawn	SC		

45-48 Camden Sq. 204 P12-1

25356

main entrance

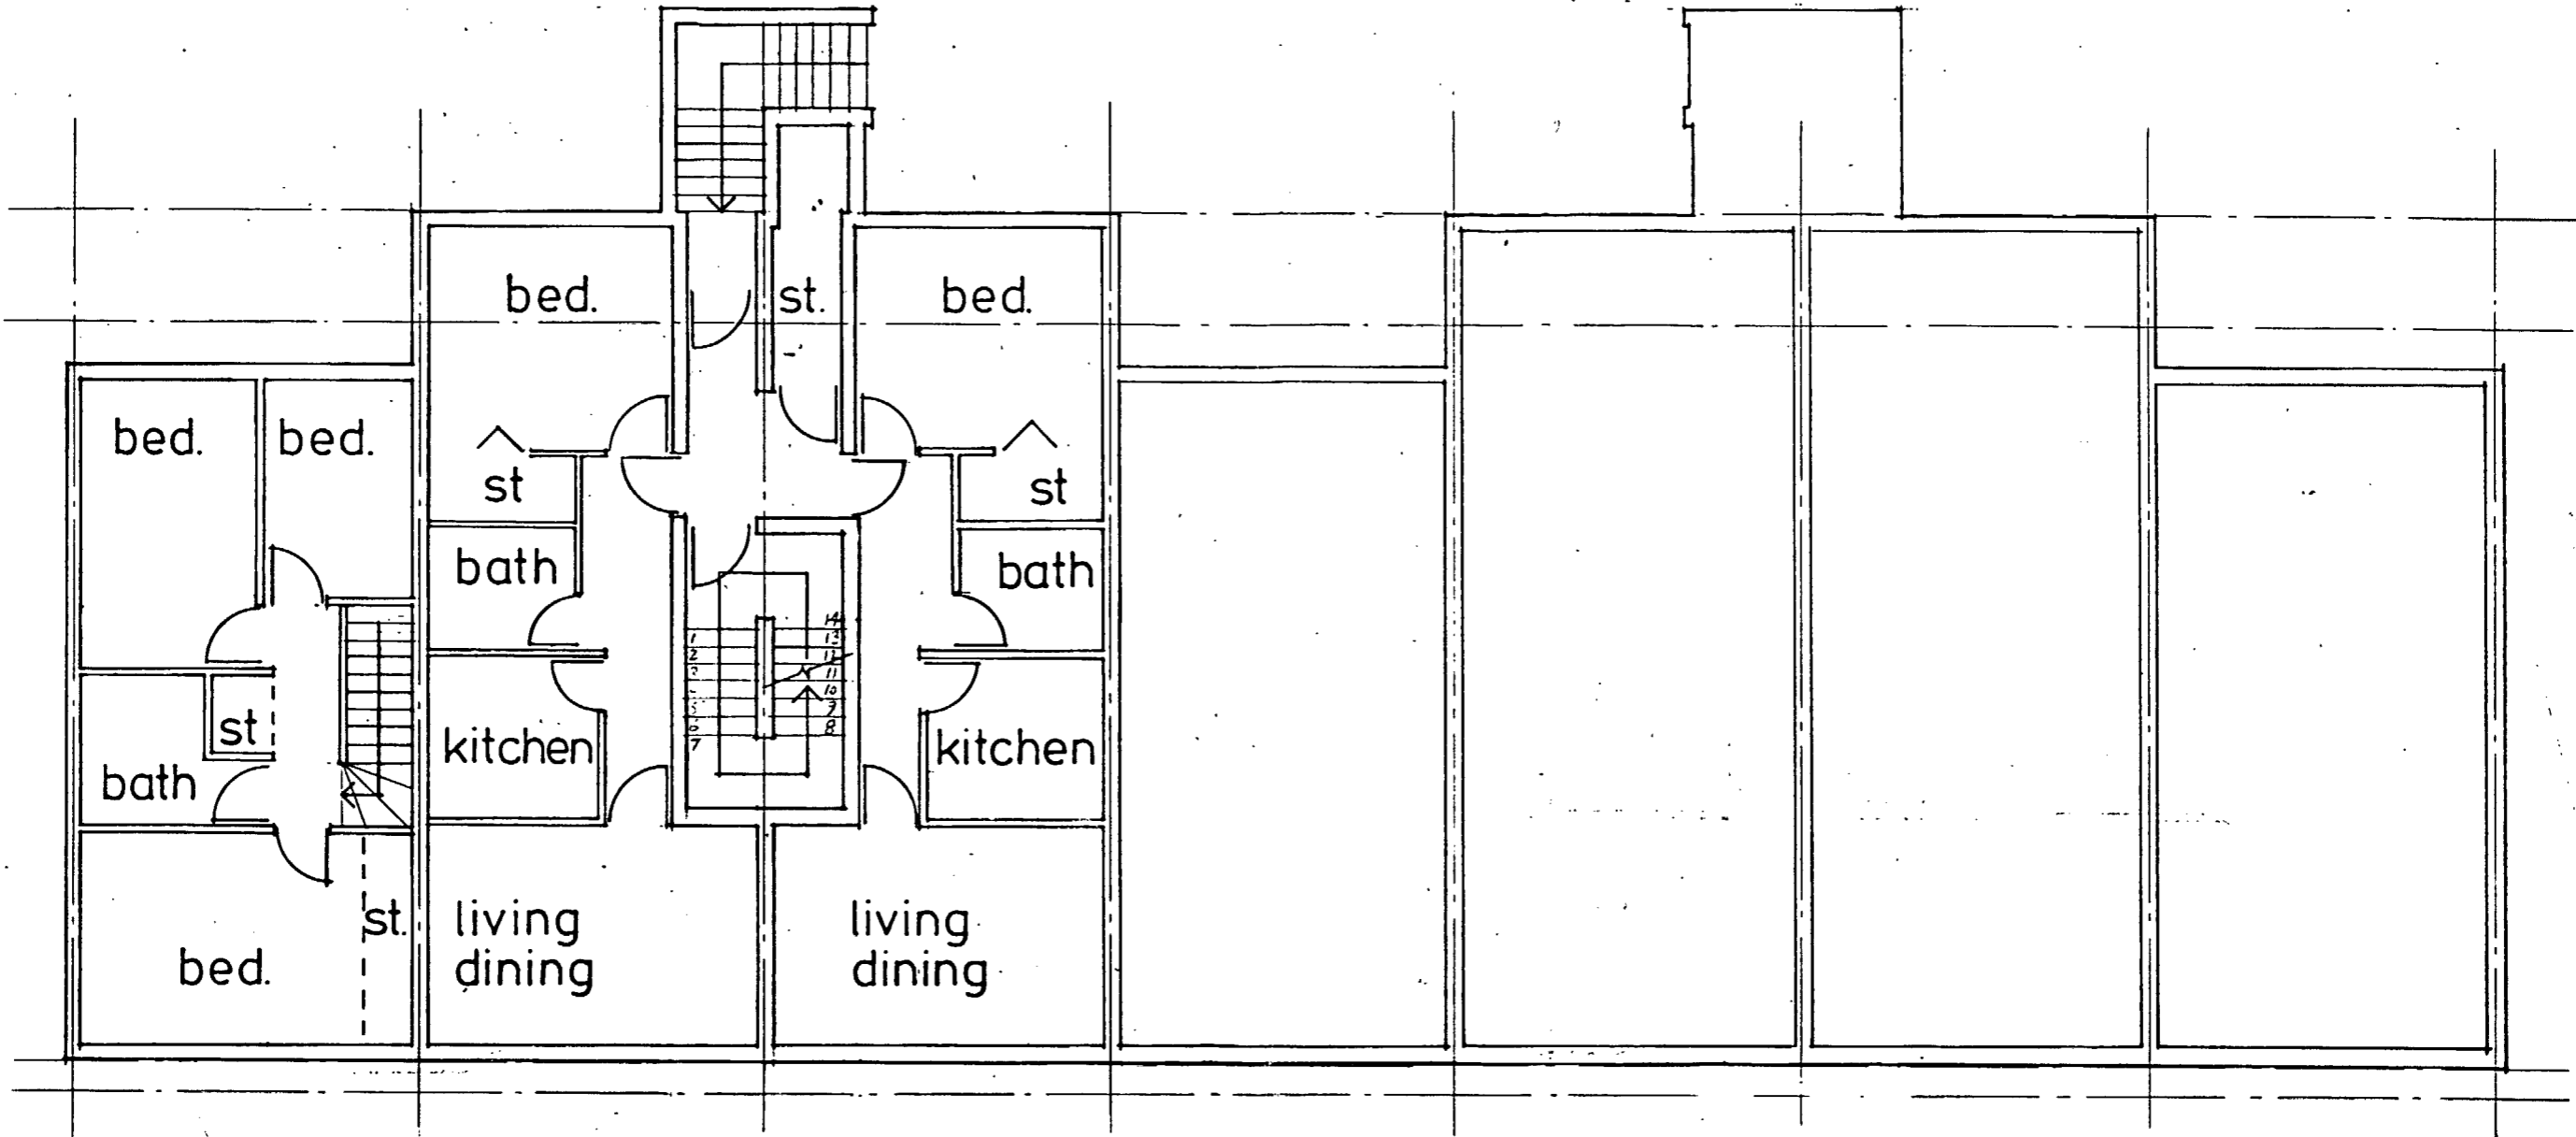

5 p maisonette
85.5 m²

2 p flat
47.5 m²


2 p flat
47.5 m²

5 p maisonette
85.5 m²

2 p flat
47.5 m²

2 p flat
47.5 m²

5 p maisonette
85.5 m²

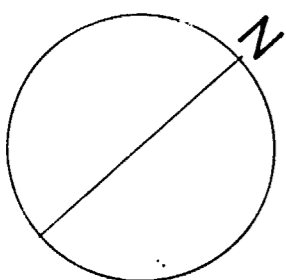

CASE COPY
 LONDON BOROUGH OF CAMDEN
 TOWN AND COUNTRY PLANNING ACTS
 - 1 DEC 1977
 PLANS ~~NOT APPROVED~~ APPROVED
 ON BEHALF OF THE COUNCIL

PLANS AND AREAS REVISED 26 AUG. 1977.


Keith Roberts and Associates. Architects.
31 Murray Mews London NW1 9RH Telephone 01-485 9292

CIP/H13/3/A/25356. A

Client	Scale 1:100	Drawing title
Date 22 July 77	Drawn DR	first floor

45-48 Camden Sq. 204 P12-2

25356

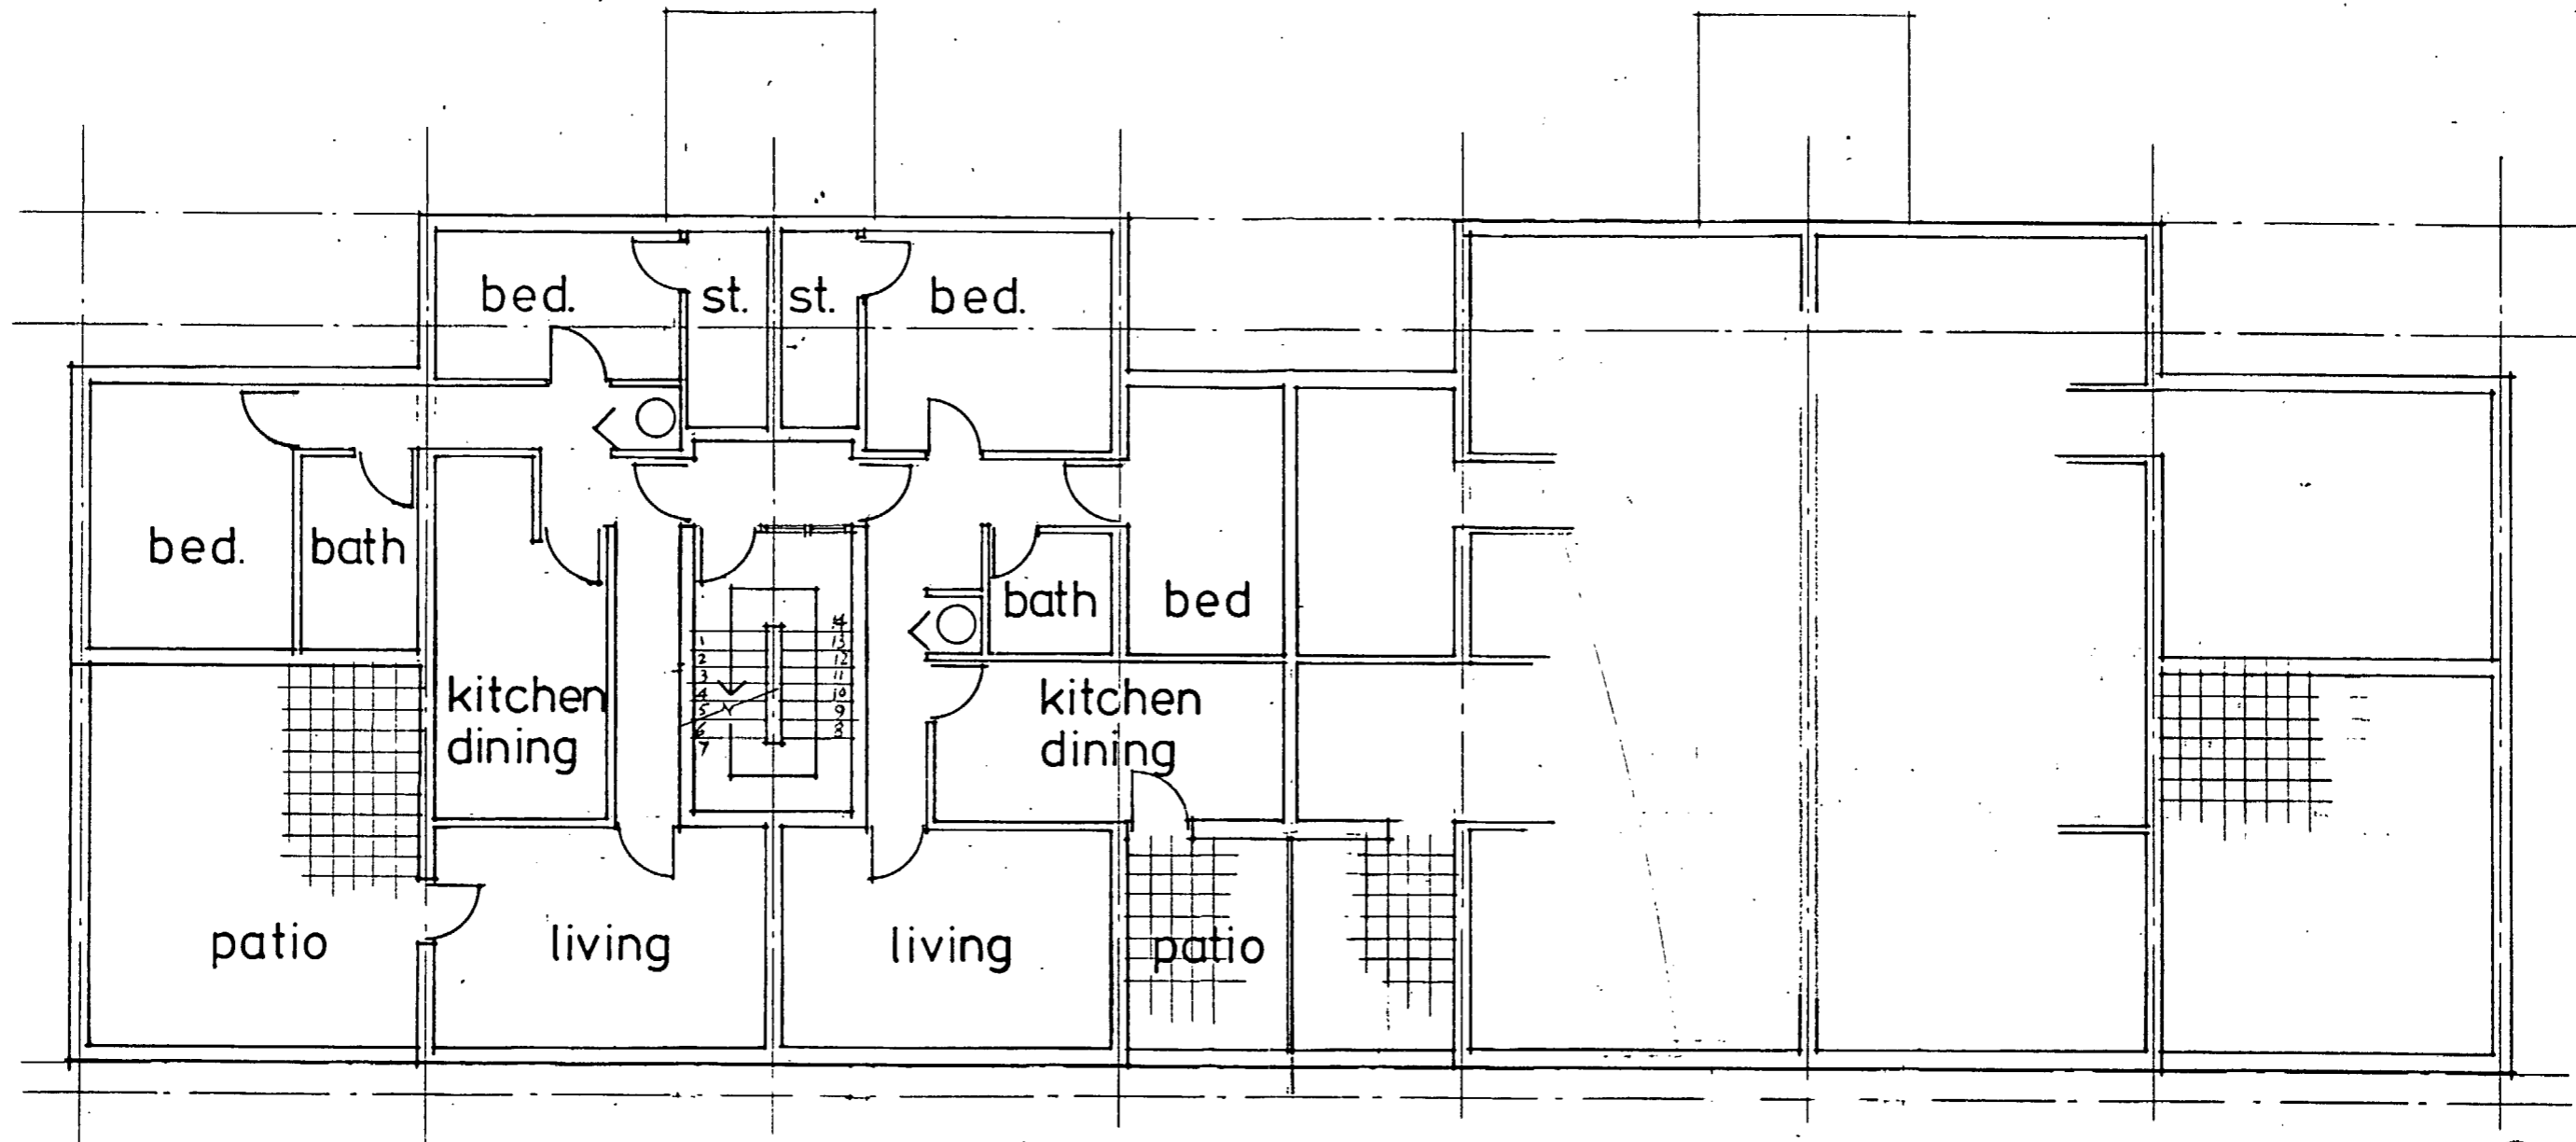

3 person flat
64.9 m²

3 person flat
60.7 m²

3 person flat
60.7 m²


3 person flat
64.9 m²

CASE COPY

LONDON BOROUGH OF CAMDEN
TOWN AND COUNTRY PLANNING ACTS

- 1 DEC 1977

PLANS ~~NOT APPROVED~~ APPROVED
ON BEHALF OF THE COUNCIL

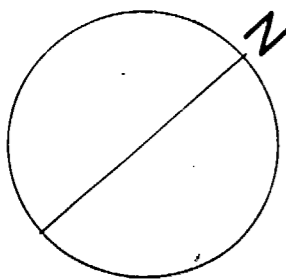

(A)

25 AUG. 1977


Keith Roberts and Associates. Architects.
31 Murray Mews London NW1 9RH Telephone 01-485 9292

CTP/HB/3/A/25356.

Client _____ Scale 1:100 Drawing title
Date 22 July 77 second floor
Drawn DR.

45-48 Camden Sq. 204 P12-3

25356

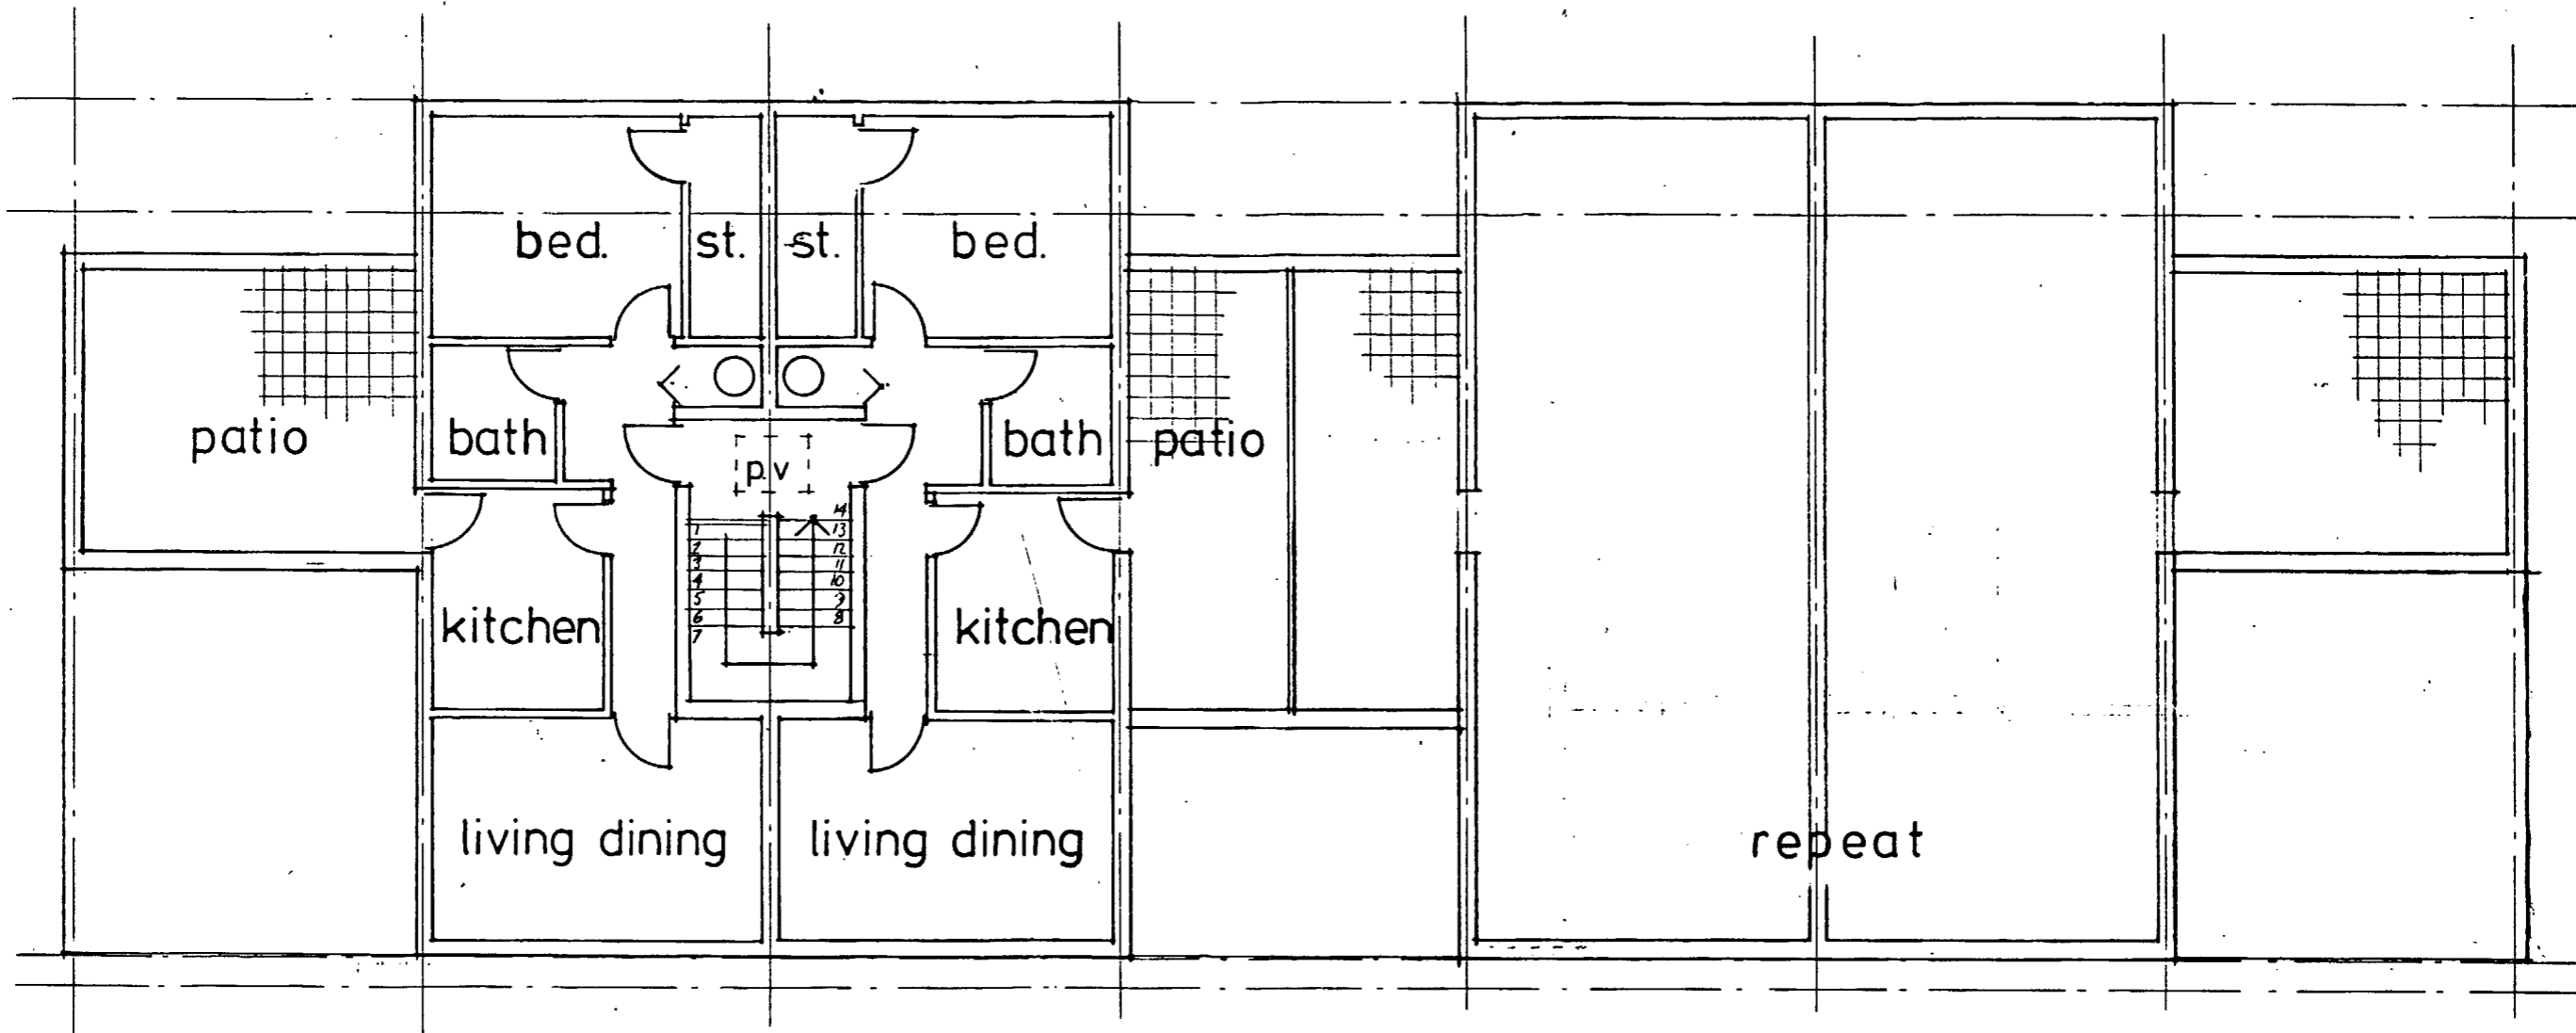


2 person flat
49.6 m²

2 person flat

2 person flat

2 person flat

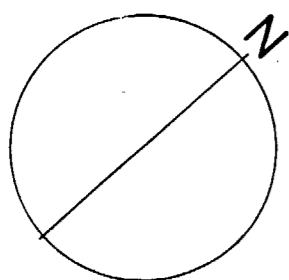


25 AUG. 1977

CASE COPY CTP/HB/3/A/25356.

LONDON BOROUGH OF CAMDEN TOWN AND COUNTRY PLANNING ACTS		(A)
- 1 DEC 1977		Keith Roberts and Associates. Architects. 31 Murray Mews London NW1 9RH Telephone 01-485 9292
PLANS NOT APPROVED APPROVED ON BEHALF OF THE COUNCIL	Client CHA	Scale 1:100 Date 22 July 77 Drawn R.
Job title 45-48 Camden Sq.		Drawing title third floor
		204 P12-4

25356

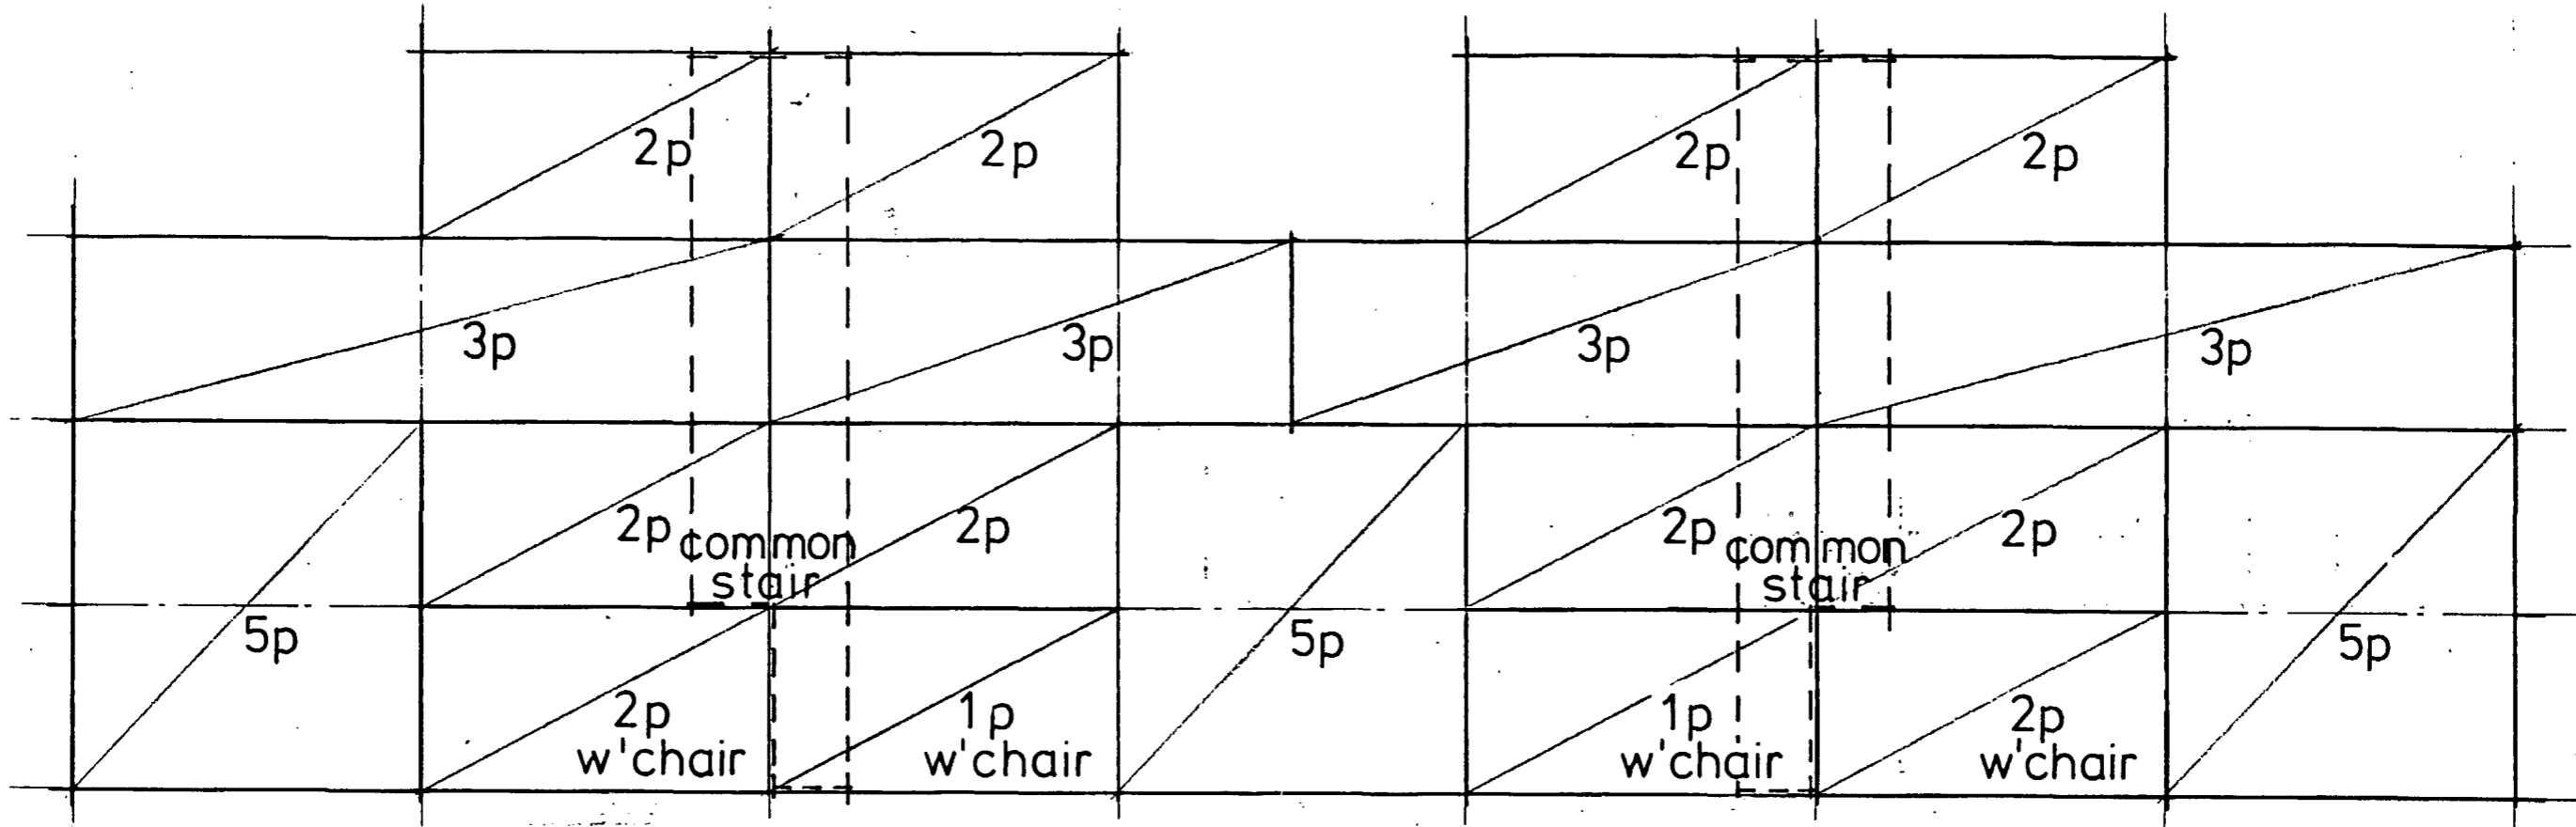

unit types	no. of units	no. of people
w'chair 1p flat	2	2
2p flat	8	8
w'chair 2p flat	2	4
3p flat	4	12
4p -	-	-
5p maisonette	3	15
6p -	-	-
totals	19 units	49 people

block section

CTP/H3/3/A/25356


CASE COPY
 LONDON BOROUGH OF CAMDEN
 TOWN AND COUNTRY PLANNING ACTS
 - 1 DEC 1977
 PLANS ~~NOT APPROVED~~ APPROVED
 ON BEHALF OF THE COUNCIL

26 AUG. 1977
 2 N° 1P UNITS ON LEVEL 2 BECOME 2 N° 2P UNITS
 2 N° 2P W'CHAIR UNITS BECOME 2 N° 1P W'CHAIR.

Keith Roberts and Associates. Architects.
 31 Murray Mews London NW1 9RH Telephone 01-485 9292

Client **CHA** Scale 1:100
 Date 22 July 77 Drawing title
 Drawn **DR** **block section**
 Job title 45-48 Camden Sq. 204 P12-5

25356

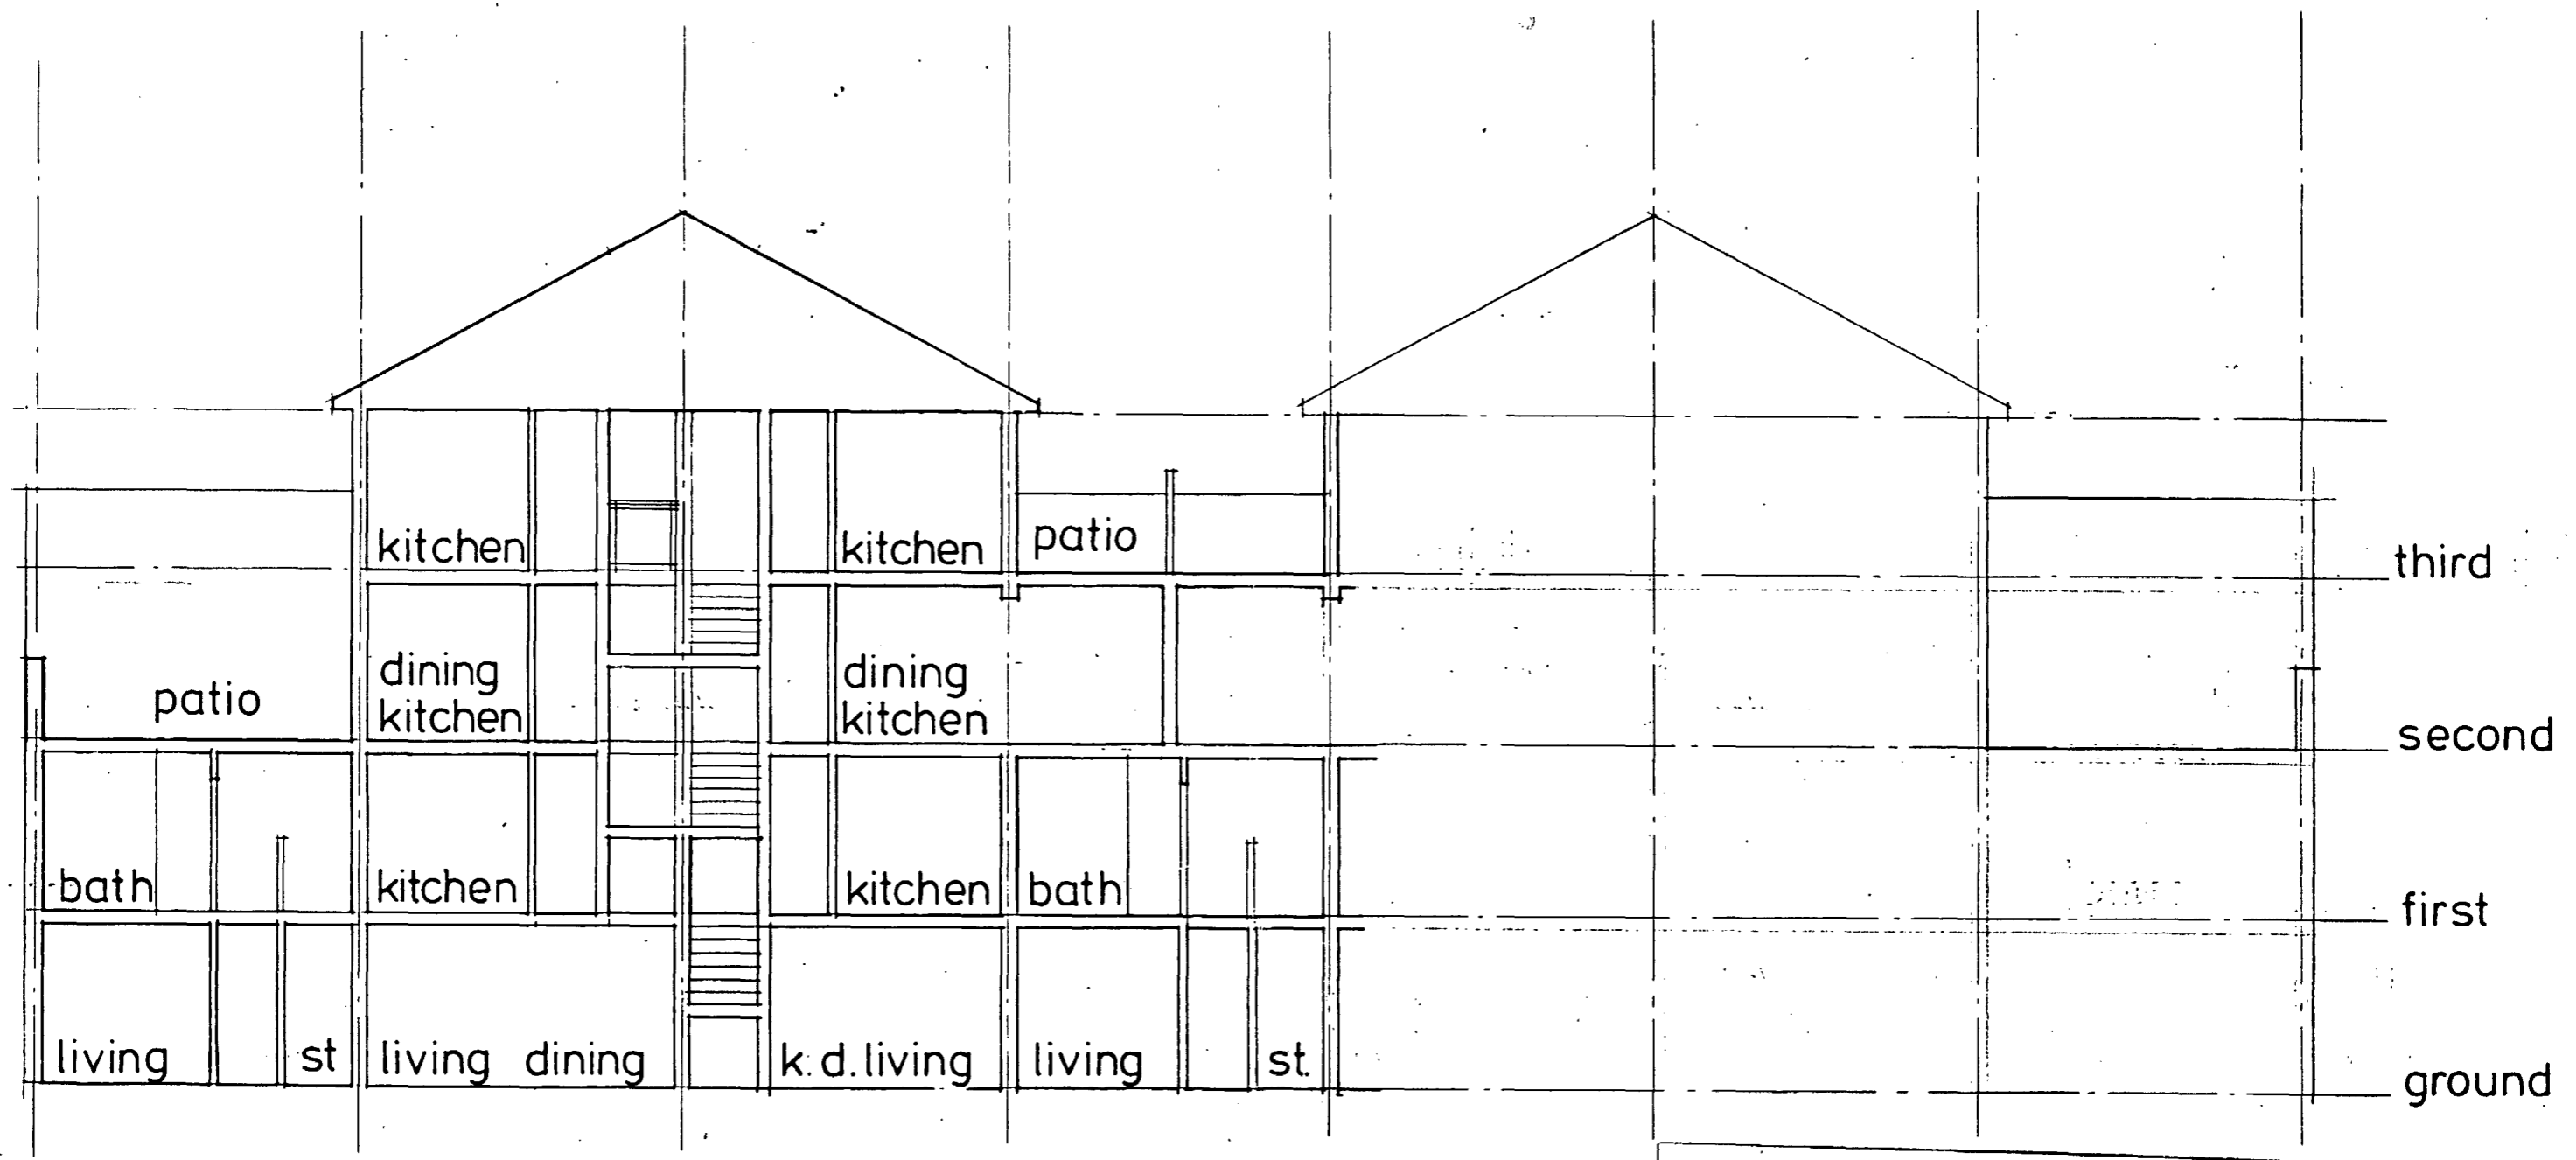


CTP/H13/3/A/25356.

CASE COPY


LONDON BOROUGH OF CAMDEN TOWN AND COUNTRY PLANNING ACTS	REVISED	26 AUG. 1977.
- 1 DEC 1977	Keith Roberts and Associates. Architects. 31 Murray Mews London NW1 9RH	Telephone 01-485 9292
PLANS APPROVED NOT APPROVED ON BEHALF OF THE COUNCIL	Client CHA	Scale 1:100 Date 26 July 77 Drawn DR
	Job title 45-48 Camden Sq	Drawing title long. section
		204 P12-6

25356

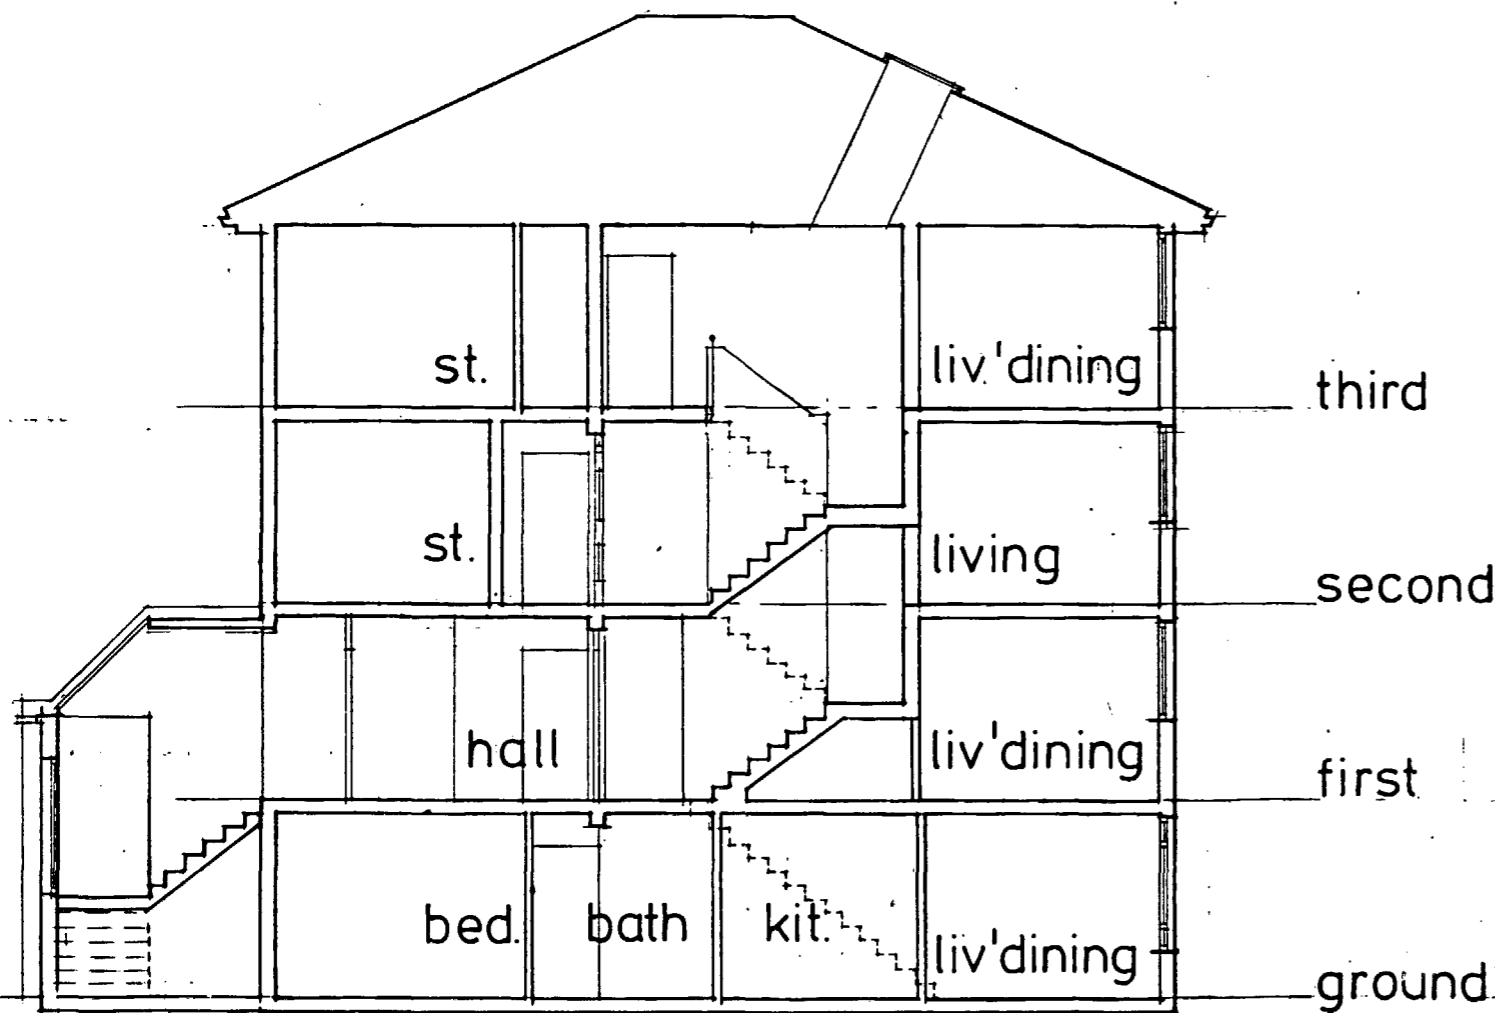

section thro' common stair.

A-A

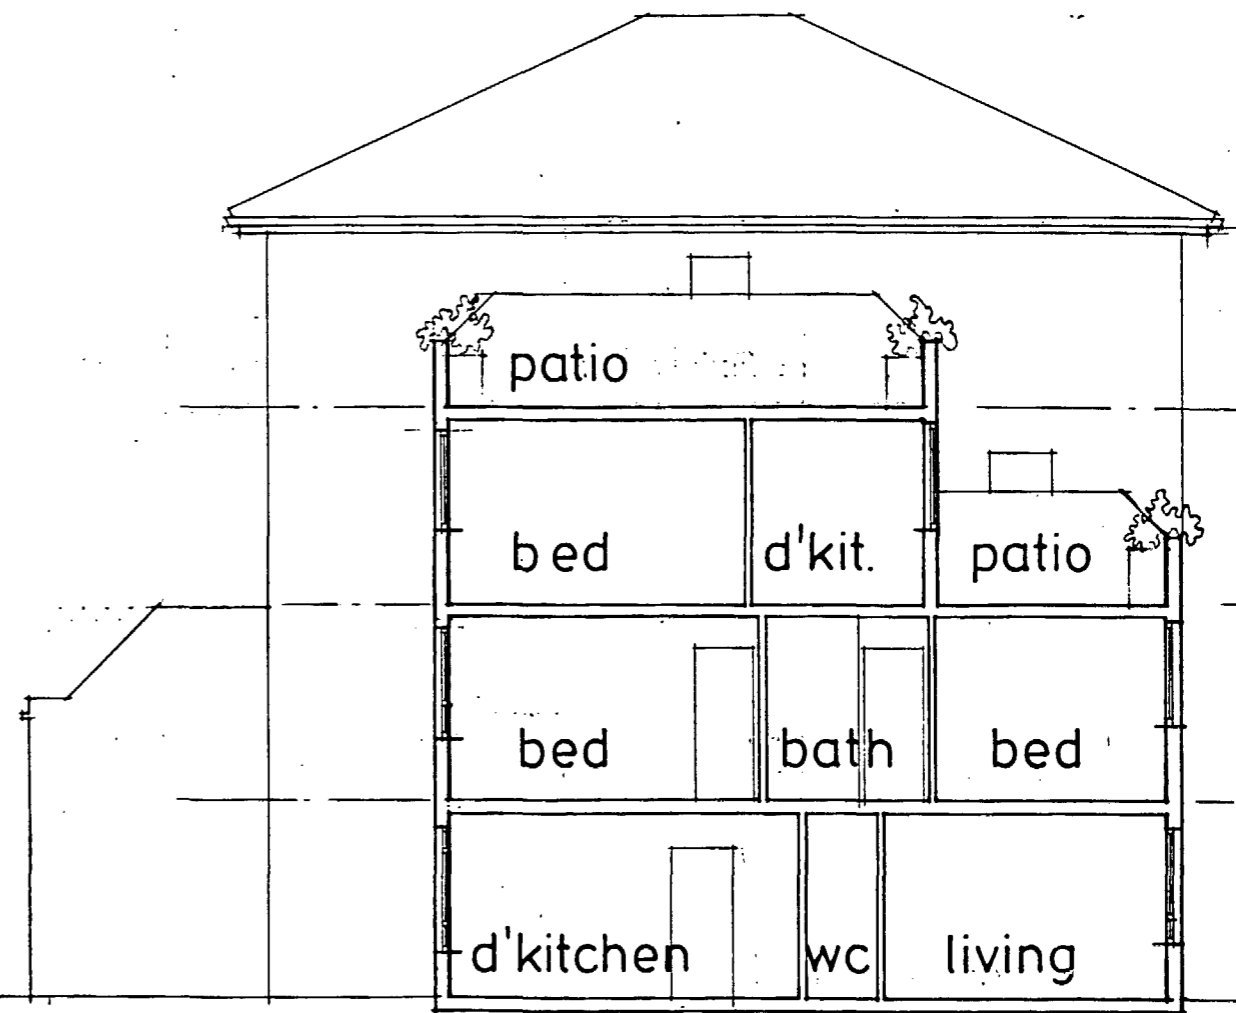

section thro' middle maisonette. B-B

(A) STAIRCASE ACCESS TO REAR GARDEN REVISED 25 AUG. 1977

LONDON BOROUGH OF CAMDEN
TOWN AND COUNTRY PLANNING ACTS
1 DEC 1977
PLANS ~~NOT APPROVED~~ APPROVED
ON BEHALF OF THE COUNCIL

Keith Roberts and Associates. Architects.
31 Murray Mews London NW1 9RH Telephone 01-485 9292


Client: CHA Scale 1:100 Drawing title: short section
Date 26 July 77 Drawn: BR

IP/HB/3/A/25356

45-48 Camden Sq. 204 P12-7

CASE COPY

25356

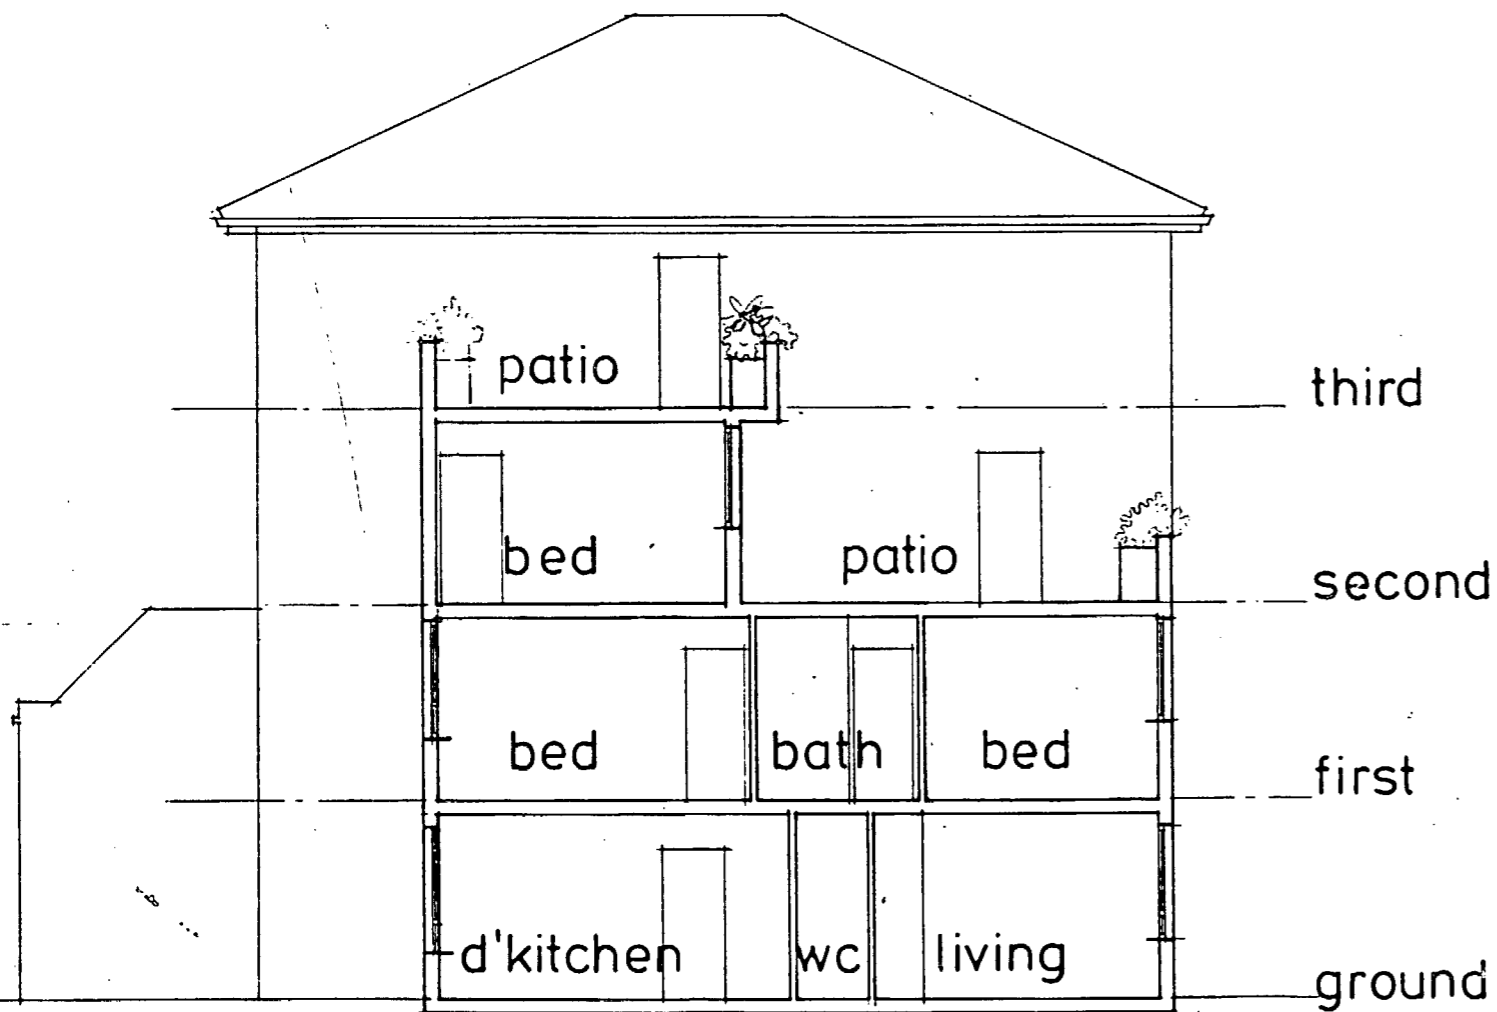

section thro' maisonette
adjoining no. 49

LONDON BOROUGH OF CAMDEN
TOWN AND COUNTRY PLANNING ACTS
- 1 DEC 1977
PLANS ~~NOT APPROVED~~ APPROVED
ON BEHALF OF THE COUNCIL


CASE COPY.

CTP/HB/3/A/25356.


Keith Roberts and Associates. Architects.
31 Murray Mews London NW1 9RH Telephone 01-485 9292

Client CHA	Scale 1:100 Date 1 SEPT 77 Drawn DR	Drawing title section C
Job title 45-48 Camden Sq.	204 P12-10	

25356

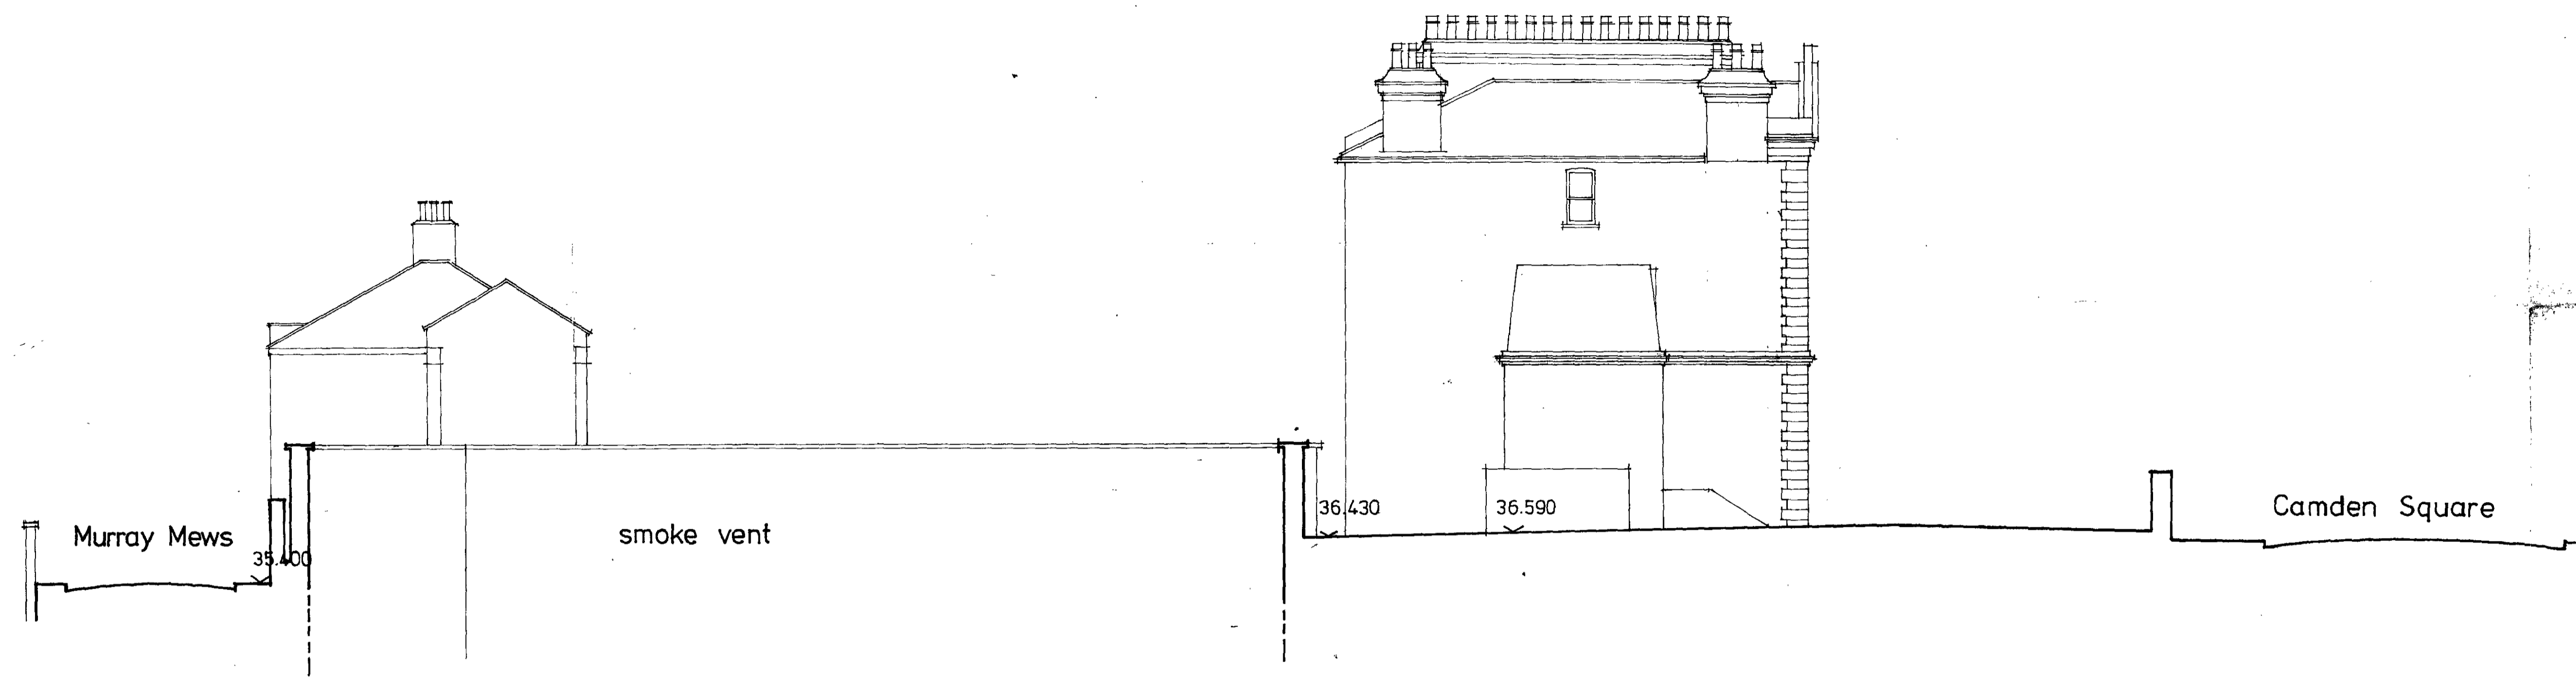

AS EXISTING

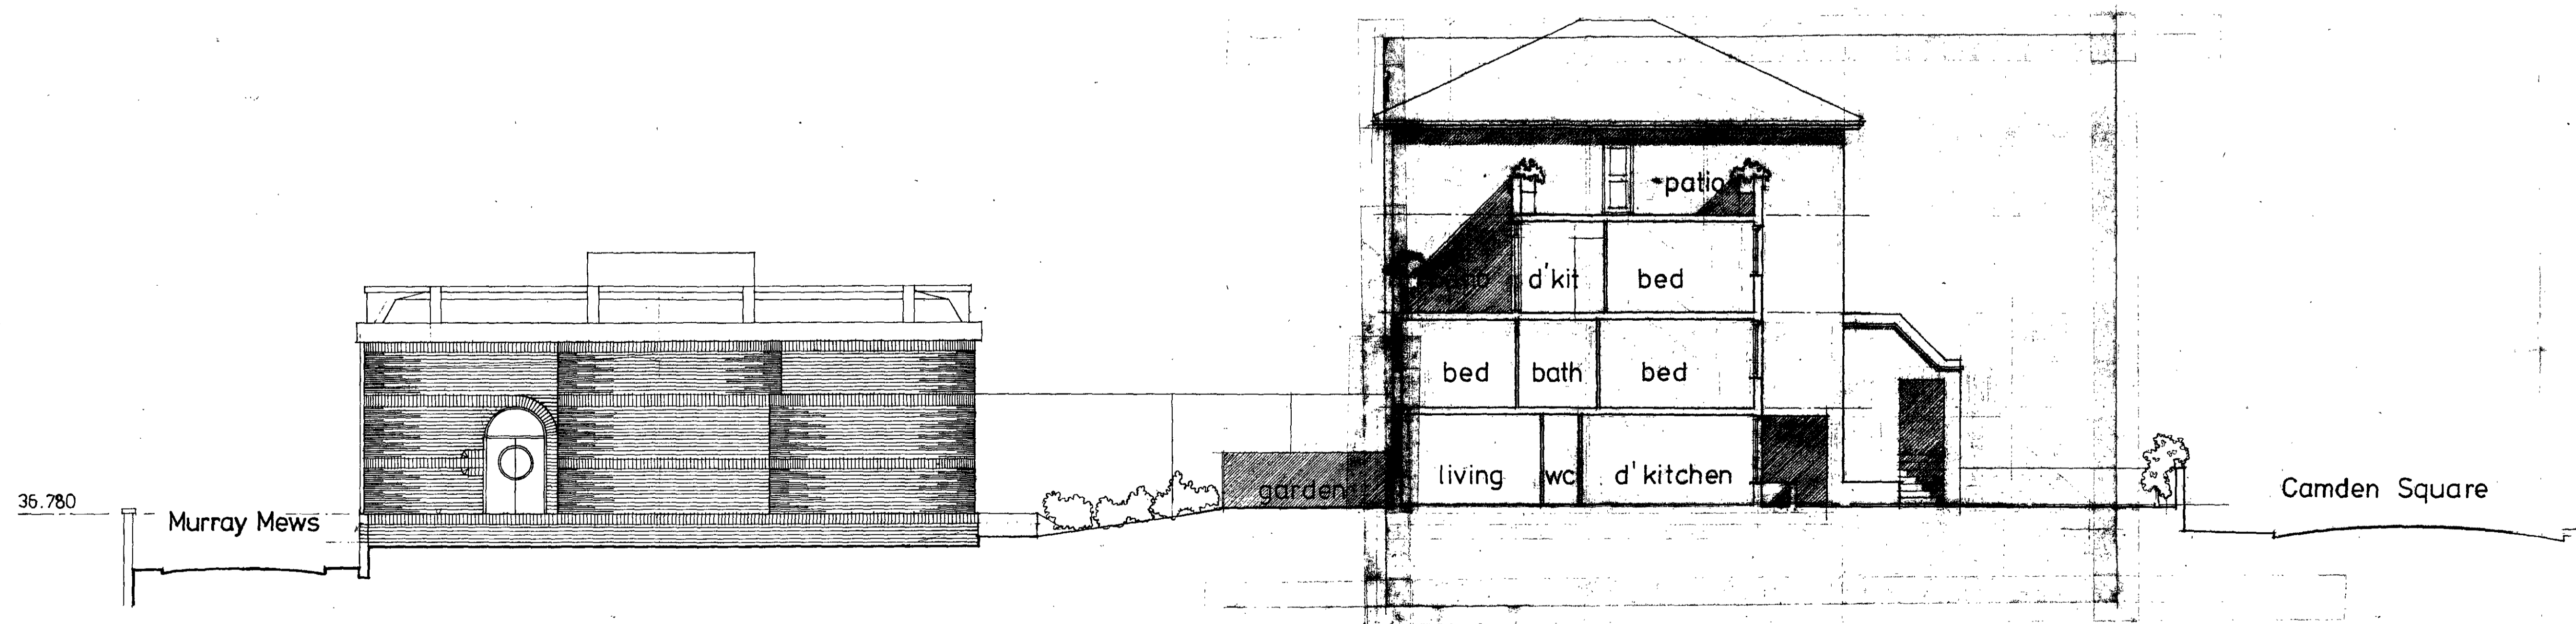

AS PROPOSED

NEW HA

- D 20 SEPT. 1977
NEW DESIGN. DC.
- C 15 JANUARY 1977
NEW HOUSING REVISED.
- B 4 JANUARY 1977
NEW HOUSING REVISED.
- A 19 OCTOBER 1976
SECTION AS EXISTING ADDED.
PUMP ROOM ADDED TO PROPOSED
SECTION.

Amendments

THE IRISH CENTRE

Existing & Proposed
SECTION ACROSS
SITE

Scale	Date
1-100	Oct 1976
Job No.	174
Drawing No.	2-10
A B C D	

LONDON BOROUGH OF CAMDEN
TOWN AND COUNTRY PLANNING DEPARTMENT
-1 DEC 1977
PLANS APPROVED
ON BEHALF OF THE COUNCIL
CASE COPY.

CTP/HB/3/A/25356

Keith Roberts and Associates
Structs and Planning Consultants.
Murray Mews
London, NW.1.
Telephone 01-485 9200

Job Architect	Drawn
DAH	MSR
	Checked
	Traced

25356



C 14 SEPT. 1977
NEW DESIGN. DR.
B 19 JANUARY 1977
NEW HOUSING, REVISED
A 7 DECEMBER 1977
NEW HOUSING, REVISED

Amendments

THE IRISH CENTRE

As Existing & Proposed
ELEVATION & SECTION
LOOKING N. WESTWARD


Scale 1 to 100 Date Oct. 1976

Job No. 174

Drawing No. 2-7



Keith Roberts and Associates
Architects and Planning Consultants,
Murray Mews
London, N.W.1
Telephone 01-485 9292

Job Architect
D.A.H.
Drawn M
Checked
Traced

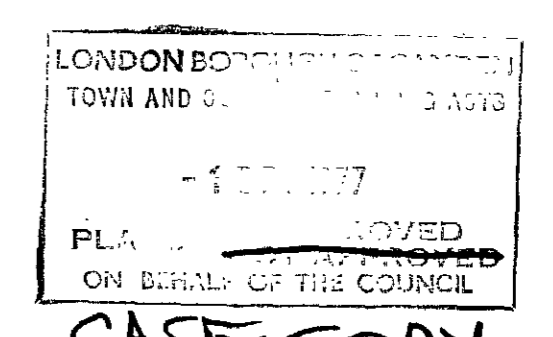

CASE COPY
CTD/HB/3 / A / 25356

25356

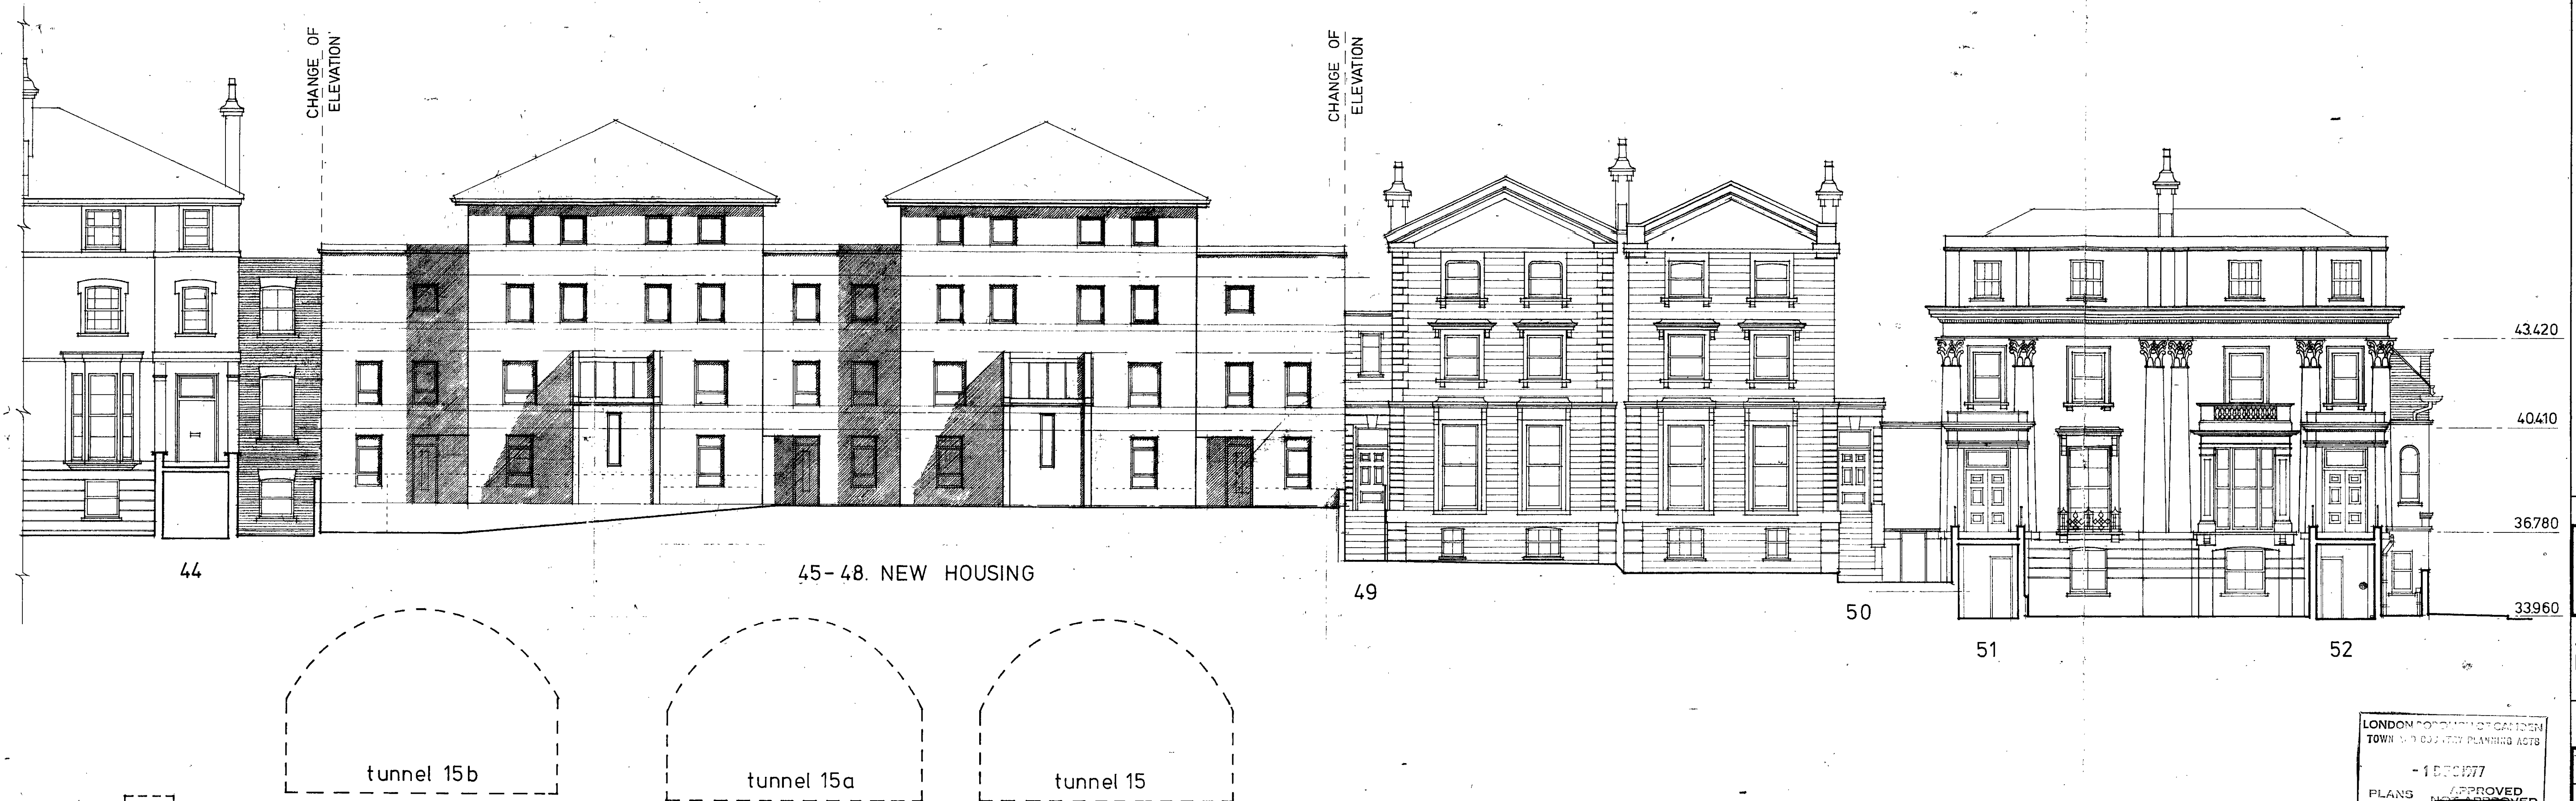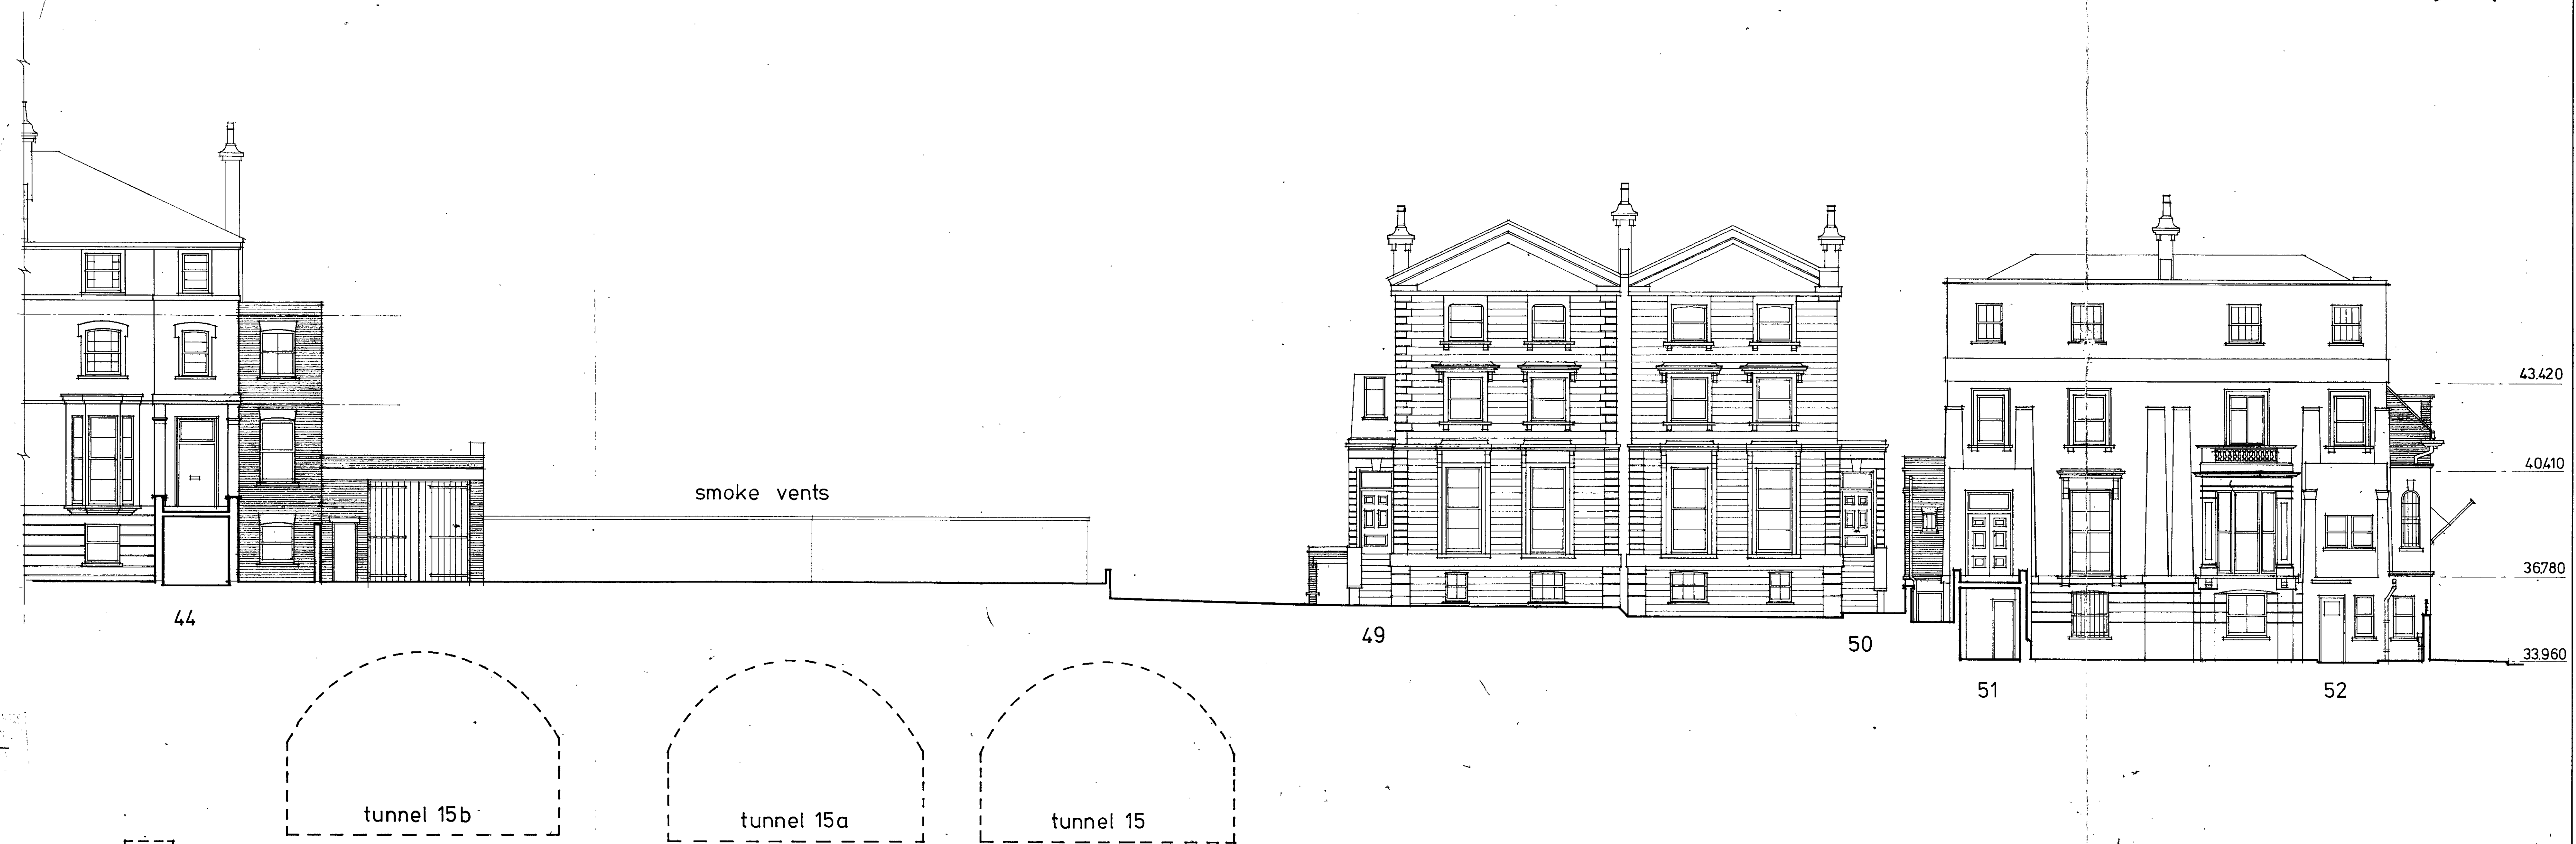

MATERIALS FOR NEW HOUSING.

ROOF - ASBESTOS CEMENT SLATES.

BECKWORK - YELLOW STOCK BROS IN STRETCHER BOND WITH MATCHING MORTAR, COPINGS AND DECORATIVE BANDING IN GERMAN ENGINEERING BECKS

WINDOW AND DOOR FRAMES - DARK STAINED TIMBER.

DOORS - PAINTED TIMBER.

- D 13 SEPTEMBER 1977 NEW DESIGN.
- C 19 JANUARY 1977 NEW HOUSING REVISED
- B 12 JANUARY 1977 NEW HOUSING GROUND FLOOR REVISED
- A 4 JANUARY 1977 NEW HOUSING REVISED

Amendments

THE IRISH CENTRE

As Existing & Proposed ELEVATION TO CAMDEN SQUARE

Scale 1 to 100 Date Sept. 1976

Job No. 174

Drawing No. 2-1

Keith Roberts and Associates
 Architects and Planning Consultants,
 21, Murray Mews,
 London, N.W.1.
 Telephone 01-463 9297


Job Architect: **DAH** Drawn: **DR**
 Checked: **DR** Traced: **DR**

LONDON CORPORATION OF CAMDEN TOWN AND DISTRICT PLANNING ACTS
 - 15/09/77
 PLANS APPROVED AND FORWARDED ON BEHALF OF THE COUNCIL
CASE COPY.

CTP/HIS/3/A/25356

CAMDEN SQUARE

25356

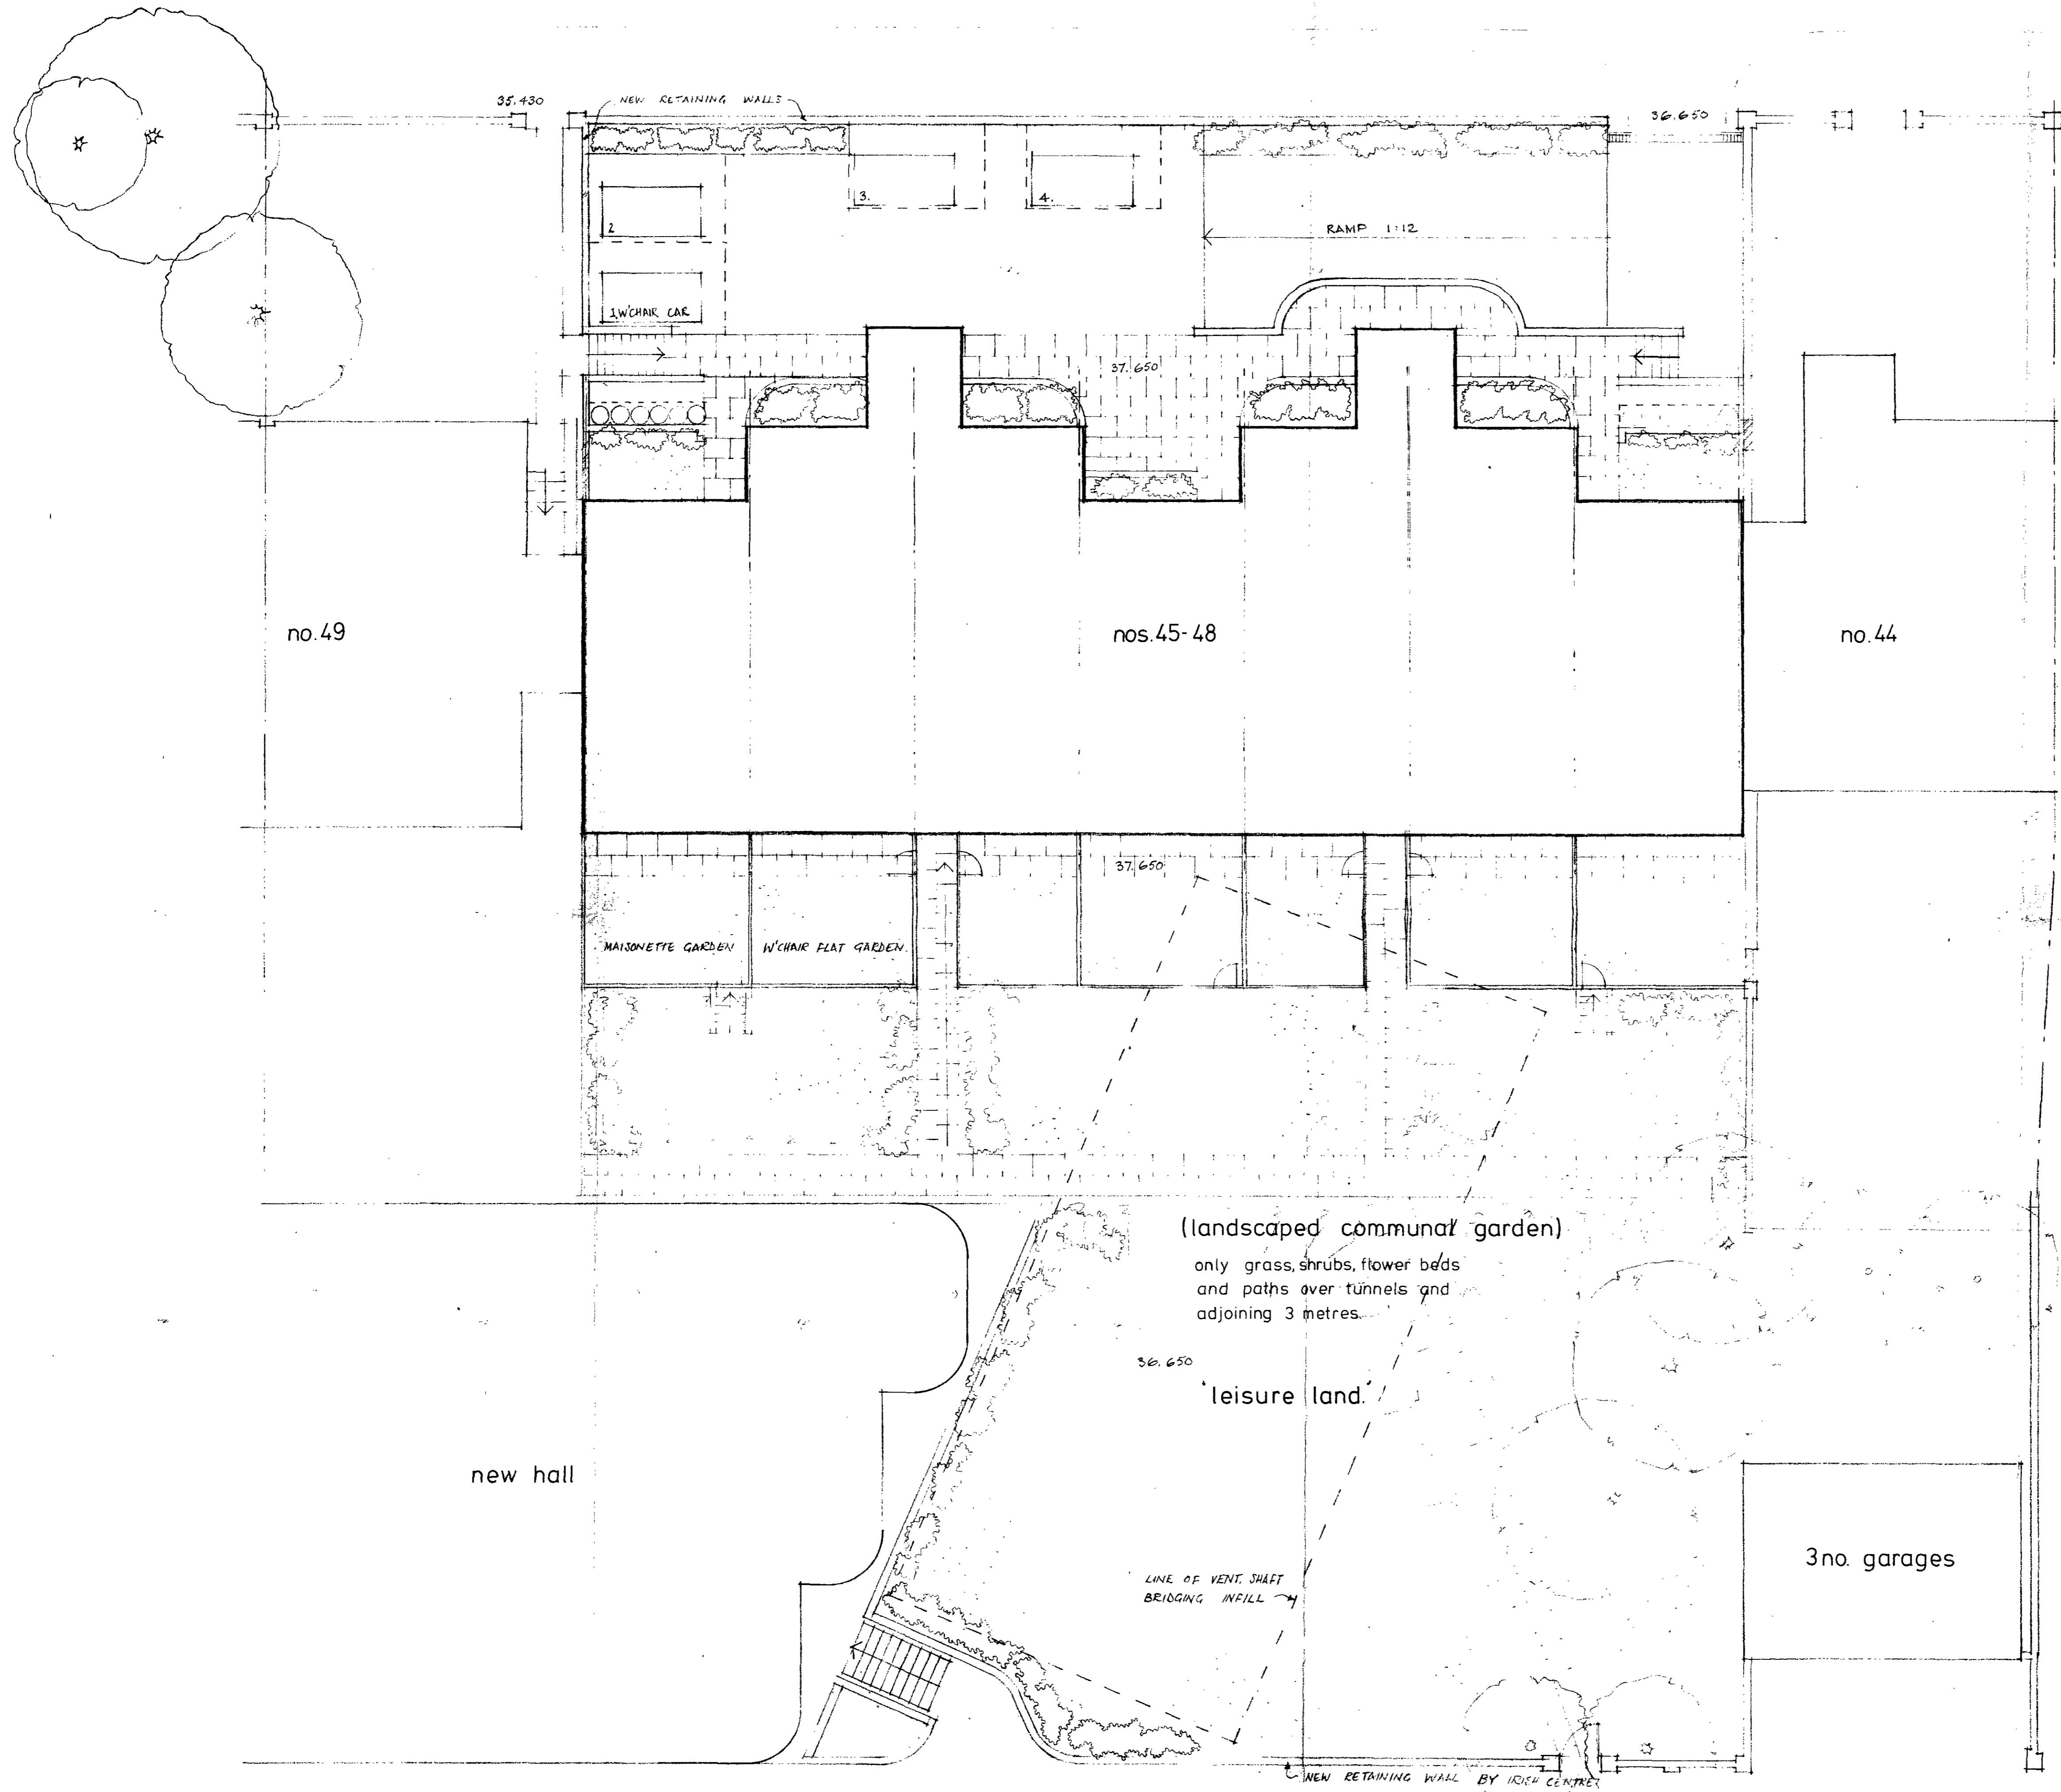

LONDON BOROUGH OF CAMDEN
TOWN AND COUNCIL PLANNING ACTS
- 1 DECEMBER
PLANS APPROVED
ON BEHALF OF THE COUNCIL

CASE COPY.

CTP/HB/3/A/25356

A. REAR GARDEN PATHS REVISED AND
IRISH CENTER LAND DESIGNATED AS 'LEISURE LAND'
SEPT. 1977

Keith Roberts and Associates, Architects.
31 Murray Mews London NW1 9RH Telephone 01-485 9292

Client CHA Scale 1:100 Drawing title external works
Date 30 AUG 77 Drawn DR.

Job title 45-48 Camden Sq. 204 P12-9

MURRAY MEWS