



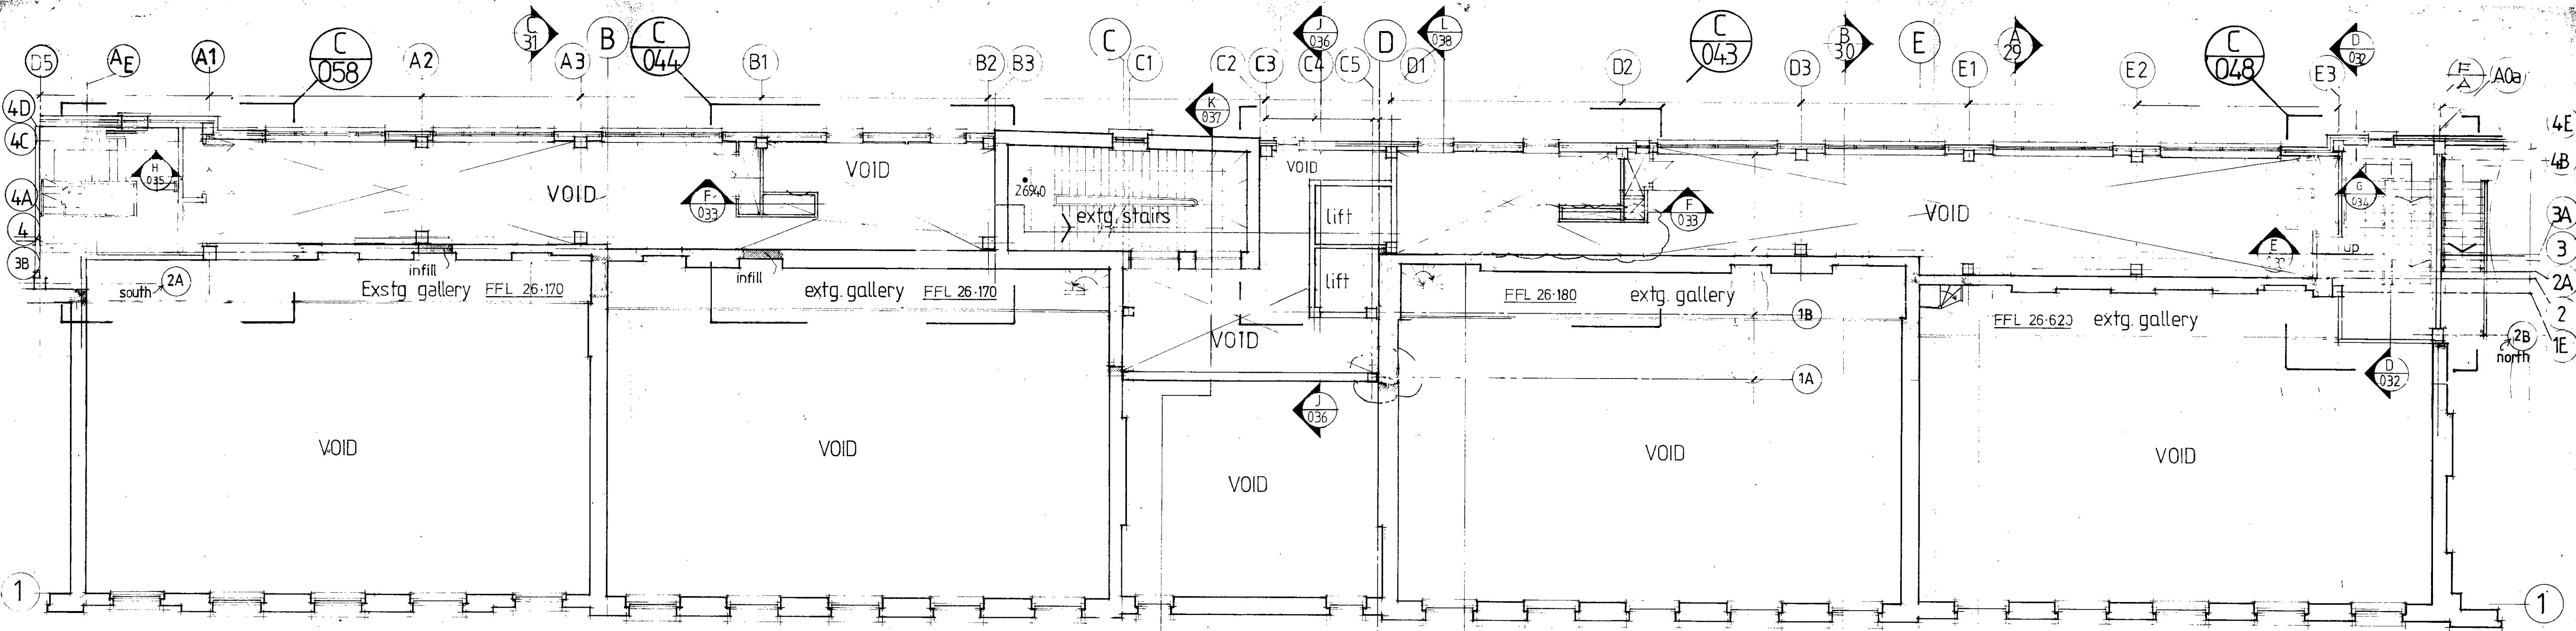

Ground Floor Mezzanine Plan

For Setting-Out Dimensions
Refer To Drg. No. C/53 C/54

GRIDLINES DO NOT
ALIGN BETWEEN BLOCKS

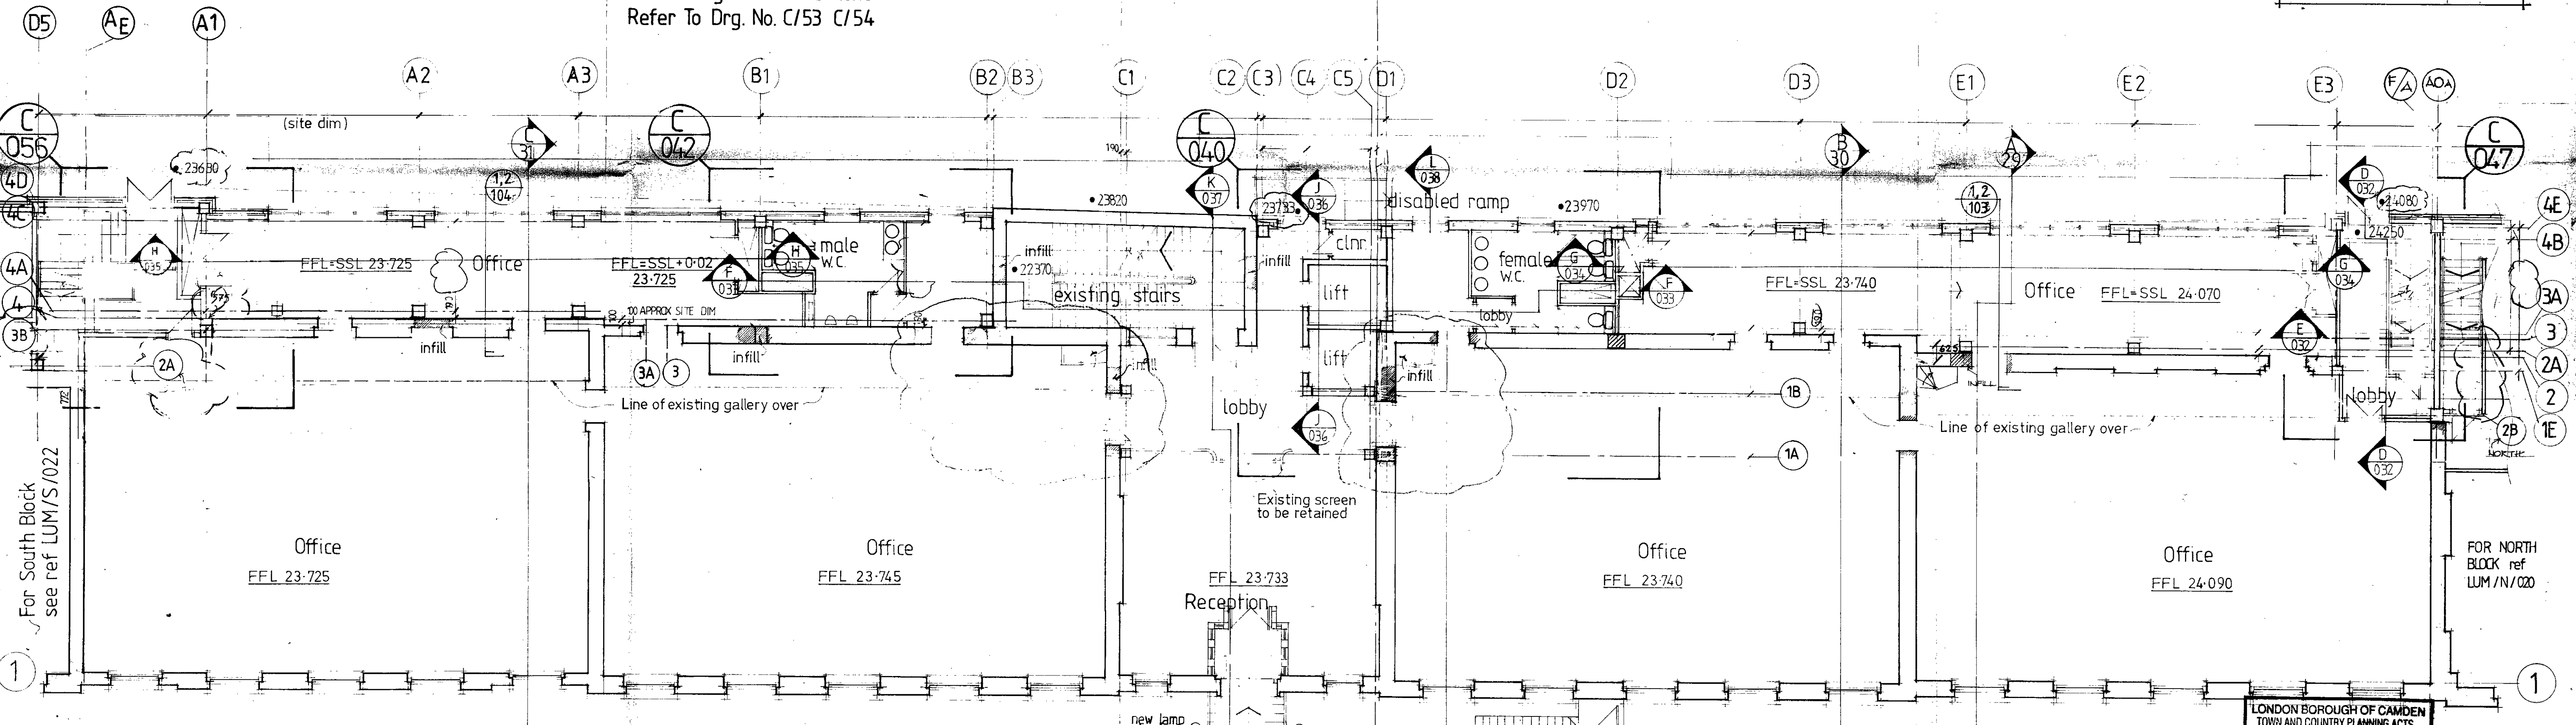

Ground Floor Plan

ALL DIMENSIONS TO
BE CHECKED ON SITE

DO NOT SCALE FROM
THIS DRAWING

ALL APPROX DIMS TO BE CHECKED BY STEEL SUBCONTRACTOR ON SITE

Eversholt Street

19.7.89 201 scheme amendments.
TENDER 230
240
11.7.89 GENERAL AMENDMENTS
24.4.89 GENERAL AMENDMENTS - OPES
DOORS, GRID LINES & DIMS.
RATIFIED.

D 1/2/89 General amendments
C 19.1.89 General Amendments
Rev Date: Comments

LONDON BOROUGH OF CAMDEN
TOWN AND COUNTRY PLANNING ACTS
06 NOV 1991
PLANS APPROVED
ON BEHALF OF THE
TP 89 03063
LONDON BOROUGH OF CAMDEN
PLANNING AND TRANSPORT
DEPARTMENT
25 SEP 1989
RECEIVED

Ground & Ground Mez. Floor Plans

APT Architects and Town Planners
Clarendon Works, Clarendon Cross
London W11 4AP
Telephone 01-727 9435

Date	Scale	Eversholt House Centre Block	Dwg no LUM/C/022
REV	1:100		

DO NOT SCALE FROM
THIS DRAWING

ALL DIMENSIONS TO
BE CHECKED ON SITE

ALL APPROX DIMS TO BE CHECKED
BY STEEL SUBCONTRACTOR ON SITE

FOR CORE SETTING OUT
REFER TO 1:20 CORE PLANS
AS INDICATED ON GA

FOR REAR WALL SETTING OUT
REF DRGS N/059 N/060

TP8903063

GRIDLINES DO NOT
ALIGN BETWEEN BLOCKS

LONDON BOROUGH OF CAMDEN
PLANNING AND TRANSPORT
DEPARTMENT
25 SEP 1989
RECEIVED

J	11.9.89	ISSUED TO 1/50 LIGHTWELL AREA
K	14.9.89	BOQ ISSUE 535
L	16.9.89	BOQ ISSUE 405
M		BOQ ISSUE 230
N		BOQ ISSUE 240
O		TENDER 230
P	23.6.89	GENERAL AMENDMENTS
Q	8.5.89	ATTENDMENTS TO CORE LG-FL
R	28.3.89	AMENDMENTS TO LIGHTWELL AREA
S	1.5.89	PAUSE AMENDMENTS
T	24.1.89	TABLE WINDOWS OMITTED SL ADDED TO SPIN RNS NEW LAMP / LIGHTING RELEASED IN CORE
U	11.1.89	GENERAL AMENDMENTS
REV	DATE	COMMENT

APT Architects and Town Planners
Clarendon Works, Clarendon Cross
London W11 4AP
Telephone 01-727 9435

Project
Eversholt House
Eversholt Street
London NW1
North Block
Drawing
Lower Ground & Ground Floor
General Arrangement

Scale
1:100
Date
Jan 1989
Drawn
Checked

Drawing number
LUM/N/020
Revision
01/02/03/2461/2462

ALL APPROX DIMS TO BE CHECKED
BY STEEL SUBCONTRACTOR ON SITE

DO NOT SCALE FROM
THIS DRAWING

ALL DIMENSIONS TO
BE CHECKED ON SITE

FOR CORE SETTING OUT
REFER TO 1:20 CORE PLANS
AS INDICATED ON GA

FOR REAR WALL SETTING OUT,
REF DRGS S/051 + S/052

GRIDLINES DO NOT
ALIGN BETWEEN BLOCKS

EXTERNAL LEVELS AT
REAR IN ABEYANCE

Ground Floor Mezzanine Plan.

Ground Floor Plan.

LONDON BOROUGH OF CAMDEN
TOWN AND COUNTRY PLANNING ACTS
06 NOV 1991
PLANS APPROVED
ON BEHALF OF THE COUNCIL

APT Architects and Town Planners
Clarendon Works, Clarendon Cross
London W11 4AP
Telephone 01-727 9435

Project
Eversholt House
Eversholt Street
London NW1
South Block
Drawing
Ground & Ground Mezzanine Flrs.
General Arrangement

Scale 1:100
Date
Drawn
Checked

Drawing number
LUM/S/022
Revision


RECEIVED
25 SEP 1991
PLANNING AND TRANSPORT
DEPARTMENT
LONDON BOROUGH OF CAMDEN

TP 8903063

E V E R S H O L T S T R E E T

ALL DIMENSIONS TO
BE CHECKED ON SITE

DO NOT SCALE FROM
THIS DRAWING

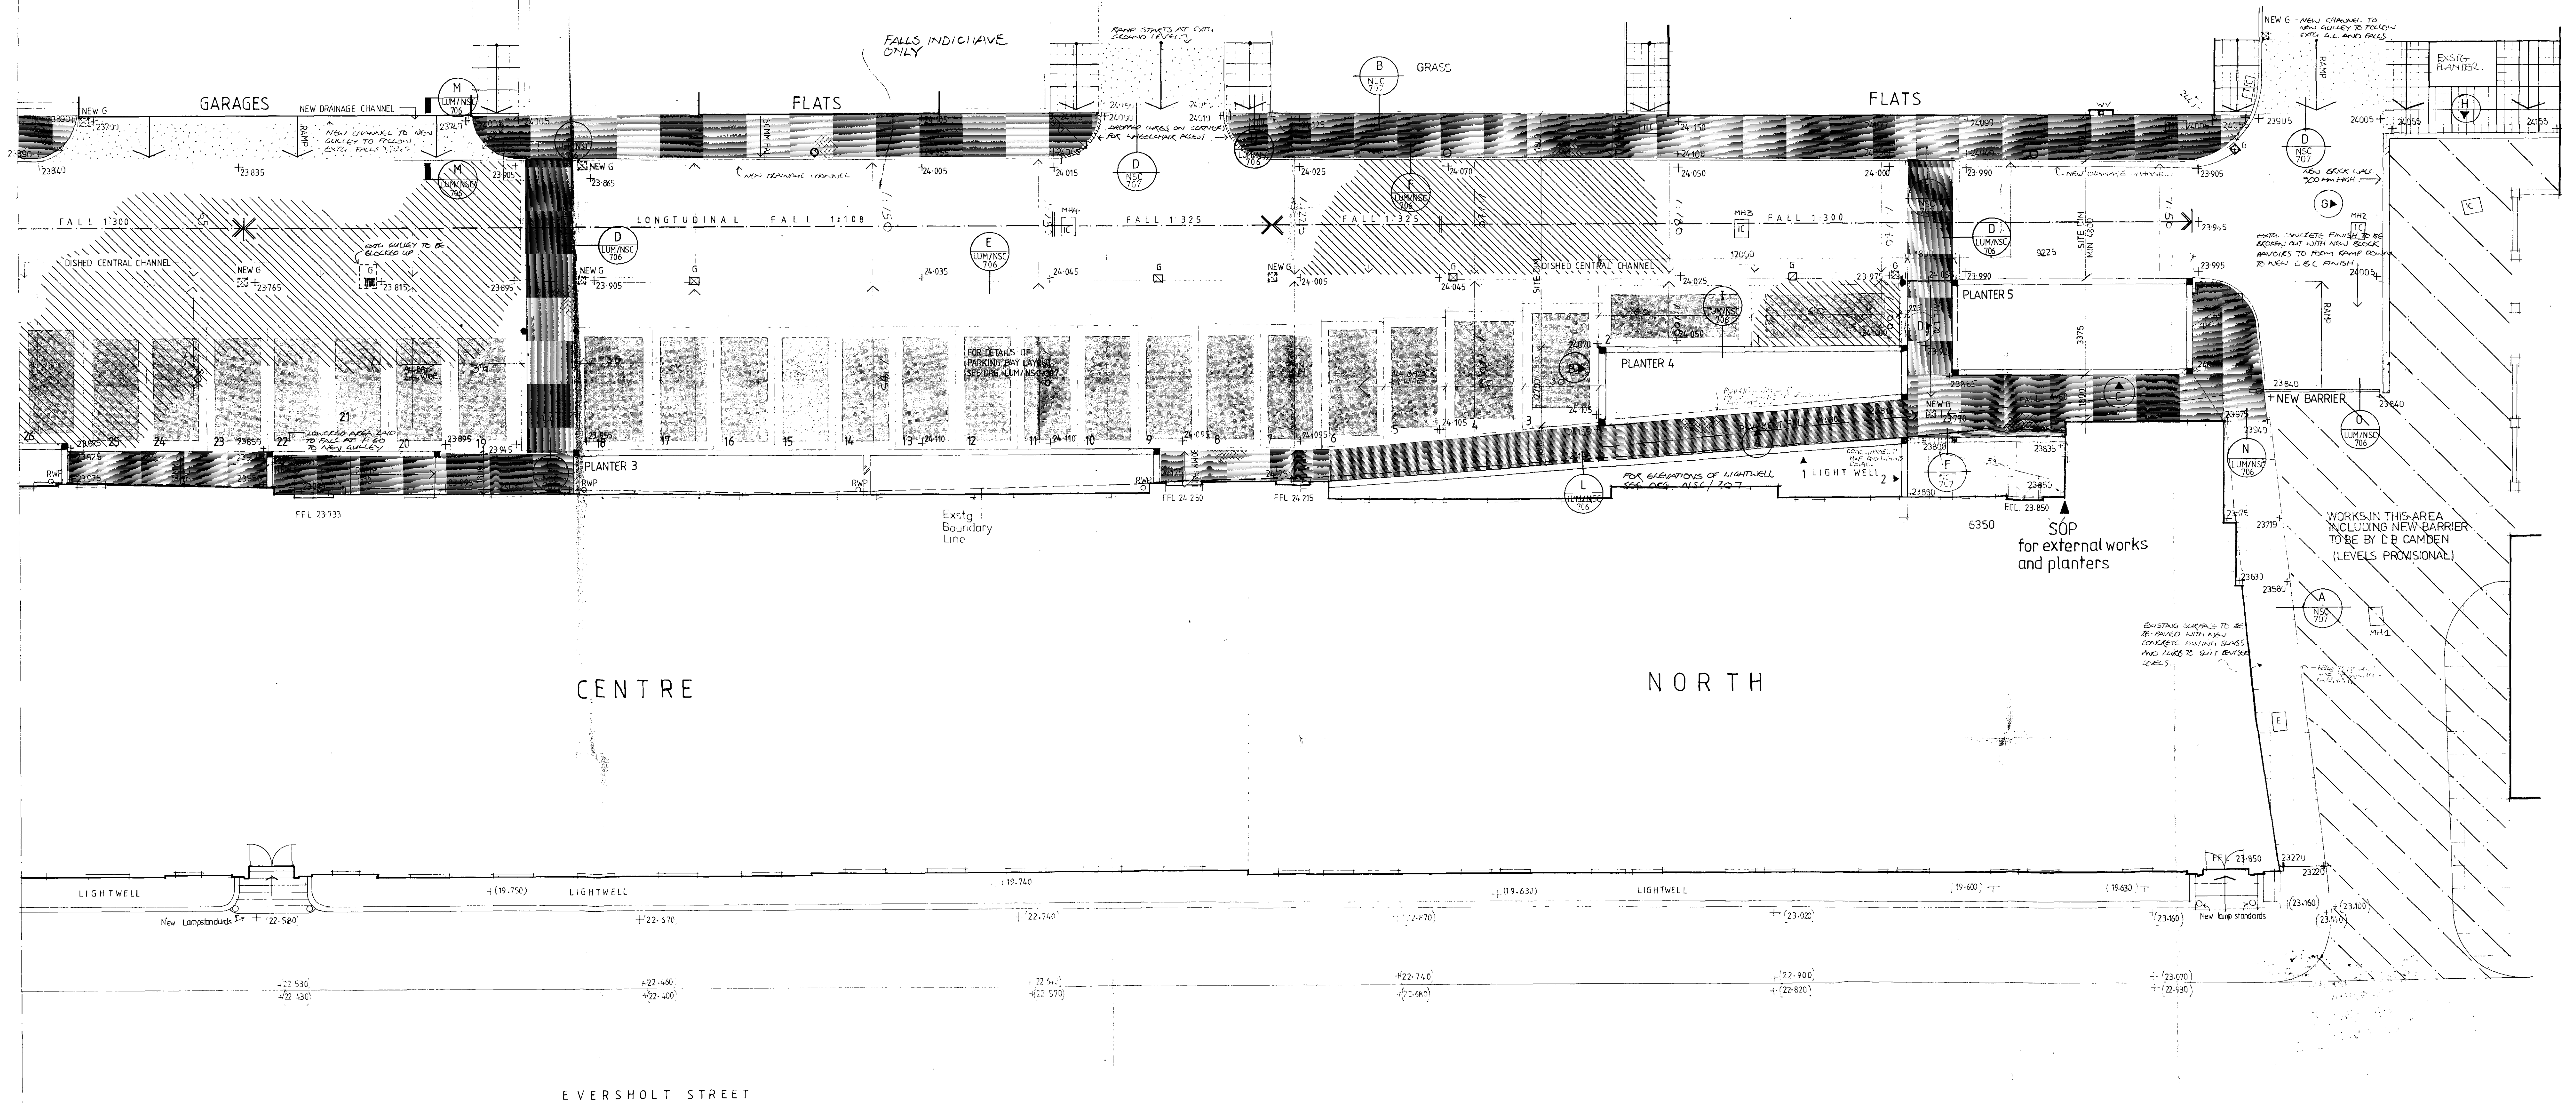

LEGEND

- | | |
|---|-----------------------------------|
| CONCRETE BLOCK PAVIORS
TYPE 1 Basketweave pattern | NEW GULLIES |
| CONCRETE BLOCK PAVIORS
TYPE 2 Basketweave pattern | EXISTING GULLIES |
| CONCRETE BLOCK PAVIORS
TYPE 3 Herringbone pattern | DROPPED PC CONC KERB |
| MASS CONCRETE BUILD UP
As per drawing to adjust existing levels
Break out for groundworks not shown | STANDARD PC CONC KERB /
EDGING |
| BRUSH FINISHED CONCRETE
RAMPS | DOUBLE PC CONC KERB HUMPS |
| HORNBL TEXTURED PC PAVING
SLABS | SITE BOUNDARY |
| PLAIN PC PAVING SLABS | EXISTING LEVELS |
| | TELECOM INSPECTION CHAMBER |
| | IN-SECTION CHAMBER |
| | E.B.S. |
| | WATER VALVE |
| | BOLLARD |
| | BRICK SPECIAL (FWS NSC 707) |
| | LAMP STANDARD |

LONDON BOROUGH OF CAMDEN
TOWN AND COUNTRY PLANNING ACTS
06 NOV 1991
PLANS APPROVED
ON BEHALF OF THE COUNCIL

NEW A 1:1000 LAMP STANDARD USED

APT
As built & used (over 10 years)
Camden Council, Planning & Design
London NW1 4AB
Telephone 01 277 9435

Project:
Eversholt House
Eversholt Street
London NW1

FOR DETAILS OF PLANTERS
SEE ORG. LUM/NSC/707

TP 8903063

RECEIVED
25 SEP 1989
LONDON BOROUGH OF CAMDEN
TOWN AND COUNTRY PLANNING ACTS

External Works Plan
REAR CAR PARK 2 of 2
Scale: 1:100
Date: AUG 89
Drawn: []
Checked: []

Drawing number:
LUM/NSC/709

Revision:
[]