


ARGYLE HOUSE

IP90 00286R3




ROOF PLAN

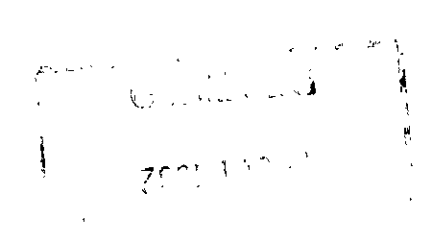

Architecture & Design
London Bristol Frankfurt
90 98 Goswell Road
London EC1V 7DB
Telephone 071 490 8899
Facsimile 071 490 5845

23-31 EUSTON ROAD
JOB NO. 27144
DRWG NO. R-01
JULY '92
JD
1:100

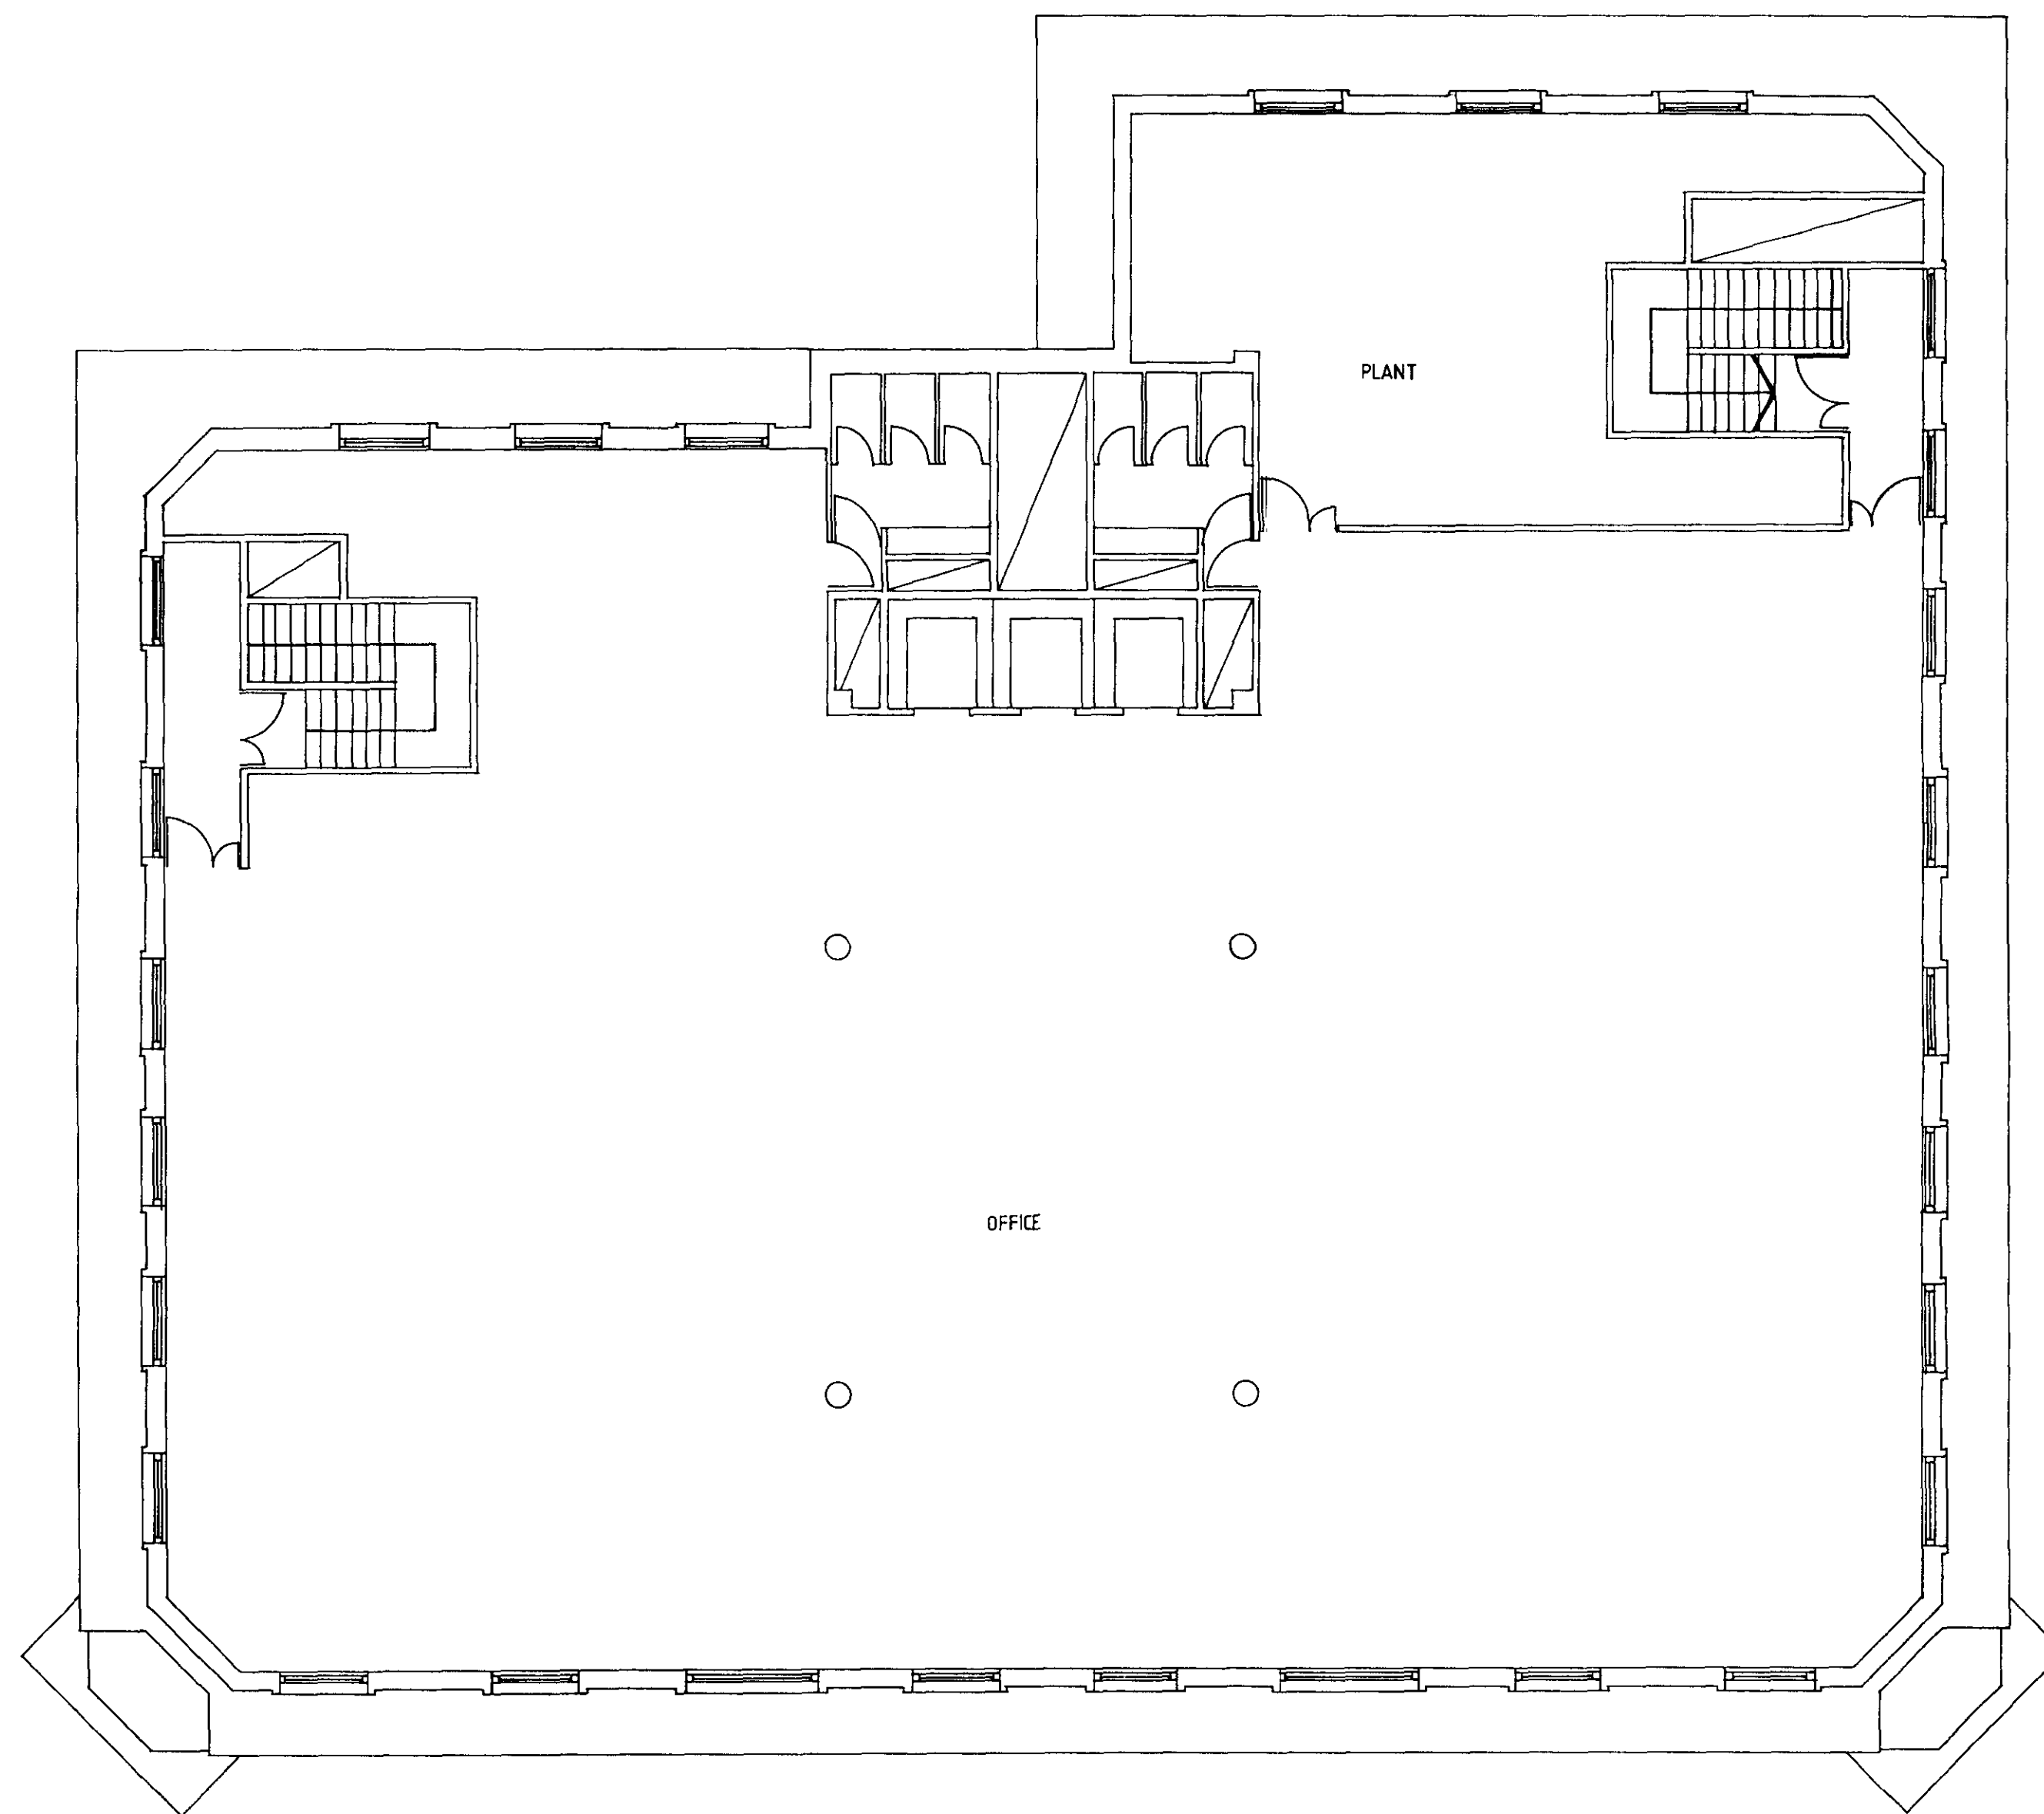

TP900023CR3


ARGYLE HOUSE

FIFTH FLOOR PLAN



Architecture & Design
London Bristol Frankfurt
90 B6 Goswell Road
London EC1V 7JG
Telephone 071 490 8999
Facsimile 071 490 5845

23-31 EUSTON ROAD
JOB NO. 27144
DRWG NO. F5-01
JULY '92
JD
1/100

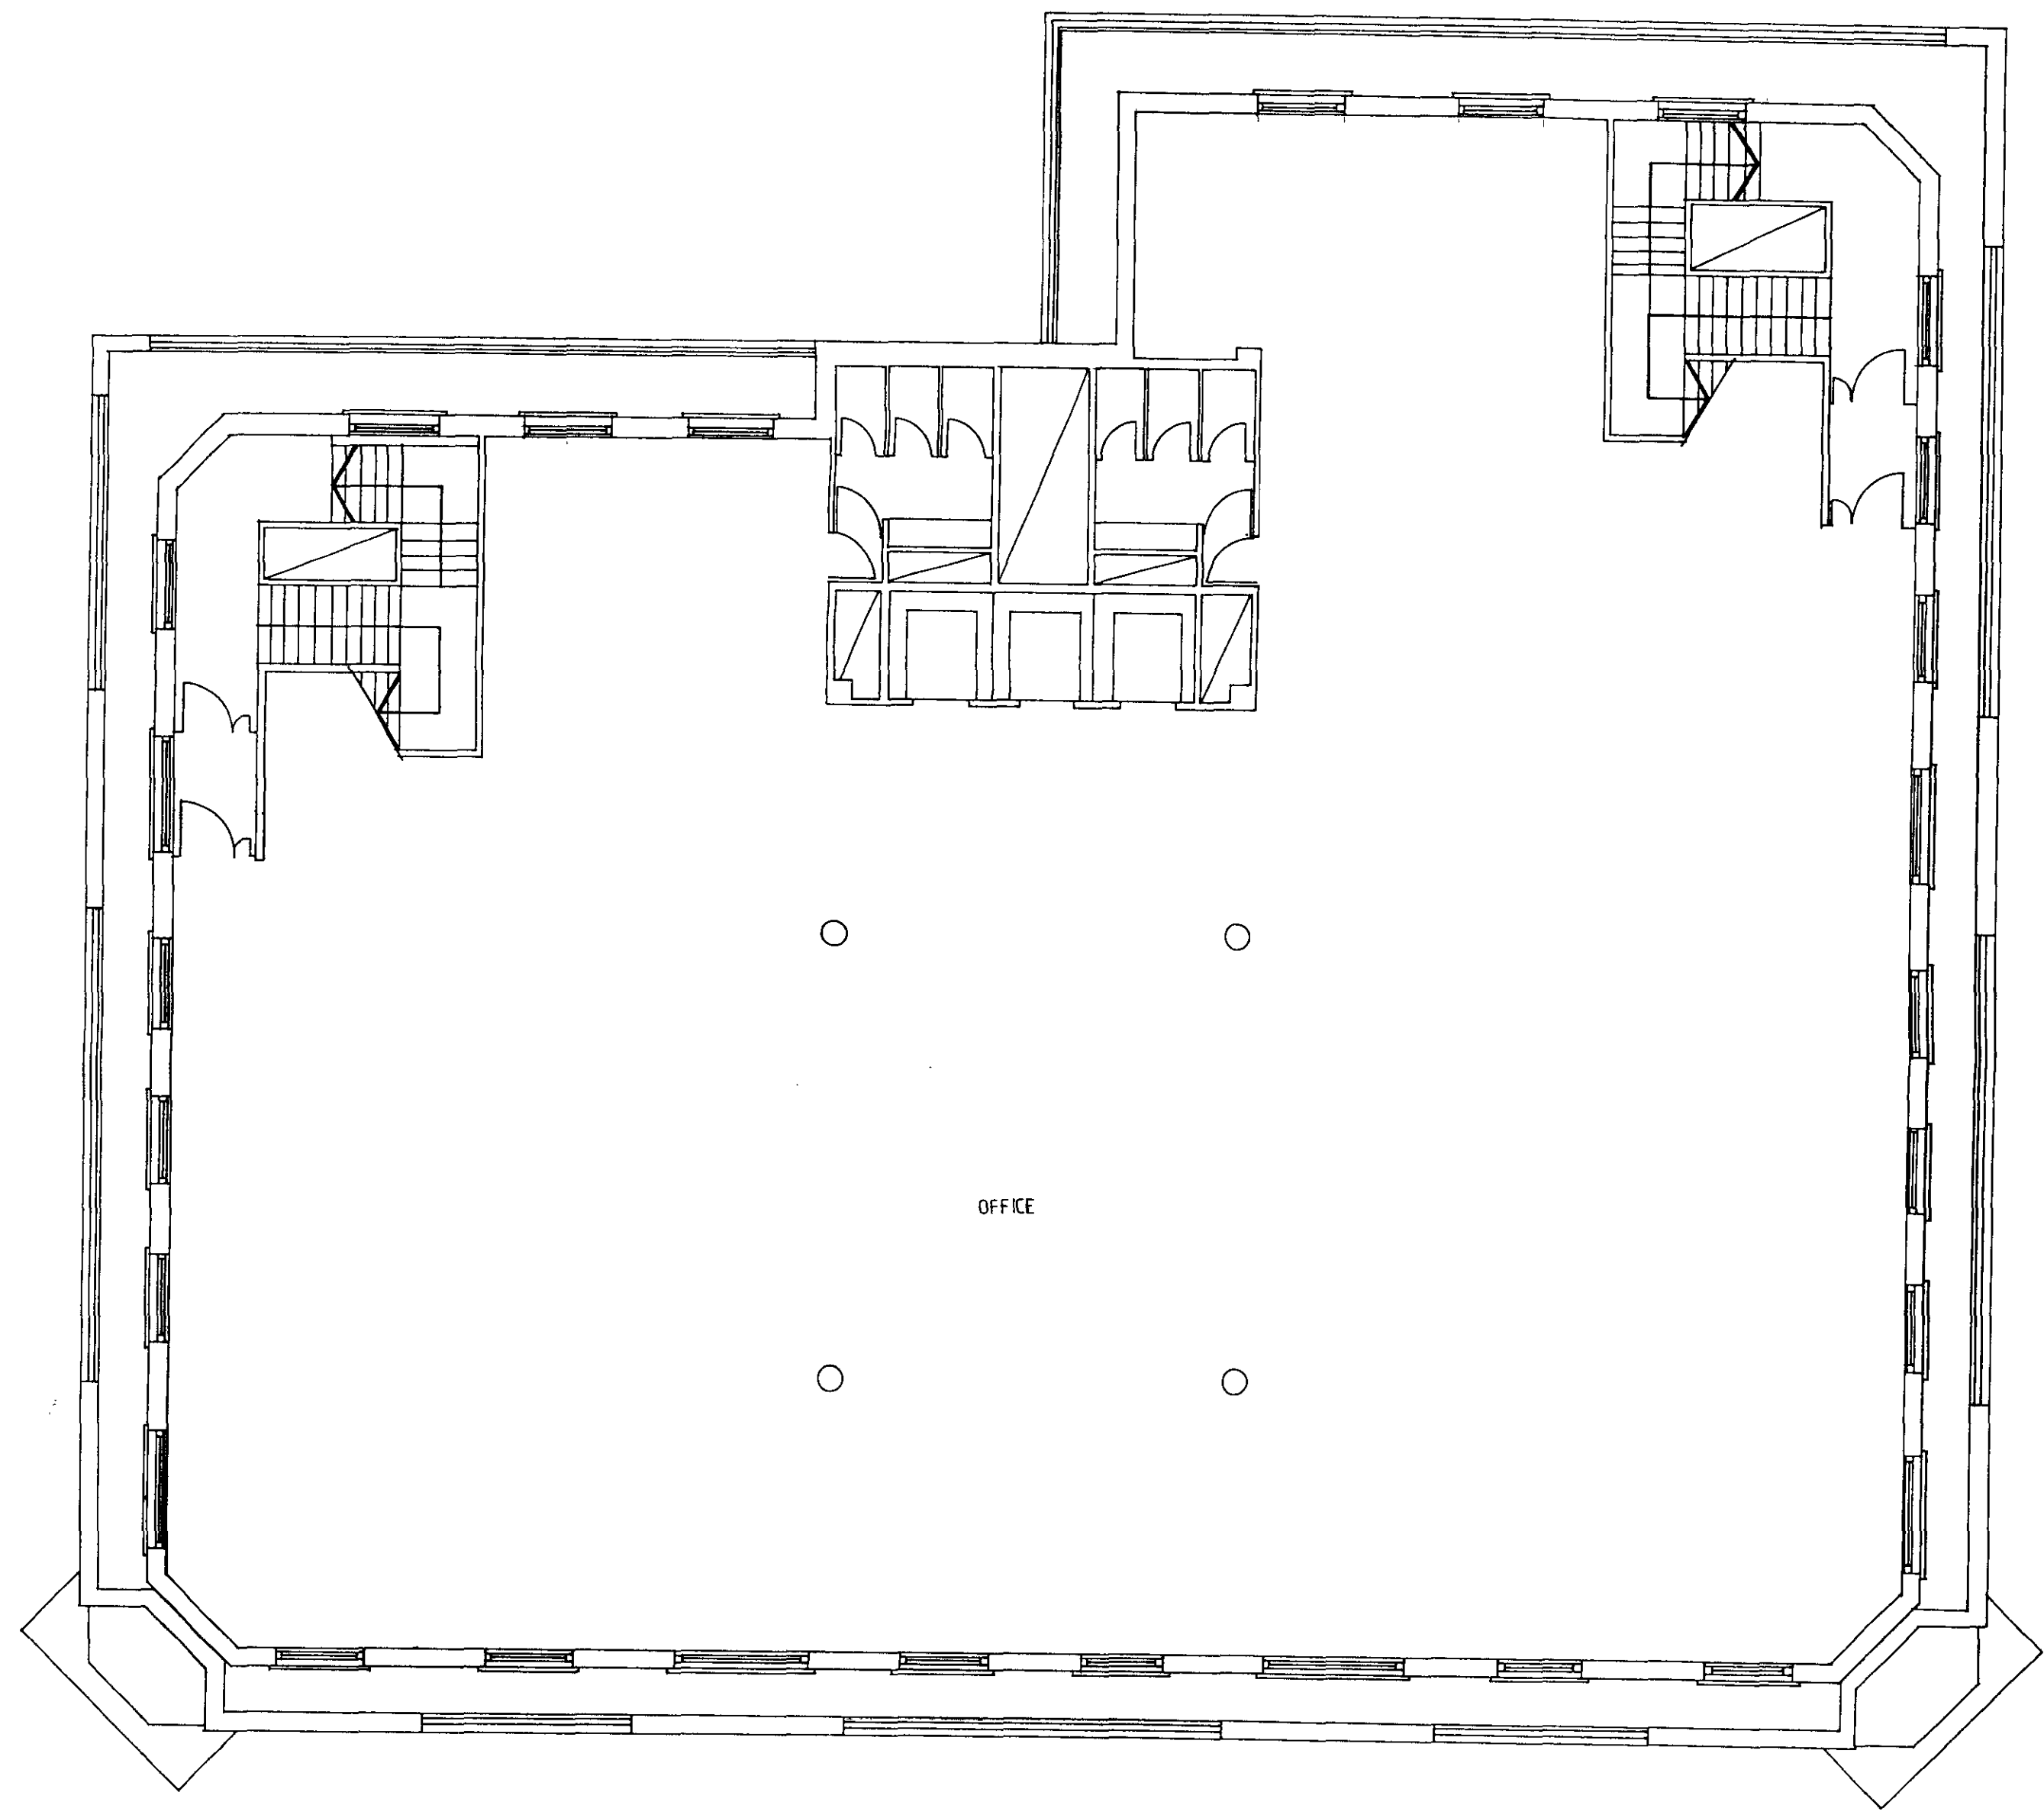

IP90 00280R3


ARGYLE HOUSE

FOURTH FLOOR PLAN



Architecture & Design
London Bristol Frankfurt
90-98 Goswell Road
London EC1V 7JH
Telephone 071 490 8899
Facsimile 071 490 5845

23-31 EUSTON ROAD
JOB NO. 27144
DRWG. NO. F4-01
JULY '92
JD
1:100

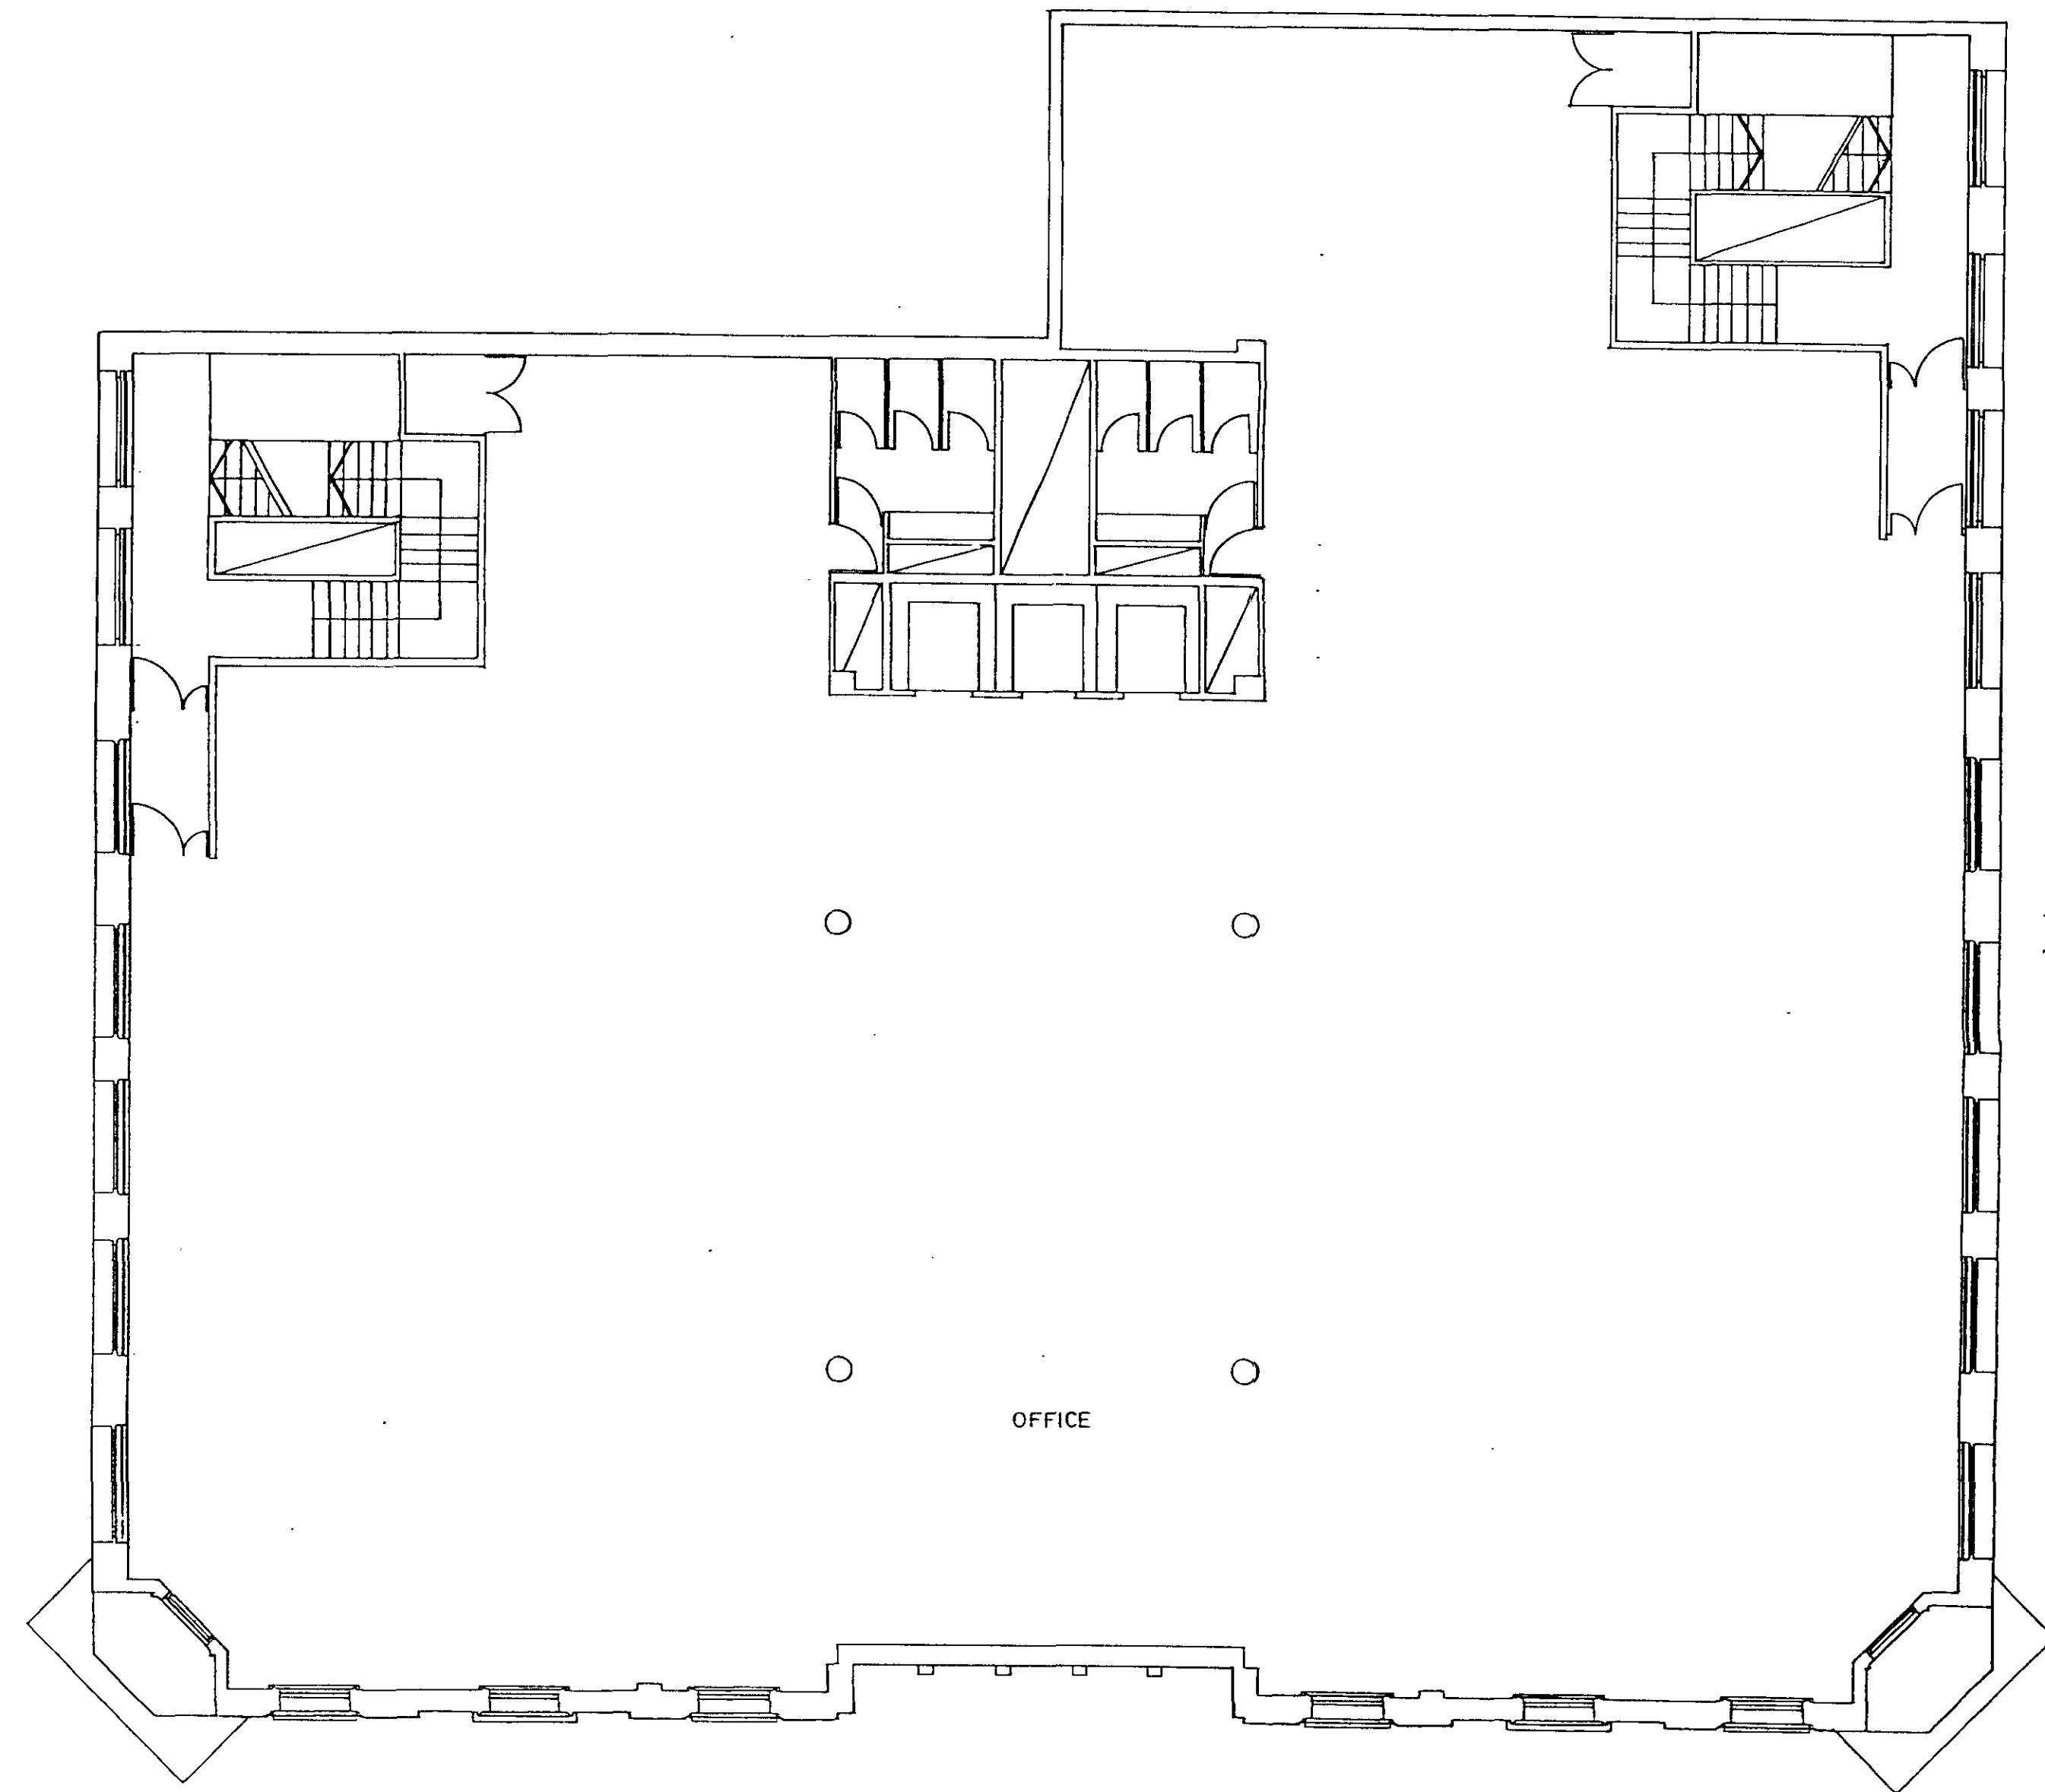

TP9000286R3


ARGYLE HOUSE

THIRD FLOOR PLAN



Architecture & Design
London E16 6JH
50 Se Gorse Road
London EC4W 7DB
Telephone 071 490 6899
Facsimile 071 490 3645

23-31 EUSTON ROAD
JOB NO. 27144
DRWG NO. F3-01
REVISED JULY '92
KOS
1/100

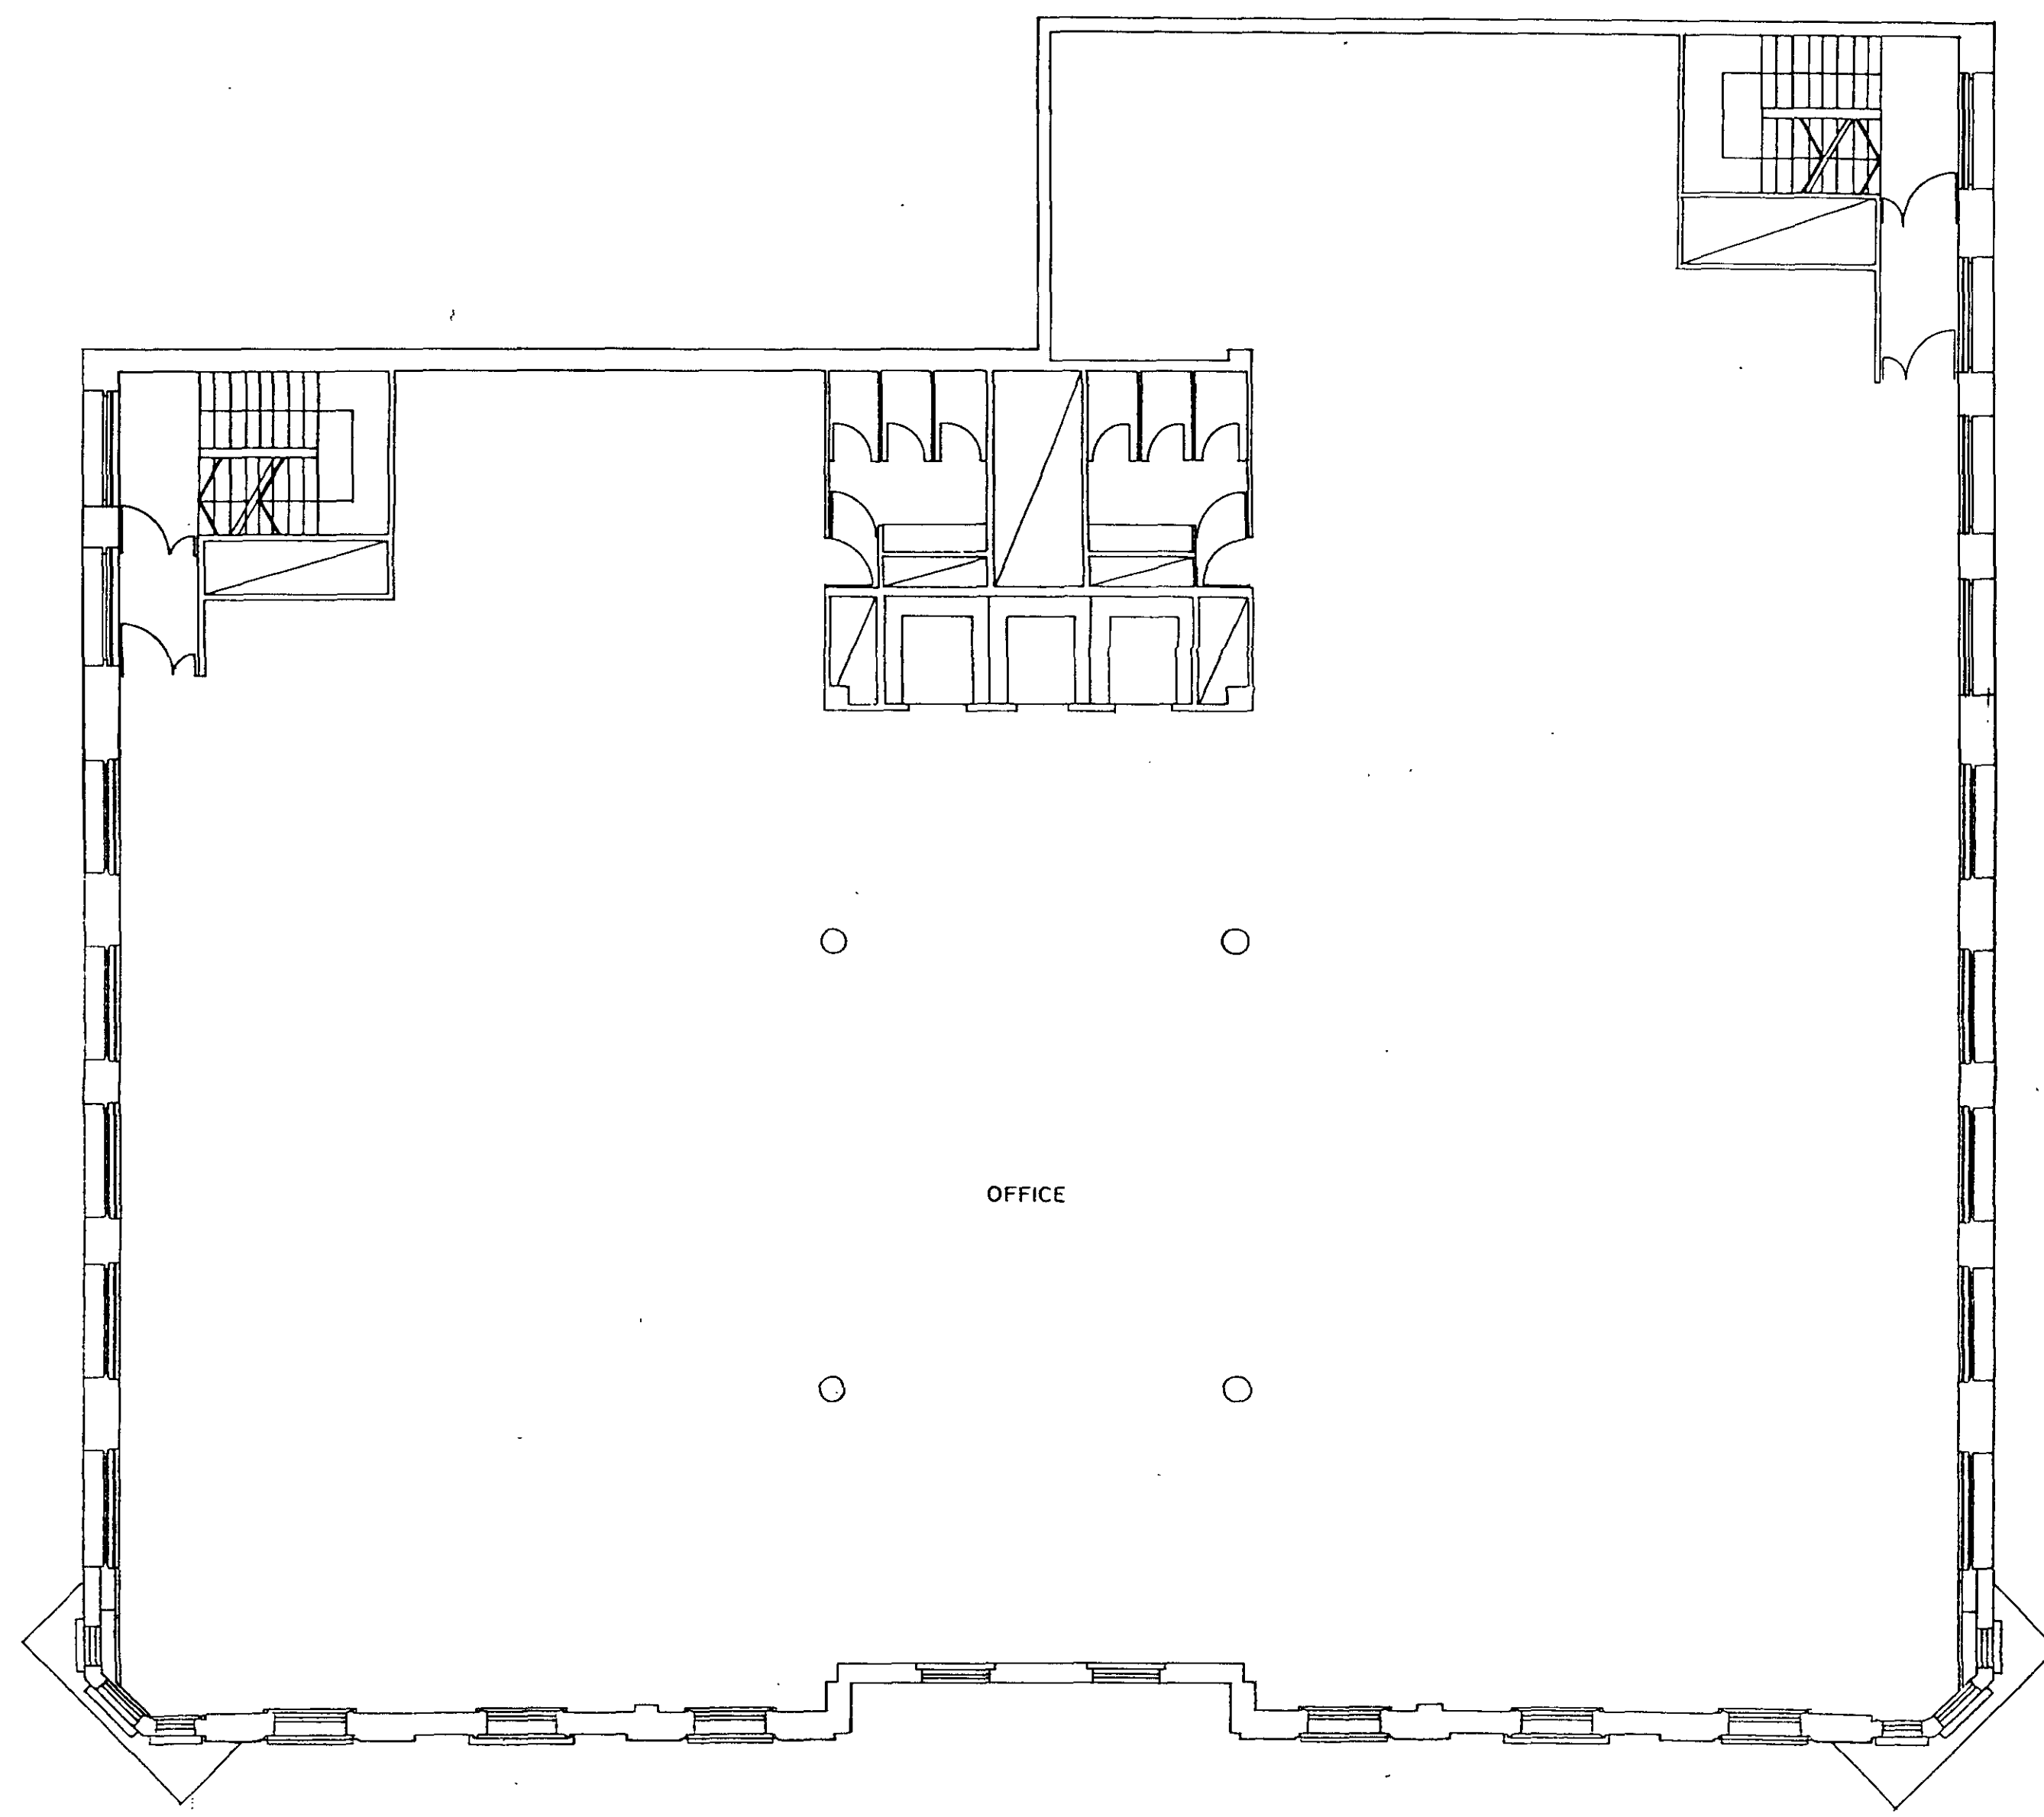

TP90 00200R3


ARGYLE HOUSE

SECOND FLOOR PLAN



Architecture & Design
London Bristol Frankfurt
90-98 Goswell Road
London EC1V 7DB
Telephone 071 490 8899
Facsimile 071 490 8845

23-31 EUSTON ROAD
JOB NO. 27122
DRWG NO. F2-01
REVISED JULY '92
KDS
1:100

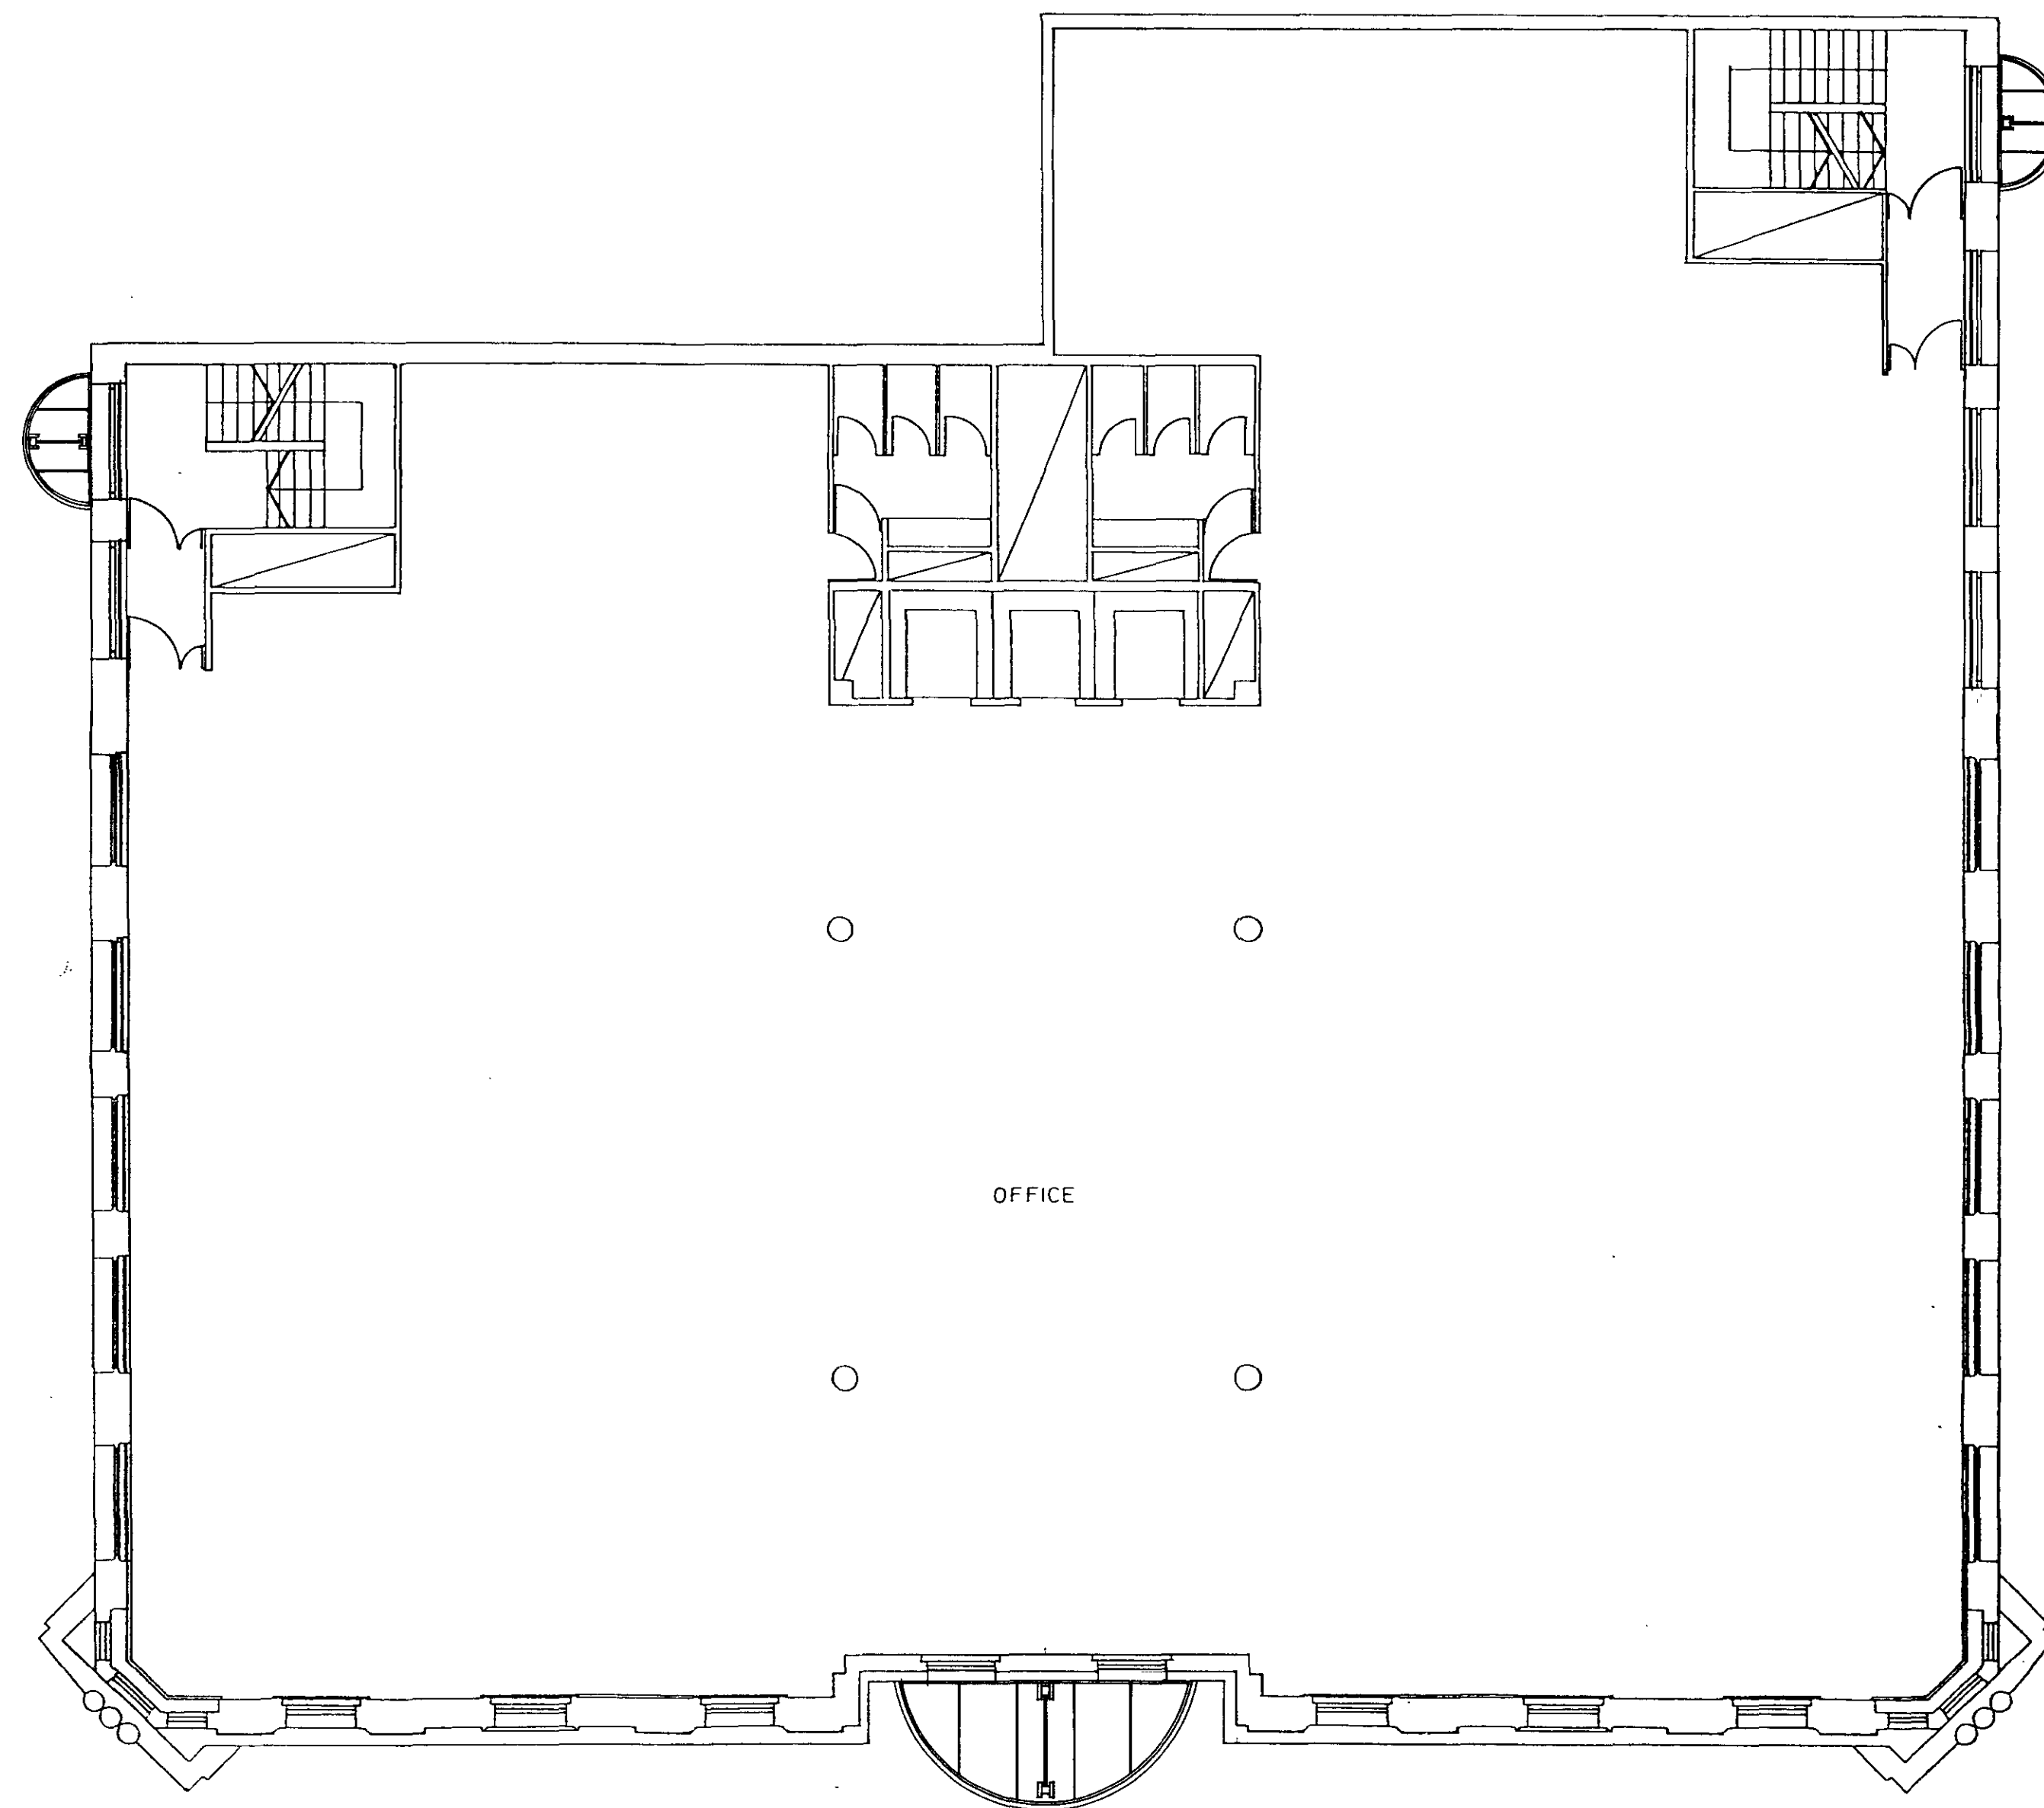

TP9000206R3


ARGYLE HOUSE

FIRST FLOOR PLAN



Architecture & Design
London Bristol Frankfurt
90 98 Goswell Road
London EC1V 7DB
Telephone 071 490 8899
Facsimile 071 490 5845

23-31 EUSTON ROAD
JOB NO 27144
DRWG NO F1-01
REVISED JULY '92
KDS
1/100

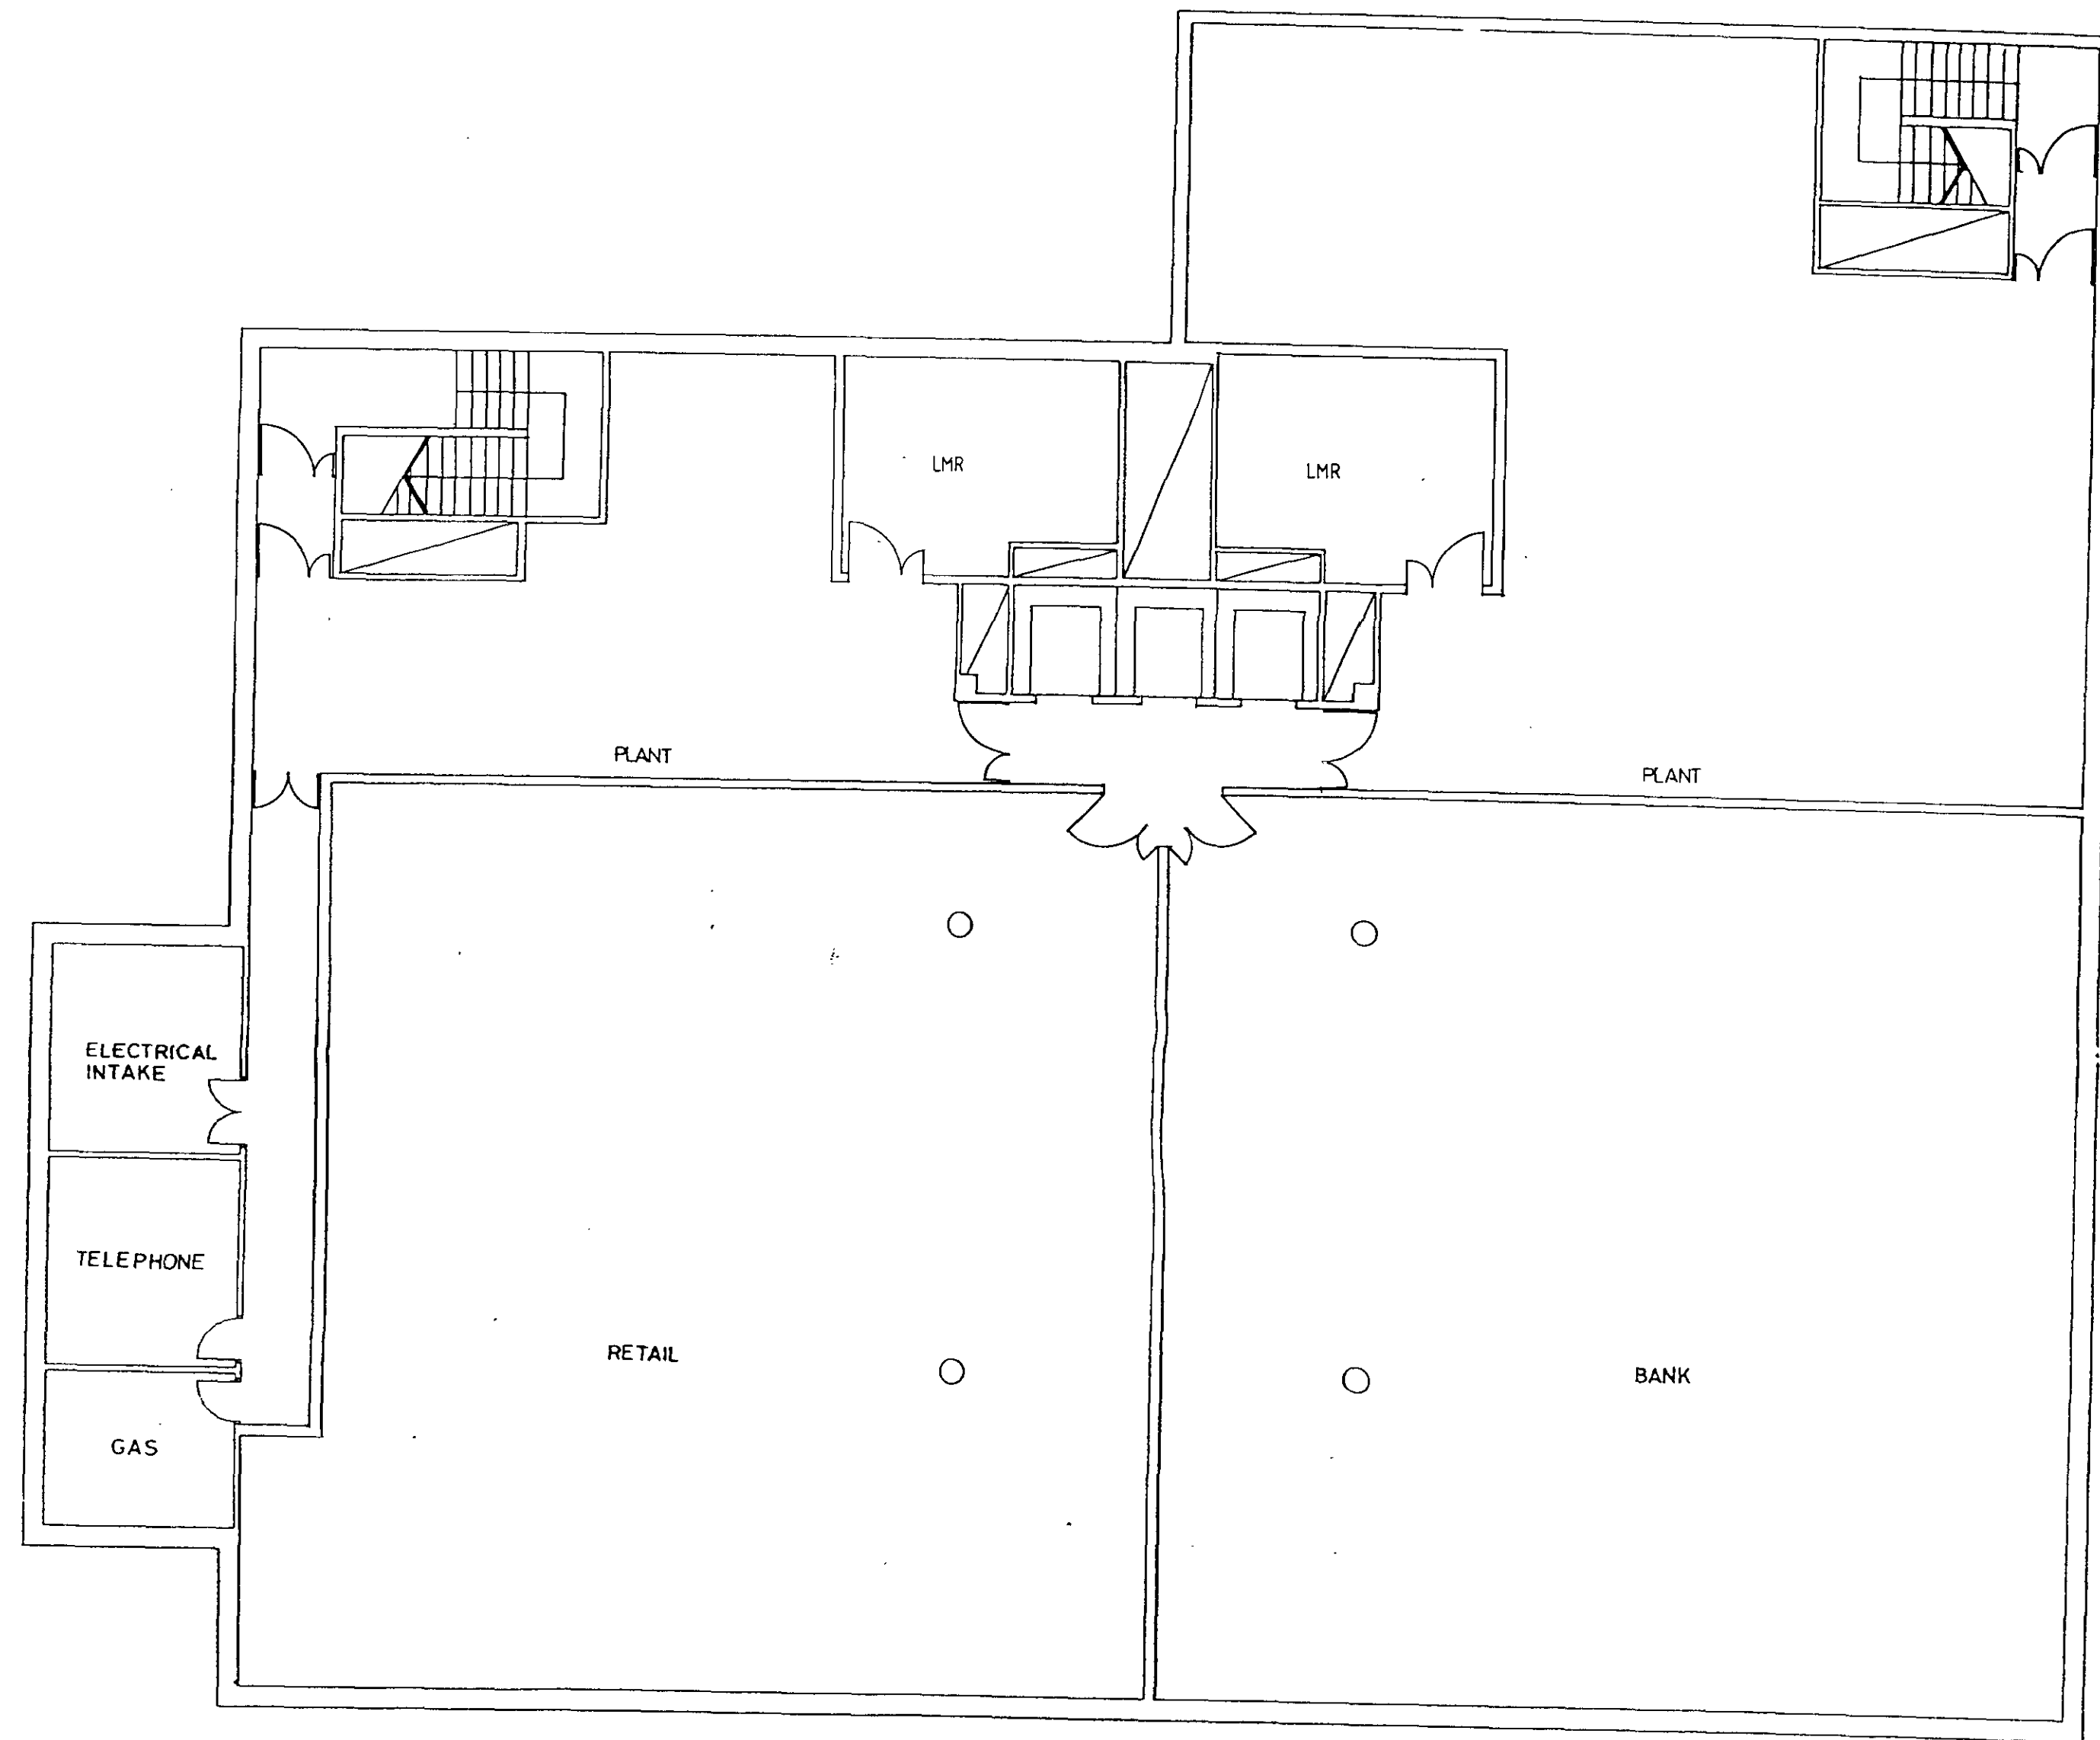

ARGYLE HOUSE


TP9000286 R3

LOWER GROUND FLOOR PLAN



Architecture & Design
London Group Practice
90-98 Goswell Road
London EC1V 7JH
Telephone 071 490 8899
Facsimile 071 490 5845

23-31 BUSTON ROAD
JOB N° 27144
DRWG NO. FLG-01
REVISED JULY '92
KDS
1/100

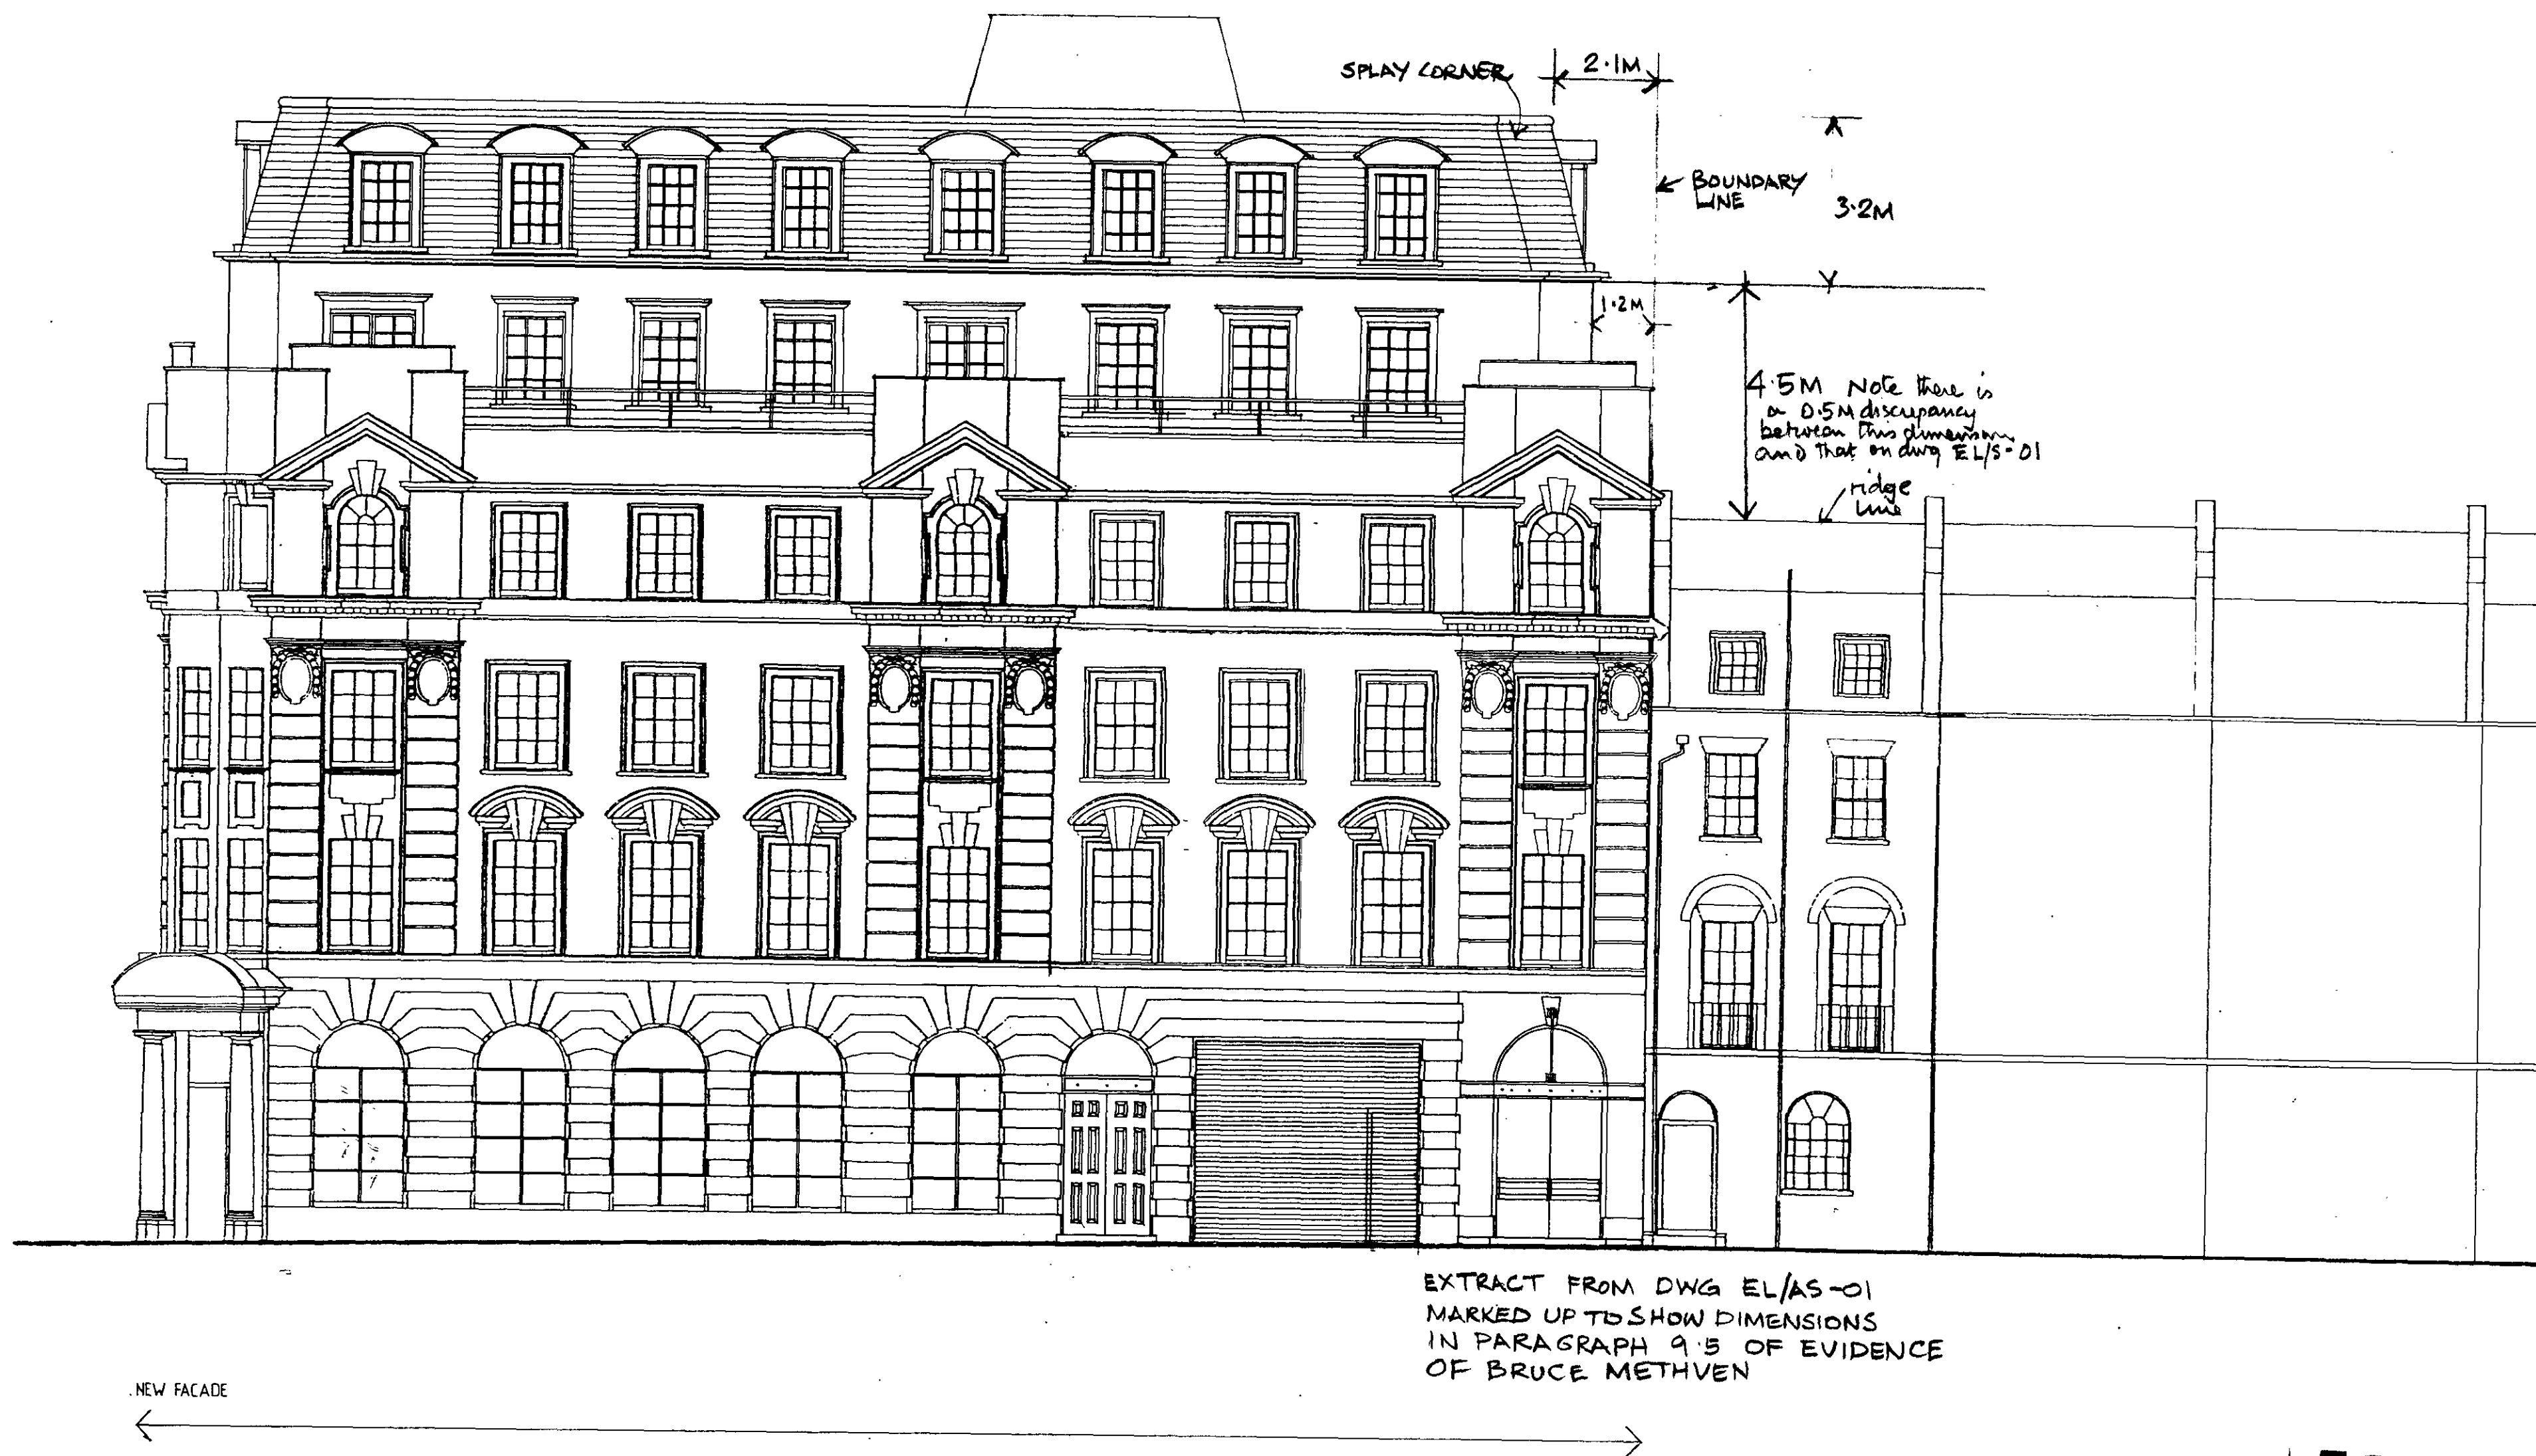

TP9000286R3

ARGYLE HOUSE


ARGYLE STREET ELEVATION *marked up with dims 17/5/92*

ttsp

Architecture & Design
London Bristol Frankfurt

90 98 Goswell Road
London EC1V 7DB
Telephone 071 490 8899
Facsimile 071 490 5845

23-31 EUSTON ROAD
JOB NO. 271 LL
DWG NO. EL/AS-01
REVISED JULY 92
KDS
1/100

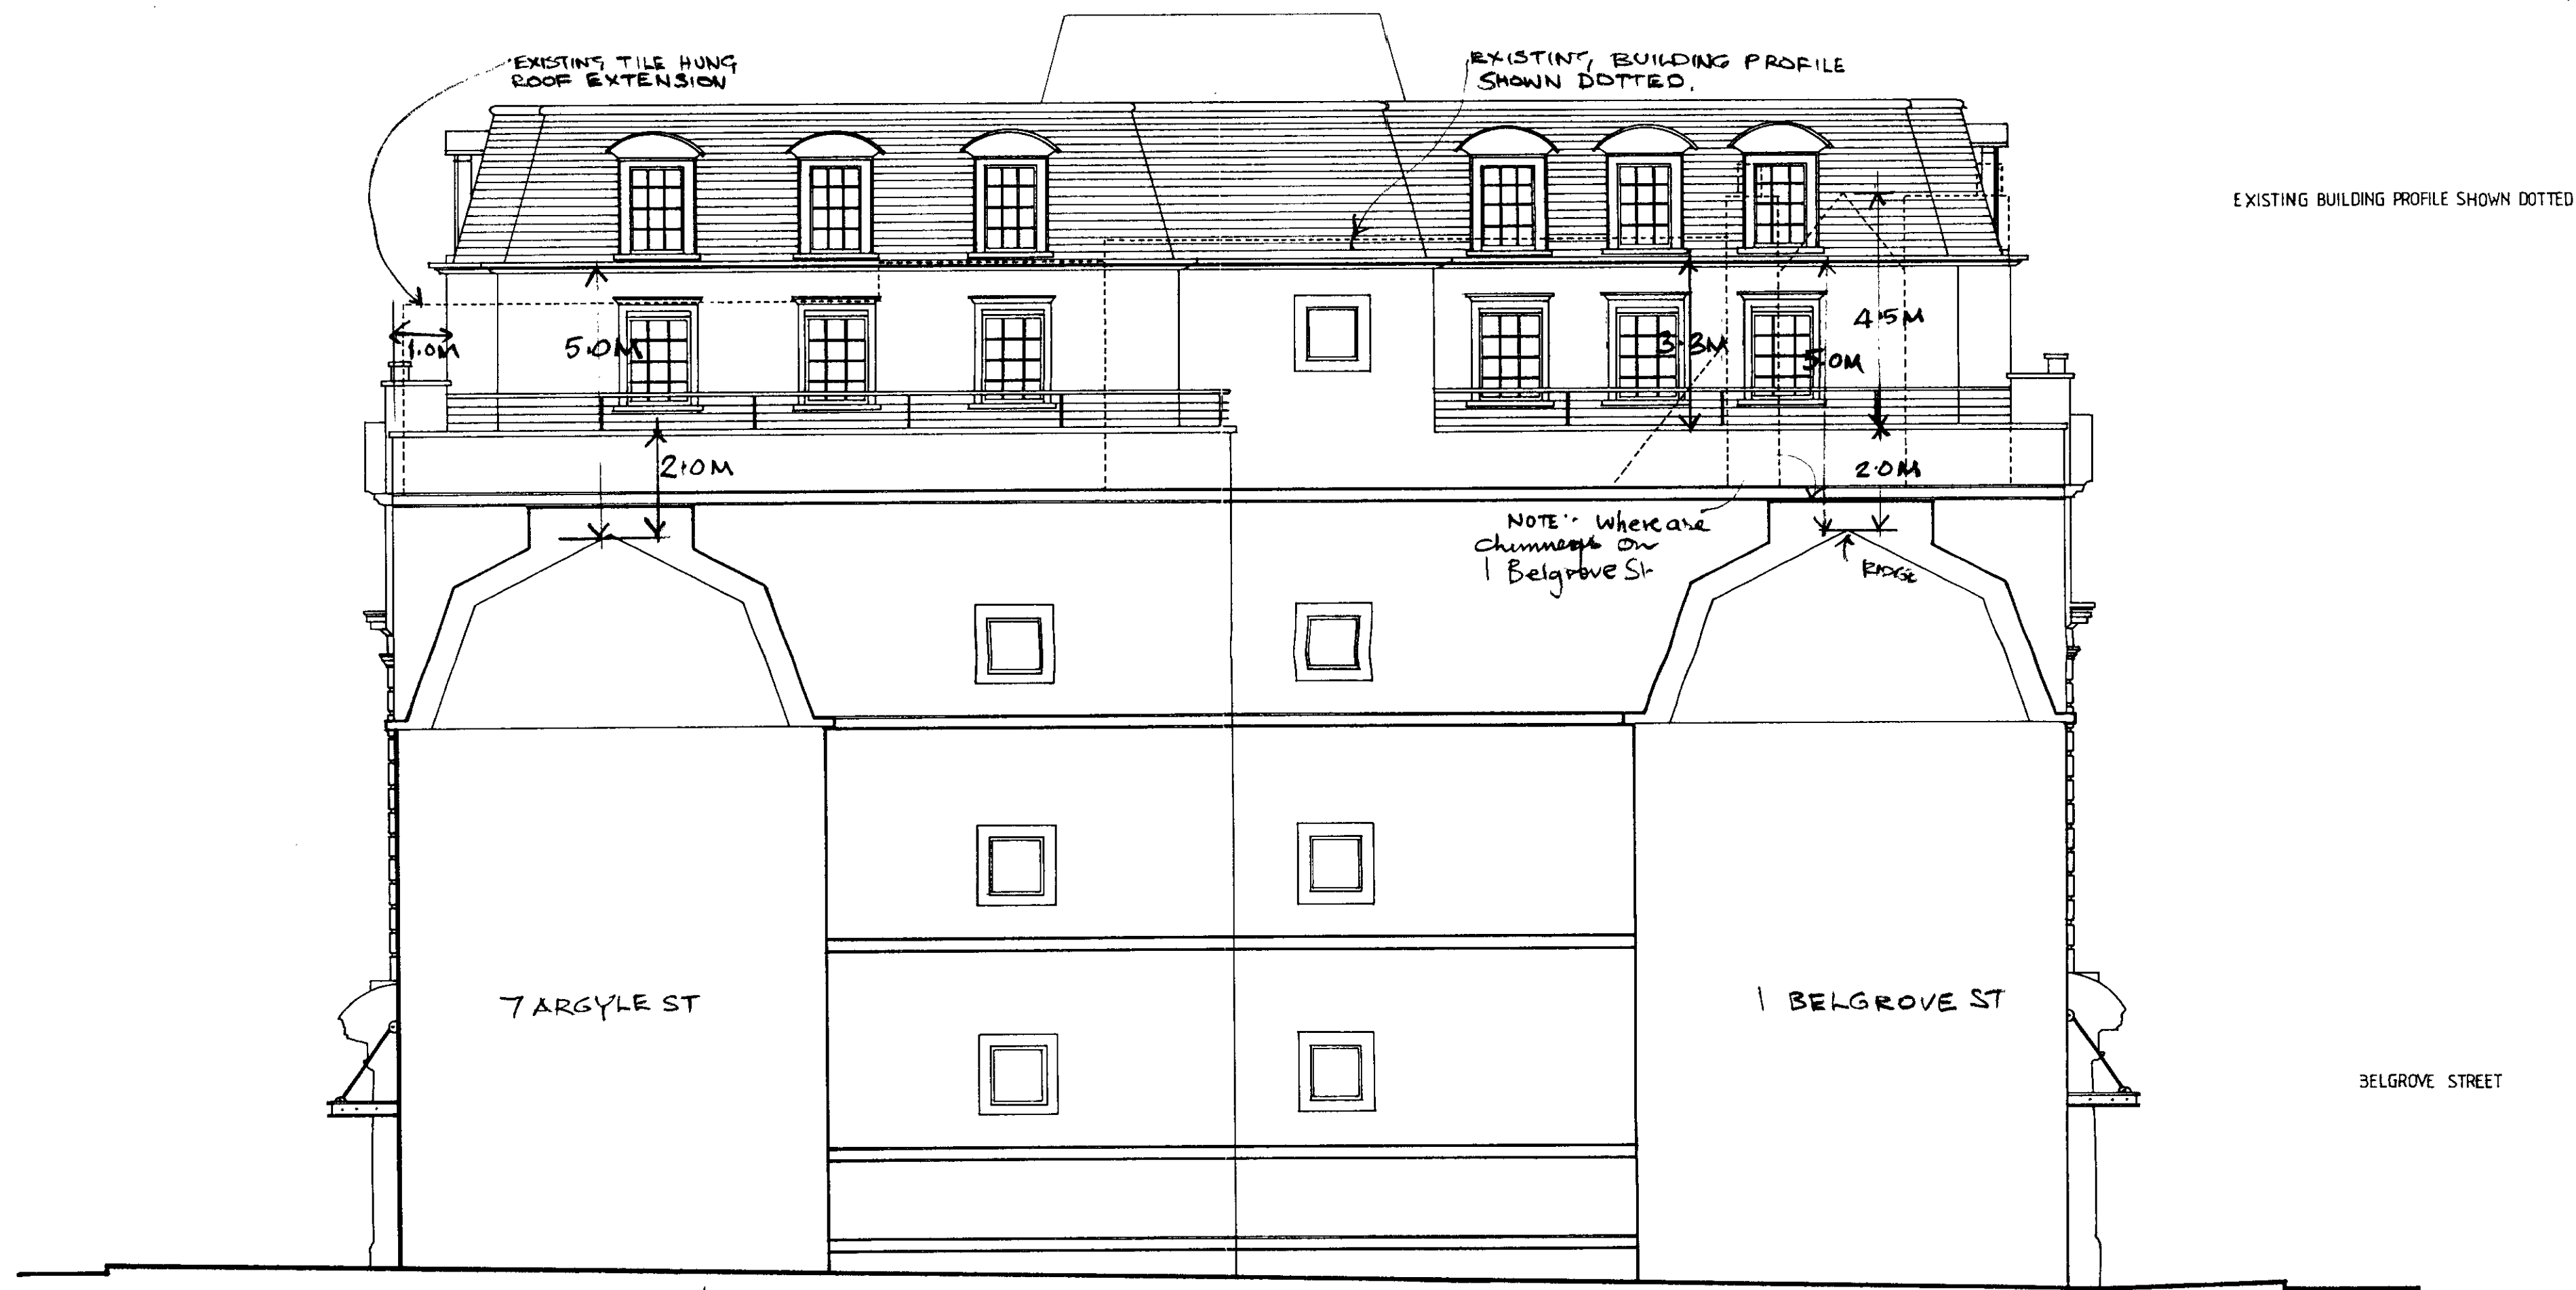

ARGYLE STREET

BELGROVE STREET

EXTRACT FROM EL/S-01
 MARKED UP TO SHOW DIMENSIONS
 IN PARAGRAPH 9.5 OF EVIDENCE
 OF BRUCE METHVEN

EXTRACT FROM EL/S-01
 MARKED UP TO SHOW DIMENSIONS
 IN PARAGRAPH 9.4 OF EVIDENCE
 OF BRUCE METHVEN

TP90 00286R3

ARGYLE HOUSE

SOUTH ELEVATION



Architecture & Design
 London Bristol Frankfurt
 90 96 Goswell Road
 London EC1V 7DB
 Telephone 071 490 8899
 Facsimile 071 490 8845

23-31 EUSTON ROAD
 JOB NO. 27144
 DRWG NO. EL/S-01
 JULY '92
 JD

1:100

Marked up with
 JWS H/15/92



OUTLINE OF EXISTING BUILDING

NEW FACADE

EXISTING FACADE WITH MODIFICATIONS

EXTRACT FROM DWG EL/BS-01
 MARKED UP TO SHOW DIMENSIONS
 IN PARAGRAPH 9.4 OF EVIDENCE
 OF BRUCE METHVEN

TP9000286R3

ARGYLE HOUSE

BELGROVE STREET ELEVATION



Architecture & Design
 London Bristol Frankfurt
 90 98 Goswell Road
 London EC1V 7DB
 Telephone 071 490 8899
 Facsimile 071 490 5845

23-31 EUSTON ROAD
 JOB NO. 27144
 DRWG NO. EL/35-01
 JULY '92
 JD

Marked



NATURAL SLATE MANSARD

PAINTED RENDER WITH STONE FEATURES

BRICKWORK WITH STONE FEATURES

BELGROVE STREET

ARGYLE STREET

OFFICE ENTRANCE DOORS AND CANOPY


EXISTING FACADE WITH MODIFICATIONS

NEW FACADE TO REPLICATE EXISTING

TP90 00286R3

ARGYLE HOUSE

EUSTON ROAD ELEVATION

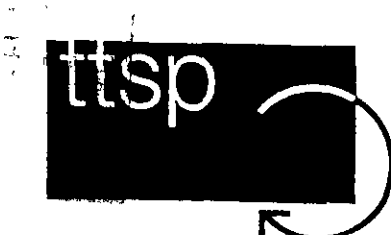

Architecture & Design
London based Frankfurt

90-98 Goswell Road
London EC1V 7JH
Telephone 071 490 5899
Facsimile 071 490 5845

23-31 EUSTON ROAD
JOB NO 27144
DRWG NO. EUEV-01
REVISED JULY '92
KDS
1:100