

FIFTH FLOOR

FOURTH FLOOR


THIRD FLOOR

SECOND FLOOR


FIRST FLOOR

GROUND FLOOR

LOWER GROUND FLOOR

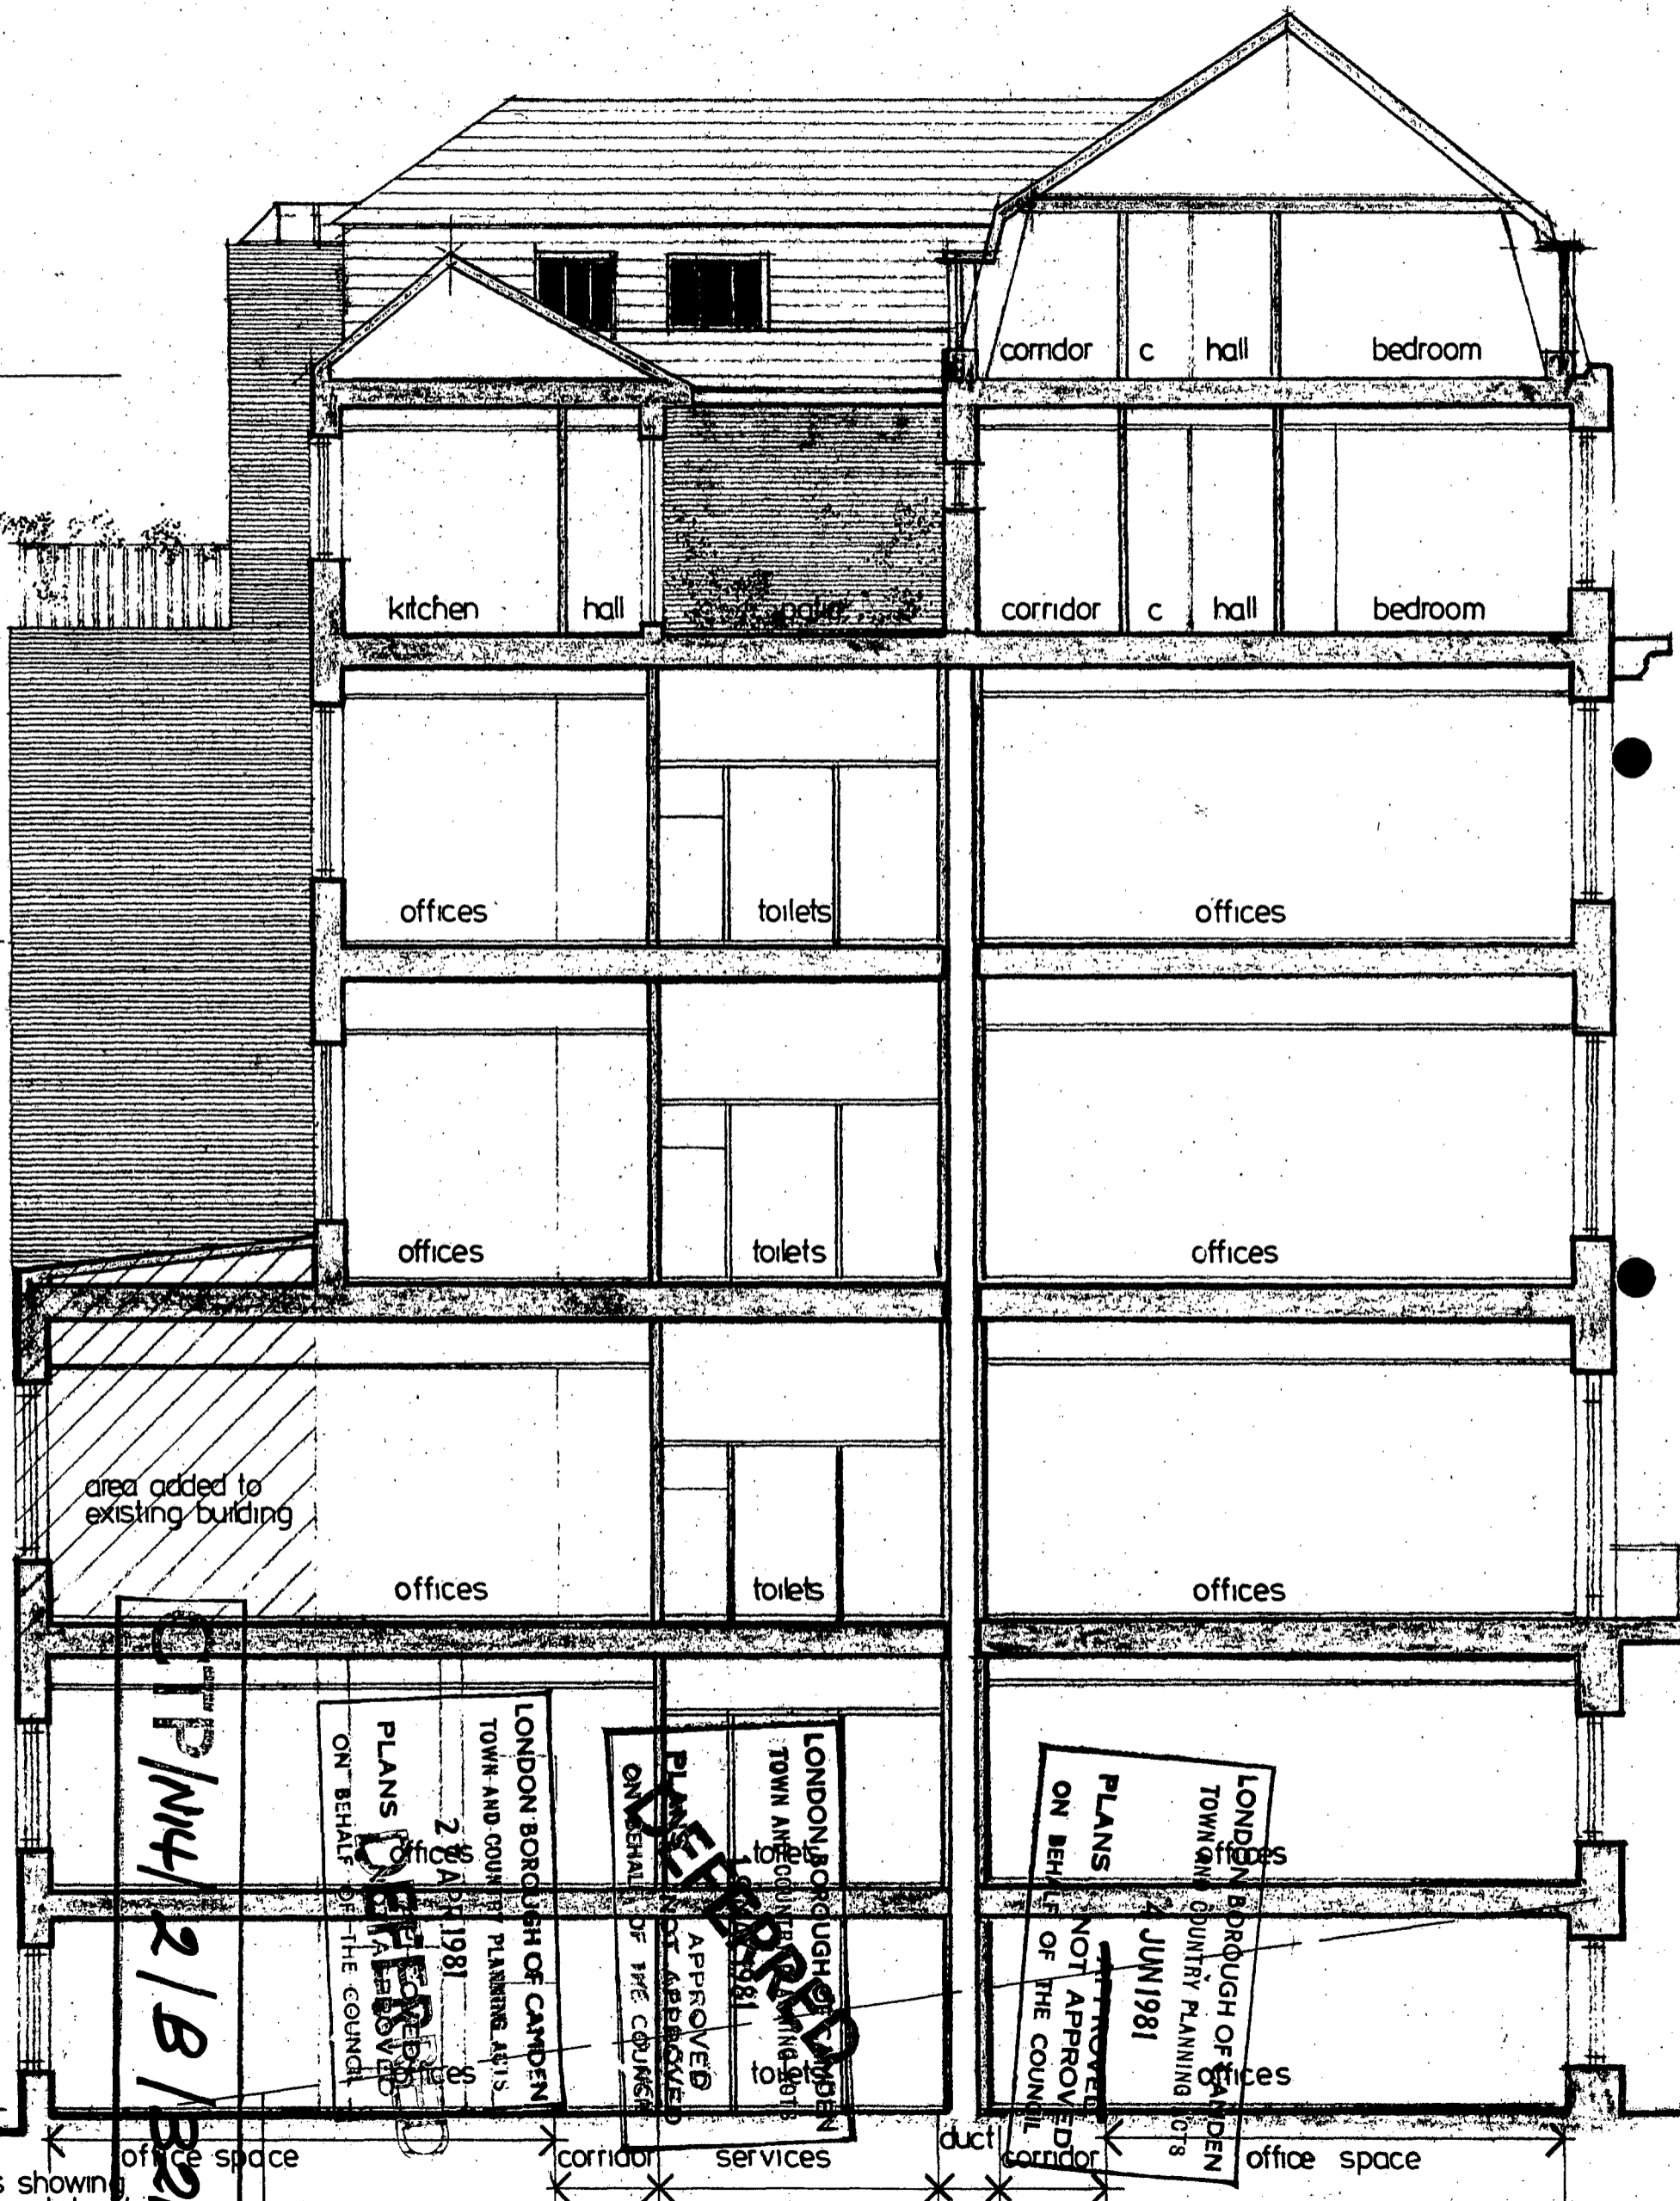

SECTION 1-1  
 SCALE 1/8" = 1'-0"  
 SCHEME 'G' Feb 1981

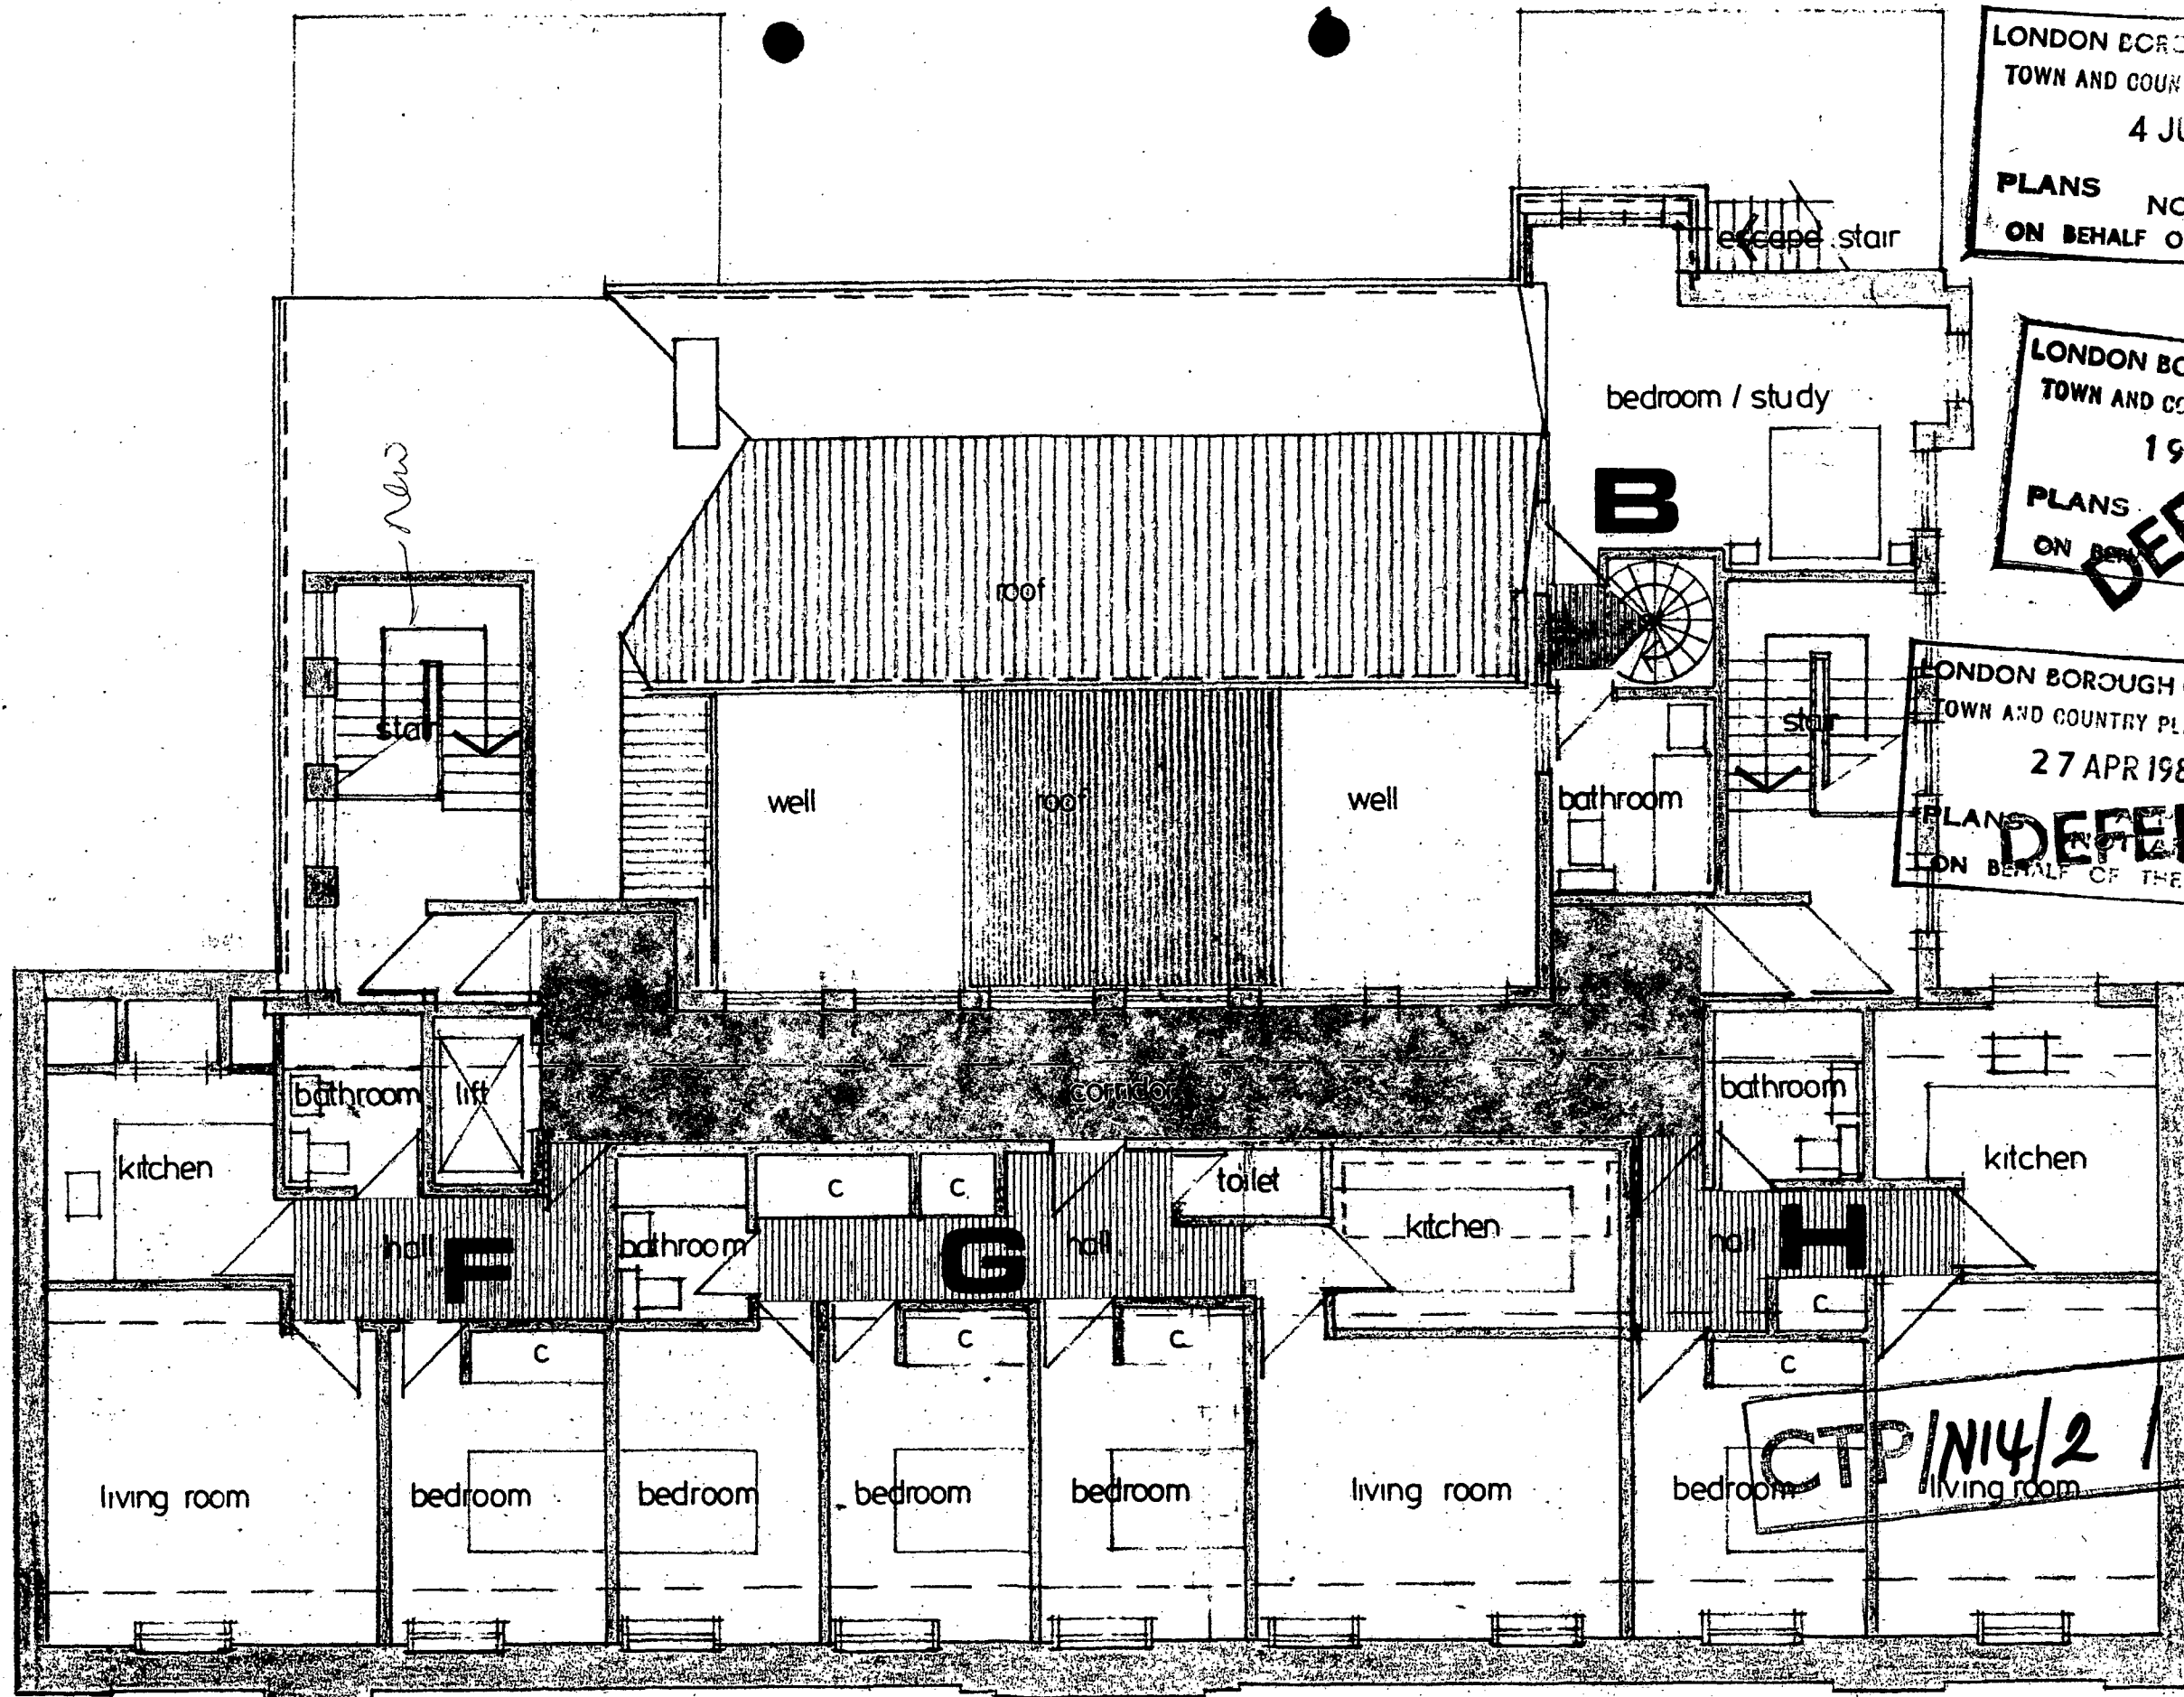


LONDON BOROUGH OF CAMDEN  
TOWN AND COUNTRY PLANNING ACTS  
4 JUN 1981  
PLANS ~~APPROVED~~ NOT APPROVED  
ON BEHALF OF THE COUNCIL

LONDON BOROUGH OF CAMDEN  
TOWN AND COUNTRY PLANNING ACTS  
19 MAY 1981  
PLANS ~~APPROVED~~ NOT APPROVED  
ON BEHALF OF THE COUNCIL

LONDON BOROUGH OF CAMDEN  
TOWN AND COUNTRY PLANNING ACTS  
27 APR 1981  
PLANS ~~APPROVED~~ NOT APPROVED  
ON BEHALF OF THE COUNCIL

CTP/N14/2 / B / 32117

FIFTH FLOOR  
SCALE 1/8" = 1'-0"  
SCHEME 'G' Feb. 1981

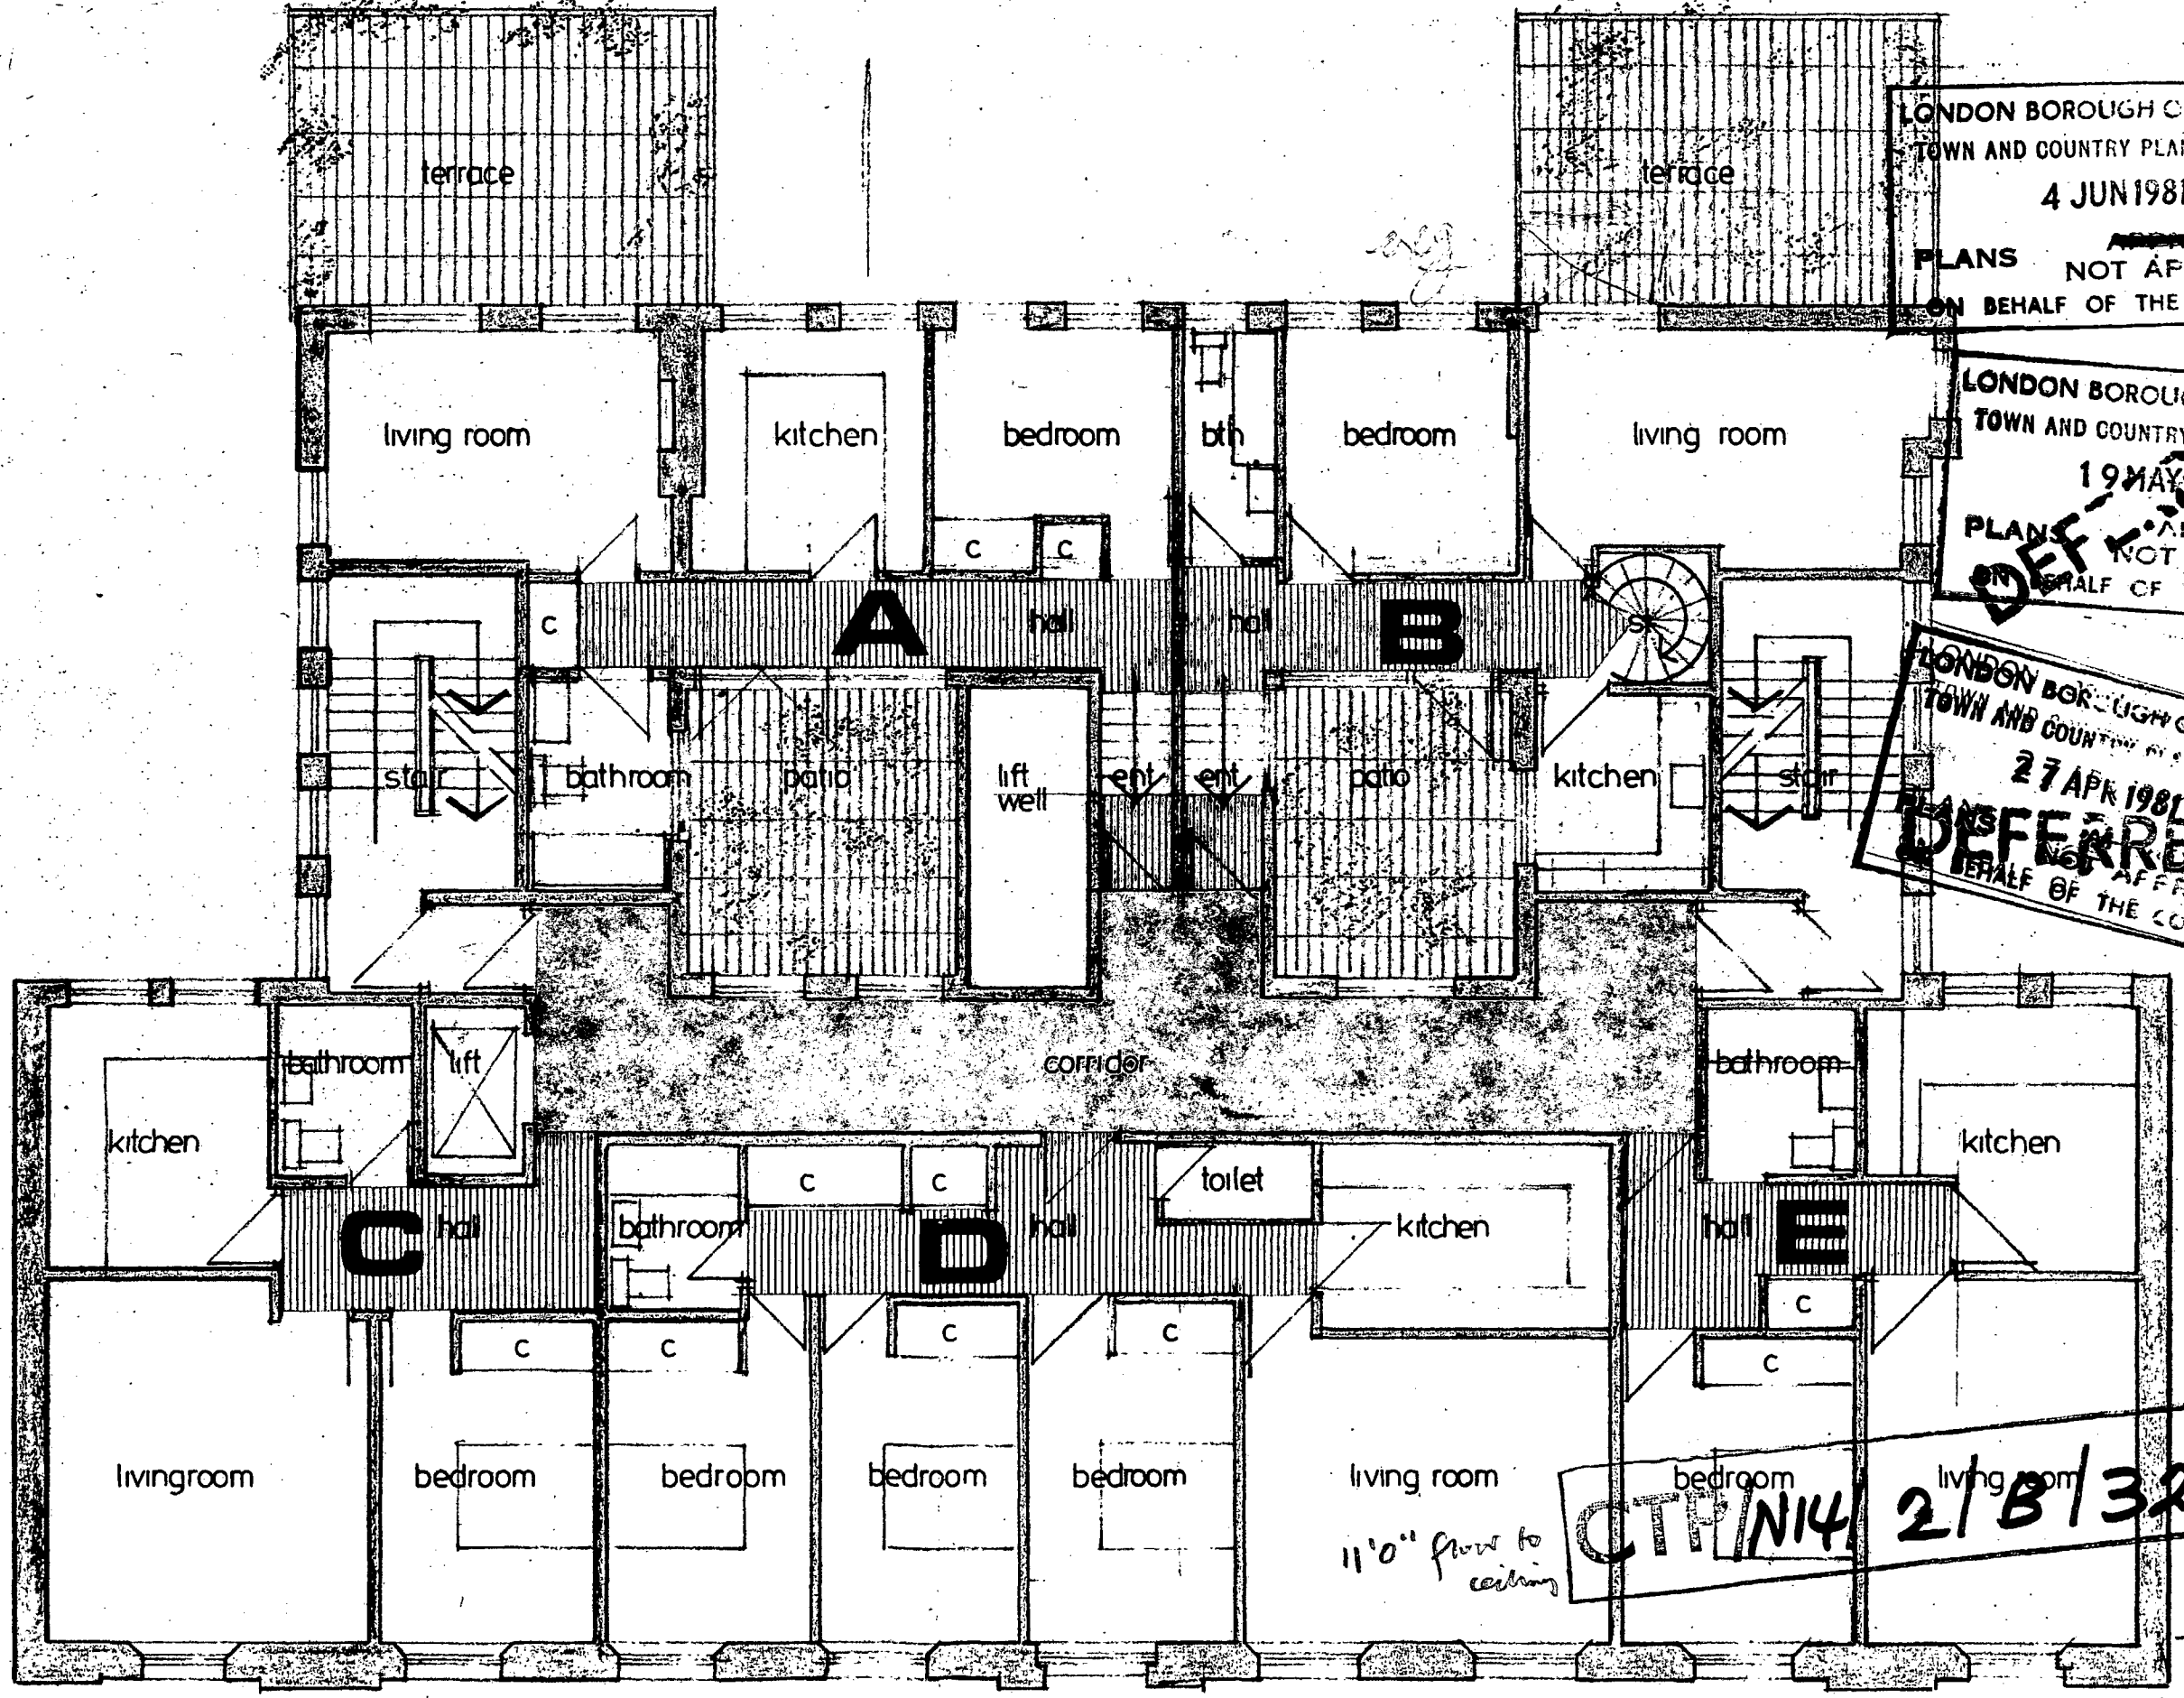


LONDON BOROUGH OF CAMDEN  
TOWN AND COUNTRY PLANNING ACTS  
4 JUN 1981  
~~APPROVED~~  
PLANS NOT APPROVED  
ON BEHALF OF THE COUNCIL

LONDON BOROUGH OF CAMDEN  
TOWN AND COUNTRY PLANNING ACTS  
19 MAY 1981  
~~APPROVED~~  
PLANS NOT APPROVED  
ON BEHALF OF THE COUNCIL

LONDON BOROUGH OF CAMDEN  
TOWN AND COUNTRY PLANNING ACTS  
27 APR 1981  
~~APPROVED~~  
PLANS DEFERRED  
ON BEHALF OF THE COUNCIL

CTP/N14/2/B/321A

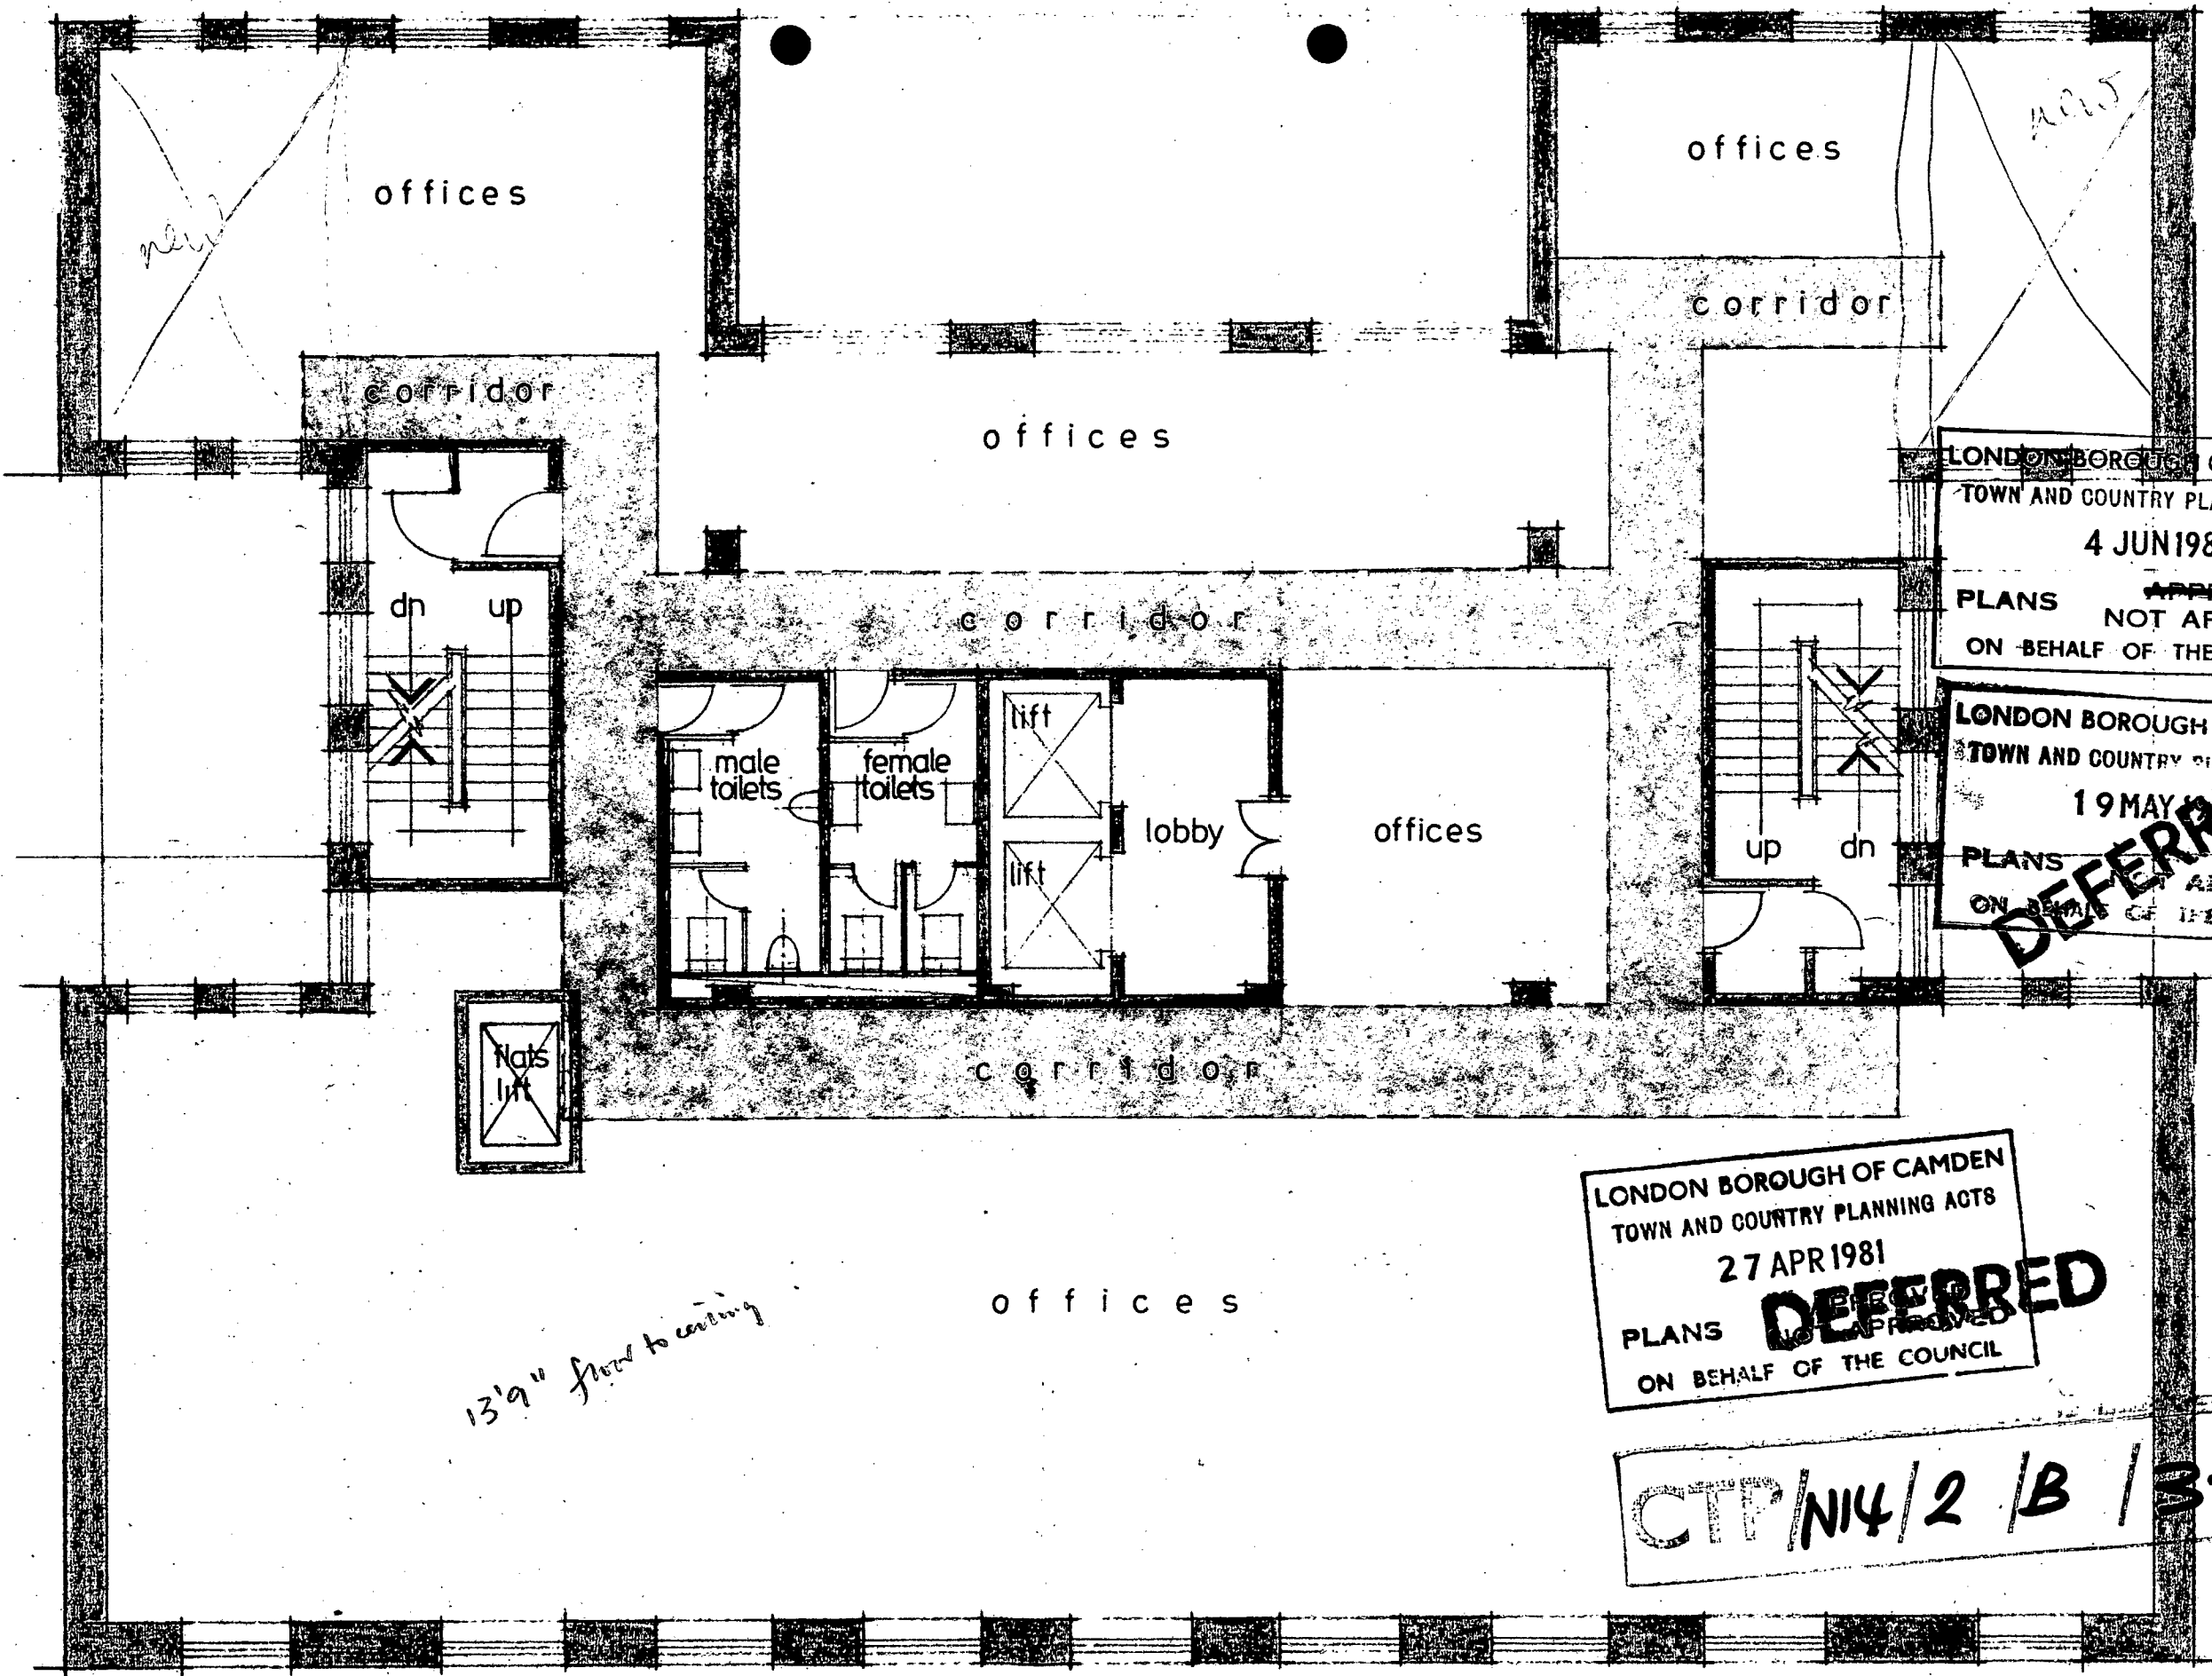


LONDON BOROUGH OF CAMDEN  
TOWN AND COUNTRY PLANNING ACTS  
4 JUN 1981  
~~APPROVED~~  
PLANS NOT APPROVED  
ON BEHALF OF THE COUNCIL

LONDON BOROUGH OF CAMDEN  
TOWN AND COUNTRY PLANNING ACTS  
19 MAY 1981  
~~APPROVED~~  
PLANS NOT APPROVED  
ON BEHALF OF THE COUNCIL

LONDON BOROUGH OF CAMDEN  
TOWN AND COUNTRY PLANNING ACTS  
27 APR 1981  
~~APPROVED~~  
PLANS NOT APPROVED  
ON BEHALF OF THE COUNCIL

CTP/N14/2/B/3217

THIRD FLOOR  
SCALE 1/8"=1'-0"  
SCHEME 'G' Feb 1981

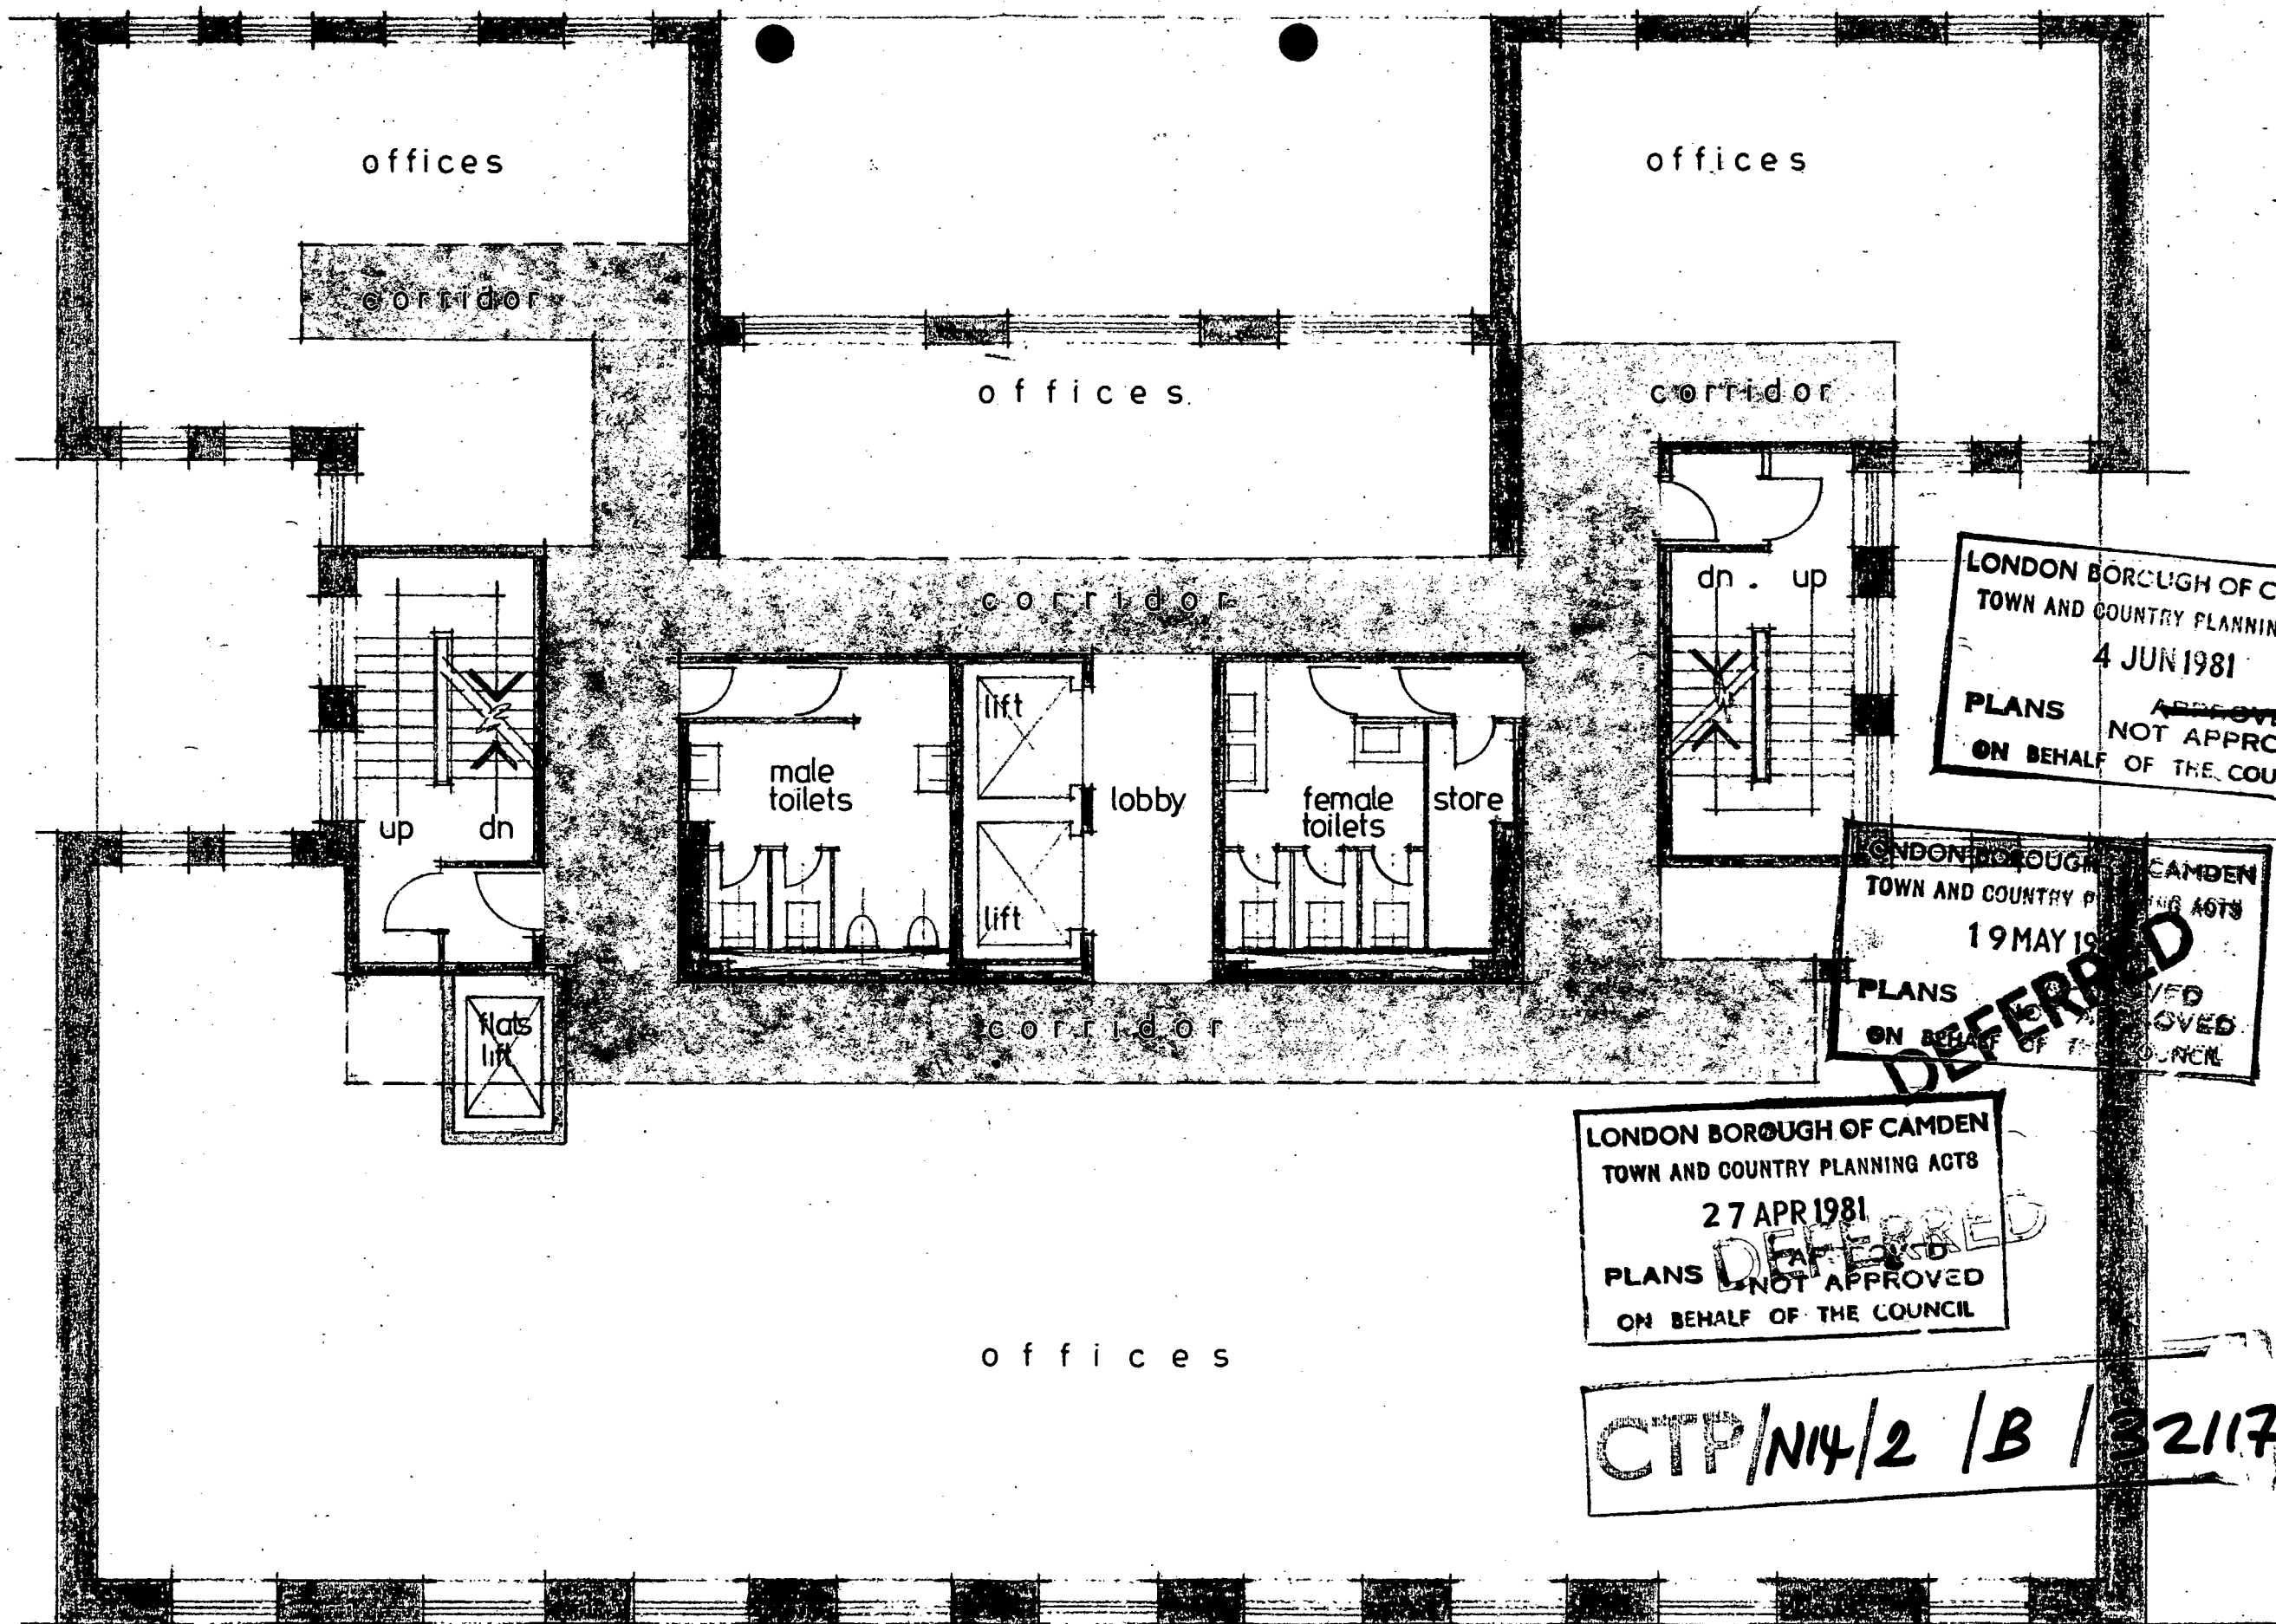


LONDON BOROUGH OF CAMDEN  
 TOWN AND COUNTRY PLANNING ACTS  
 4 JUN 1981  
 PLANS ~~APPROVED~~  
 NOT APPROVED  
 ON BEHALF OF THE COUNCIL

LONDON BOROUGH OF CAMDEN  
 TOWN AND COUNTRY PLANNING ACTS  
 19 MAY 1981  
 PLANS ~~APPROVED~~  
 NOT APPROVED  
 ON BEHALF OF THE COUNCIL

LONDON BOROUGH OF CAMDEN  
 TOWN AND COUNTRY PLANNING ACTS  
 27 APR 1981  
 PLANS ~~APPROVED~~  
 NOT APPROVED  
 ON BEHALF OF THE COUNCIL

CTP/N14/2 /B /32117

SECOND FLOOR  
 SCALE 1/8"=1'-0"  
 SCHEME 'G' Feb 1981

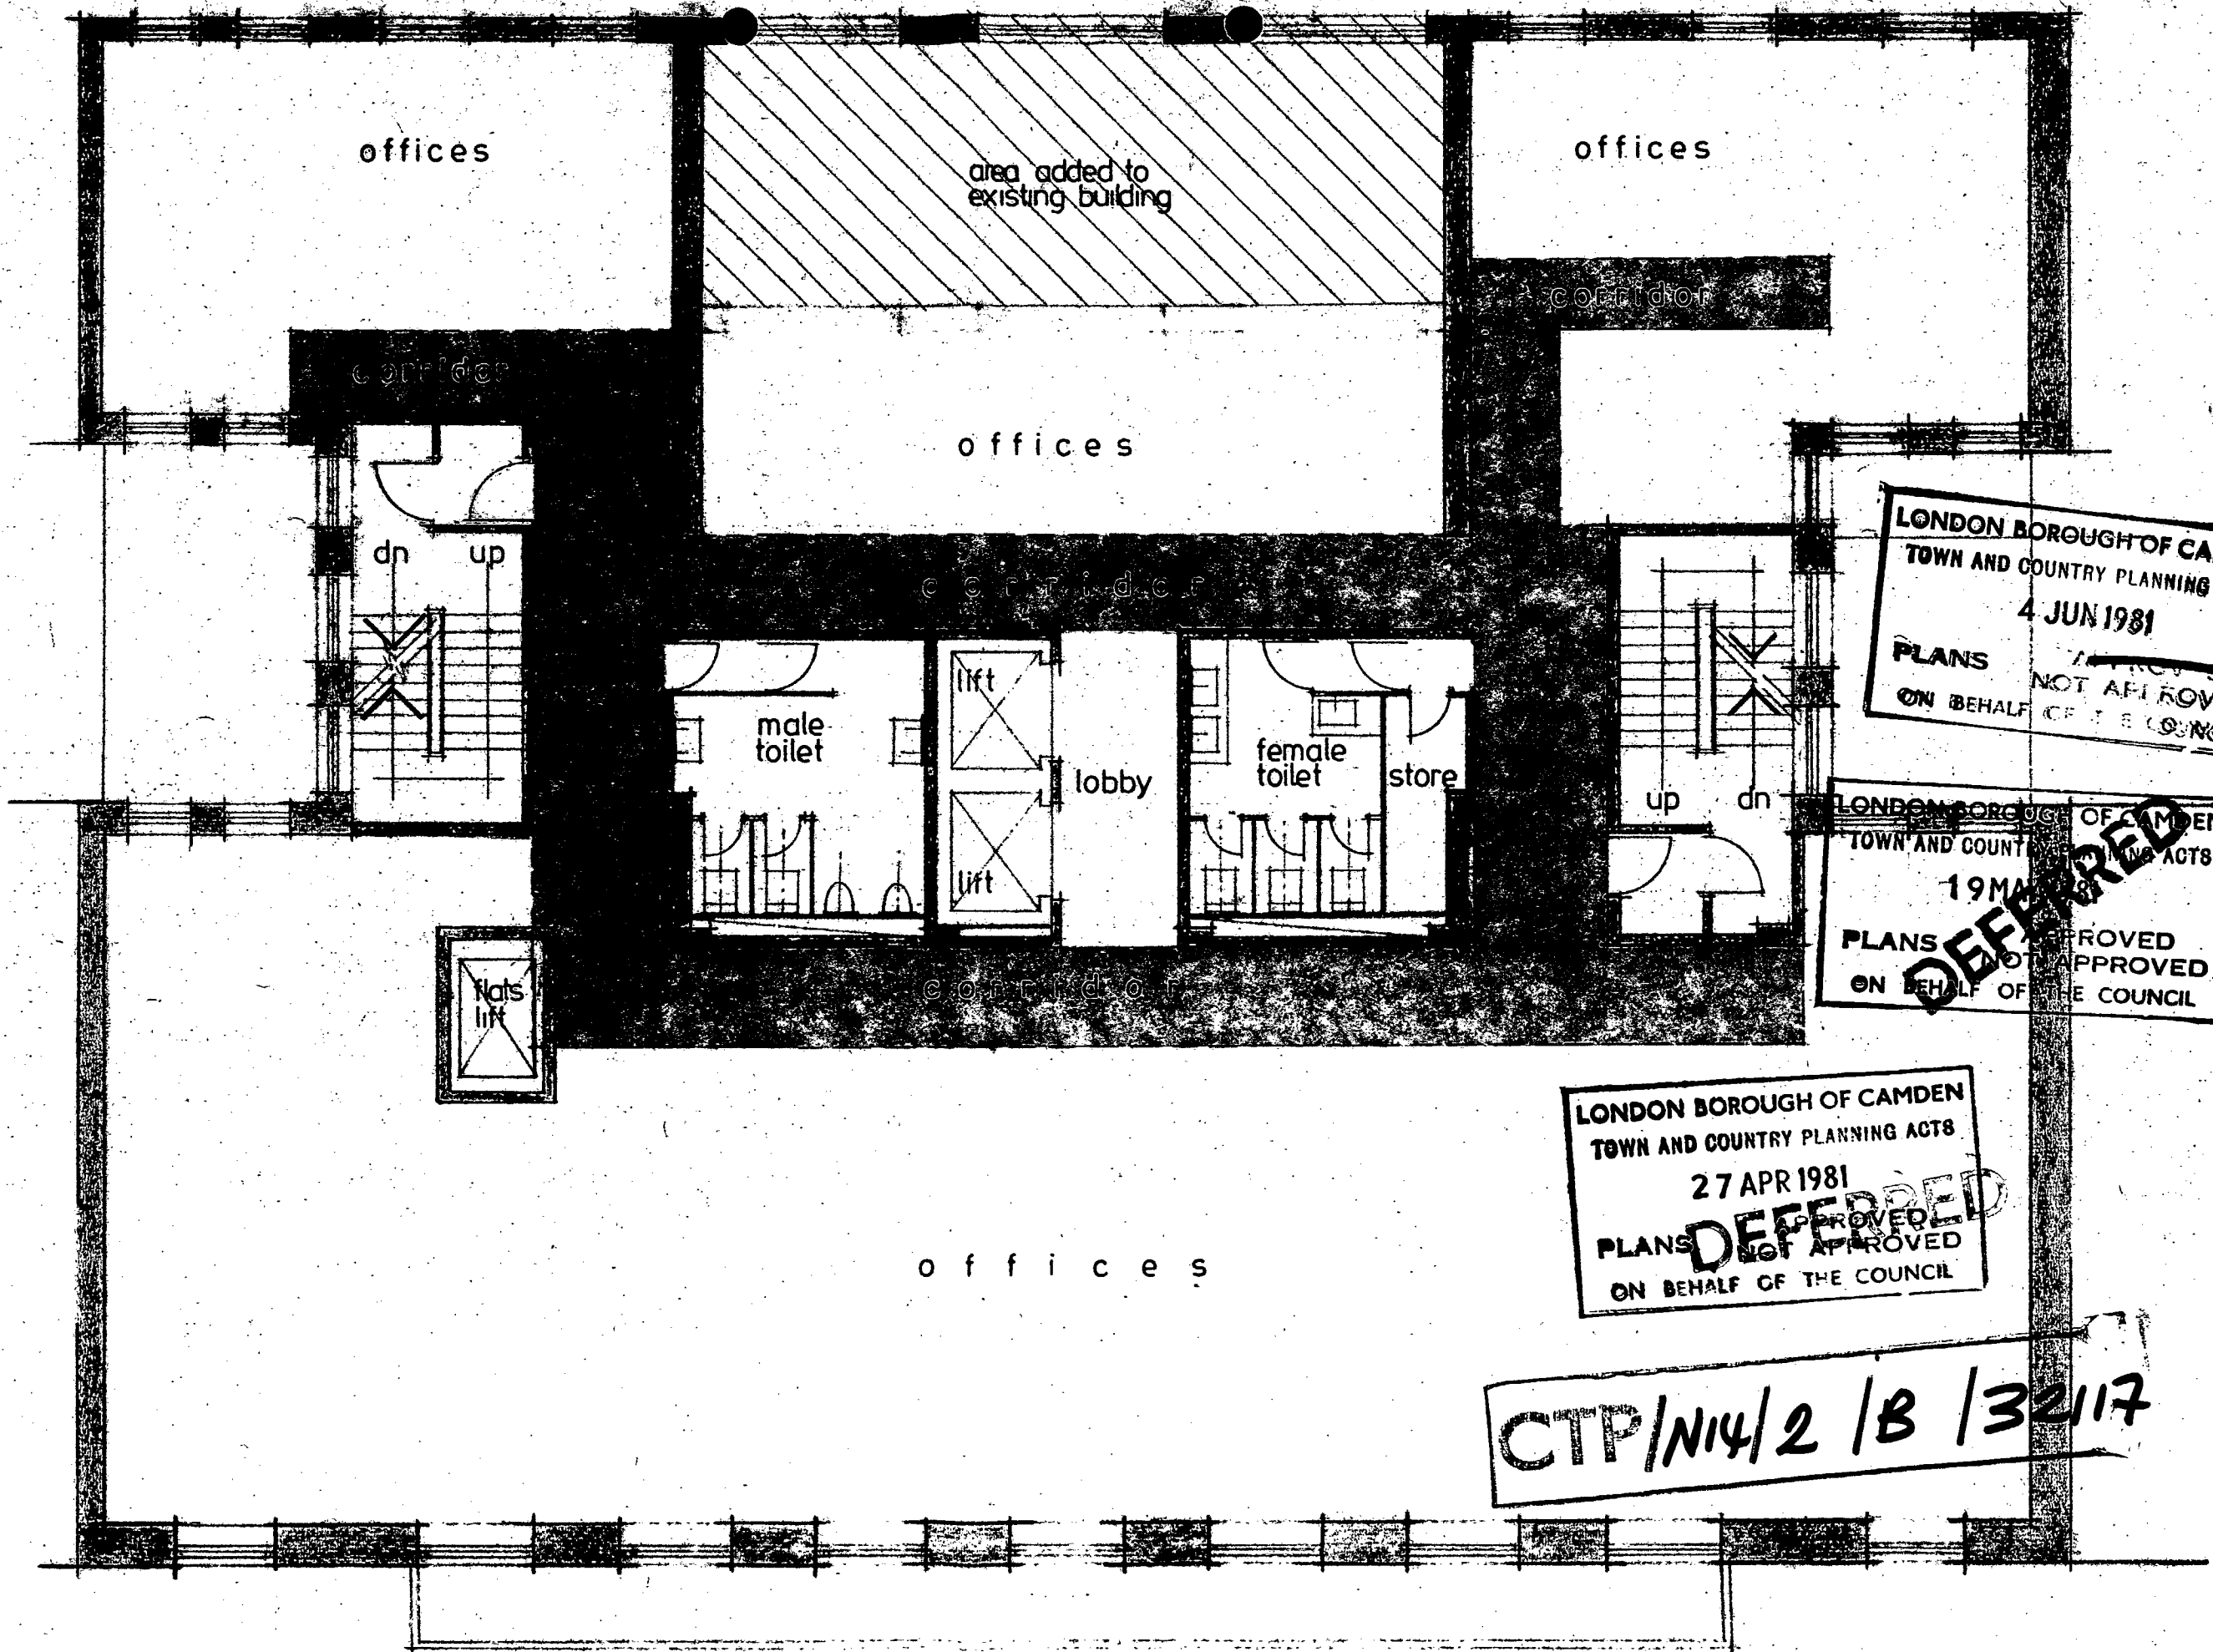

offices

area added to  
existing building

offices

corridor

corridor

offices

corridor

dn up

male  
toilet

lift

lobby

female  
toilet

store

up dn

flats  
lift

corridor

LONDON BOROUGH OF CAMDEN  
TOWN AND COUNTRY PLANNING ACTS  
4 JUN 1981  
PLANS NOT APPROVED  
ON BEHALF OF THE COUNCIL

LONDON BOROUGH OF CAMDEN  
TOWN AND COUNTRY PLANNING ACTS  
19 MAY 1981  
PLANS NOT APPROVED  
ON BEHALF OF THE COUNCIL


LONDON BOROUGH OF CAMDEN  
TOWN AND COUNTRY PLANNING ACTS  
27 APR 1981  
PLANS NOT APPROVED  
ON BEHALF OF THE COUNCIL

offices

CTP/N14/2/B/32117

SCHEME 'G'

FIRST FLOOR  
SCALE 1/8"=1'-0"  
Feb. 1981

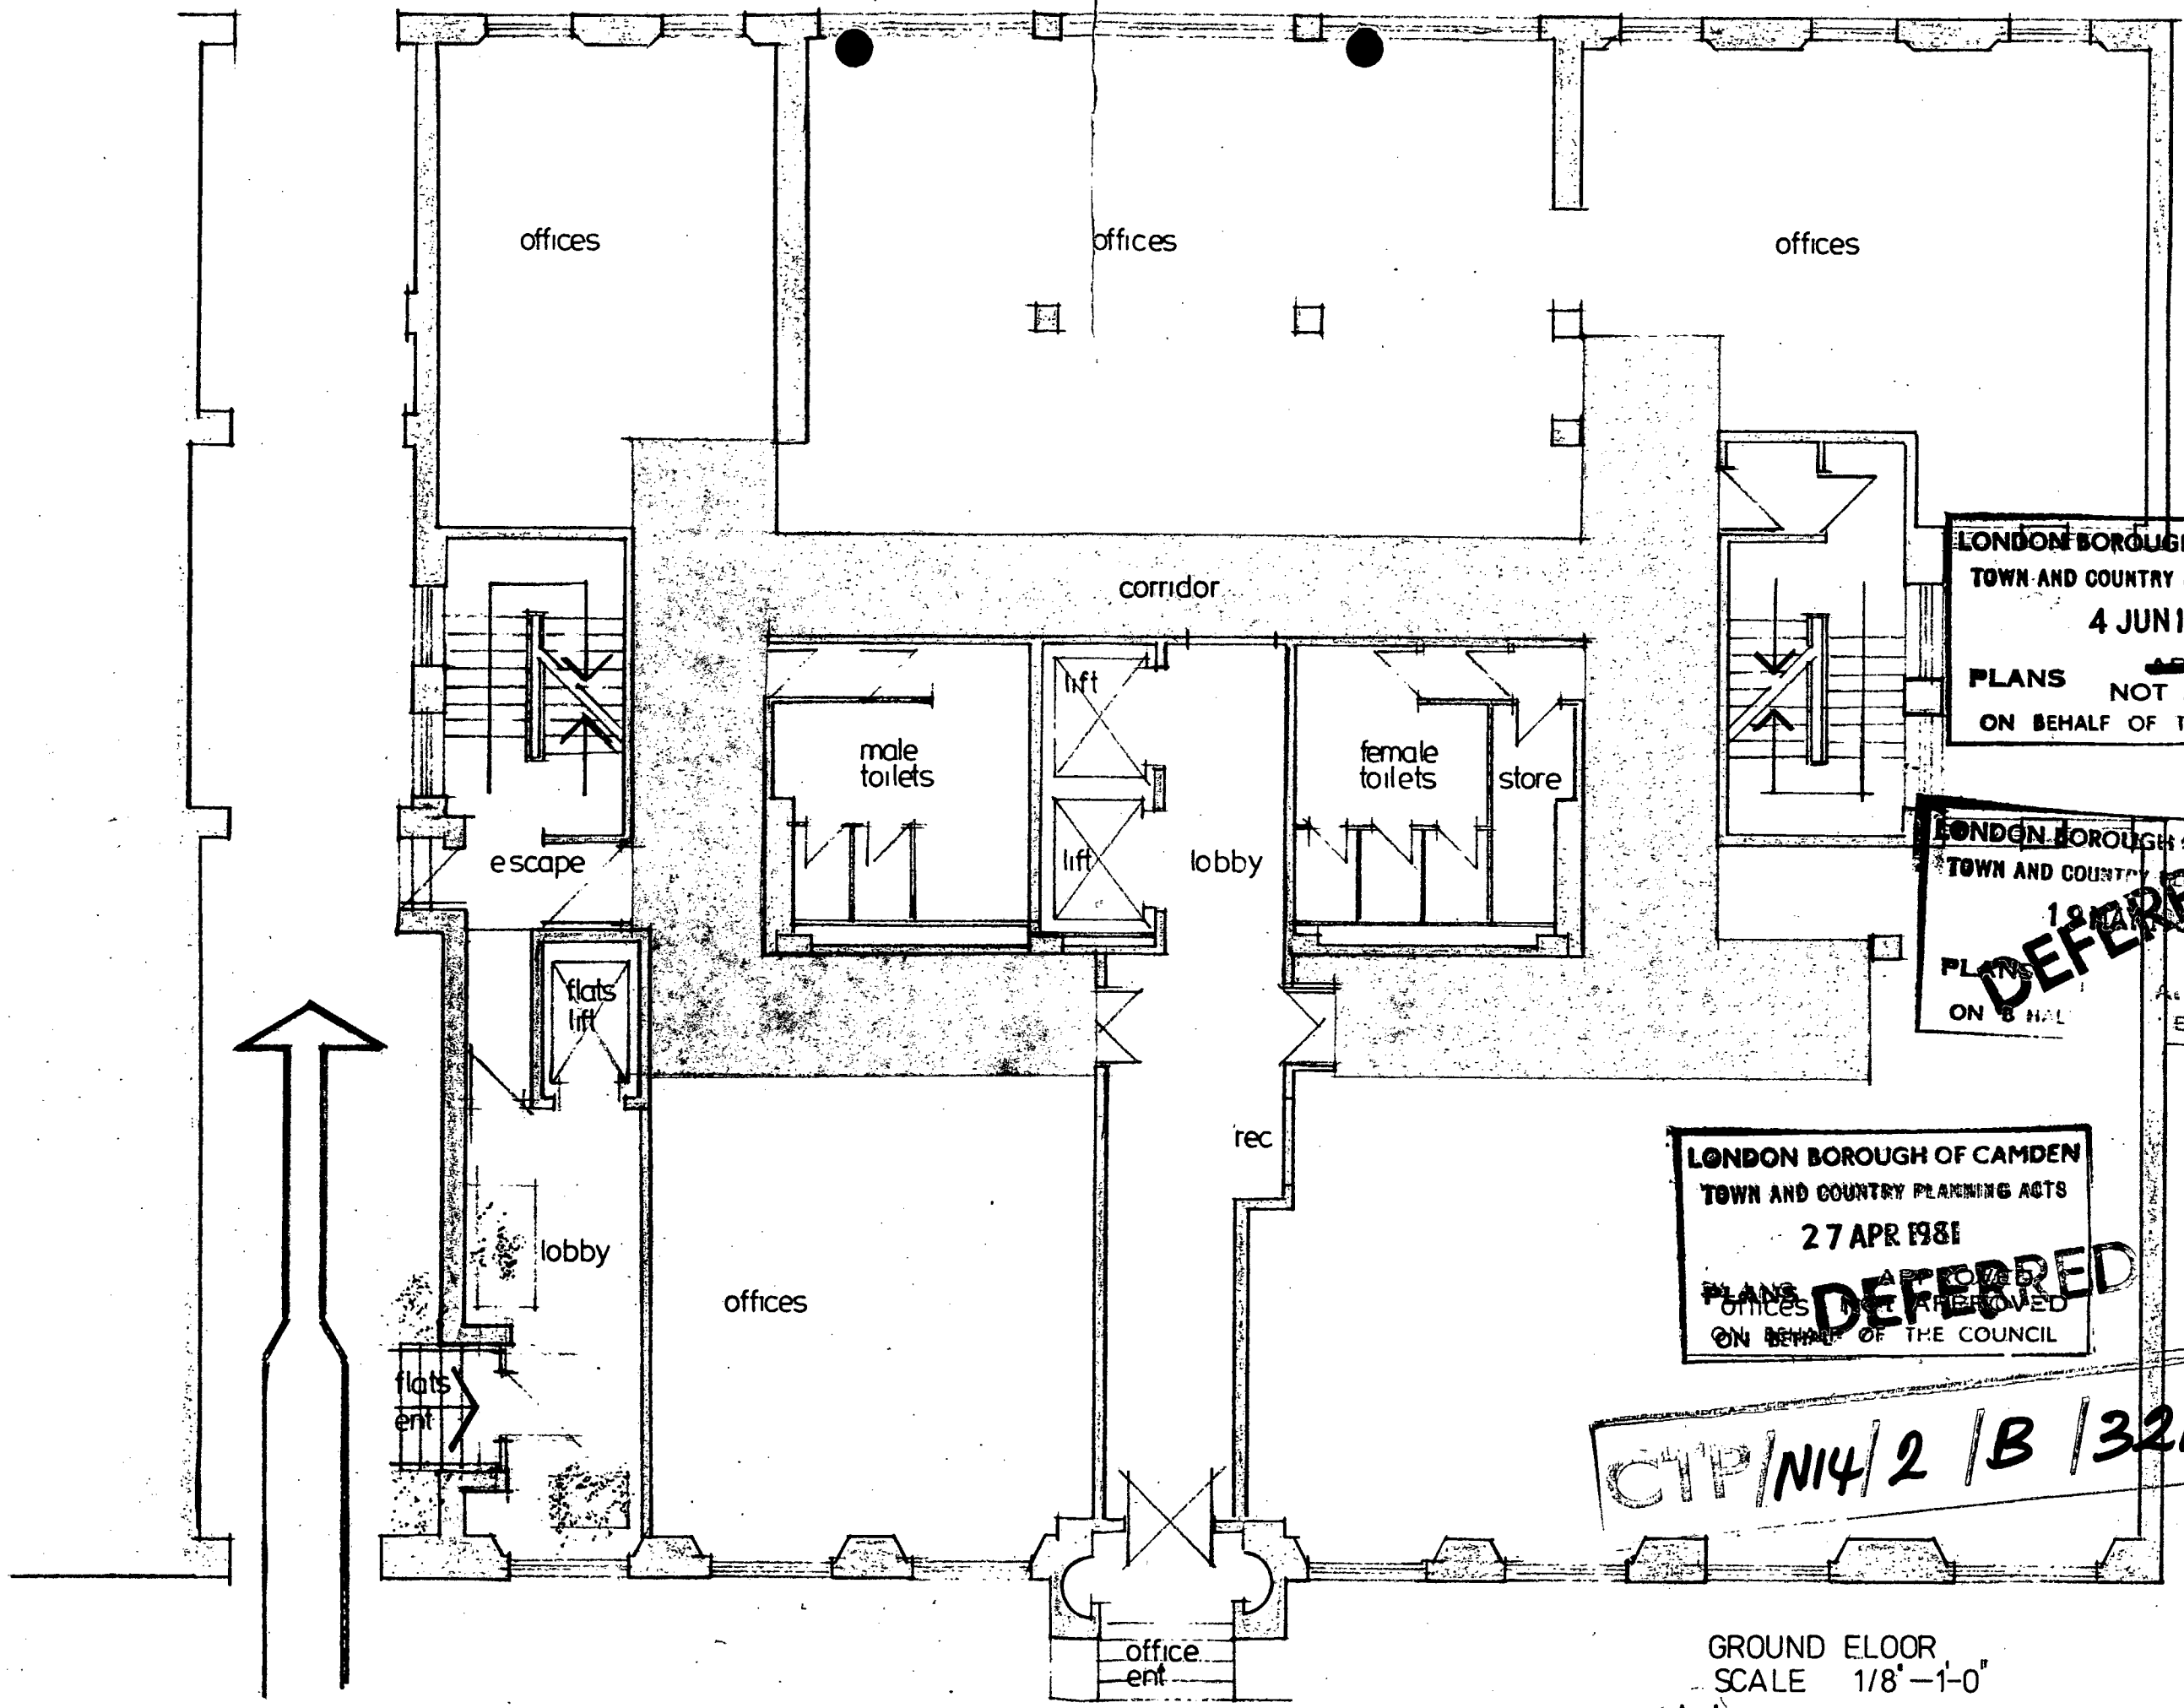


LONDON BOROUGH OF CAMDEN  
 TOWN AND COUNTRY PLANNING ACTS  
 4 JUN 1981  
 PLANS ~~APPROVED~~  
 NOT APPROVED  
 ON BEHALF OF THE COUNCIL

LONDON BOROUGH OF CAMDEN  
 TOWN AND COUNTRY PLANNING ACTS  
 18 MAY 1981  
 PLANS ~~APPROVED~~  
 DEFERRED  
 ON BEHALF OF THE COUNCIL

LONDON BOROUGH OF CAMDEN  
 TOWN AND COUNTRY PLANNING ACTS  
 27 APR 1981  
 PLANS ~~APPROVED~~  
 DEFERRED  
 ON BEHALF OF THE COUNCIL

CIP/N14/2/B/3217

GROUND FLOOR  
 SCALE 1/8" = 1'-0"  
 SCHEME 'G' Feb. 1981

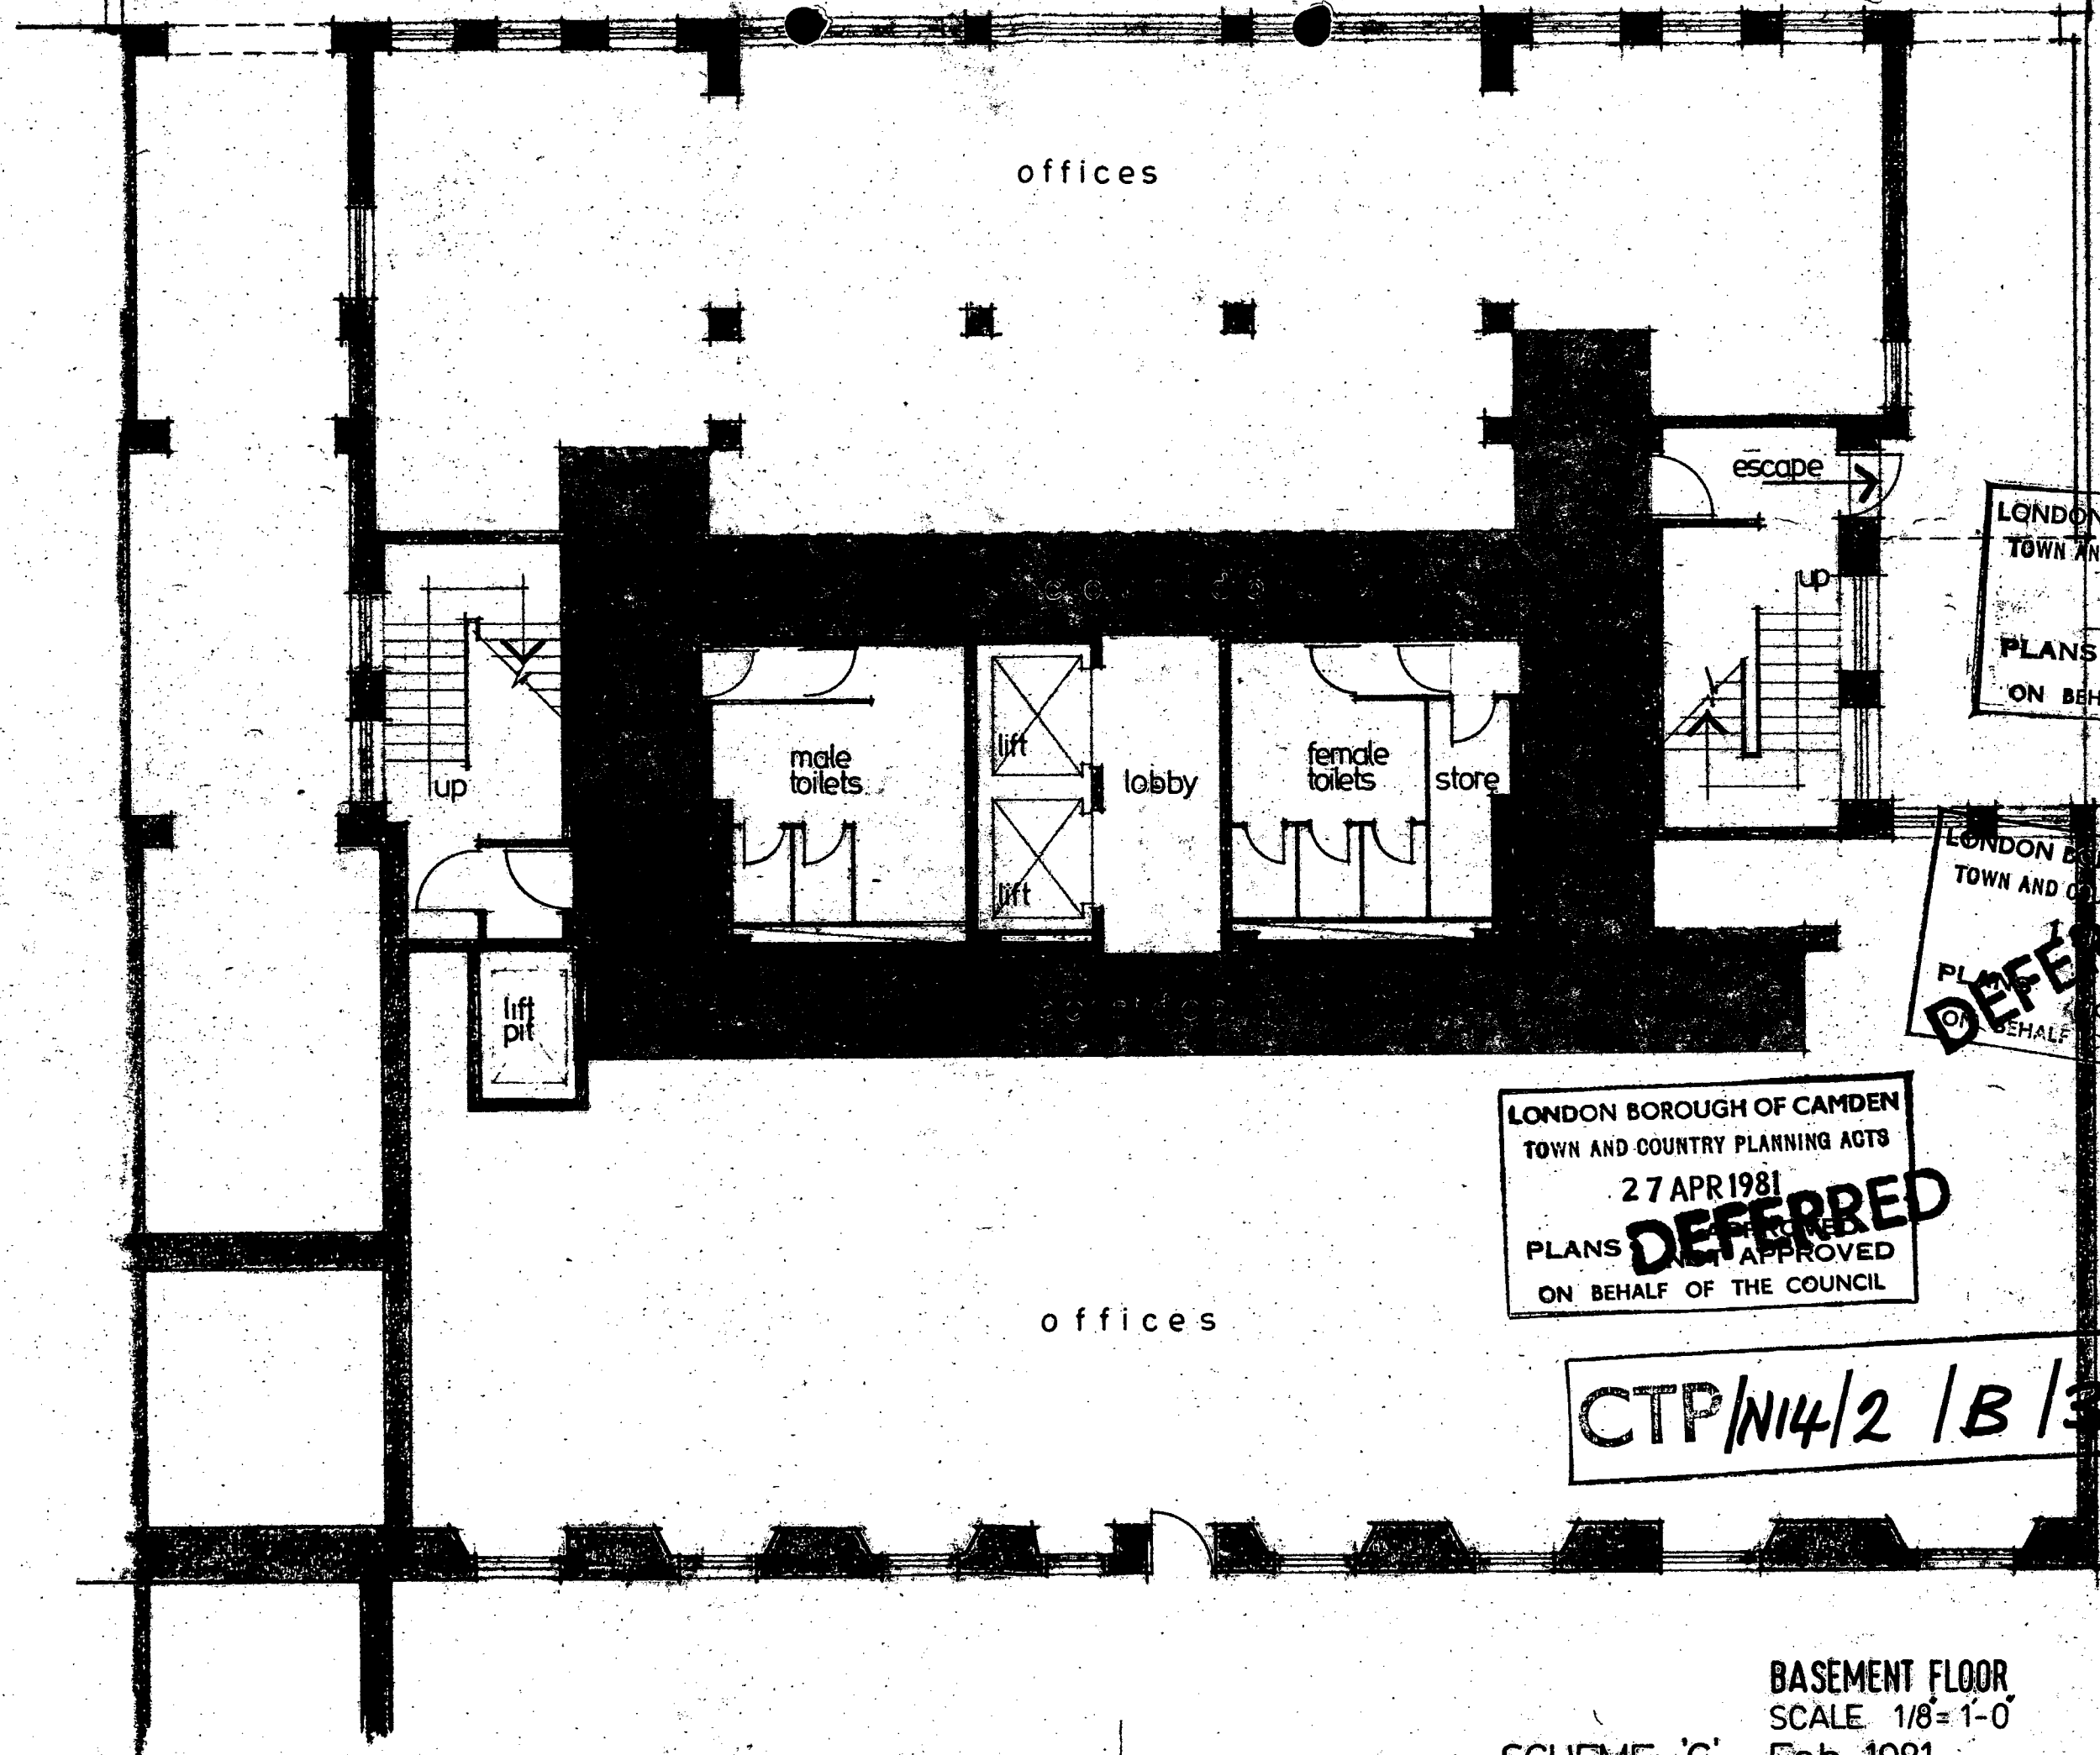

LONDON BOROUGH OF  
TOWN AND COUNTRY PLANNING ACTS  
4 JUN 1981  
PLANS APPROVED  
NOT APPROVED  
ON BEHALF OF THE COUNCIL

LONDON BOROUGH OF CAMDEN  
TOWN AND COUNTRY PLANNING ACTS  
27 APR 1981  
PLANS DEFERRED  
NOT APPROVED  
ON BEHALF OF THE COUNCIL

LONDON BOROUGH OF CAMDEN  
TOWN AND COUNTRY PLANNING ACTS  
27 APR 1981  
PLANS DEFERRED  
NOT APPROVED  
ON BEHALF OF THE COUNCIL

CTP/N14/2 / B / 32117

BASEMENT FLOOR  
SCALE 1/8" = 1'-0"  
Feb 1981

SCHEME 'G'