

TP 8700534/KS
~~113 4770011/KS~~

LONDON BOROUGH OF CAMDEN
 TOWN AND COUNTRY PLANNING ACTS
 3 SEP 1997
 APPROVED
 PLANS NOT APPROVED
 ON BEHALF OF THE COUNCIL

LONDON BOROUGH OF CAMDEN
 TOWN AND COUNTRY PLANNING ACTS
 6 AUG 1987
 APPROVED
 PLANS NOT APPROVED
 ON BEHALF OF THE COUNCIL

Figured dimensions only are to be taken from this drawing. All dimensions are to be checked on site before any work is put in hand. If in doubt, ask

Notes

Mk	Revision	Initial	Date
0.	HANBARD ROOF REV'D	JAA	5.8.87

- > Bradstone Brook
Shalford, Guildford GU4 8HT
telephone 0483 68686
- > 10-13 King Street
London WC2E 8HZ
telephone 01-240 2961
- > 4 Fitzroy Place
Glasgow G3 7RH
telephone 041-204 0066

SCOTT BROWNRIGG & TURNER
 Architects and planning consultants

Client's name
TAYLOR WOODROW PROPERTY CO. LTD
TEXACO SITE
7 DIALS WC 2.
 Drawing title
ROOF PLAN


Scale 1:100

Drawn	Checked	Date

Job no	Drawing no	Rev
8081	A 12	B

Figured dimensions only are to be taken from this drawing. All dimensions are to be checked on site before any work is put in hand. If in doubt, ask.

Notes

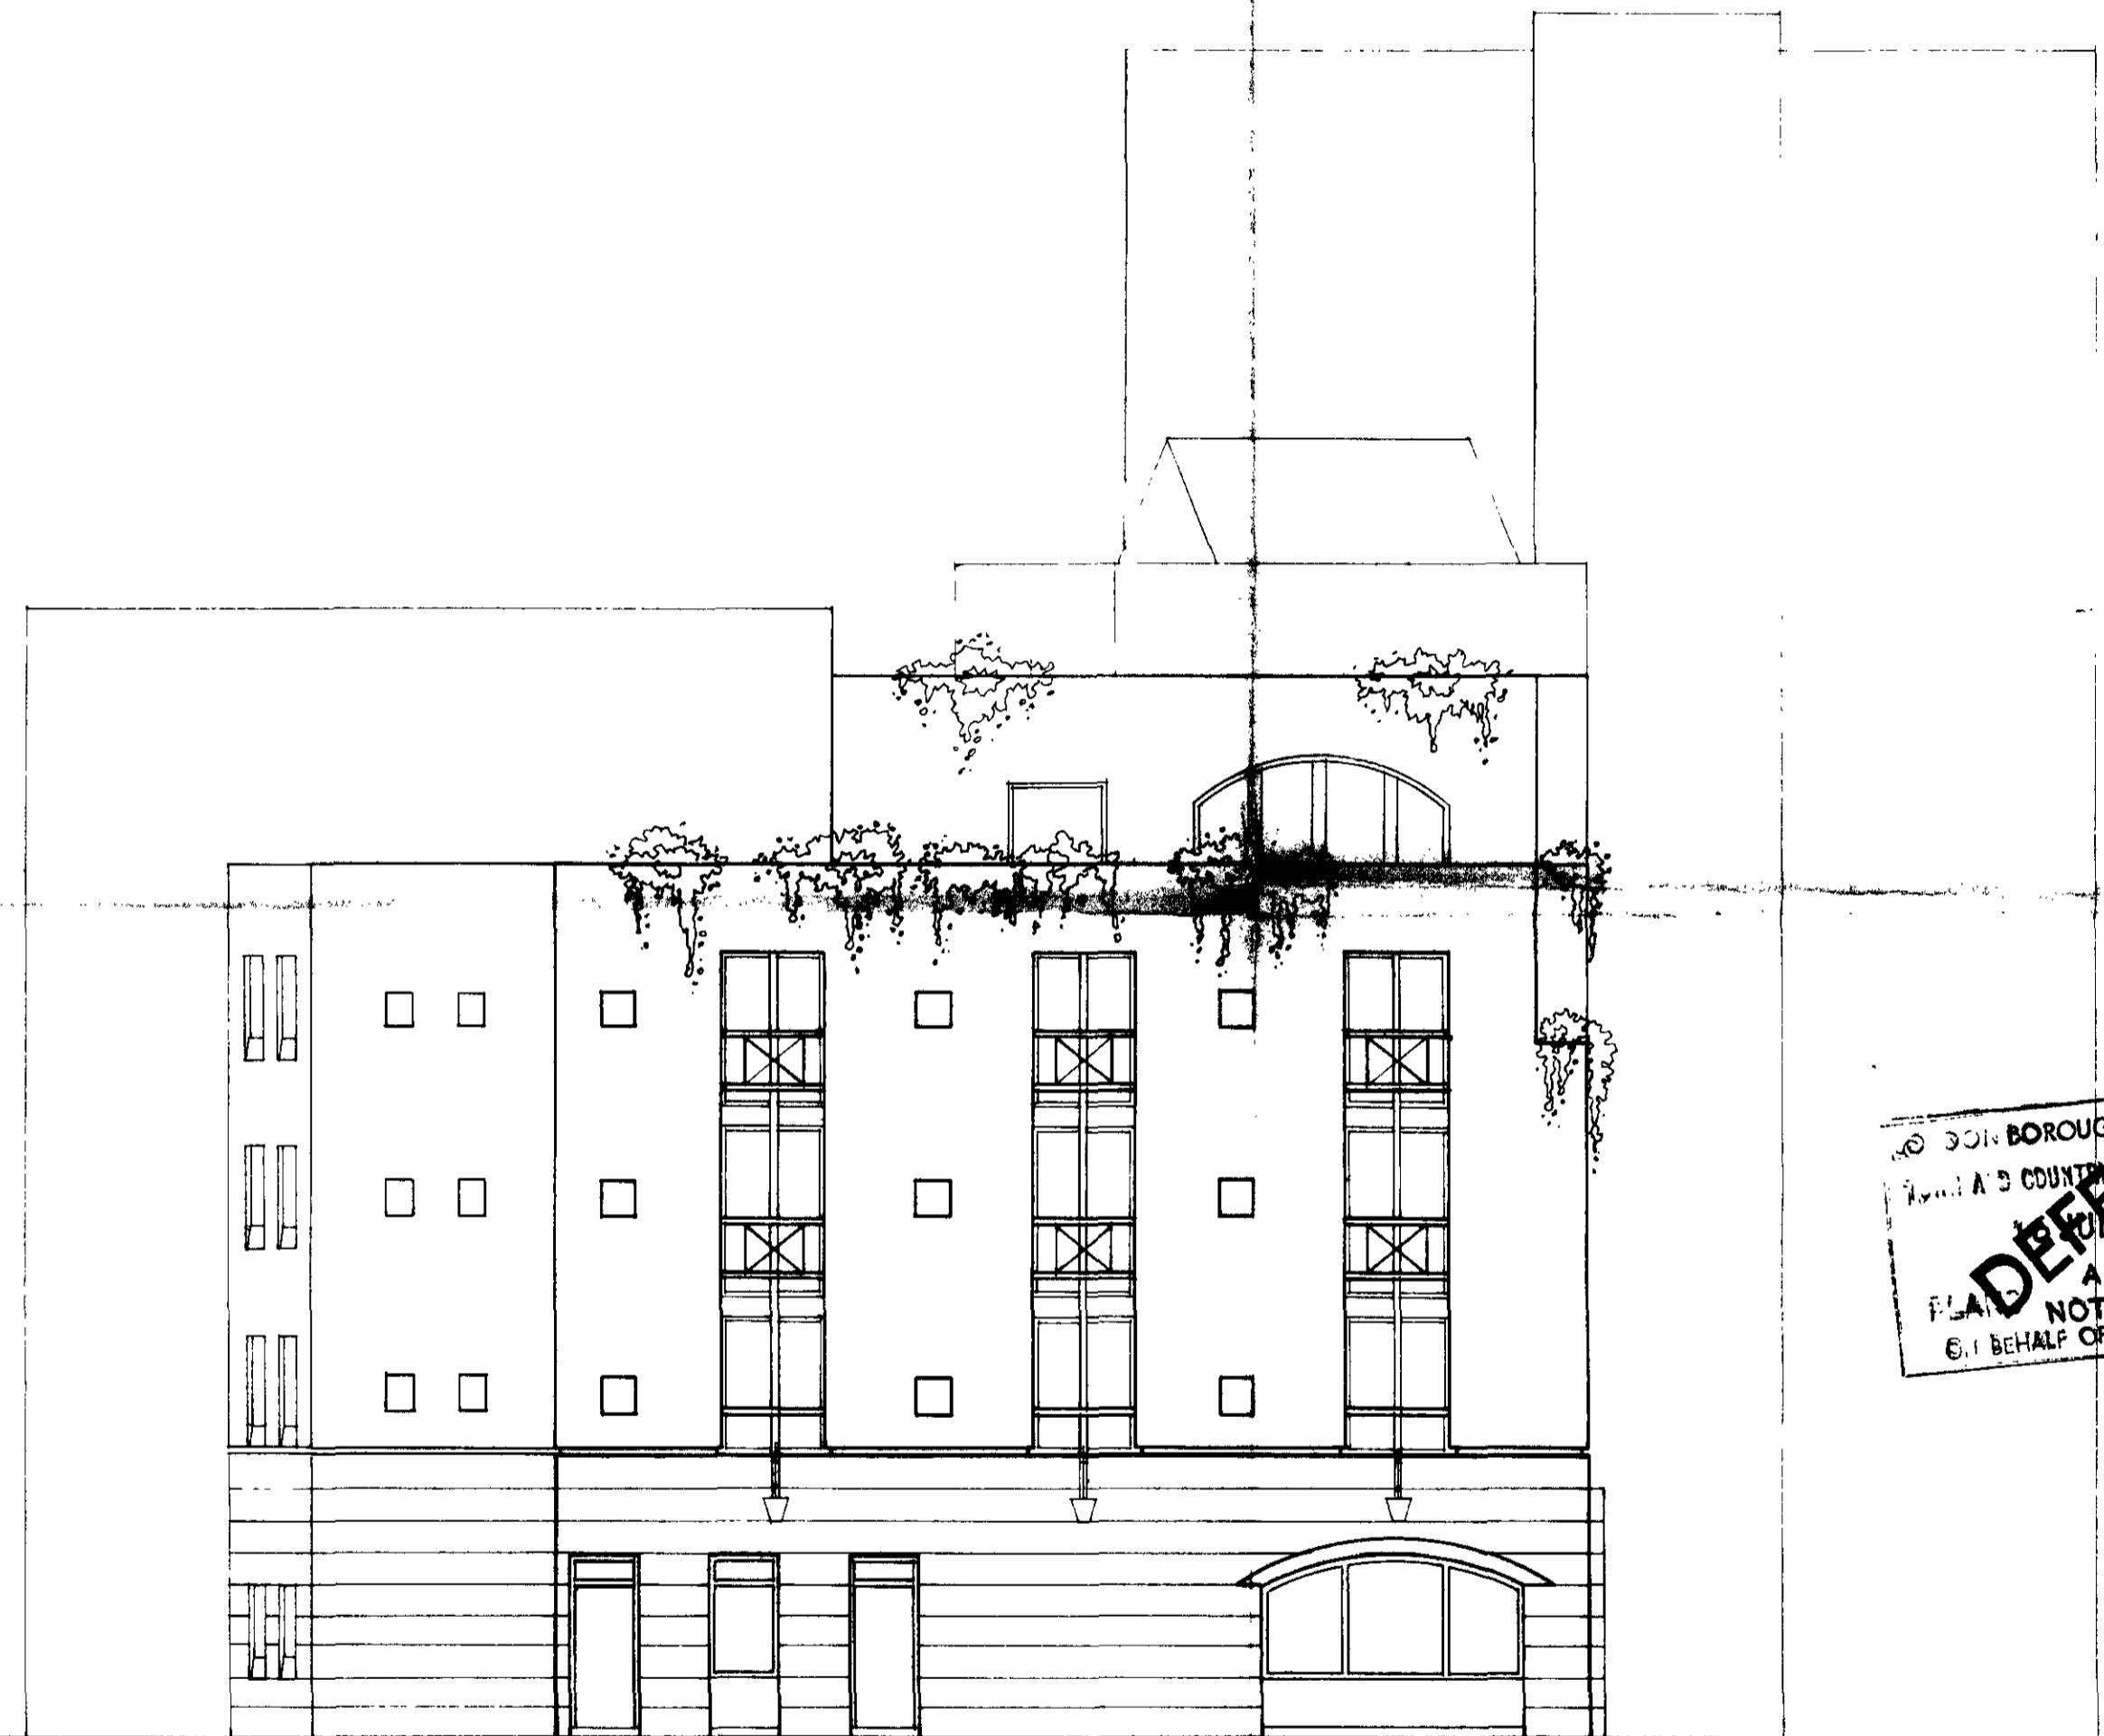

→
S/W
W/W

LONDON BOROUGH OF CAMDEN
TOWN AND COUNCILY PLANNING ACTS
APPROVED
PLANS NOT APPROVED
ON BEHALF OF THE COUNCIL
JUL 1987

TP 87 00538R4

~~HB 87 76001R4~~

LONDON BOROUGH OF CAMDEN
TOWN AND COUNCILY PLANNING ACTS
APPROVED
PLANS NOT APPROVED
ON BEHALF OF THE COUNCIL
3 SEP 1997

LONDON BOROUGH OF CAMDEN
PLANNING AND COMMUNICATIONS
DEPARTMENT
- 9 JUL 1987 (A.M.)
RECEIVED
ACK. REF. TO:

A.	OVERALL HEIGHT REDUCED	#.	5'87.
B.	ALTERED ELEVATION AT 4th FLOOR LEVEL.	#.	7'67.

Mk	Revision	Initial	Date
----	----------	---------	------

> Bradstone Brook
Shalford Guildford GU4 8HT
telephone 0483 68686
> 10-13 King Street
London WC2E 8HZ
telephone 01-240 2961
> 4 Fitzroy Place
Glasgow G1 7BH
telephone 0438 250066

**SCOTT
BROWN
& TURNER**
Architects and planning
consultants

LONDON BOROUGH OF CAMDEN
TOWN AND COUNCILY PLANNING ACTS
APPROVED
PLANS NOT APPROVED
ON BEHALF OF THE COUNCIL
AUG 1987

7 DIALS WC 2


Drawing title
**ELEVATION TO
TOWER COURT**

Scale 1:100

Drawn	Checked	Date NOV. 86
Job no 8081	Drawing no A11	Rev B

Figured dimensions only are to be taken from this drawing. All dimensions are to be checked on site before any work is put in hand. If in doubt, ask.

Notes

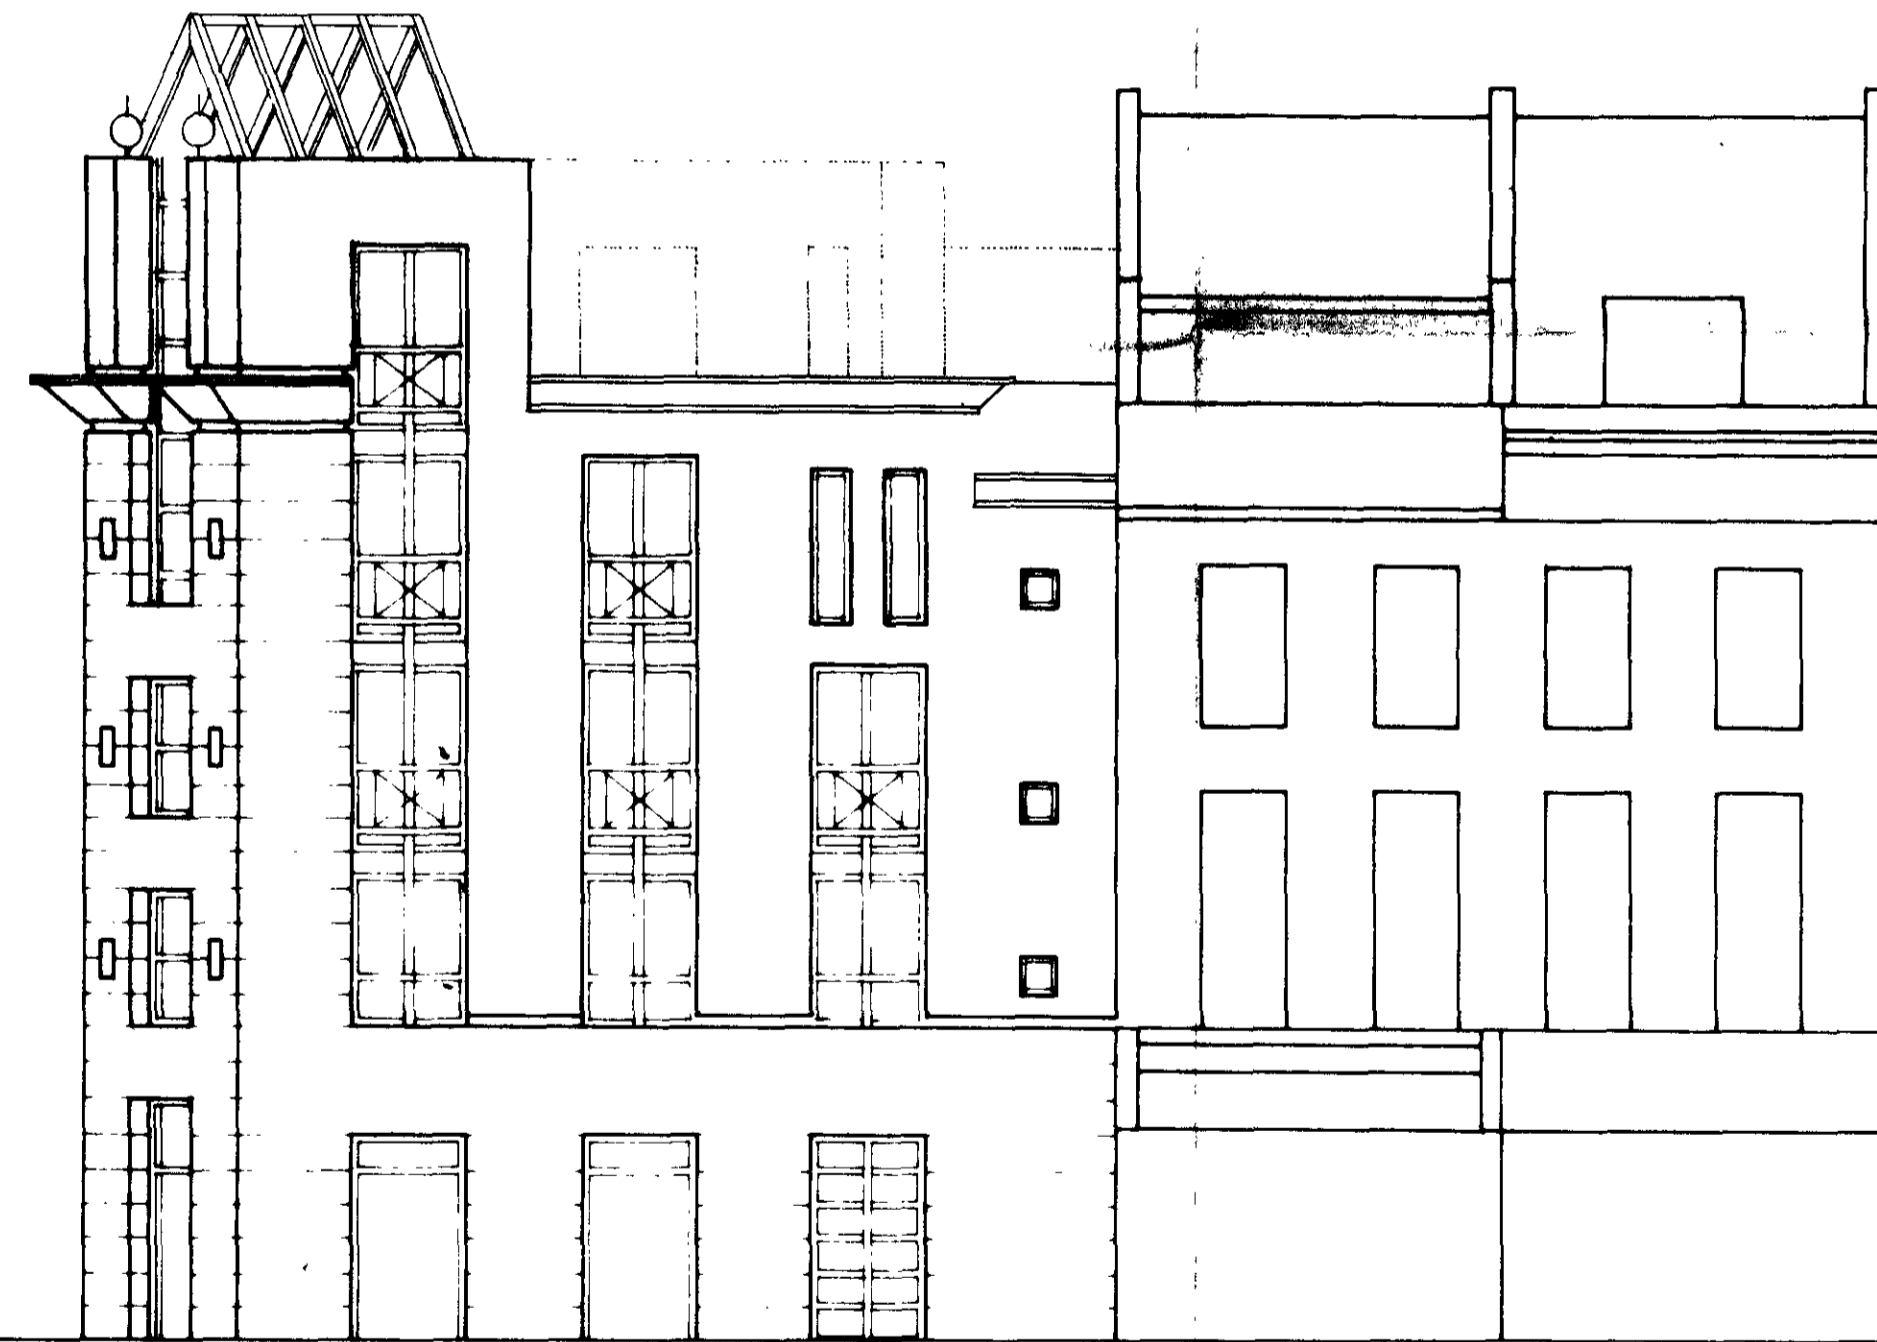

LONDON BOROUGH OF CANNERS
TOWN AND COUNTRY PLANNING ACTS
- 3 SEP 1997
APPROVED
PLANS NOT APPROVED
ON BEHALF OF THE COUNCIL

TP 87 005 J8 K6
HB ~~87 7009 TR6~~

A	OVERALL HEIGHT REDUCED PENETRATION ALTERED	#	5/87
B	NEW STEP INTRODUCED ON 4TH FLOOR STAIR AREA	#	7/87
C	MANIBARD ROOF REV'D	JMA	8-8-87
D	REVISED LEVEL '4'	#	8-8-87
E	REDUCED APES TO LOCKER	#	8-8-87

D: Bradstone Brook
Shelford Guildford GU4 8HT
telephone 0483 88886
D: 10-13 King Street
London WC2E 8HZ
telephone 01-240 2961
D: 4 Fizzroy Place
Glasgow G3 7RH
telephone 041 204 0086

**SCOT
BROOKS
& TUNER**
Architects and planning
consultants

Client's name
**TAYLOR WOODROW
PROPERTY CO. LTD.**
Job title
**TEXACO SITE
7 DIALS WC2**

Drawing title
ELEVATION TO EARLHAM ST.

Scale 1:100

Drawn	Checked	Date
Job no	Drawing no	Rev
8081	A 10	D.

Figured dimensions only are to be taken from this drawing. All dimensions are to be checked on site before any work is put in hand. If in doubt, ask.

Notes



LONDON BOROUGH OF CAMDEN
TOWN AND COUNTRY PLANNING ACTS
= 3 SEP 1997 APPROVED
PLANS NOT ALTERED
ON BEHALF OF THE COUNCIL

~~HR 87 7 009 TR8~~

TP 87 00538 R6

A	REDUCED OVERALL HEIGHT PENETRATION ALTERED	RE	5.87
B	REVISED PENETRATION	RE	7.87
C	REVISED LEVEL POINT	RE	8.87
D	REDUCED APPEX OF CORNER	RE	8.87

▷ Bradstone Brook
Shefford Guilford GU4 8HT
telephone 0463 66666
▷ 10-13 King Street
London WC2E 8HZ
telephone 01-240 2861
▷ 4 Fitzroy Place
Glasgow G3 7RH
telephone 041-204 0066



Client's name

TAYLOR WOODROW
PROPERTY CO LTD

Job title

TEXACO SITE
7 DIALS WC 2

Drawing title


7 DIALS ELEVATION

Scale 1:100

Drawn	Checked	Date
Job no	Drawing no	Rev
8061	A09	D-3

Figured dimensions only are to be taken from the drawing. All dimensions are to be checked on site before any work is put in hand. If in doubt, ask.

Notes

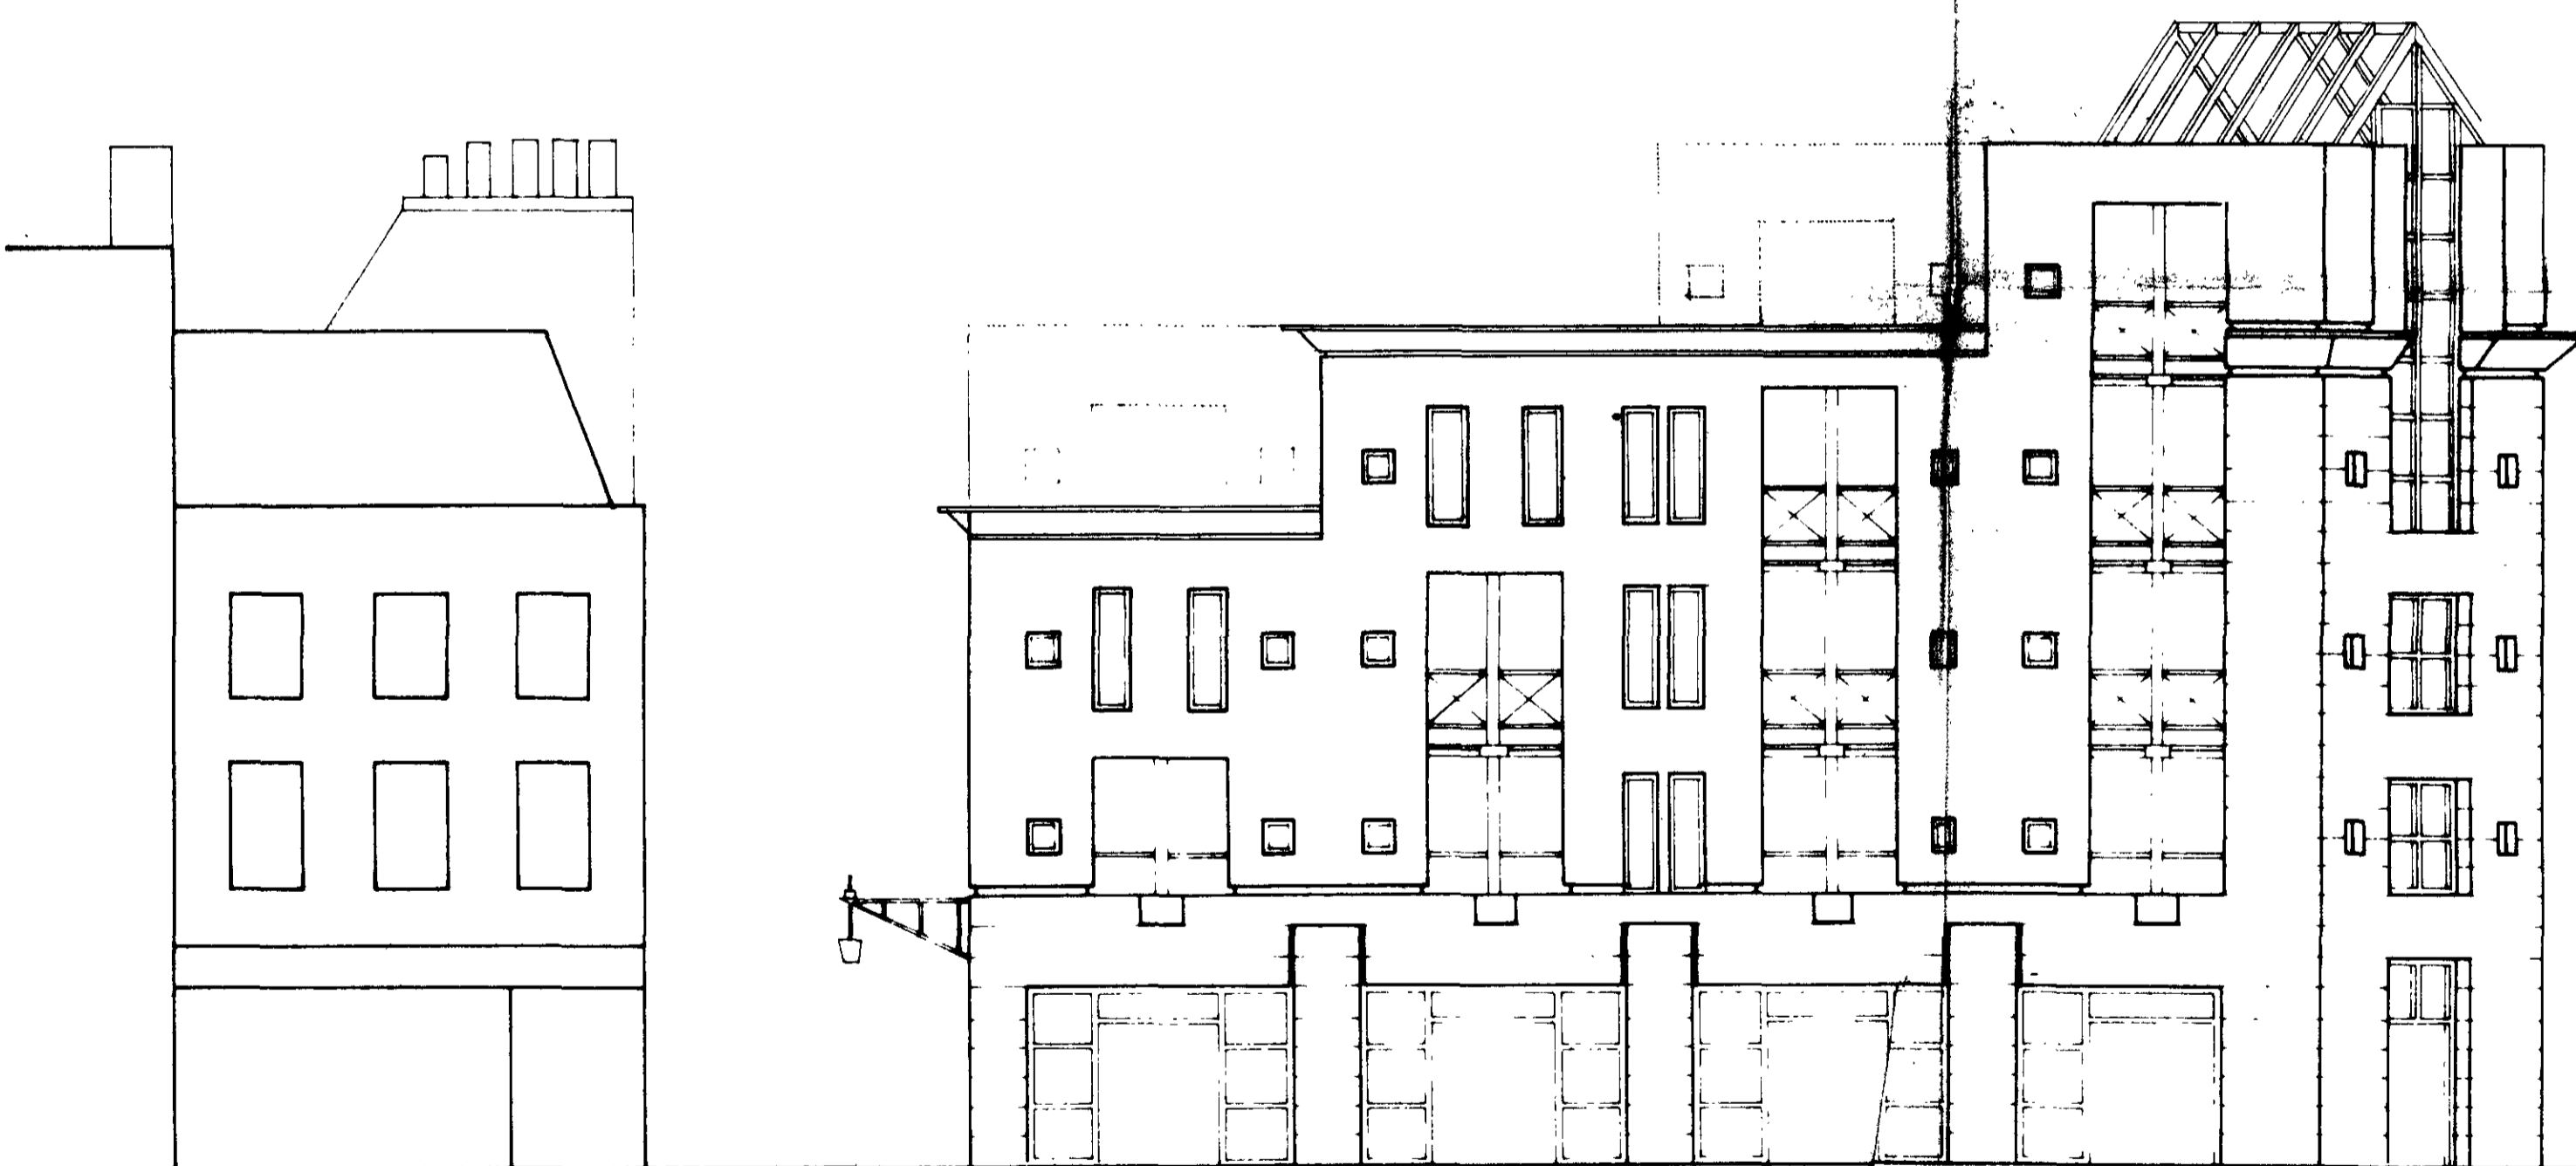

LONDON BOROUGH OF CAMDEN
TOWN AND COUNTRY PLANNING ACTS
3 SEP 1997
APPROVED
PLANS NOT APPROVED
ON BEHALF OF THE COUNCIL

TP 87 00538 R6
HB ~~8770091 R6~~

A	WINDOWS REVISED.		8.87
B	WINDOWS REVISED.		7.87
C	REVISED LEVEL 4'	RF	8.87
D	REDUCED APEX TO CORNER.	RF	8.87
	Revision	Initial	Date

D Bradstone Brook
Shalford Guildford GU4 8HT
telephone 0483 66666
D 10-13 King Street
London WC2E 8HZ
telephone 01 240 2981
D 4 Fitzroy Place
Glasgow G3 7RH
telephone 041 204 0066

SCOTT BROWNING & TURNER
Architects and planning consultants

Client's name
**TAYLOR WOODROW
PROPERTY CO. LTD.**
Job title
**TEXACO SITE
7 DIALS WC 2**


Drawing title
ELEVATION TO MONMOUTH ST

Scale 1:100

Drawn	Checked	Date
Job no.	Drawing no.	Rev.
8081	A08	D.

Figured dimensions only are to be taken from this drawing. All dimensions are to be checked on site before any work is put in hand. If in doubt, ask.

Notes

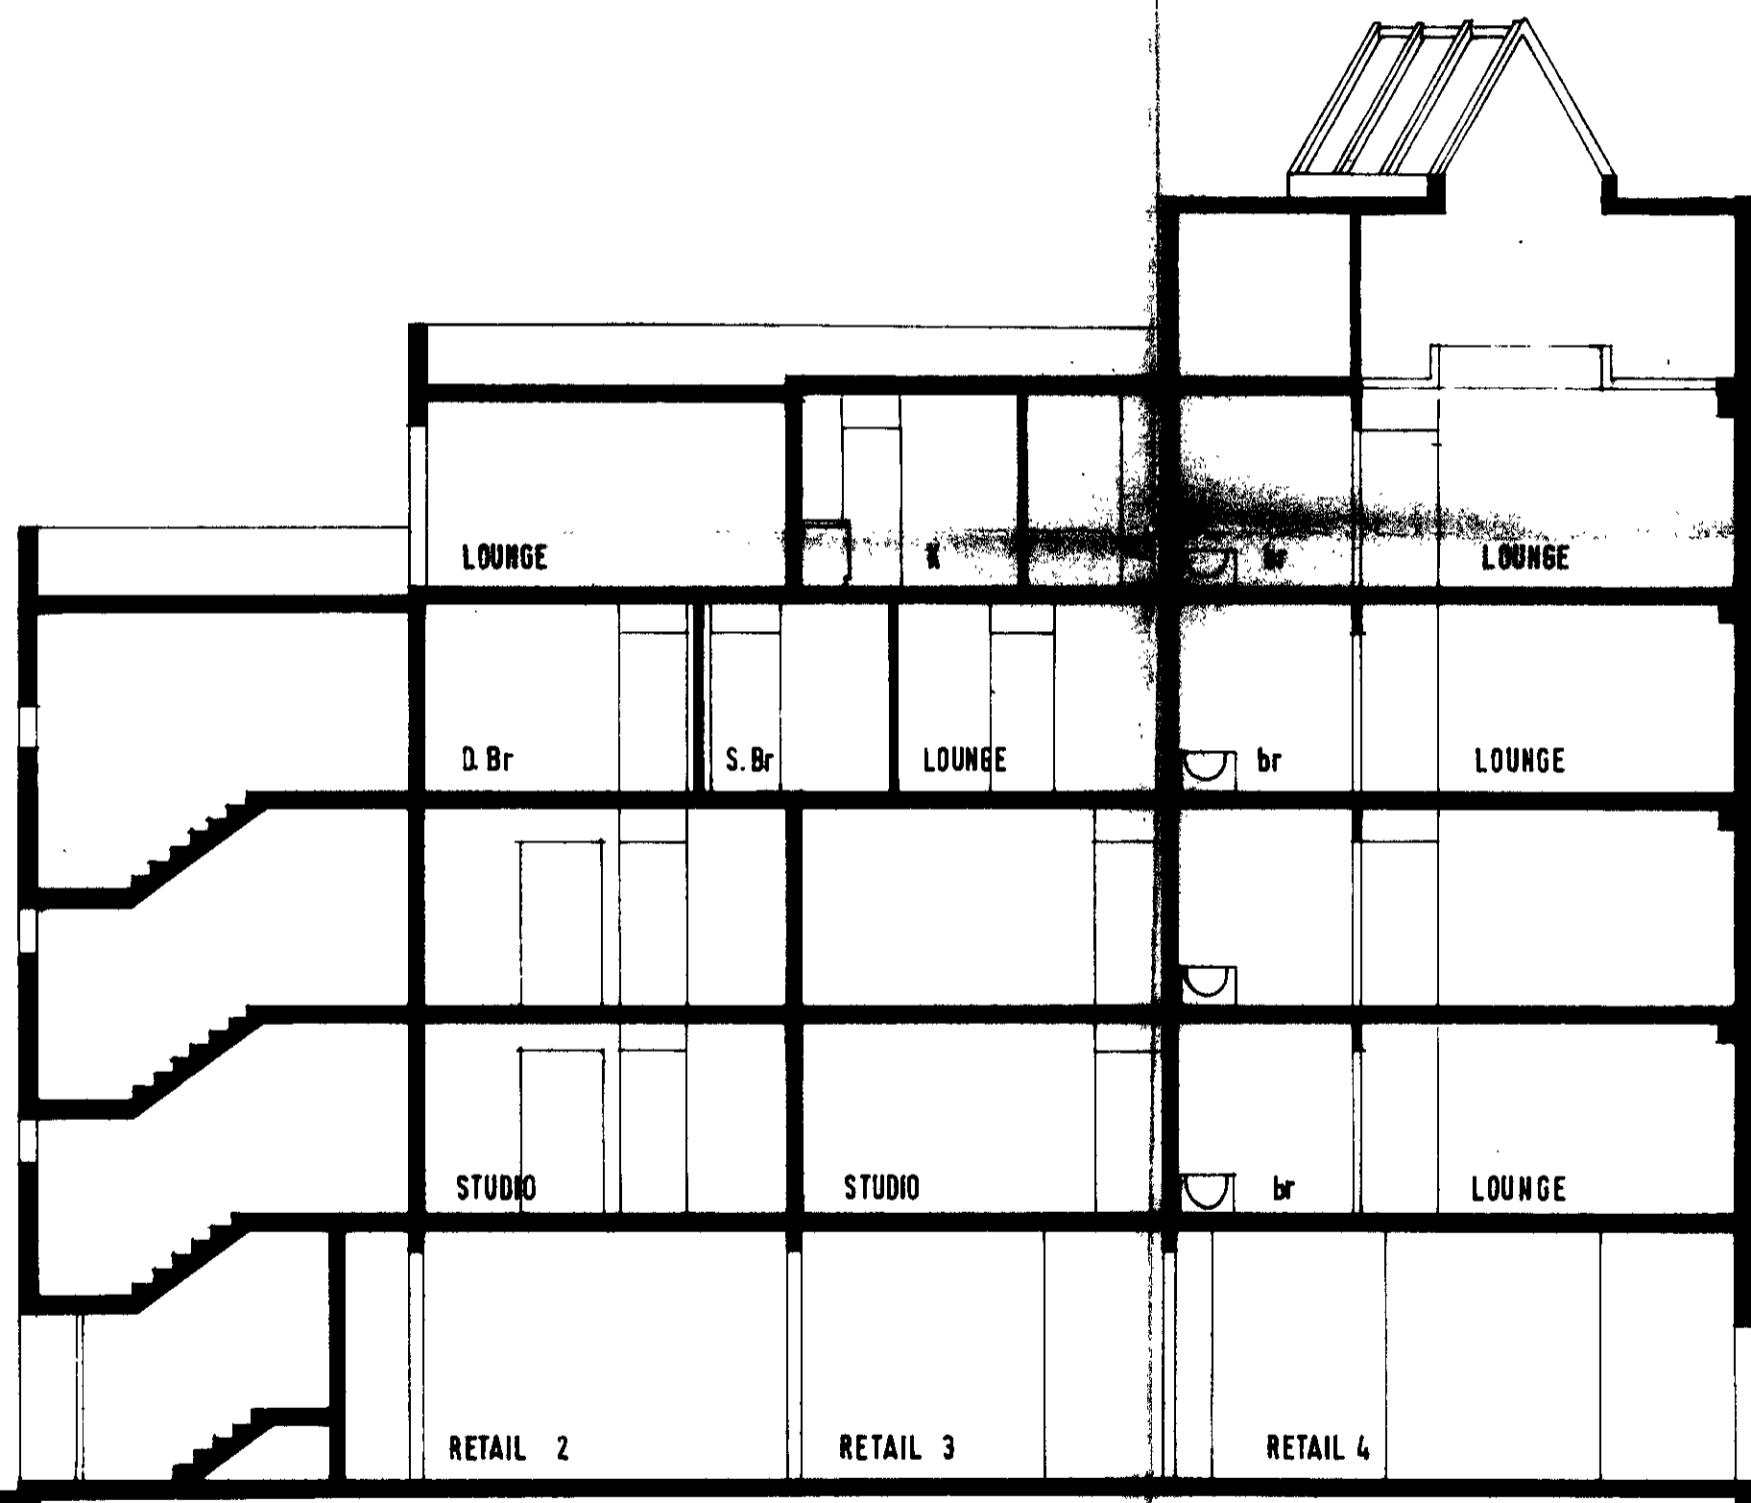

14 300

11 600

8 900

6 200

3 500

LONDON BOROUGH OF CAMDEN
TOWN AND COUNTRY PLANNING ACTS
16 JUL 1987
APPROVED
PLANS NOT APPROVED
ON BEHALF OF THE COUNCIL

TP 87 00538 R3

HP 8776604 R3

LONDON BOROUGH OF CAMDEN
TOWN AND COUNTRY PLANNING ACTS
3 SEP 1997
APPROVED
PLANS NOT APPROVED
ON BEHALF OF THE COUNCIL

LONDON BOROUGH OF CAMDEN
PLANNING AND COMMUNICATIONS
DEPARTMENT
- 3 JUL 1987 (A.M.)
RECEIVED
ACK.

A.	REDUCED OVERALL HEIGHT INTRODUCED MEZZANINE	JK	5'87

Mk	Revision	Initial	Date

▷ Bradstone Brook
Shaftord Guildford GU4 8HT
telephone 0483 68686
▷ 10-13 King Street
London WC2E 8HZ
telephone 01-240 2961
▷ 4 Fitzroy Place
Glasgow G3 7RH
telephone 041-204 0066

**SCOTT
BROWN RIGG
& TURNER**
Architects and planning
consultants

Client's name
**TAYLOR WOODROW
PROPERTY CO. LTD**


LONDON BOROUGH OF CAMDEN
TOWN AND COUNTRY PLANNING ACTS
7 DAY EVERETT
6 AUG 1987
SECTION PLANS NOT APPROVED
ON BEHALF OF THE COUNCIL

Scale 1:100

Drawn	Checked	Date
		NOV 86
Job no	Drawing no	Rev
8081	A 07	A

Figured dimensions only are to be taken from this drawing. All dimensions are to be checked on site before any work is put in hand. If in doubt, ask.

Notes

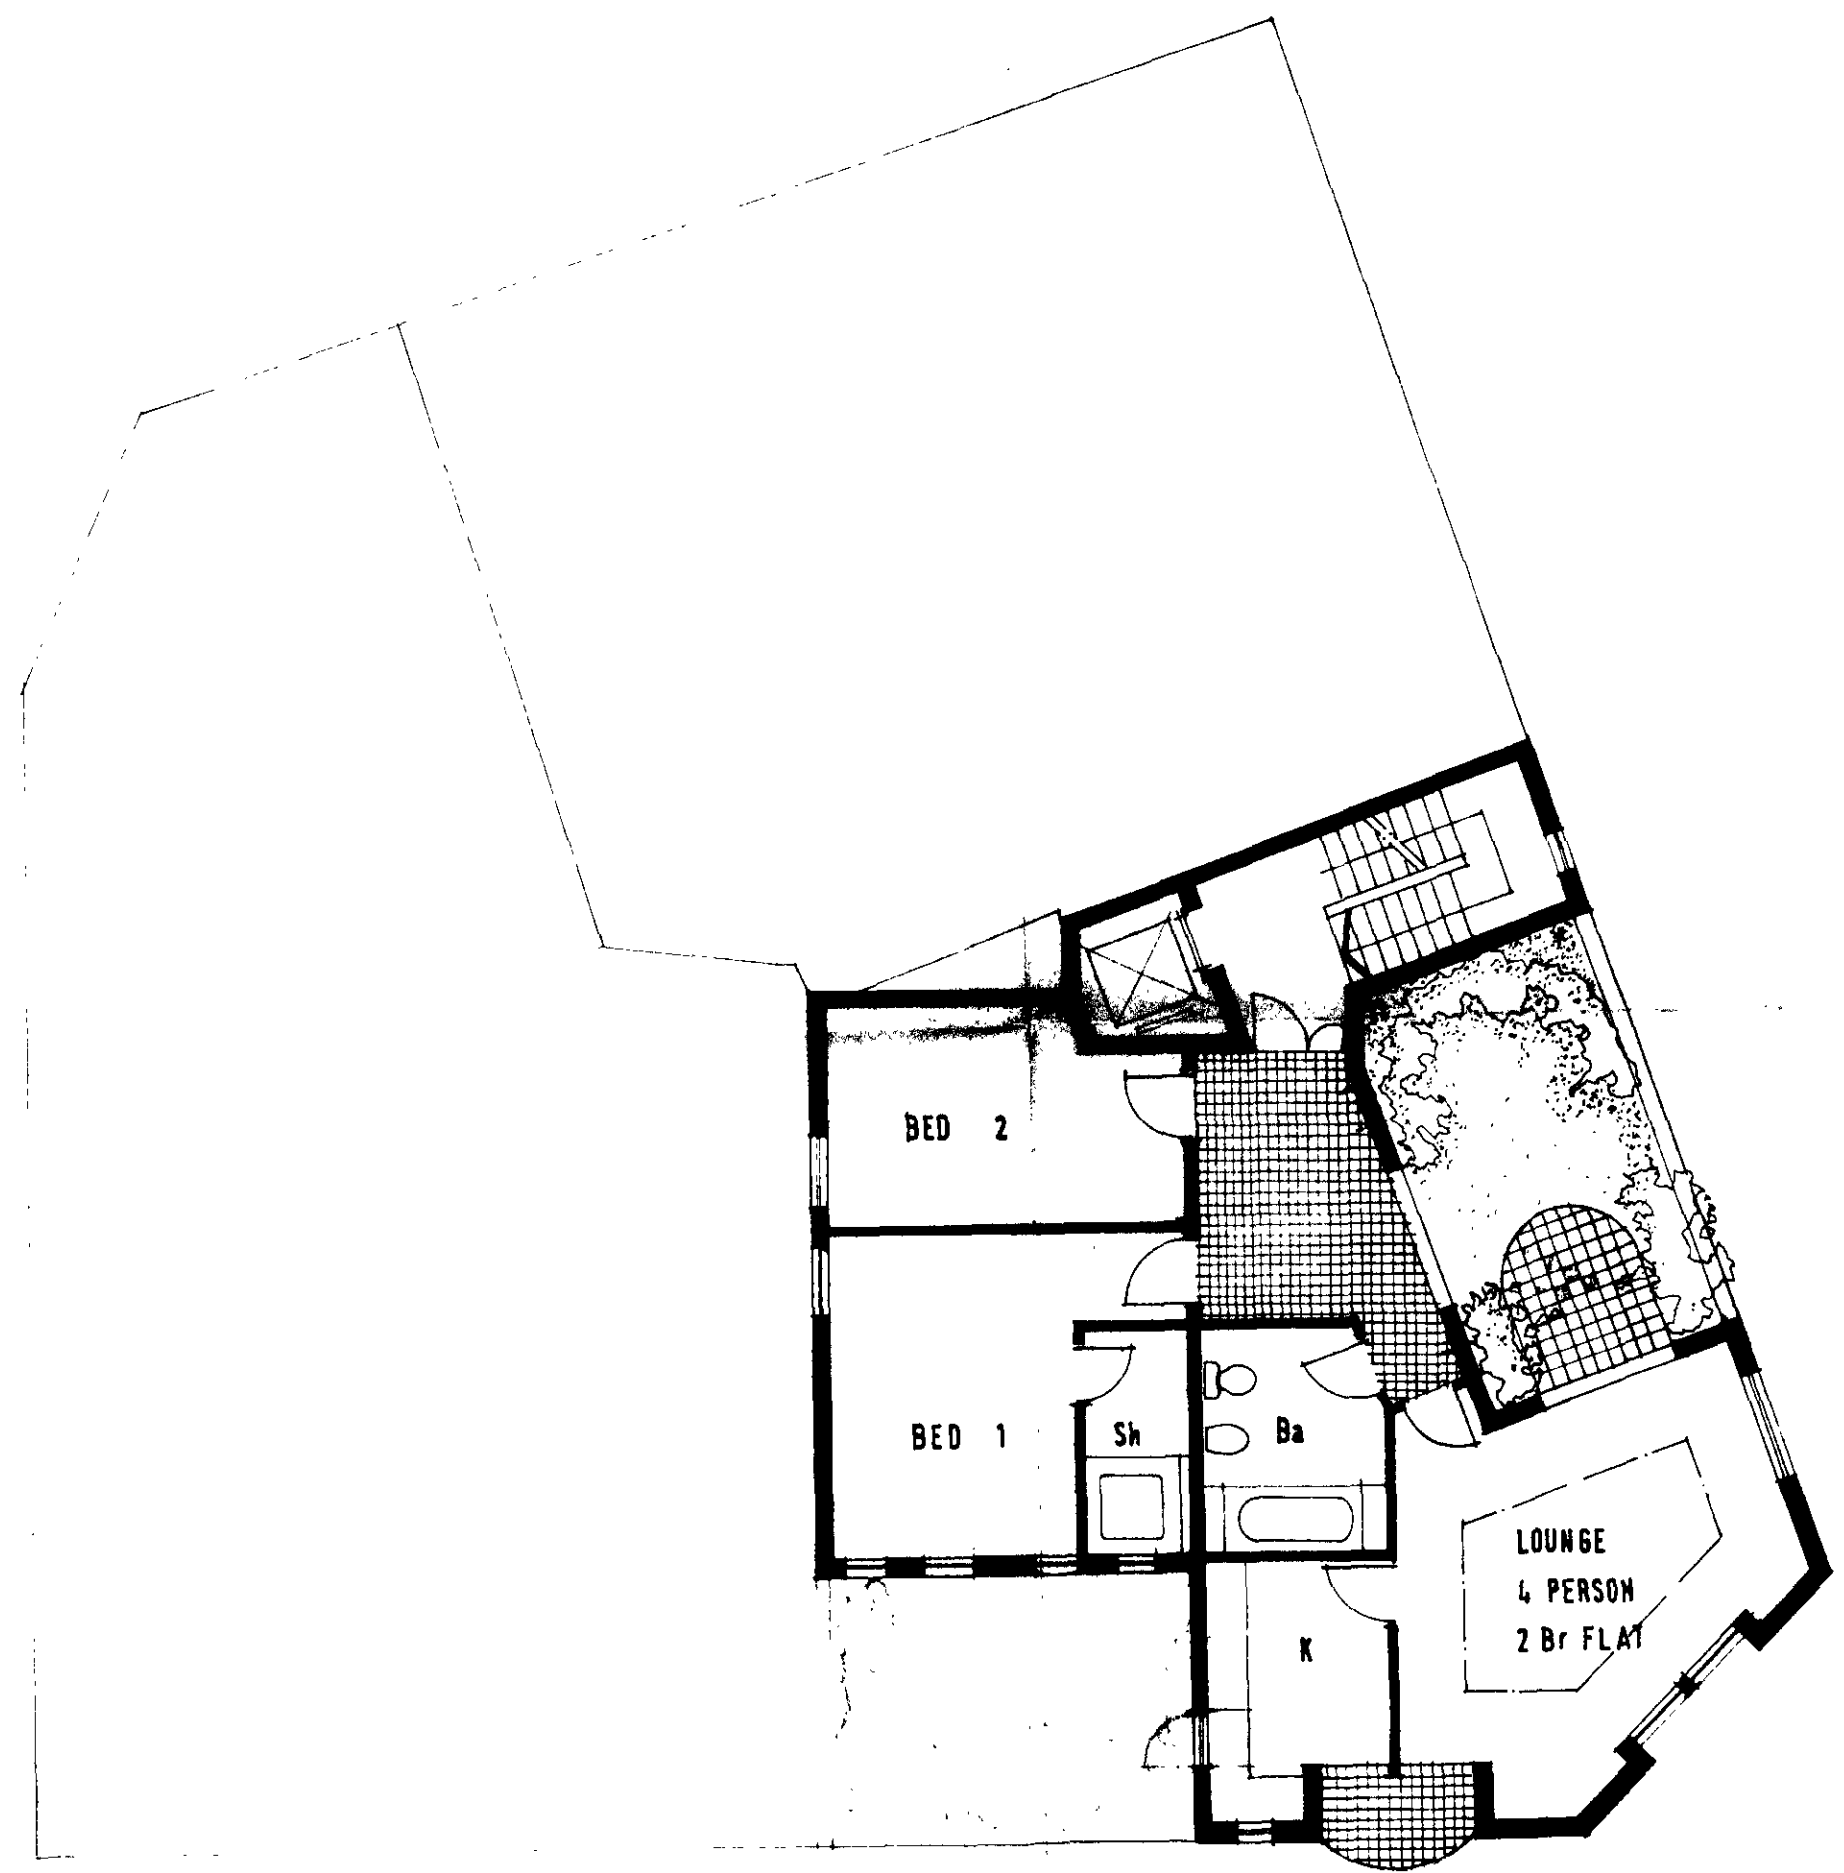

LONDON BOROUGH OF CAMDEN
TOWN AND COUNTRY PLANNING ACTS
3 SEP 1997
APPROVED
~~PLANS NOT APPROVED~~
ON BEHALF OF THE COUNCIL

TP0700538R6
~~HB0770091R6~~

Mk	Revision	Initial	Date
C	REVISION 4/11/97	FE	8/87

▷ Bradstone Brook
Shalford Guildford GU4 8HT
telephone 0483 68686
▷ 10-13 King Street
London WC2E 8HZ
telephone 01-240 2961
▷ 4 Fitzroy Place
Glasgow G3 7RH
telephone 041-204 0066

**SCOTT
BROWN RIGG
& TURNER**
Architects and planning
consultants

Client's name
**TAYLOR WOODROW
PROPERTY CO LTD**
Job title
**TEXACO SITE
7 DIALS WC 2**


Drawing title
FOURTH FLOOR PLAN

Scale **1 100**

Drawn	Checked	Date
J		11/1/97
Job no	Drawing no	Rev
8081	A5	C

Figured dimensions only are to be taken from this drawing. All dimensions are to be checked on site before any work is put in hand. If in doubt, ask.

Notes

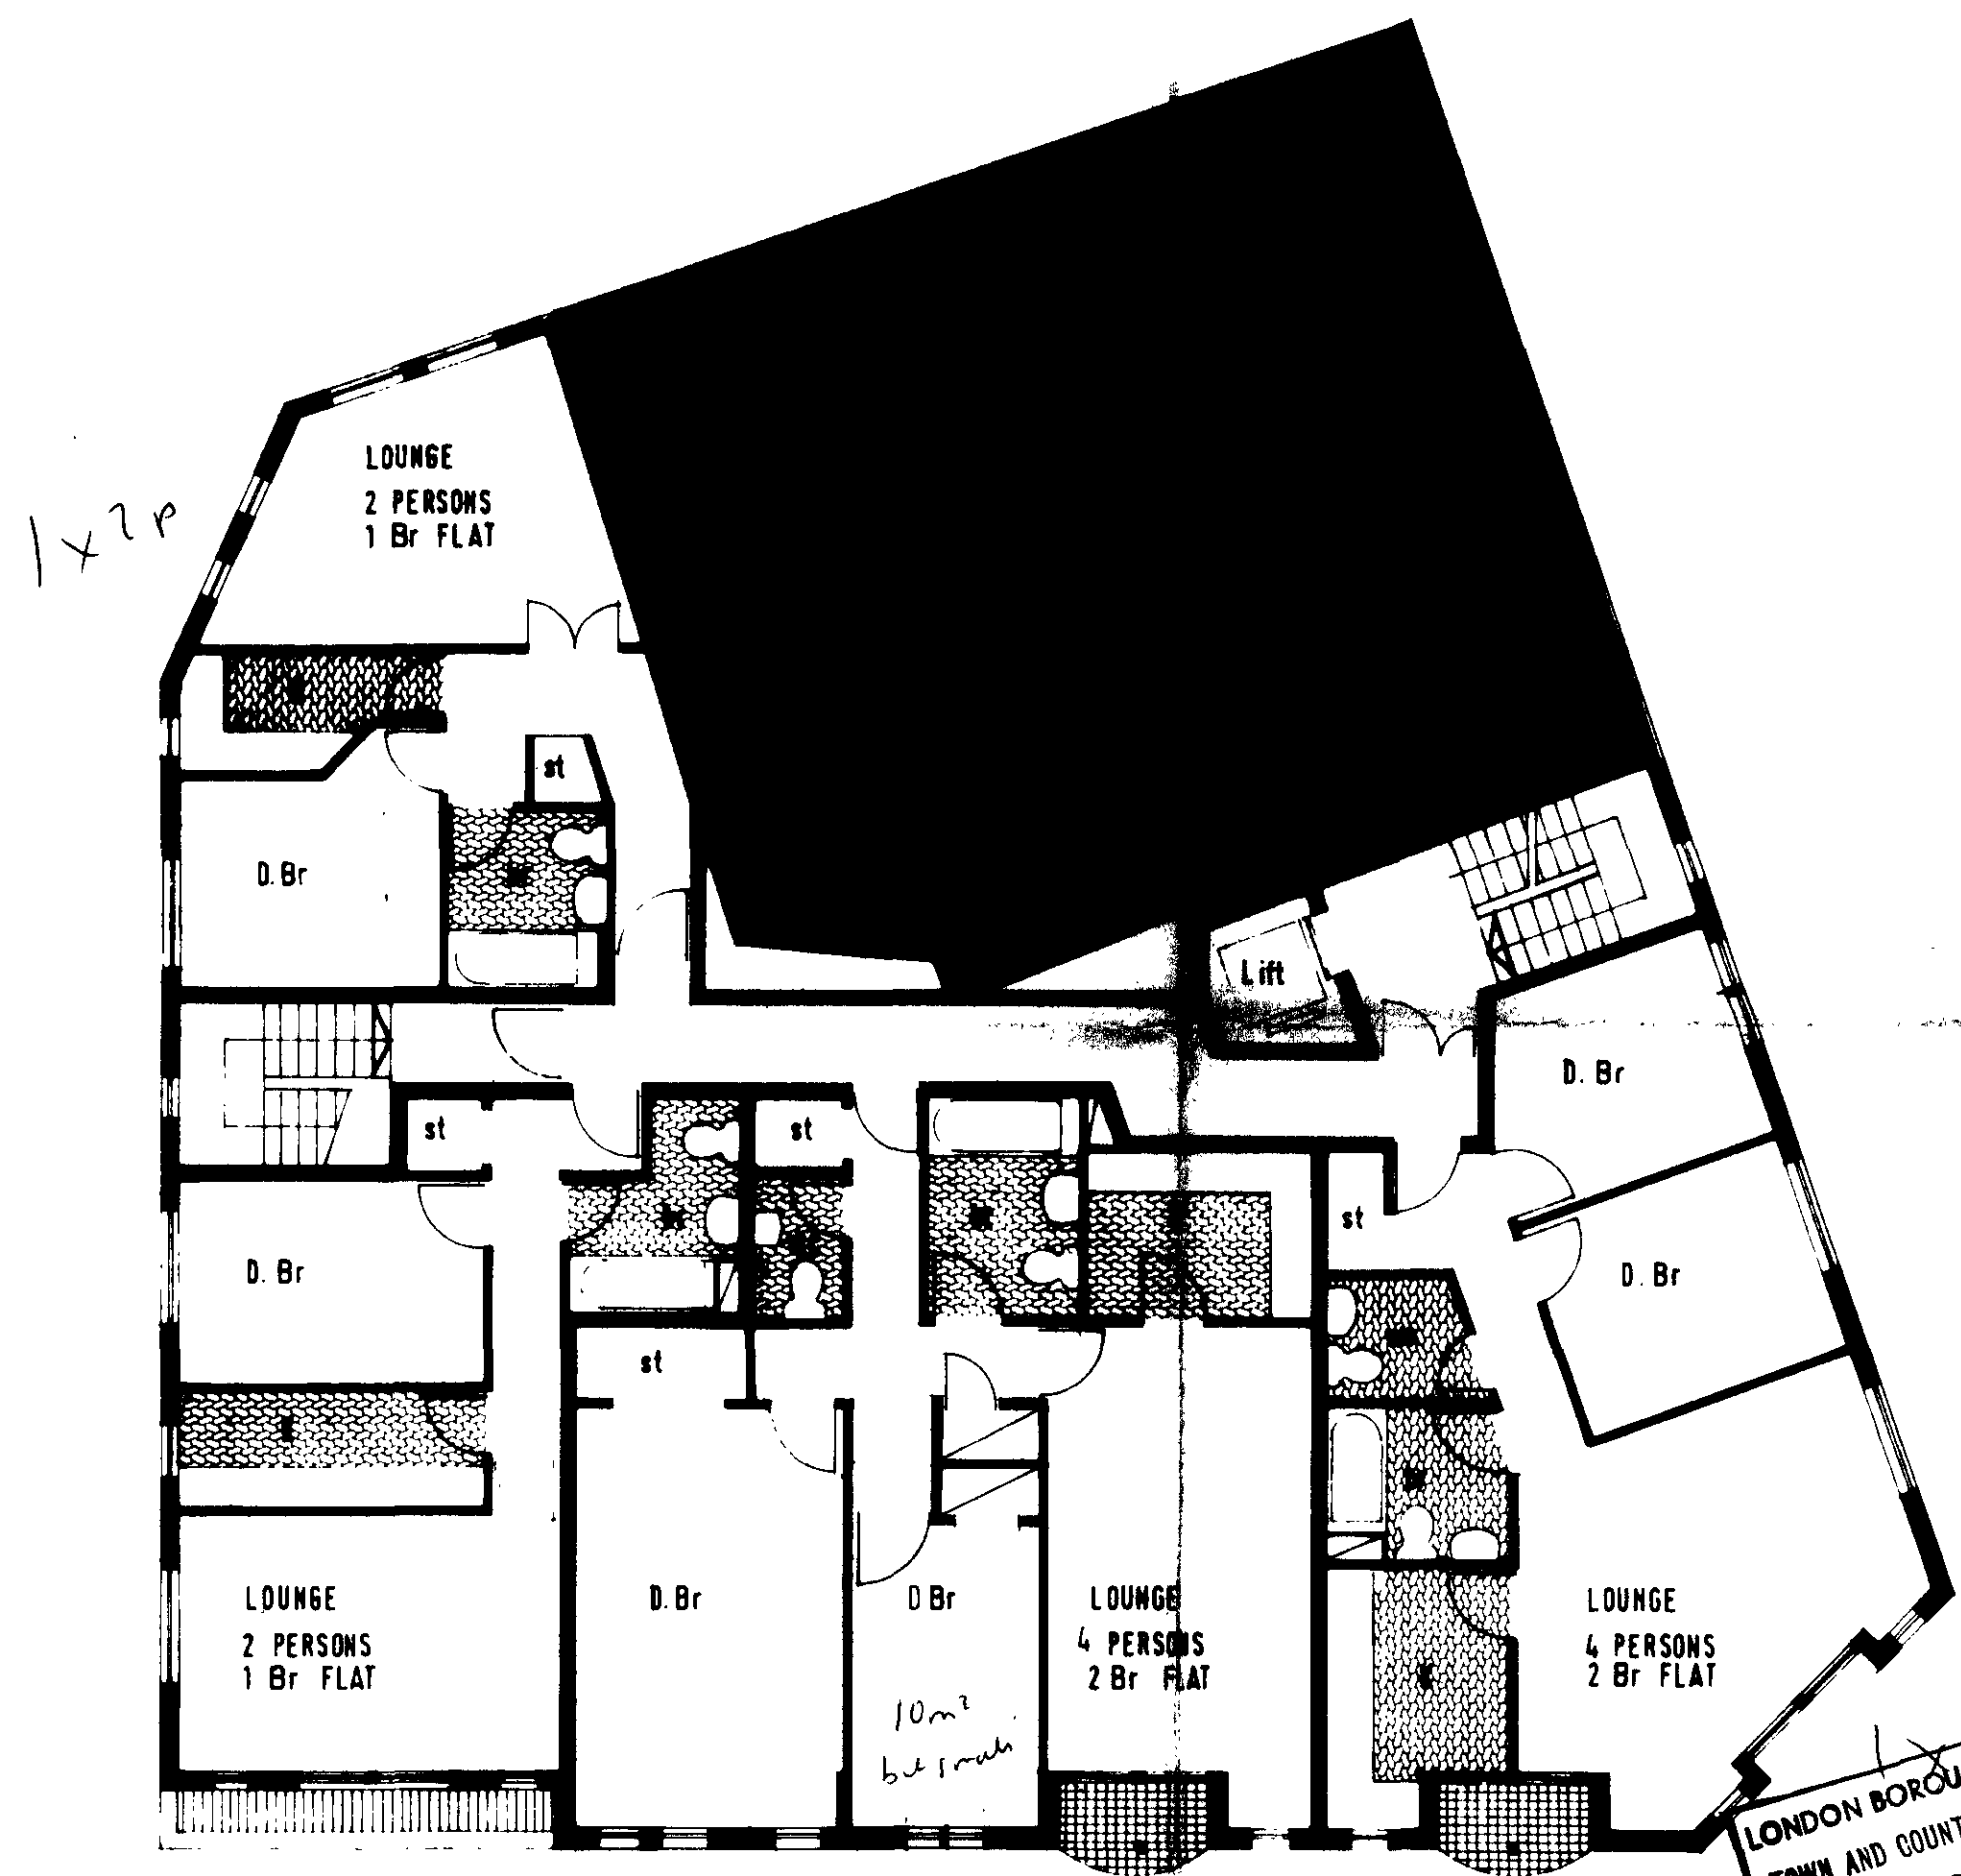

LONDON BOROUGH OF CAMDEN
TOWN AND COUNTRY PLANNING ACTS
DEFERRED
APPROVED
PLANS NOT APPROVED
ON BEHALF OF THE COUNCIL

LONDON BOROUGH OF CAMDEN
TOWN AND COUNTRY PLANNING ACTS
- 3 SEP 1997
APPROVED
PLANS NOT APPROVED
ON BEHALF OF THE COUNCIL

T 87 00538 R4

LONDON BOROUGH OF CAMDEN
PLANNING AND COMMUNICATIONS
DEPARTMENT
- 9 JUL 1987 (A.M.)
RECEIVED
ACK. REF. TO

Rev	Revision	Initial	Date
A	CHANGING 3 PERSON FLAT TO 4 PERSON FLAT		5/87
B	INTERNAL LAYOUT AMENDMENTS WINDOW REVISION		July 87
C	INCORPORATED 12' WIDENING TO FRONT FLAT LOUNGE AND REAR FLAT LOUNGE		July 87

D. Bradstone Brook
Shalford, Guildford GU4 8HT
telephone 0483 68886

D. 10-13 King Street
London WC2E 8JF
telephone 01-240 2261

D. 4 Fitzroy Place
Glasgow G3 7JF
telephone 01-226 1056

SCOTT BROWNRIGG & TURNER
LONDON BOROUGH OF CAMDEN
TOWN AND COUNTRY PLANNING ACTS
DEFERRED
APPROVED
PLANS NOT APPROVED
ON BEHALF OF THE COUNCIL
16 AUG 1987


Client's name
TAYLOR WOODROW PROPERTY CO. LTD

Job title
TEXACO SITE 7 DIALS WC 2

Drawing title
THIRD FLOOR PLAN

Scale 1:100

Drawn	Checked	Date
		NOV. 86
Job no	Drawing no	Rev
8081	A4	C

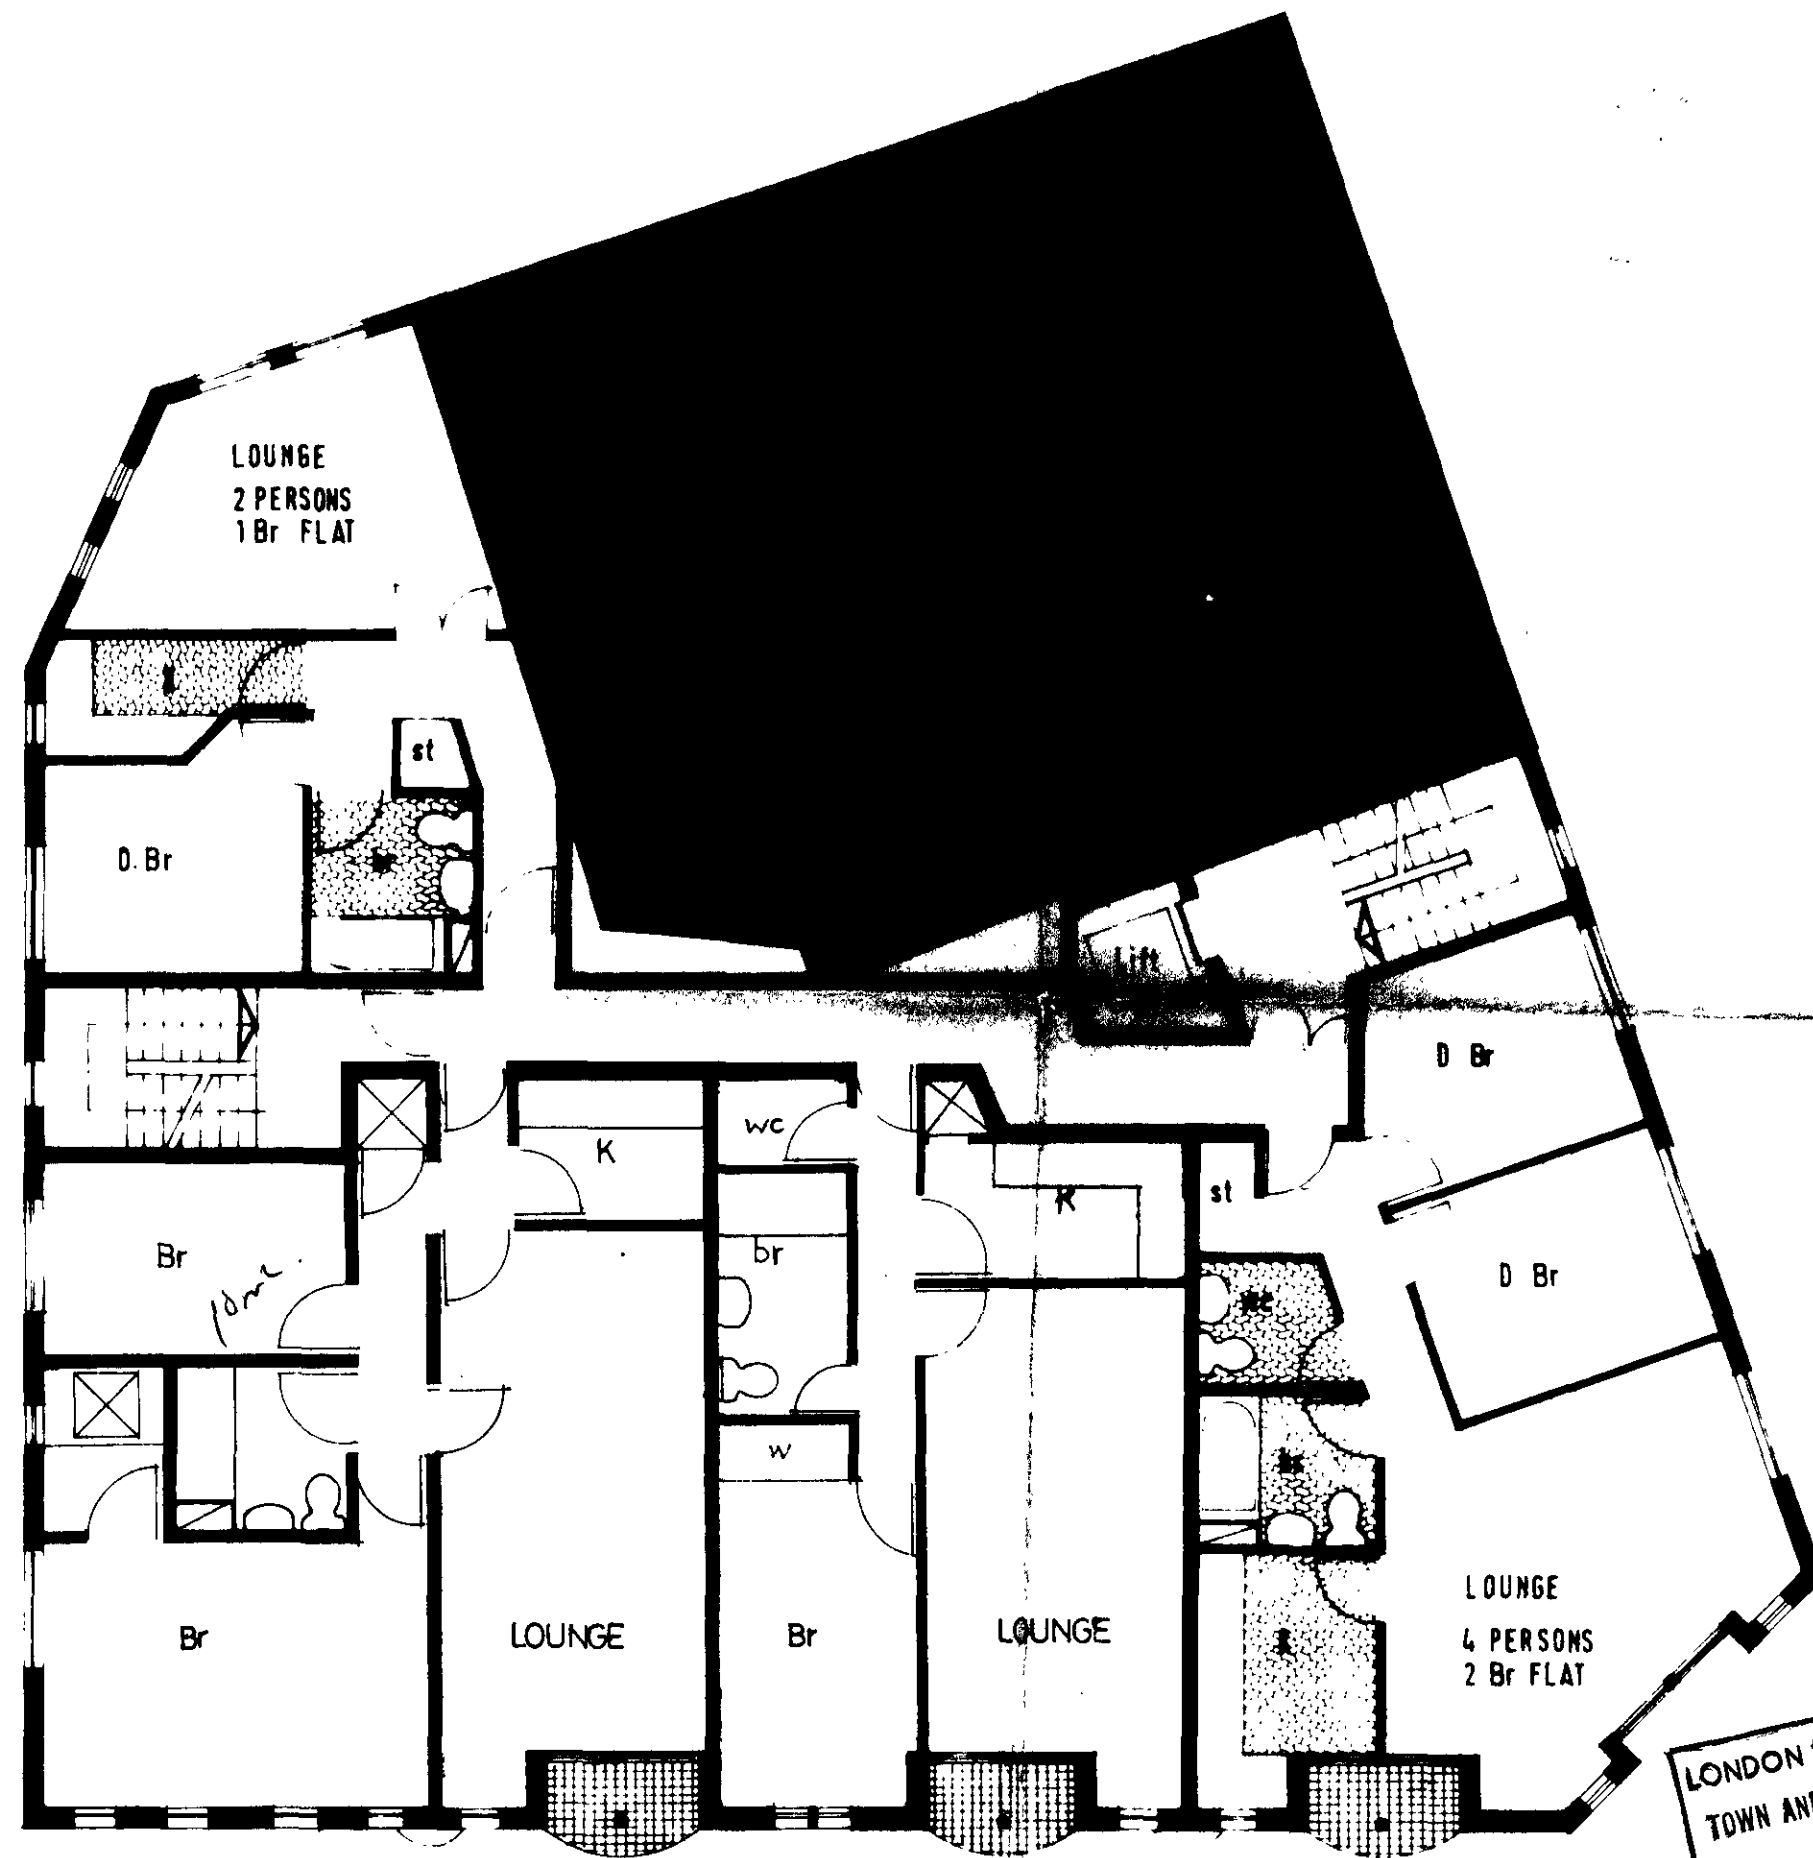

Figured dimensions only are to be taken from this drawing. All dimensions are to be checked on site before any work is put in hand. If in doubt, ask.

Notes

A.	INCORPORATING 2 LOUNGES TO FRONT FLAT LOUNGES AND REAR FLAT LOUNGE	#.	July 87

LONDON BOROUGH OF CAMDEN
TOWN AND COUNTRY PLANNING ACTS
1 JUL 1987
DEFERRED
APPROVED
PLANS NOT APPROVED
ON BEHALF OF THE COUNCIL

LONDON BOROUGH OF CAMDEN
TOWN AND COUNTRY PLANNING ACTS
3 SEP 1987
DEFERRED
APPROVED
PLANS NOT APPROVED
ON BEHALF OF THE COUNCIL

LONDON BOROUGH OF CAMDEN
TOWN AND COUNTRY PLANNING ACTS
6 AUG 1987
DEFERRED
APPROVED
PLANS NOT APPROVED
ON BEHALF OF THE COUNCIL

LONDON BOROUGH OF CAMDEN
PLANNING AND COMMUNICATIONS
DEPARTMENT
9 OCT 1987 (A.M.)
RECEIVED
ACK. REF. TO:

SCOTT BROWN RIGG & TURNER
Architects and planning consultants

1. Bradstone House
Shalford Road WC2 1 4 4
Telephone 0483 68686


TEXACO SITE
7 DIALS WC2

Drawing title
SECOND FLOOR PLAN

Scale 1:100		
Drawn	Checked	Date NOV 86
Job no. 8081	Drawing no. A3 ⁱⁱ	Rev. A.

Figured dimensions only are to be taken from this drawing. All dimensions are to be checked on site before any work is put in hand. If in doubt, ask.

Notes

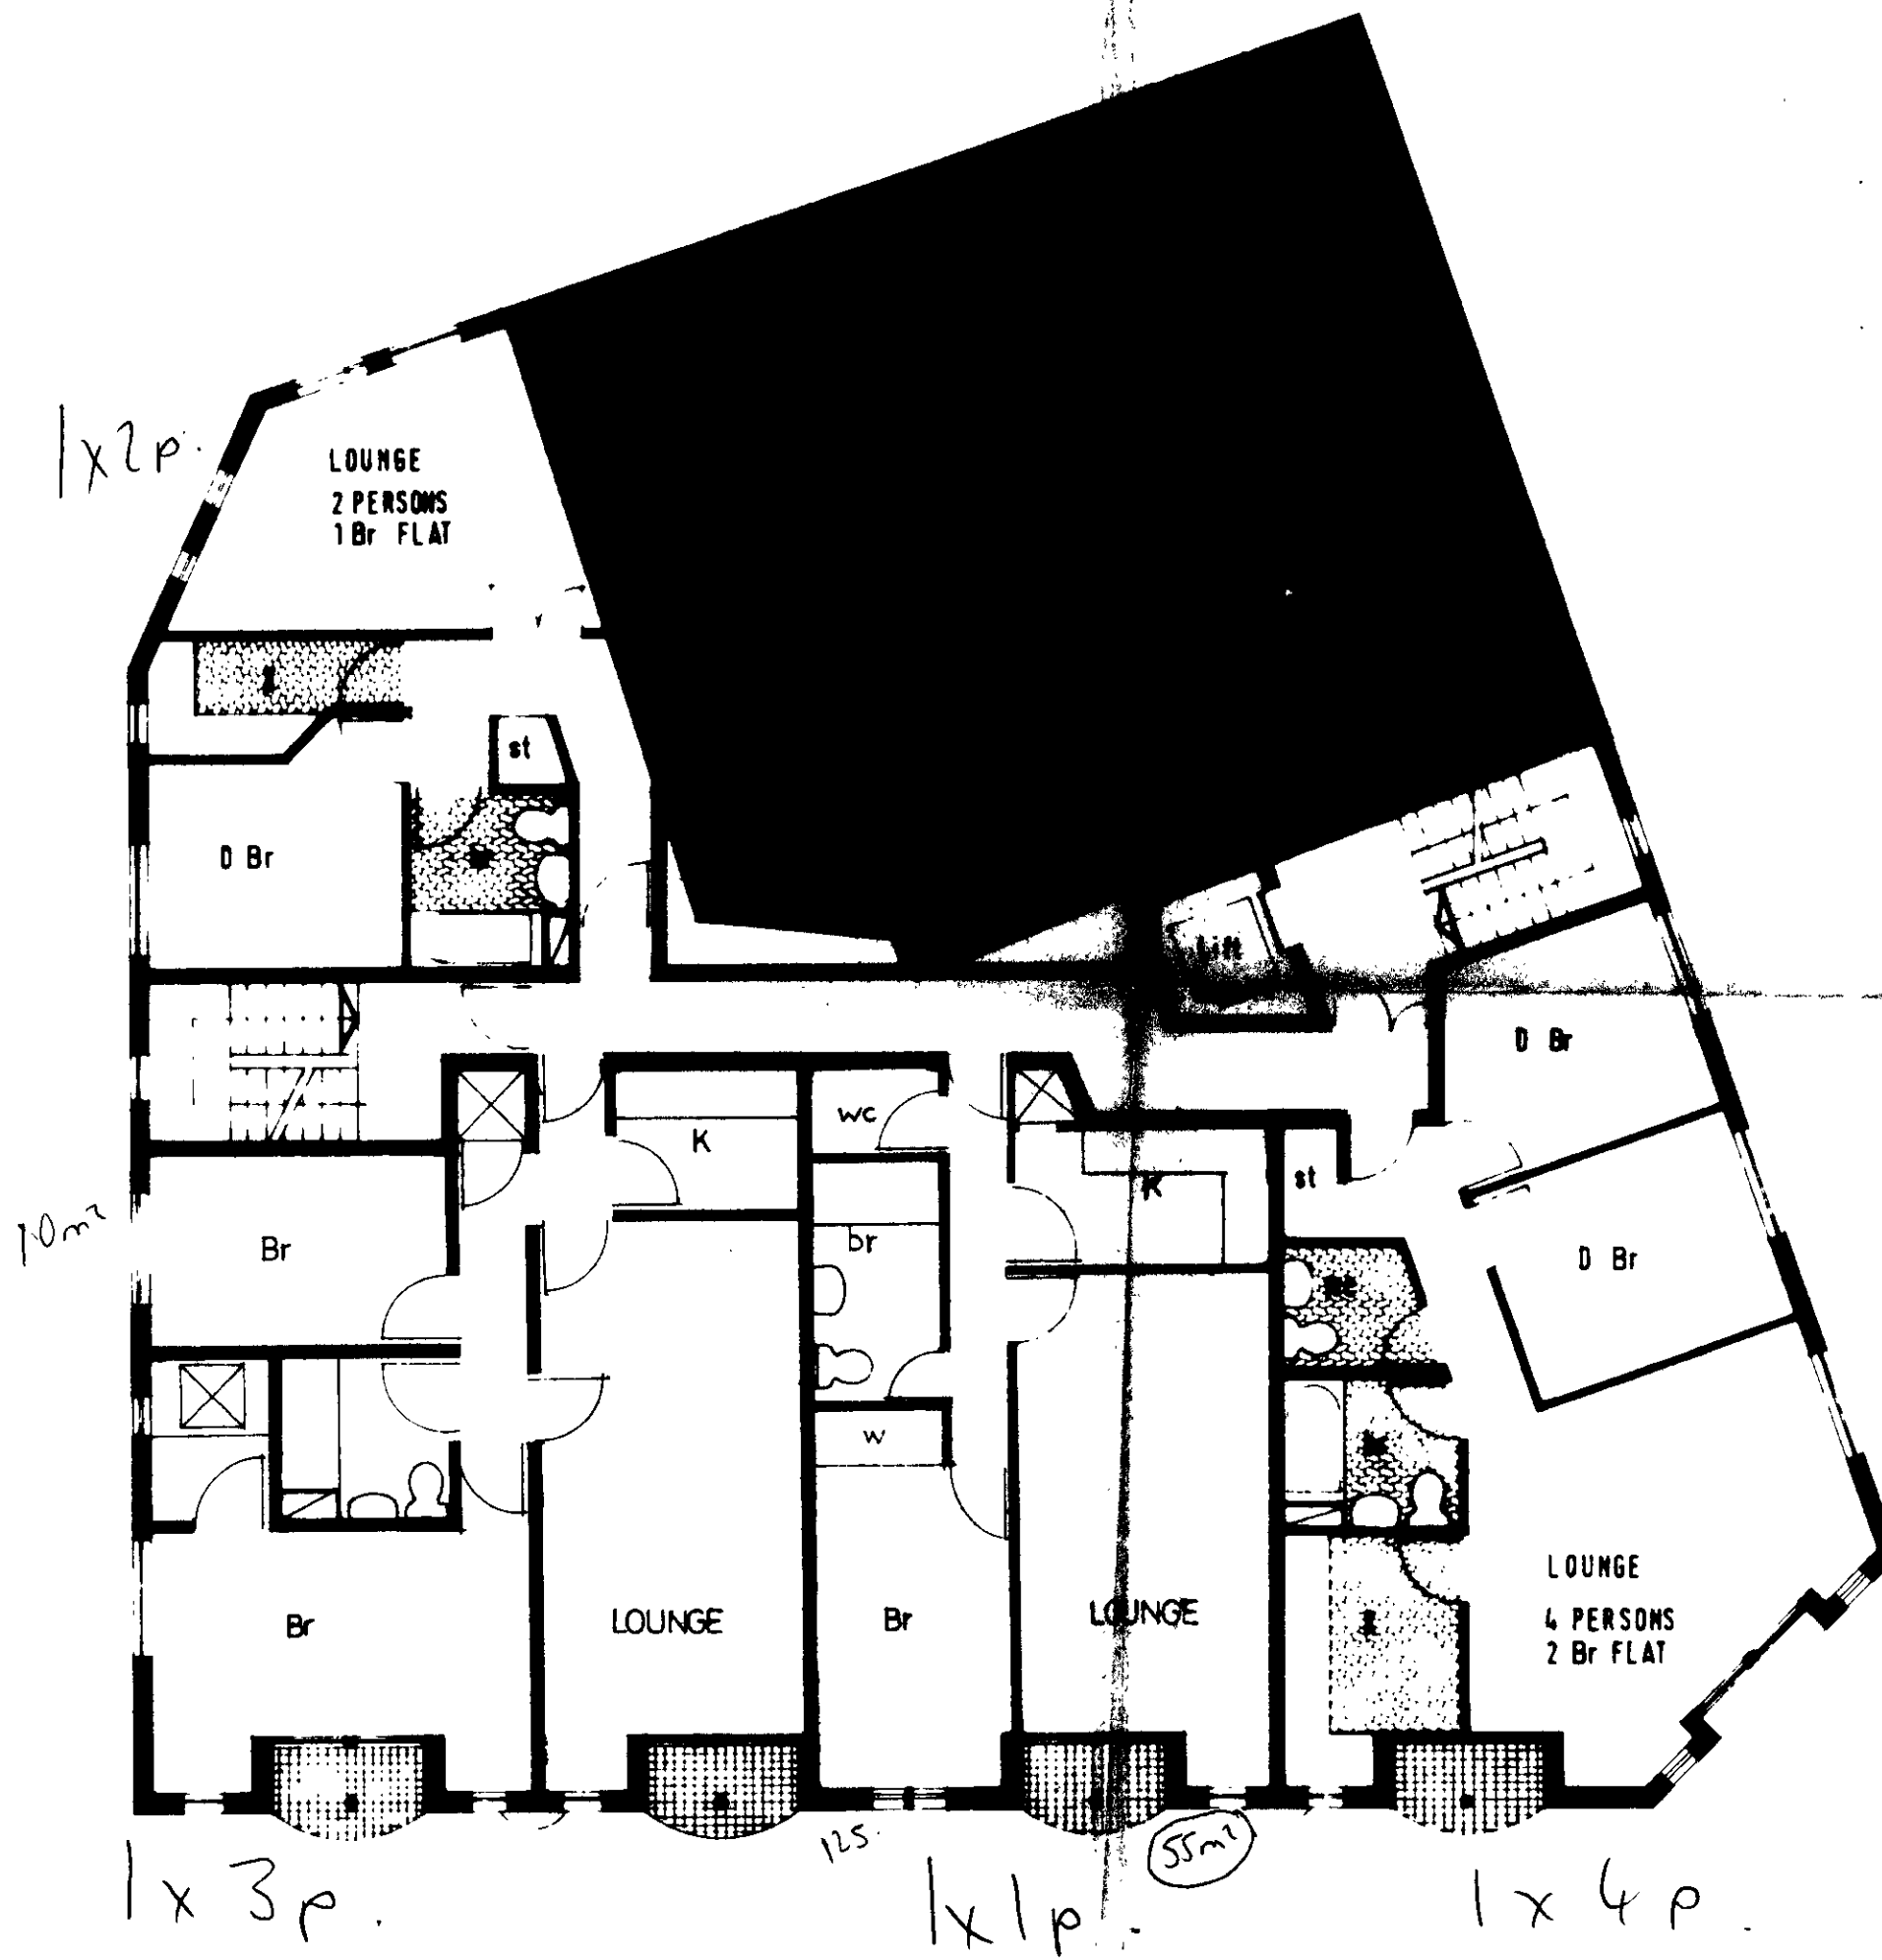

LONDON BOROUGH OF CAMDEN
TOWN AND COUNTRY PLANNING ACTS
- 3 SEP 1997
PLANS APPROVED
NOT APPROVED
ON BEHALF OF THE COUNCIL

LONDON BOROUGH OF CAMDEN
TOWN AND COUNTRY PLANNING ACTS
16 JUN 1987
PLANS APPROVED
NOT APPROVED
ON BEHALF OF THE COUNCIL

TP8700538R4

~~HD8778001R4~~

LONDON BOROUGH OF CAMDEN
PLANNING AND COMMUNICATIONS
DEPARTMENT
- 9 JUL 1987 (A.M.)
RECEIVED
ACK. REF. TO:

A	REORGANISING 2 FLATS TO FORM 1 BR FLAT & 2 BR FLAT	K	5 '87
B	INTERNAL LAYOUT AMENDMENT	X	JULY 87
C	INCLUDED TWO WINDOWS TO CORNER FLAT LOUNGE AND REAR FLAT LOUNGE	FF	JULY 87

11 Bradstone Brook
Shaftesbury Gardens, London WC4 8HT
Telephone: 0483 68686
12 The Priory Street
London WC2E 8RZ
Telephone: 01 241 2961
13 4 Fitzroy Place
London W1T 4AN
Telephone: 01 214 0066

SCOTT BROWN RIGG & TURNER
Architects and planning consultants


DEFERRED
LONDON BOROUGH OF CAMDEN
TOWN AND COUNTRY PLANNING ACTS
6 AUG 1987
PLANS APPROVED
NOT APPROVED
ON BEHALF OF THE COUNCIL
TAYLOR WOODROW
PROPERTY CO. LTD
GALLOPACO SITE
APPROVALS WC2
FIRST FLOOR PLAN

Scale: 1:100

Drawn	Checked	Date
		NOV. 86
Job No.	Drawing No.	Rev.
8081	A3 ⁱ	C.

Figured dimensions only are to be taken from this drawing. All dimensions are to be checked on site before any work is put in hand. If in doubt, ask.

Notes

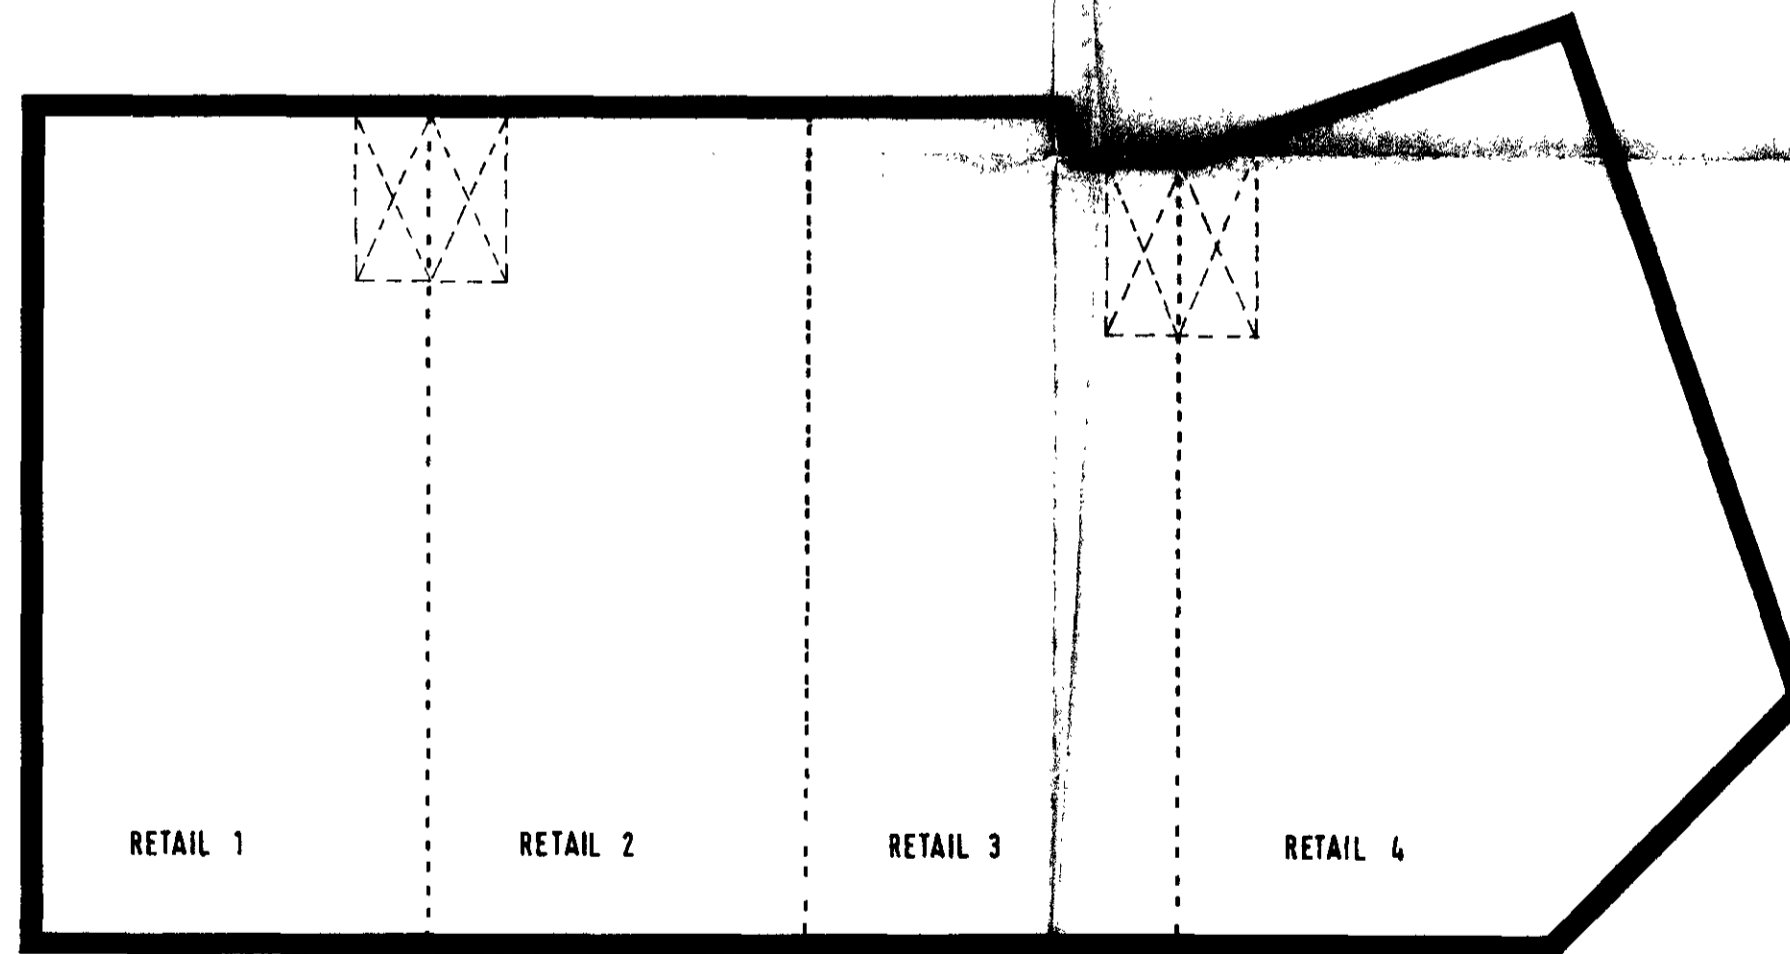

LONDON BOROUGH OF CAMDEN
TOWN AND COUNTRY PLANNING ACTS
3 SEP 1987
APPROVED
PLANS NOT APPROVED
ON BEHALF OF THE COUNCIL

Mk	Revision	Initial	Date

JP 87 0053873

JP 87 7000103

LONDON BOROUGH OF CAMDEN
TOWN AND COUNTRY PLANNING ACTS
6 AUG 1987
DEFERRED
PLANS NOT APPROVED
ON BEHALF OF THE COUNCIL

LONDON BOROUGH OF CAMDEN
TOWN AND COUNTRY PLANNING ACTS
16 MAR 1987
DEFERRED
PLANS NOT APPROVED
ON BEHALF OF THE COUNCIL

LONDON BOROUGH OF CAMDEN
PLANNING AND COMMUNITY DEVELOPMENT DEPARTMENT
- 3 JUL 1987
RECEIVED
ACK.

**SCOTT
BROWNRIGG
& TURNER**

Architects and planning consultants

- ▷ Bradstone Brook
Shalford Guildford GU4 8HT
telephone 0483 68686
- ▷ 10-13 King Street
London WC2E 8HZ
telephone 01-240 2961
- ▷ 4 Fitzroy Place
Glasgow G3 7RH
telephone 041-204 0066

Client's name

**TAYLOR WOODROW
PROPERTY CO. LTD.**

Job title

**TEXACO SITE
7 DIALS WC2**

Drawing title

BASEMENT PLAN

Scale 1:100

Drawn	Checked	Date
		NOV. 86

Job no	Drawing no	Rev
8081	A1	