


APPROVED FOR PRODUCTION DATE 4.9.92

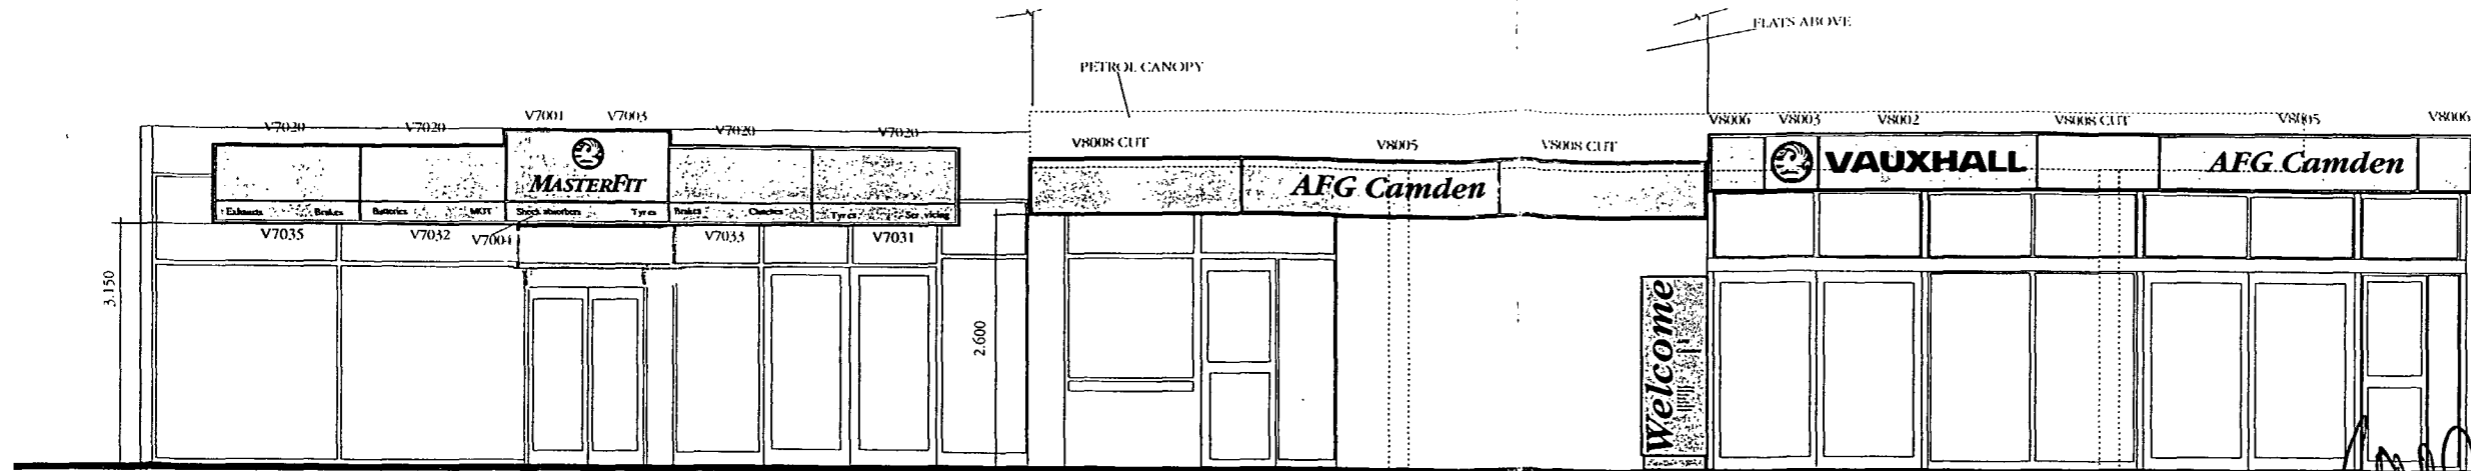

**SIGN A**  
5.690 X 800  
NEW BOX/NEW TRIM  
SCALE 1:100

**SIGN C**  
9.000 X 800  
NEW BOX/NEW TRIM  
SCALE 1:100


**SIGN C(W)**  
SCALE 1:100

**SIGN D**  
10.075 X 800 BOB  
10.385 FOB  
NEW BOX/NEW TRIM  
150MM STANDOFF BRACKET  
REUSE EXISTING  
SCALE 1:100


**SIGN J**  
SINGLE SIDED  
ILLUMINATED  
V2001  
POSITION TO BE DETERMINED  
SCALE 1:50

LONDON BOROUGH OF CAMDEN  
TOWN AND COUNTRY PLANNING ACTS  
**19 NOV 1992**  
PLANS APPROVED  
ON BEHALF OF THE COUNCIL

Notes:  
Signage to have aluminium cases finished in eggshell black, with all retaining trim in Vauxhall green.  
Cases retain moulded acrylic pans with text and designs as shown. Logo and Vauxhall letters are built up. Dealer name flat

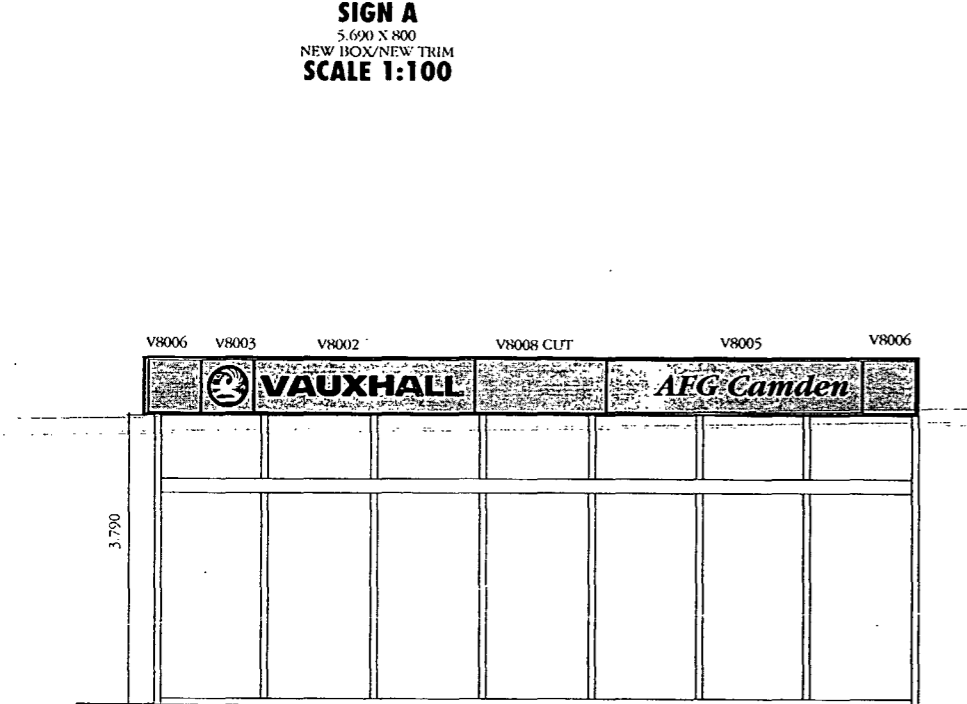

**SIGN E**  
10.150 X 800 BOB  
10.310 FOB  
NEW BOX/NEW TRIM  
SCALE 1:100

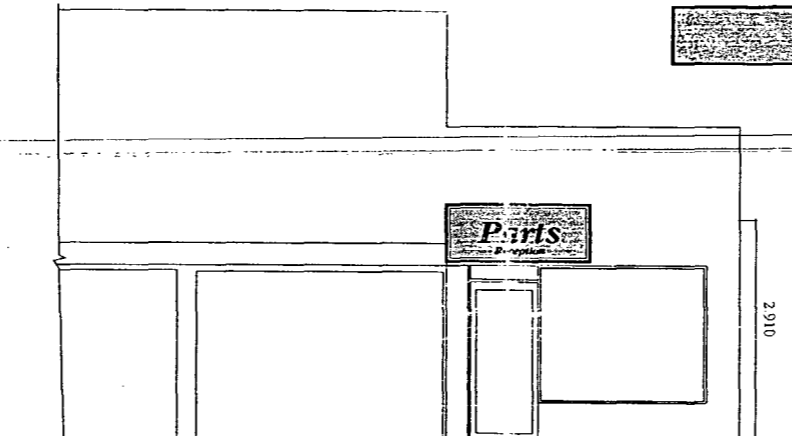

**SIGN F**  
SCALE 1:100


**SIGN H**  
11.545 X 760  
FLAT ACRYLIC PANELS/PANATRIM  
TO BE FITTED TO INNER FACE OF PETROL CANOPY  
NON ILLUMINATED  
SCALE 1:100

- REMOVALS**
- R1 BOX 11.780
  - R2 BOX 10.075
  - R3 BOX 10.150
  - R4 BOX 7.300
  - R5 SPECIAL PRG
  - R6 SPECIAL FLAT 4.090
  - R7 SPECIAL FLAT 4.820
  - R8 SPECIAL FLAT 3.010


**ILLUMINATION**  
Vauxhall Griffin logo to be illuminated  
Vauxhall letters to be individually illuminated internally with light showing around face edge of letters giving a halo effect. Dealer letters and other facilities if shown illuminated behind faces.  
All illumination by fluorescent tubes.  
Logo, Vauxhall & Dealer name ONLY to illuminate.

**COLOUR**  
Vauxhall logo: White Griffin on red background and sides  
Vauxhall letters: grey face with opal edge and sides  
Dealer letters: opal faces  
Background pans: Vauxhall green


**POLE SIGNS**  
Double sided, internally illuminated, twin post sign, sizes as shown, acrylic face pans. Text and logo only to illuminate

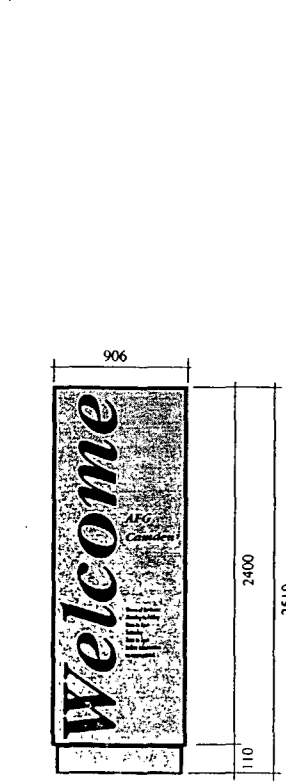


**SIGN C(W)**  
WELCOME SIGN  
SEPARATE FROM FACIA  
SCALE 1:50

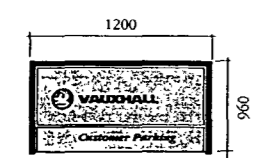


**SIGN L/SIGN M/SIGN N/SIGN O**  
WALL MOUNTED DIRECTIONAL SIGN  
SCALE 1:50

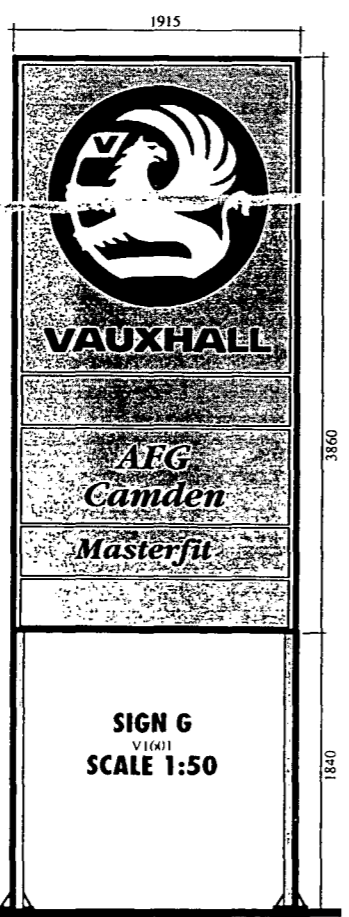


**SIGN G**  
SCALE 1:50

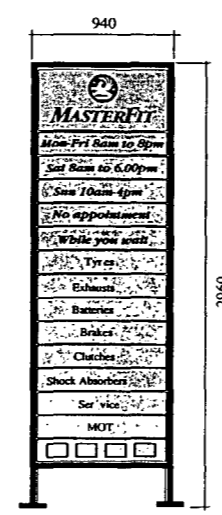

**SIGN K**  
SCALE 1:50

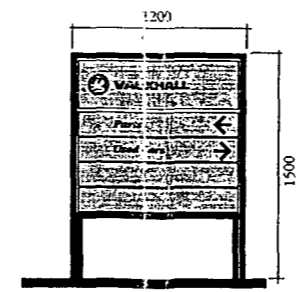

**SIGN P**  
DIRECTIONAL LAWN SIGN  
SCALE 1:50

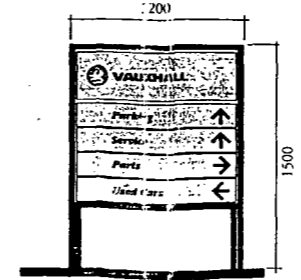

**SIGN Q**  
DIRECTIONAL LAWN SIGN  
SCALE 1:50




**SIGN B**  
SCALE 1:50



**SIGN F**  
SCALE 1:50

**FOR ATTENTION OF DEALER**  
Electrical Supply  
Please provide suitable low tension supply to within 1 metre of each sign position and to the base of each pole.  
See drawing for each sign current rating.

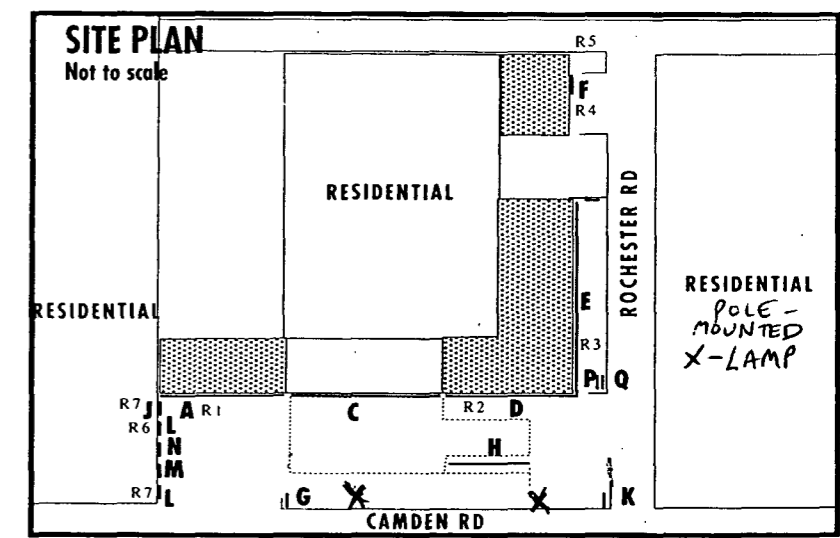

<b>AFG CAMDEN</b> 85 CAMDEN RD NW1	Job No. 4940 REV A
	Date. 19/8/92
	Scale 1:100 1:50
	Drng No.

Futurama Signs Limited  
Island Farm House  
Island Farm Road  
East Molesey  
Surrey KT8 0TR TEL: 081 941 1999

**VAUXHALL**  
Dealer Development