



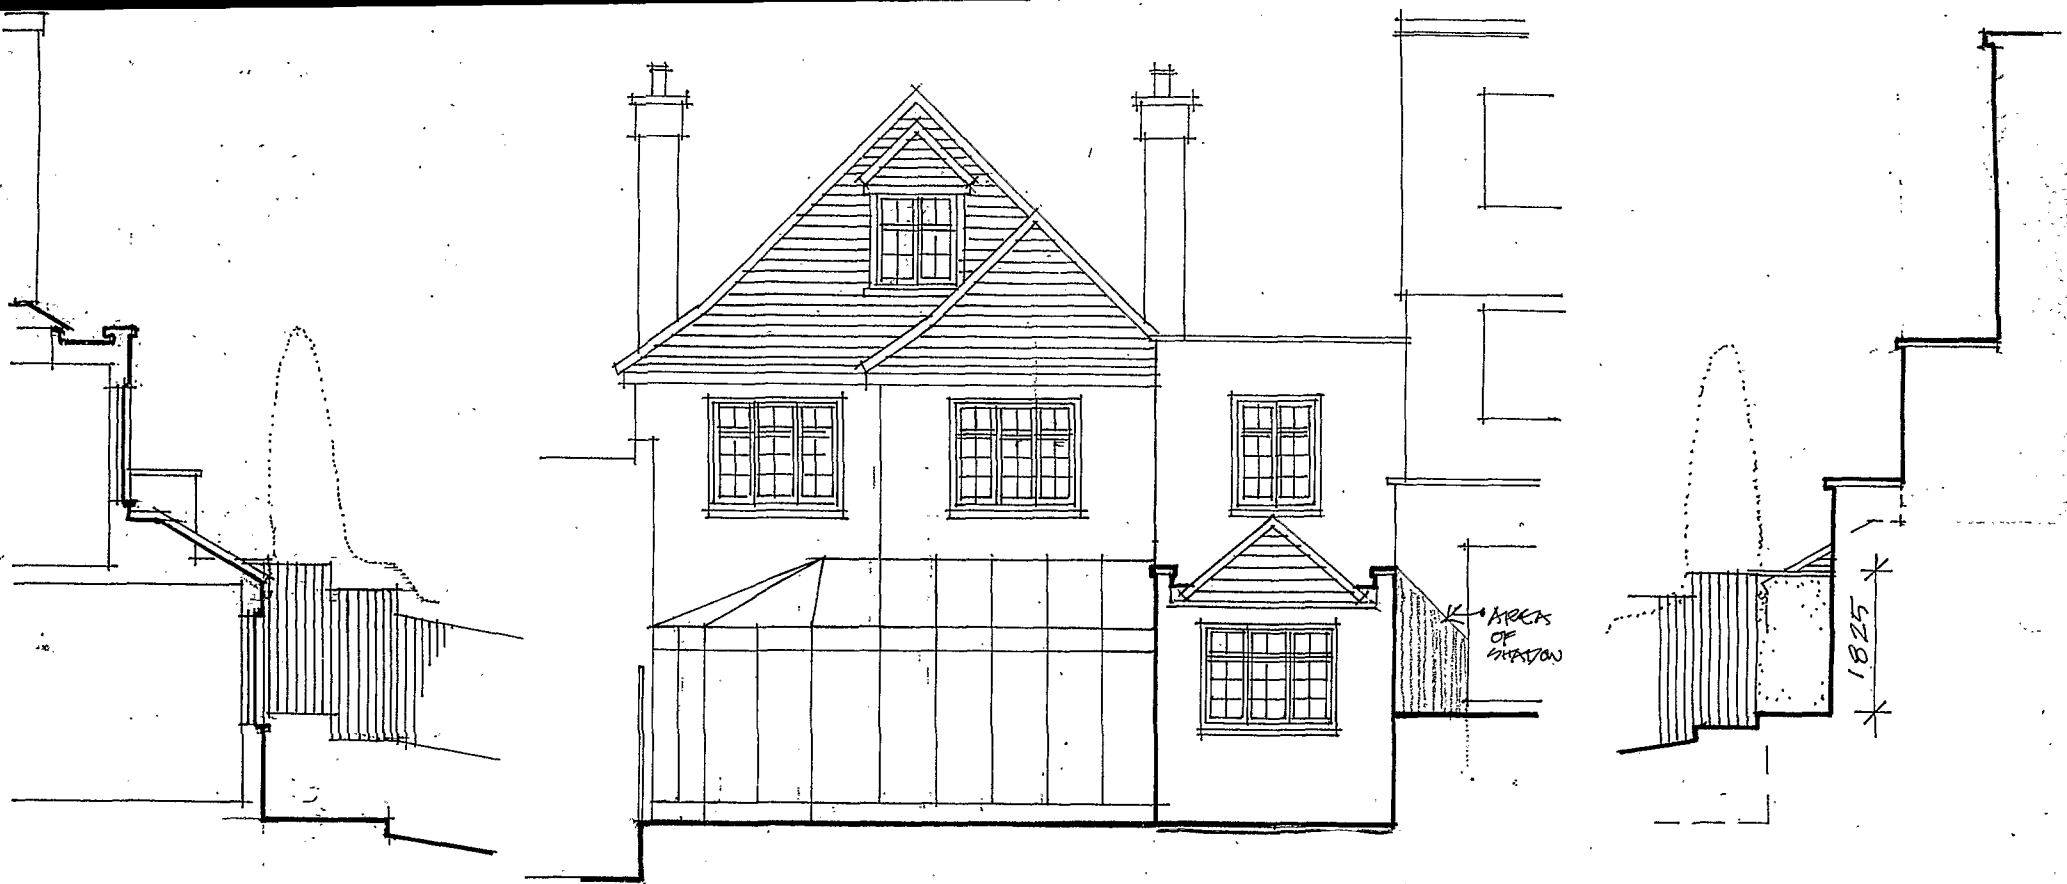

PART SECTION FROM (A)
VIEW FROM N2 88

REAR ELEVATION -
AS BUILT.

PART SECTION FROM (B)
VIEW FROM N2 90

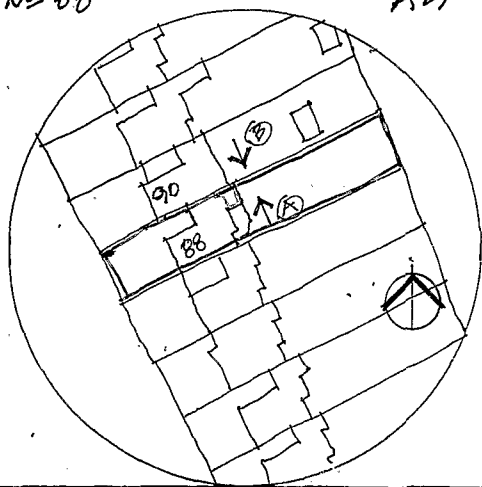

LOCATION PLAN - 1:1250



PART SECTION FROM (A)
VIEW FROM N2 88

REAR ELEVATION -
AS APPROVED

PART SECTION FROM (B)
VIEW FROM N2 90

title 88 HILLWAY, LONDON , N6 6DP			CLIENT		
drawing REAR EXTENSION - ROOF ALTERATION			MR E. QUARADEGHINI, 88 HILLWAY, LONDON, N6 6DP.		
date SEPT 1997	scale 1:100		M & J ARCHITECTS		
job reference 9709/001	drawing number 1	rev	39 GROSSE WAY LONDON SW15 5DQ TEL/FAX 0181 789 2807		