


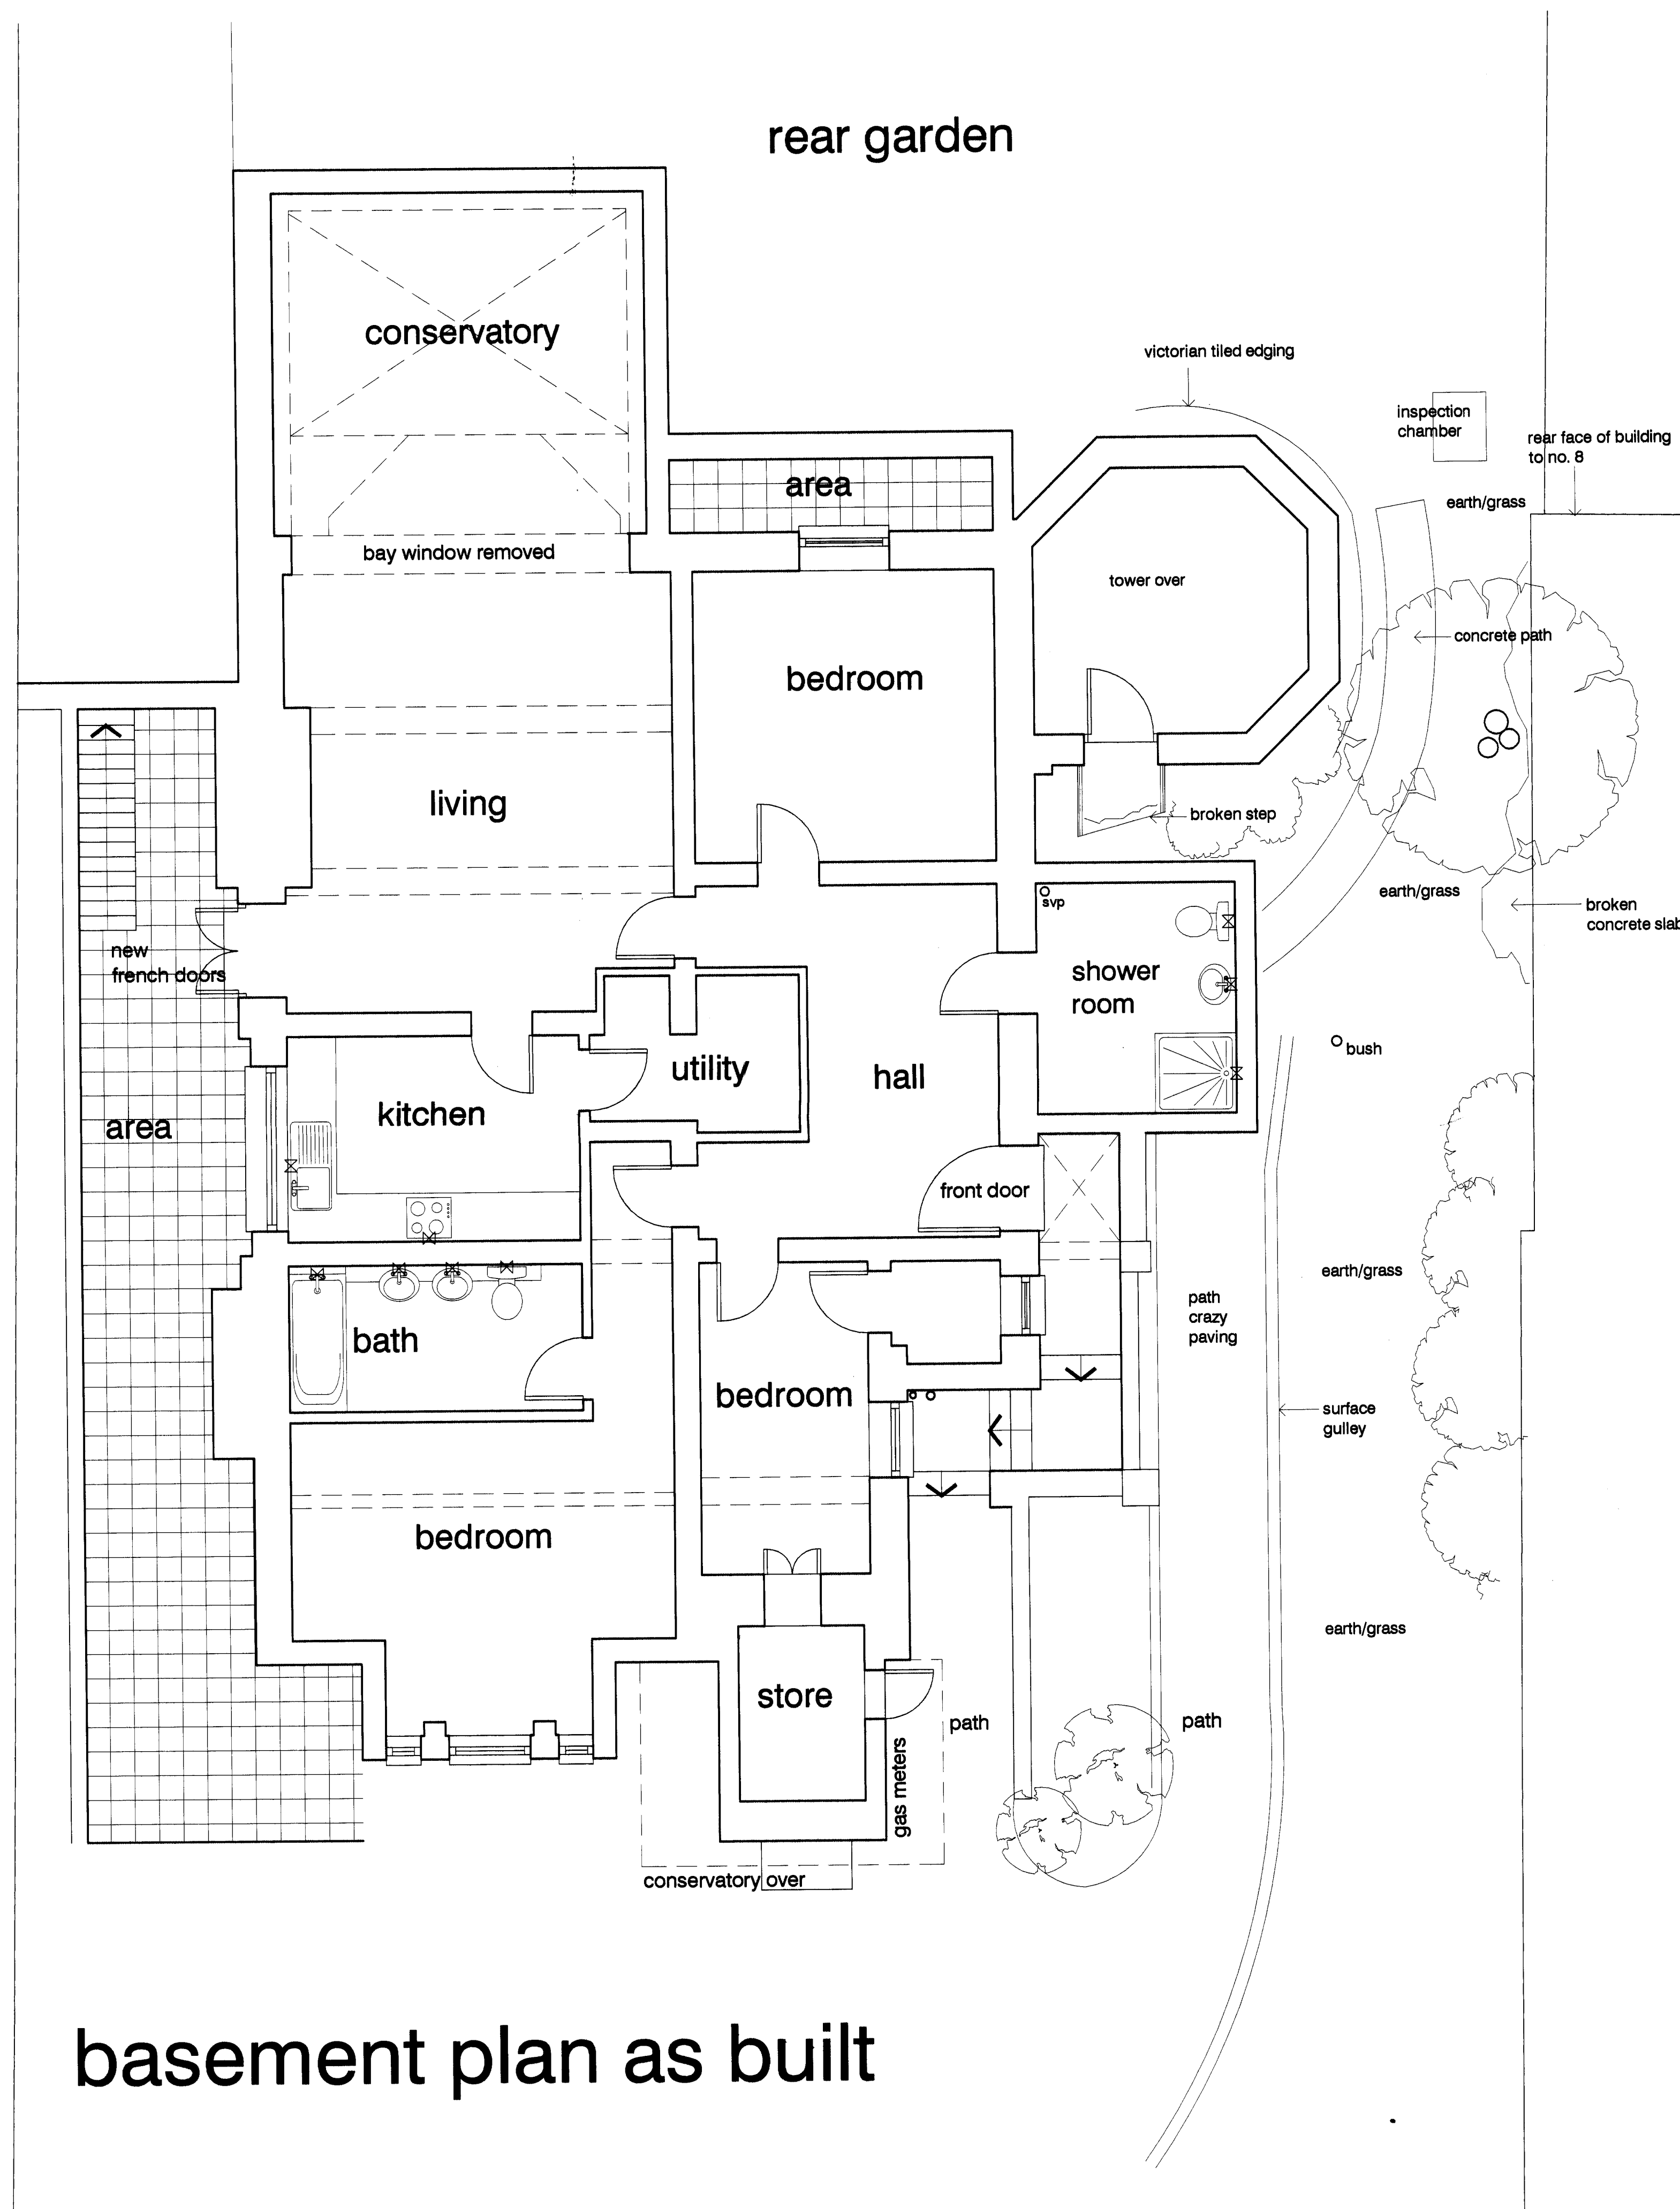

basement plan as built

DVM ARCHITECTS			
4a Murray Street . London . NW1 9RE Telephone 0207 485 2121 . Facsimile 0207 267 2527 e-mail: studio@dvmarch.com			
Client Mr and Mrs A Sastry			
Project 7 Lyndhurst Road Hampstead London NW3			
Title Basement Plan as Built			
Scale 1:50	Date 28.12.07	Job No. 1654	
Drawing No. 1654/04		Rev. A	
All dimensions are to be checked on site. © This drawing is copyright and remains the property of David & Victoria Mercer at all times and may not be reproduced in part or whole without written consent.			



east sectional elevation as built

(true elevation into front area)



east elevation as built

DVM ARCHITECTS 4a Murray Street . London . NW1 9RE Telephone 0207 485 2121 . Facsimile 0207 267 2527 e-mail: studio@dvmarch.com			
Client			
Mr and Mrs A Sastry			
Project			
7 Lyndhurst Road Hampstead London NW3			
Title			
East + Sectional Elevation as Existing			
Scale	Date	Job No.	
1:50	28.12.07	1654	
Drawing No.			Rev.
1654/06			A
All dimensions are to be checked on site. This drawing is copyright and remains the property of David & Victoria Mercer at all times and may not be reproduced in part or whole without written consent.			