




W
100
TYPICAL DOOR THRESHOLD
(Scale 1:5)

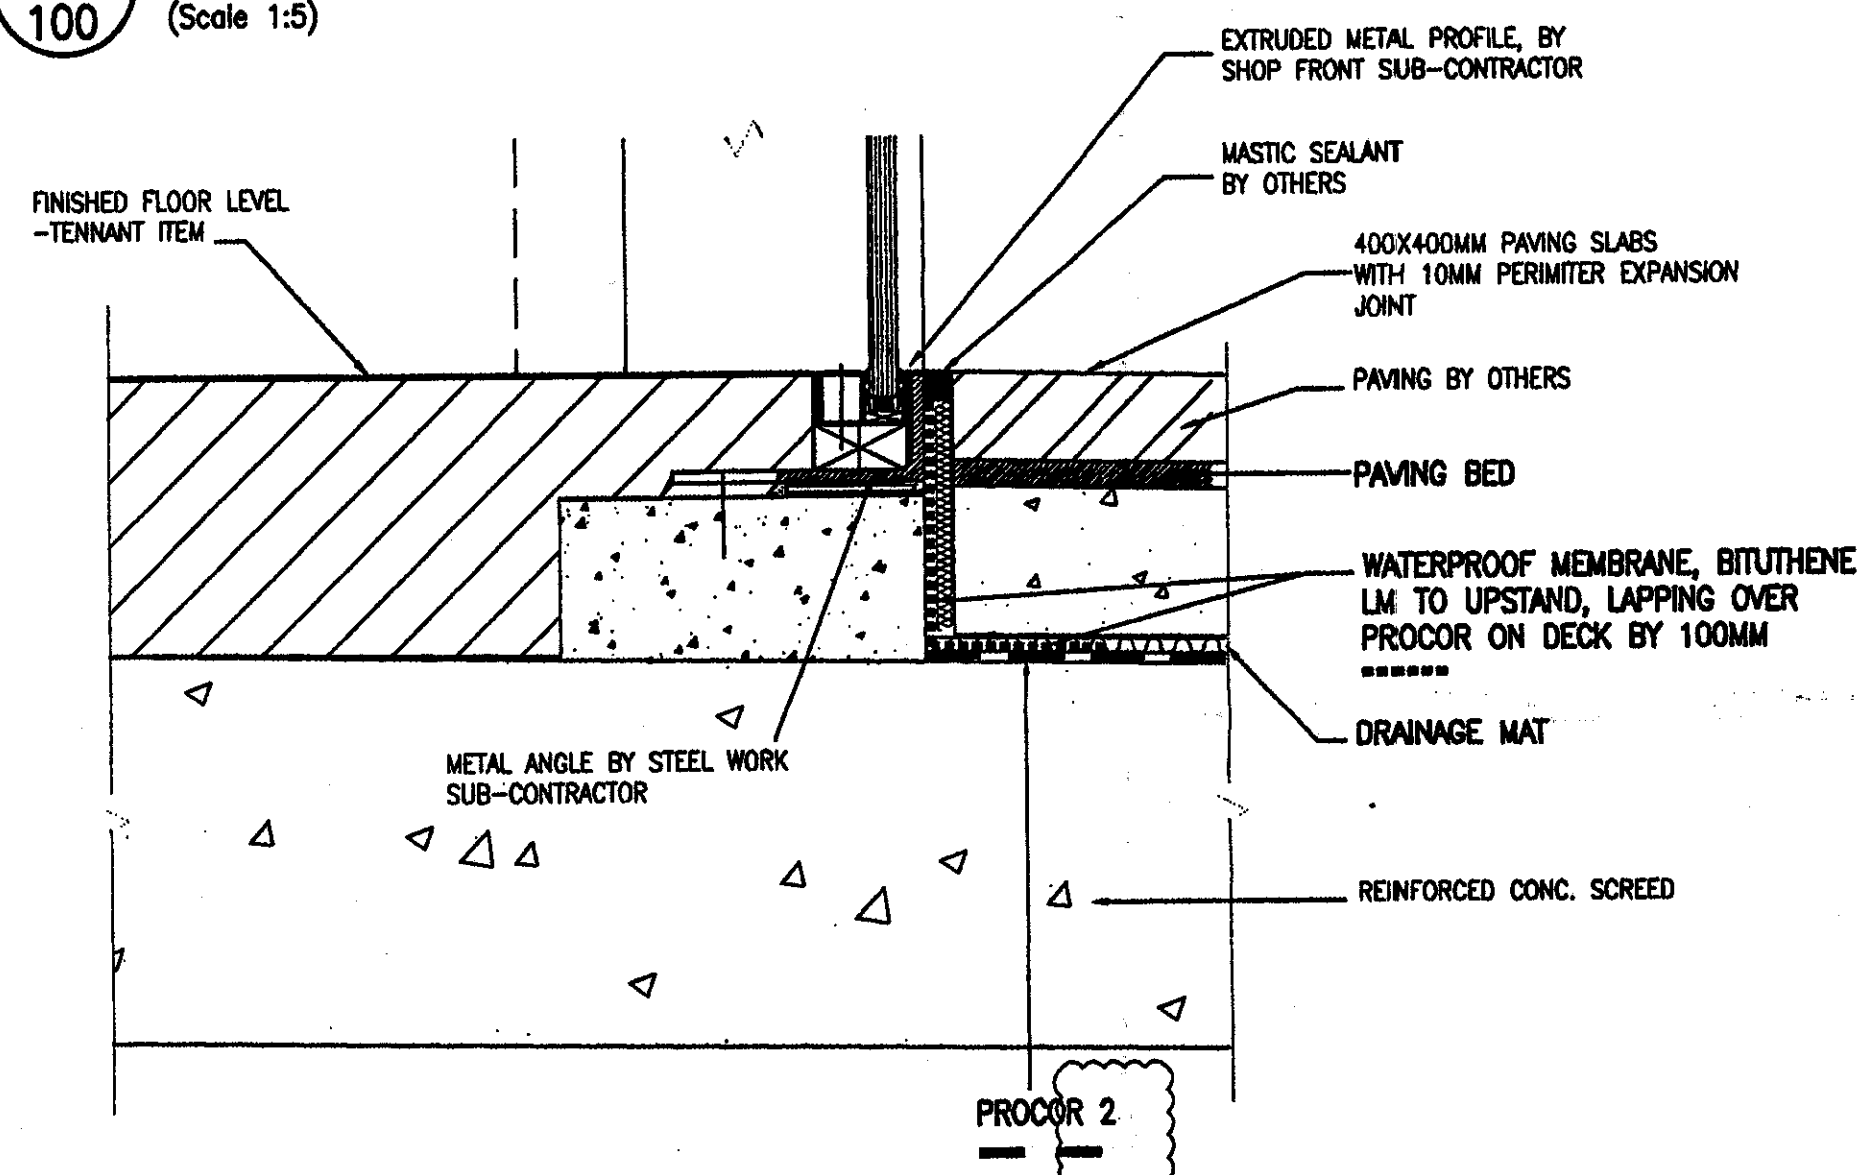

U
100
TYPICAL GLAZED SHOPFRONT
(Scale 1:5)

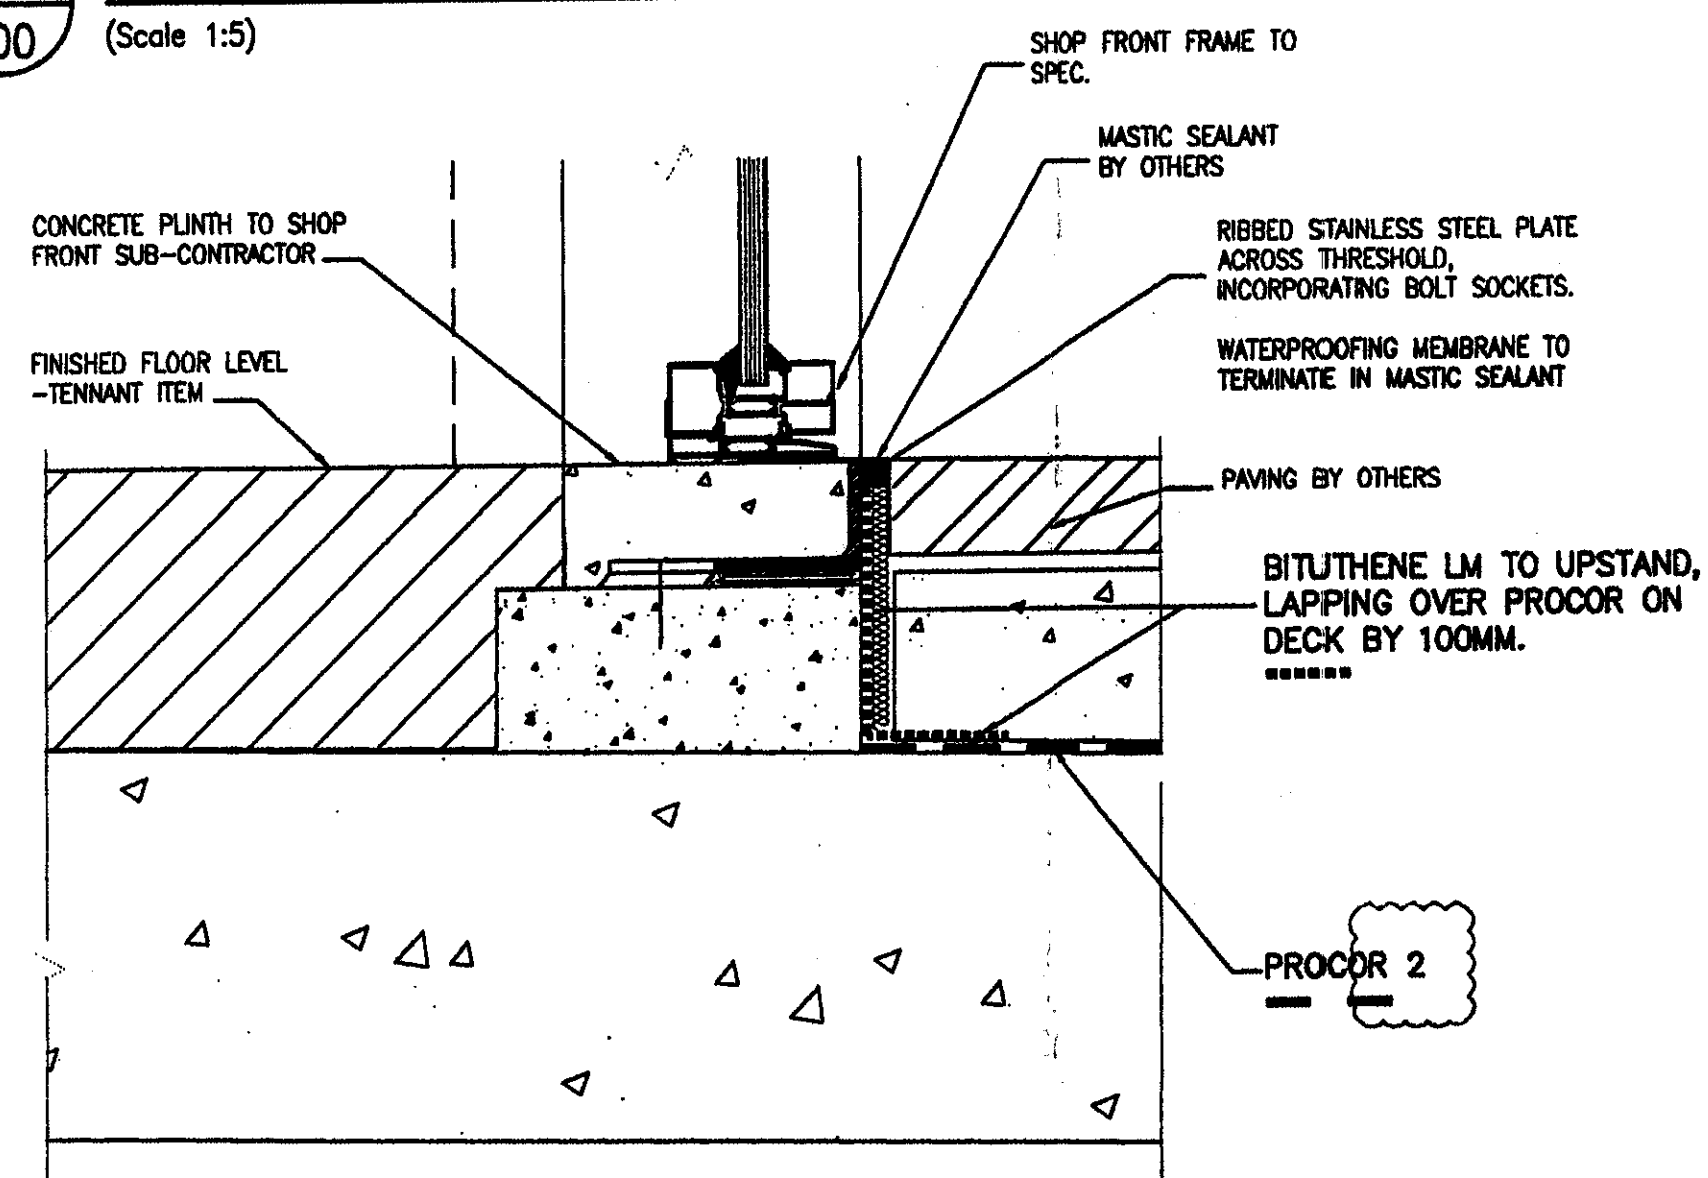


V
100
TYPICAL GLAZED SHOPFRONT
(Scale 1:5)

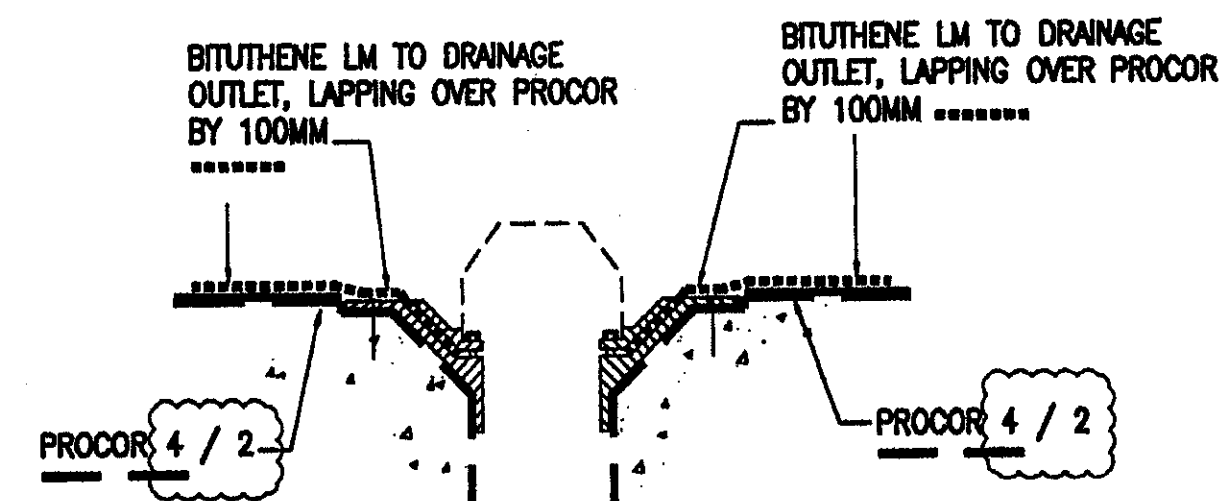


DRAINAGE OUTLET BODY TO BE FIXED PRIOR TO MEMBRANE APPLICATION MASK BODY AND BOLT HOLES TO AVOID OVERSPRAY FIX CLAMP RING AFTER CURING IS COMPLETE


C.I. DRAINAGE OUTLET
(Scale 1:5)

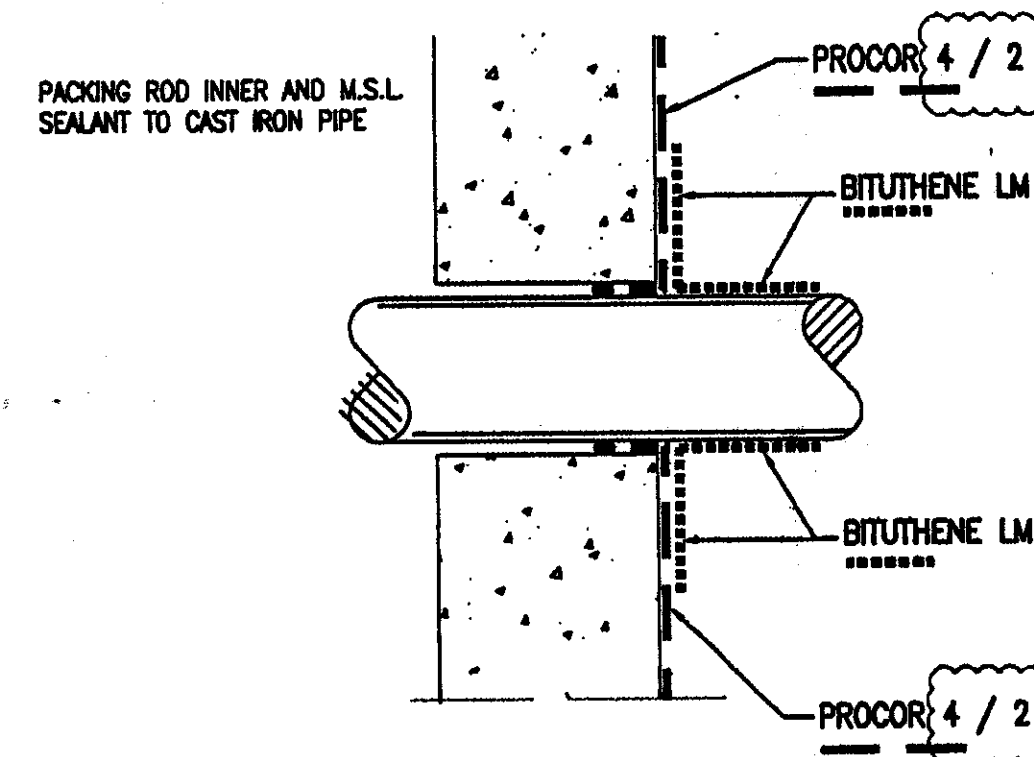


SERVICE / PIPE PENETRATION HORIZONTAL
(Scale 1:5)

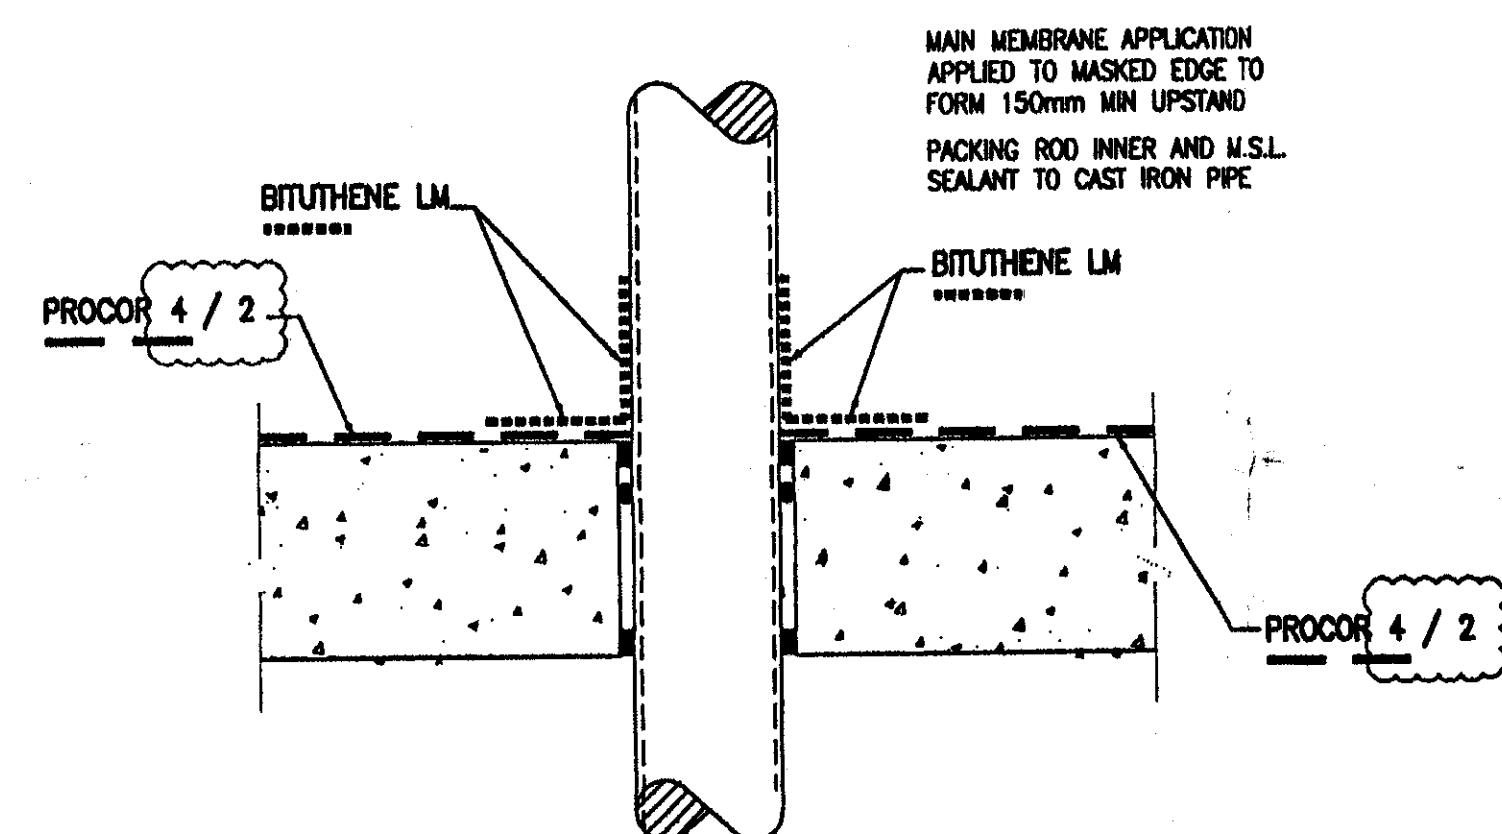

SERVICE / PIPE PENETRATION VERTICAL
(Scale 1:5)

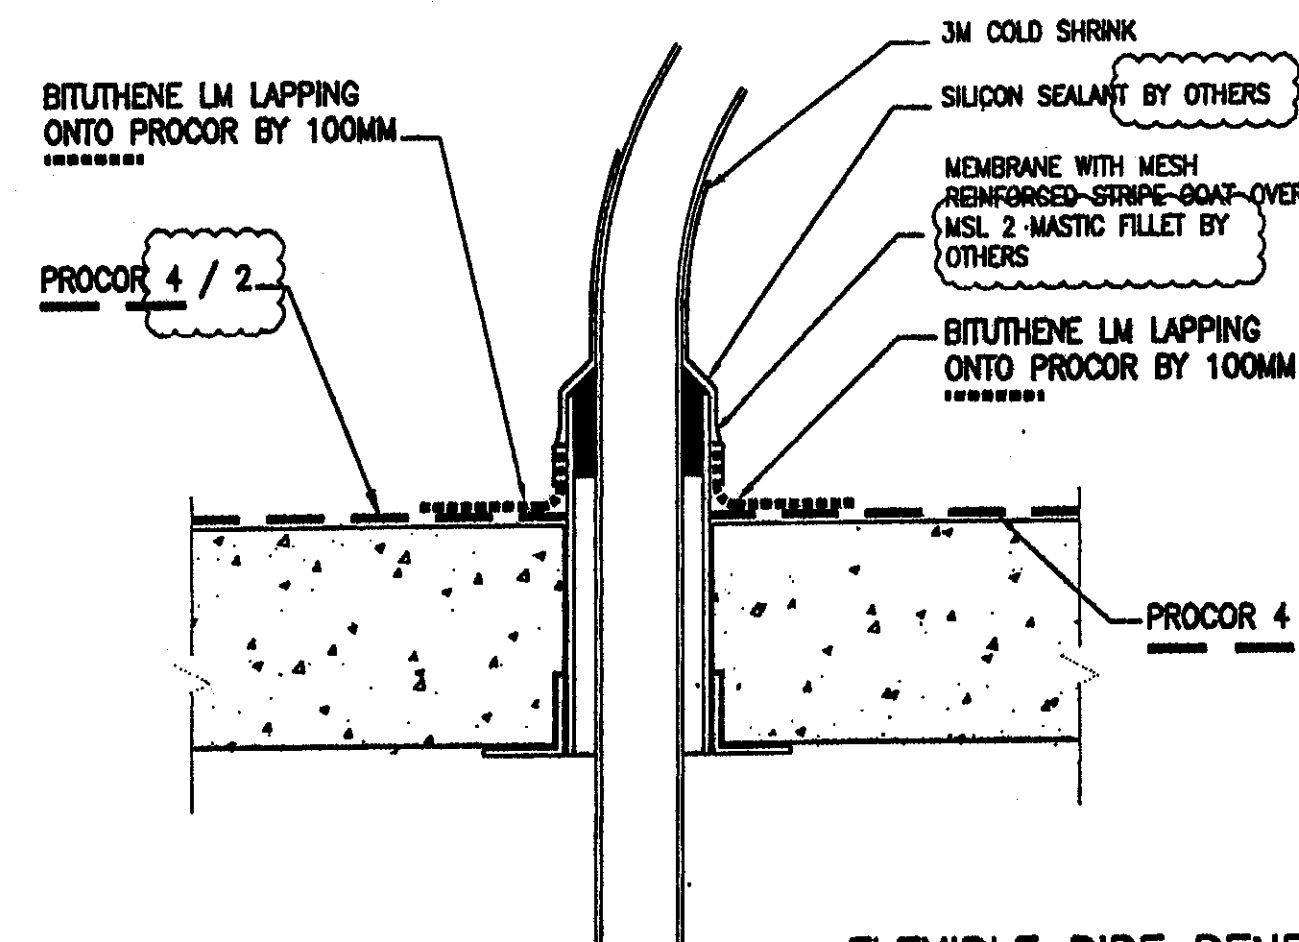

FLEXIBLE PIPE PENETRATION VERTICAL
(Scale 1:5)

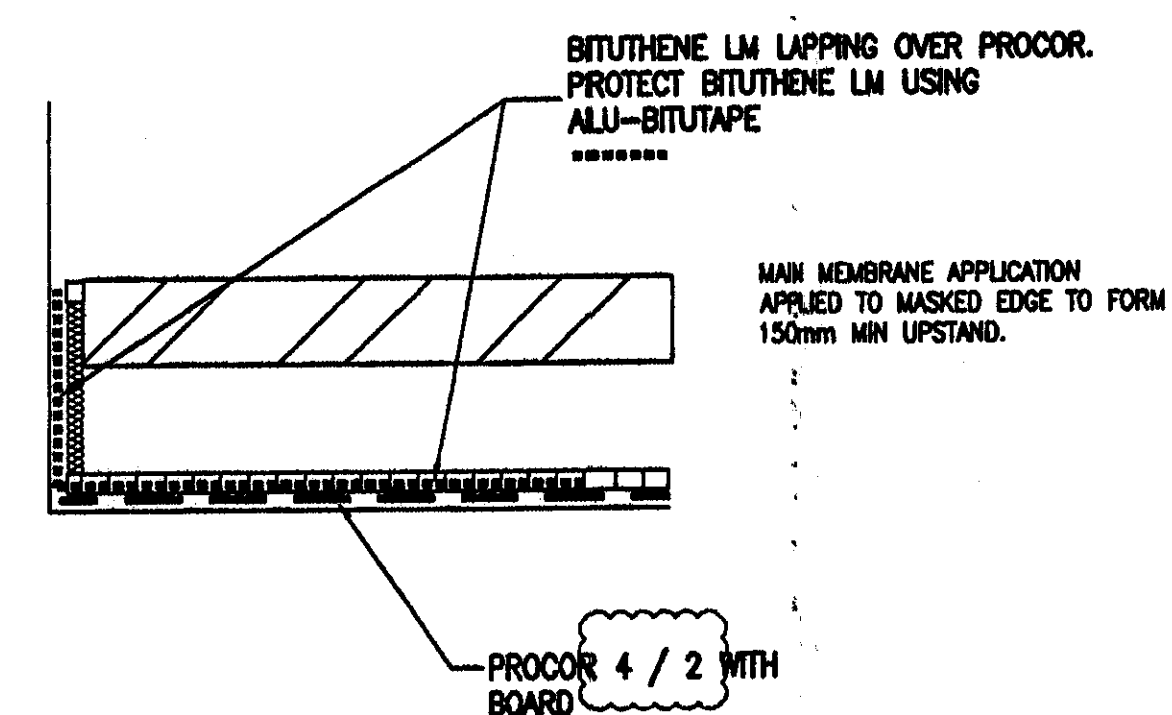

UPSTAND TERMINATION
(Scale 1:5)

NOTES

1. This drawing is to be read in conjunction with all relevant Architects and Engineer's drawings and the Specification.
2. All workmanship and materials are to comply with the Specification, Building Regulations, relevant British Standard and manufacturers recommendations.
3. This drawing is not to be scaled. All dimensions are in mm unless noted.

NOTE:

- FOR DETAIL LOCATIONS TO LEVEL 'A' REFER TO DRAWING 2370 / DWG / 100
- FOR DETAIL LOCATIONS TO LEVEL 'C' REFER TO DRAWING 2370 / DWG / 101

B	CAD	28.11.05	Revised 'as clouded'
A	CAD	03.11.05	CONSTRUCTION ISSUE

Rev	Task	Date	Revision
-----	------	------	----------

cemplas
Waterproofing & Concrete Repairs Limited
Holloway House
72 Lower Addcombe Road
Croydon Surrey CR9 5AD
Tel: 020 8854 5149
Fax: 020 8855 9094
Email: info@cemplas.co.uk

Client
ALLIED LONDON PROPERTIES LIMITED + INTERIOR PLC

Job No.
THE BRUNSWICK LONDON WC1

Drawing Title
**WATERPROOFING DETAILS
SHOPFRONT / DRAINAGE - SHEET 1**

Purpose of Issue	Preliminary <input type="radio"/>	Approval <input type="radio"/>	Construction <input checked="" type="radio"/>
	Information <input type="radio"/>	Tender <input type="radio"/>	Record Copy <input type="radio"/>

Date	Drawn	Scale	Checked
OCT 05	CAD	(as shown)	

Drawing No.	Rev
2370 / 210	B