




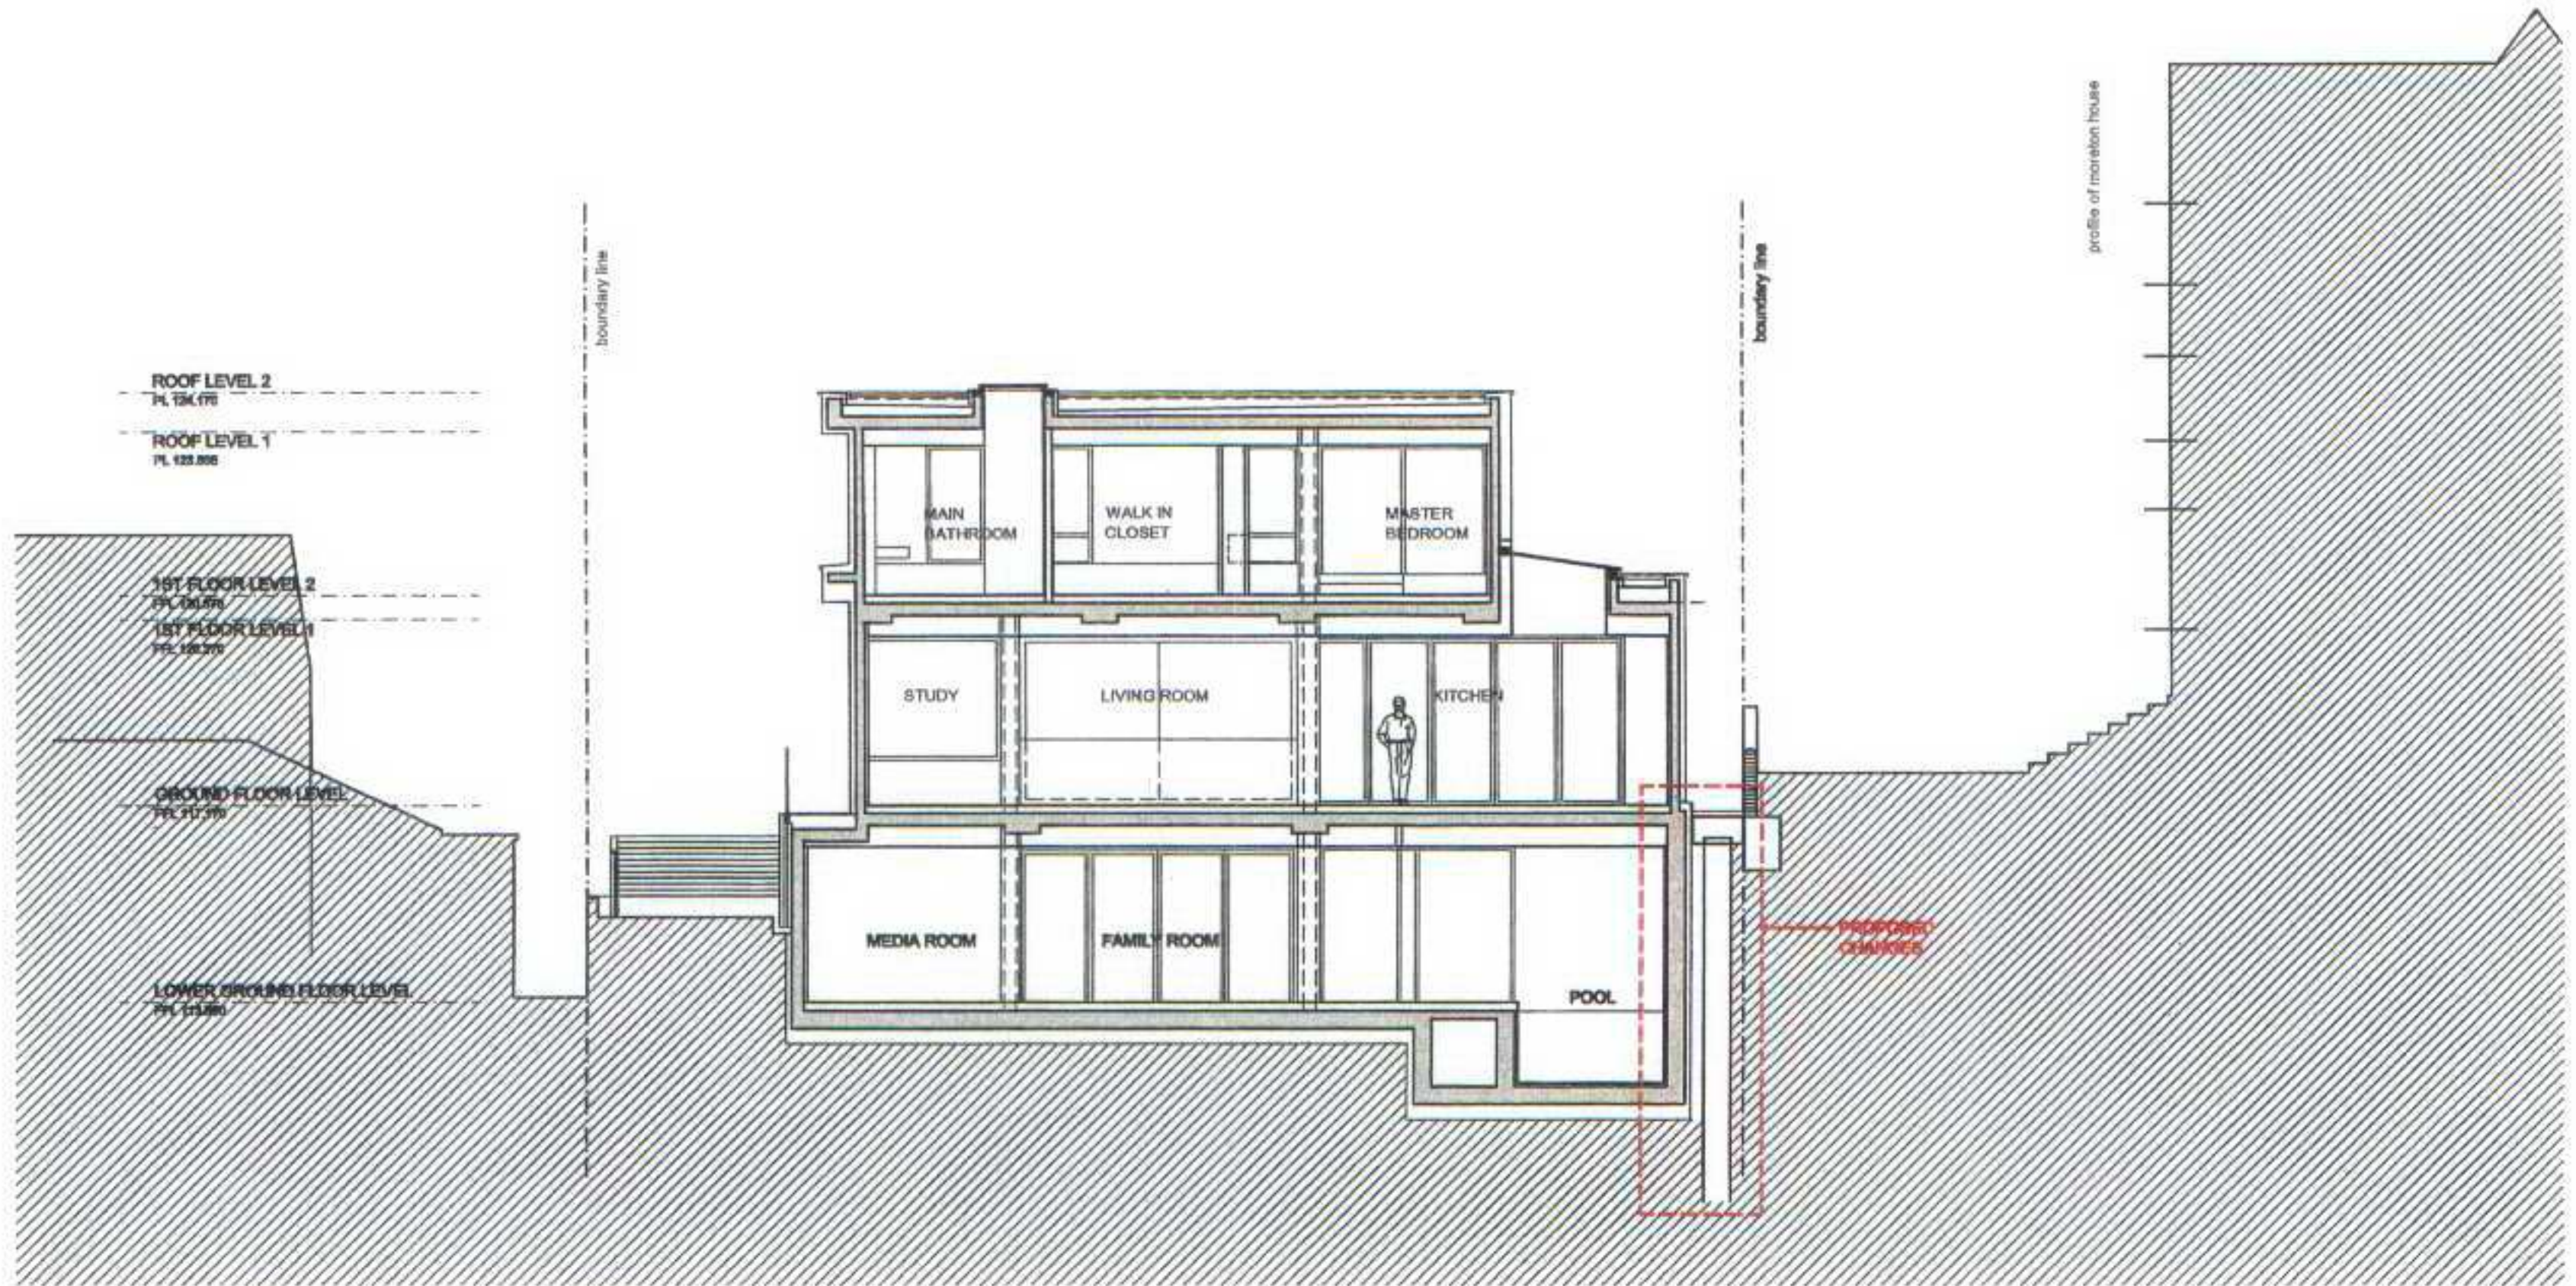

SECTION A-A

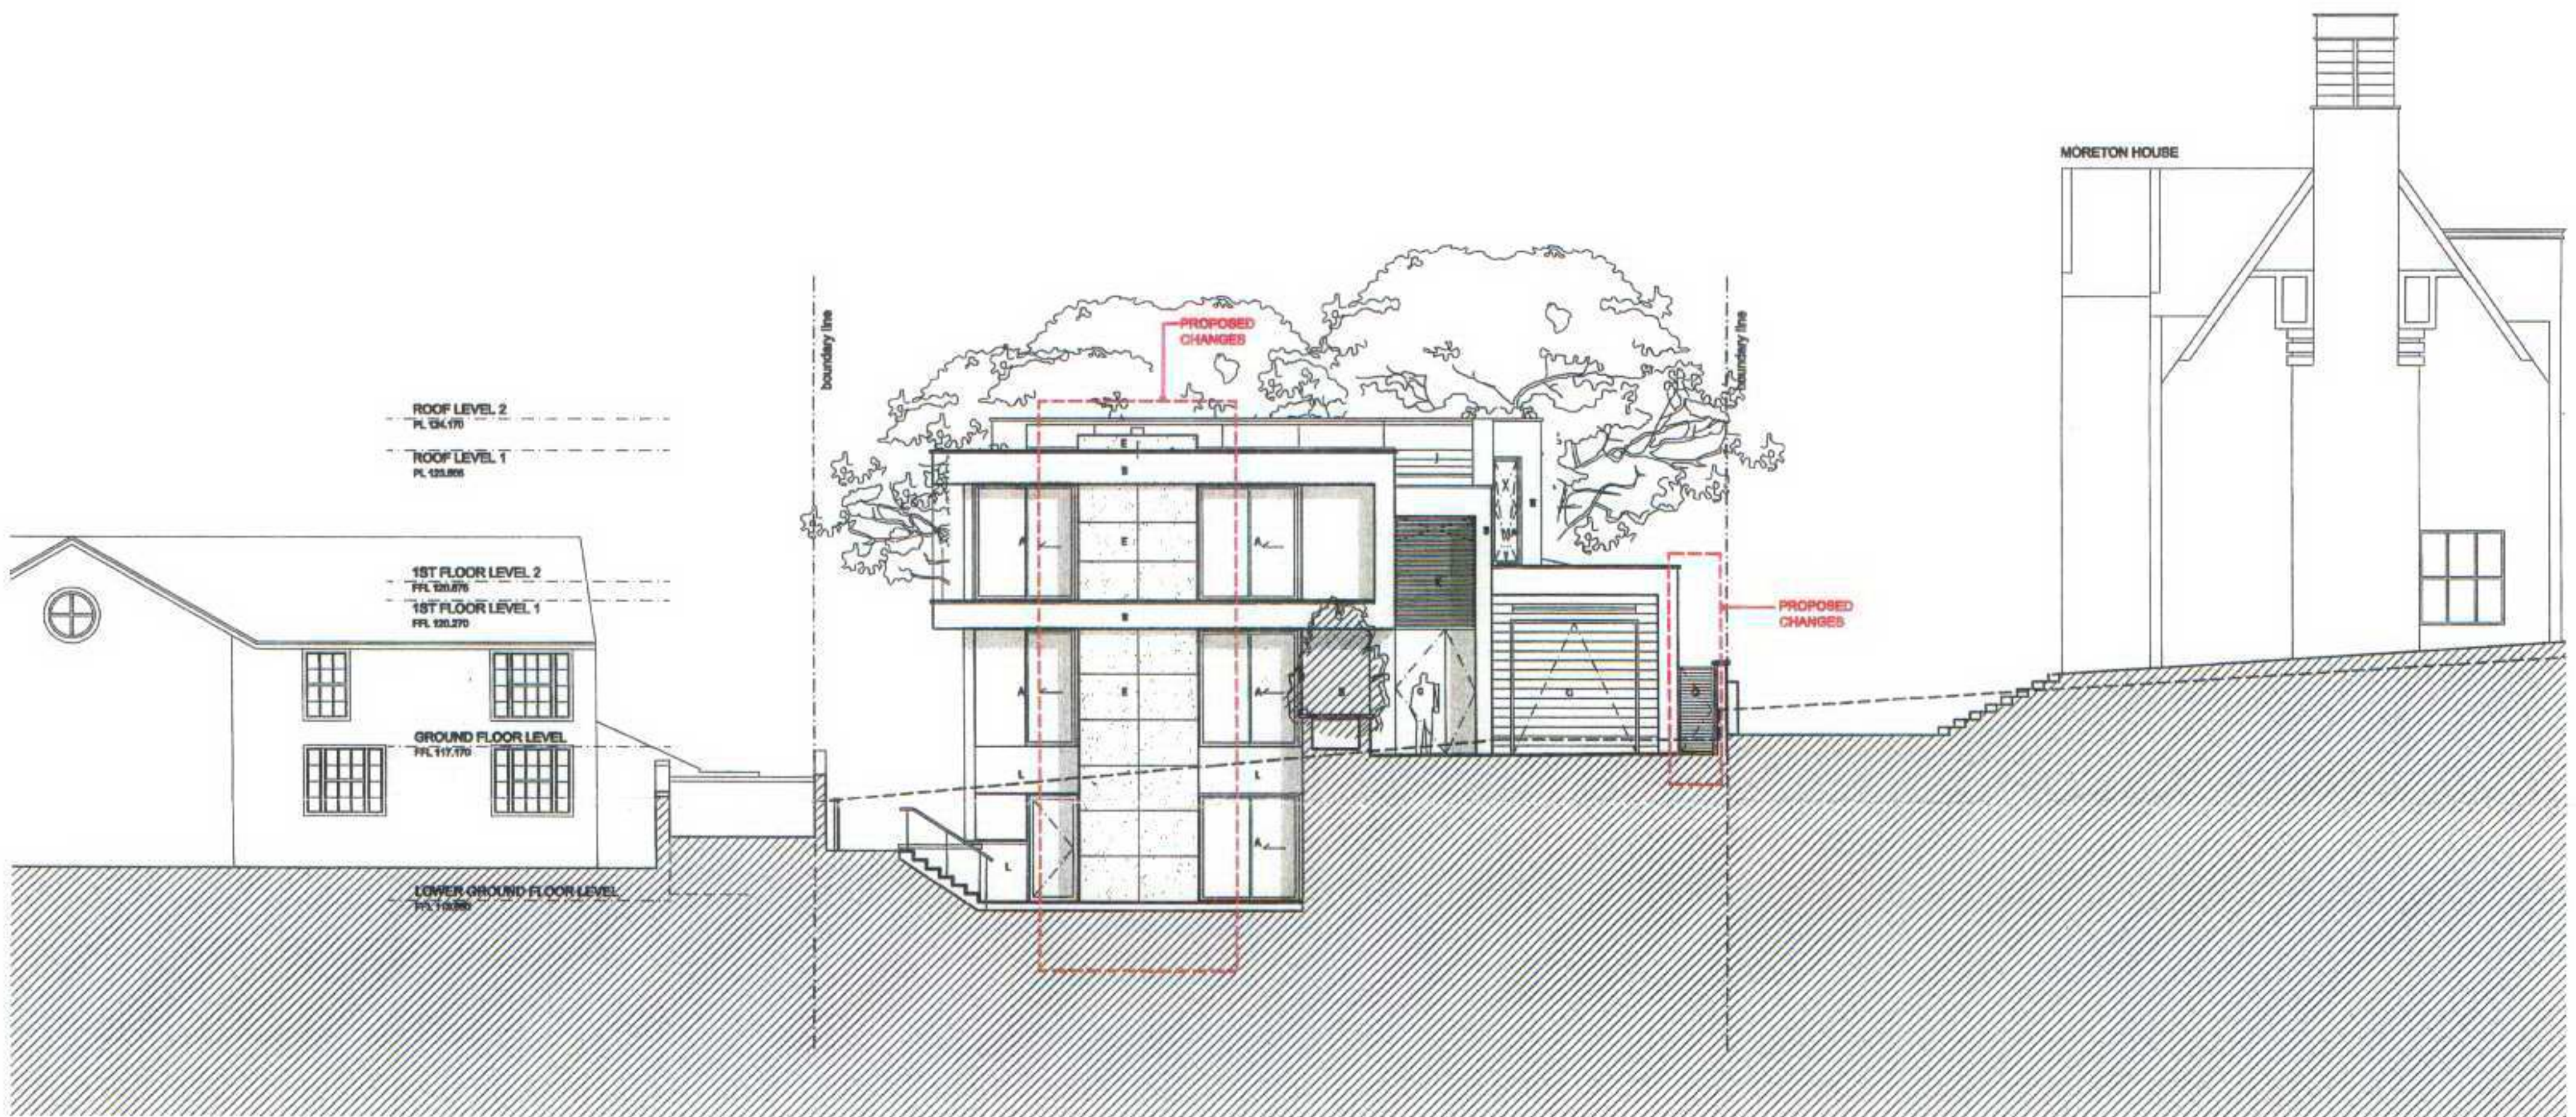

SECTION ELEVATION EAST

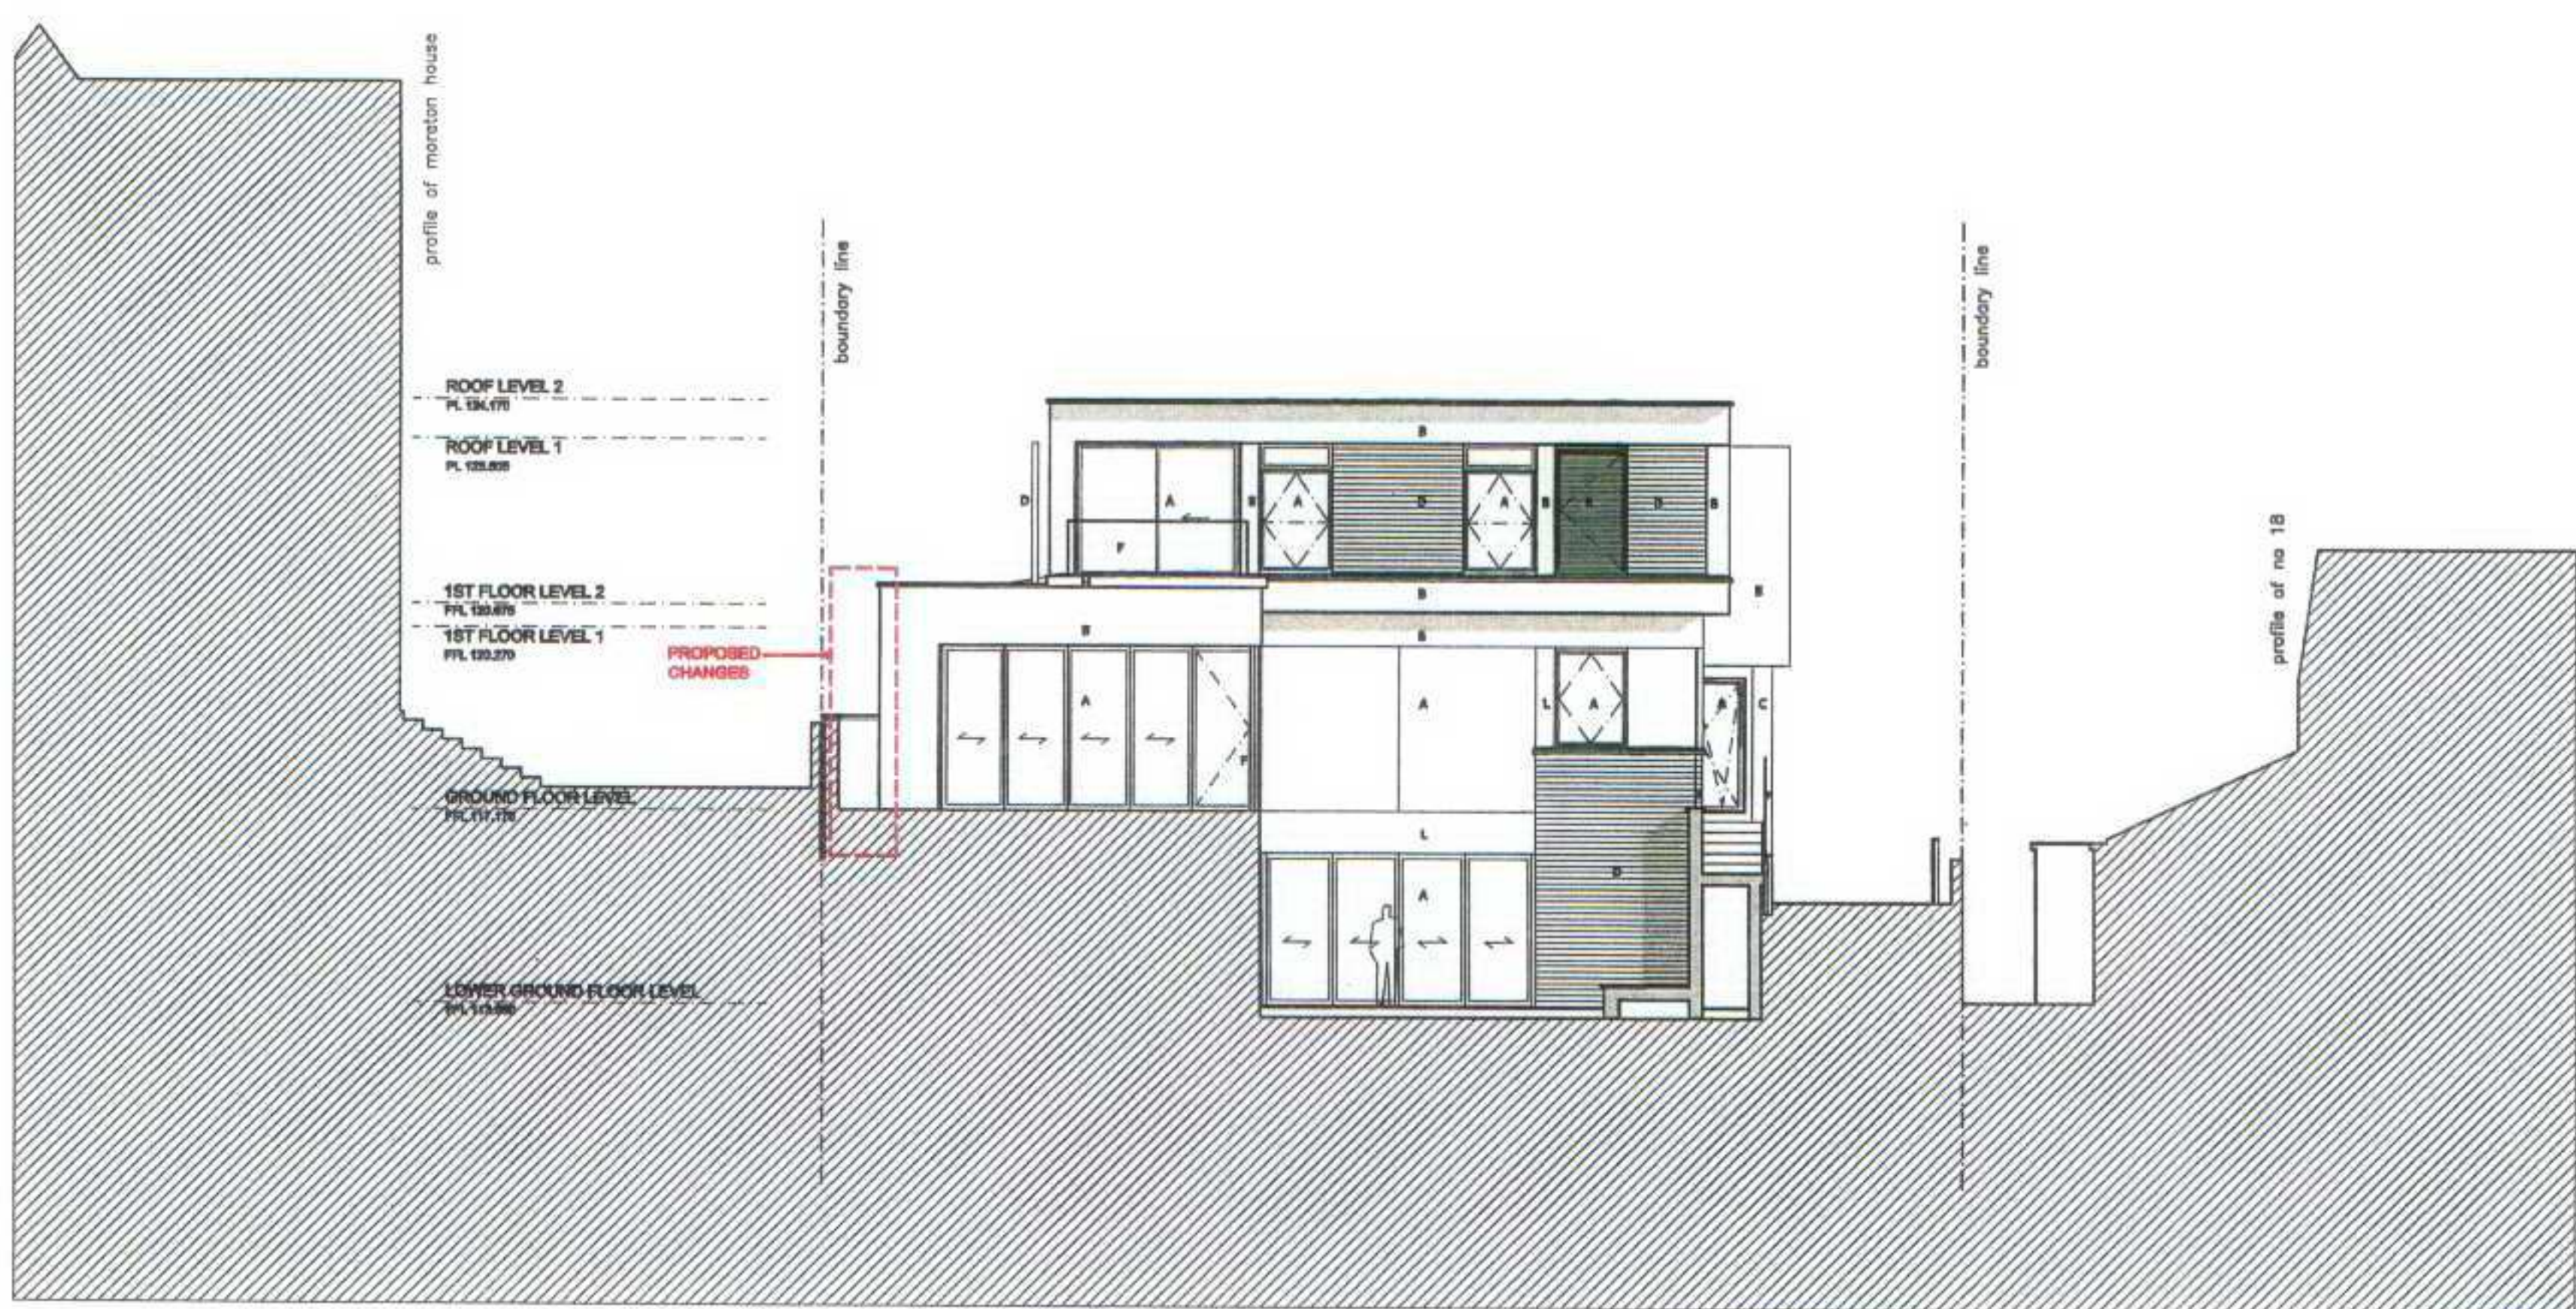

SECTION ELEVATION WEST

GENERAL NOTES:
THIS DRAWING IS COPYRIGHT OF KSR ARCHITECTS. THIS DRAWING MUST BE READ IN CONJUNCTION WITH THE DESIGNER'S RISK ASSESSMENT, SPECIFICATION AND ALL OTHER RELEVANT DOCUMENTATION AND DRAWINGS. KSR ARCHITECTS ACCEPT NO LIABILITY FOR ANY CORRUPTION, LOSS OR DAMAGE OF WHATEVER NATURE AND HOWEVER ARISING FROM ANY VARIATION MADE TO THIS DRAWING OR IN THE EXECUTION OF THE WORK TO WHICH IT RELATES WHICH HAS NOT BEEN REFERRED TO THEM AND THEIR APPROVAL OBTAINED.
DO NOT SCALE FROM THIS DRAWING OR THE COMPUTER DIGITAL DATA.
ONLY DIMENSIONS ARE TO BE USED. IF IN DOUBT ASK.

RECEIVED
23 MAR 2007

MATERIALS
A - PPC ALUMINIUM WINDOWS
B - RENDER
C - NATURAL OR RECONSTITUTED STONE
D - TIMBER CLADDING
E - STONE CLADDING
F - TONGUED AND GROoved GLASS BALUSTRADE
G - TIMBER DOOR
H - TIMBER DECKING
I - FROSTED GLASS
J - GLASS ROOFLIGHT
K - TIMBER LOUVERS OVER GLASS
L - METAL SPANDREL PANEL BETW. 2 WINDOWS

Project
18 HOLLY WALK
LONDON
NW3 6RA

ksr architects
14 Grosvenor Street, London W1A 0HD
Tel: 020 7561 2000
Fax: 020 7561 2000
Email: info@ksr.co.uk

ksr
architects

Section A-A
SECTION ELEVATION EAST
SECTION ELEVATION WEST
CHANGES MARKED IN RED

Rev	Notes	Drawn By	Checkd	By	Date	Scale	1:100 @ A1 / 1:200 @ A3
1	Initial	AK	AK	AK	MARCH 10	1:100 @ A1 / 1:200 @ A3	

Project
18 HOLLY WALK
LONDON
NW3 6RA

Section
SECTION A-A
SECTION ELEVATION EAST
SECTION ELEVATION WEST
CHANGES MARKED IN RED

Drawn By
HYK

Checkd By
HYK-P3-200 (changes)