
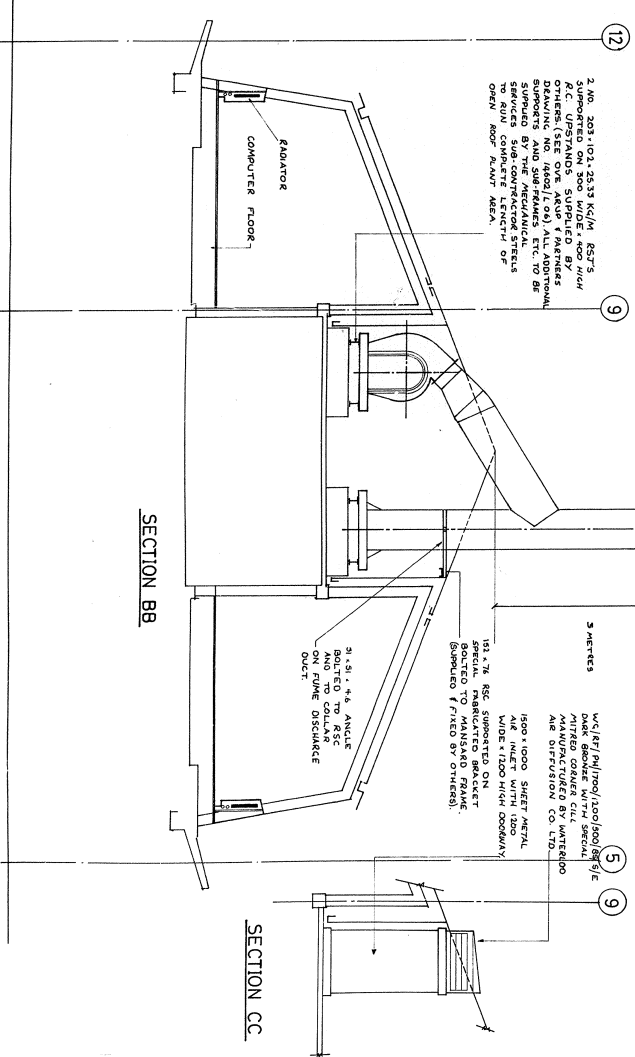


REVISIONS

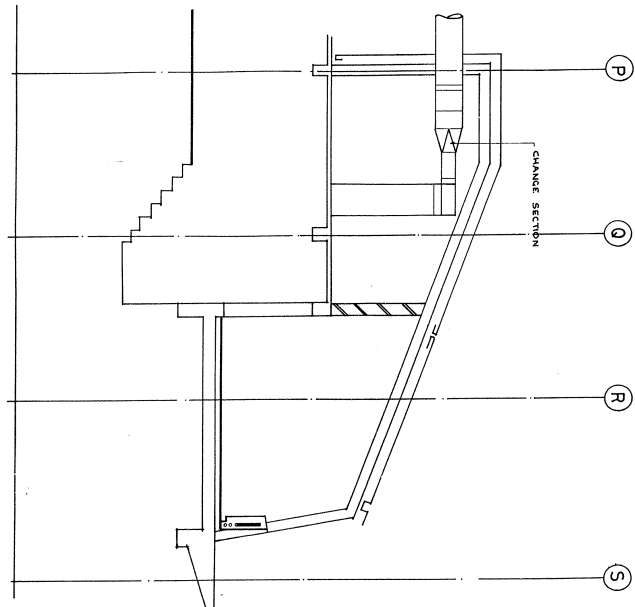

ALL FUME SUPPARED DISCHARGE
STACKS TERMINATES 3 METRES
ABOVE A.P.F.

3 METRES

WC (W/P) 100/120/120 (100/120) 1/2
DARK BRIDGE WITH SPECIAL
UNITED CORNER CILT
W/OUTFLOWS BY WATERBOD
AIR VENTILATION CO TO
1500 x 1000 SHEET METAL
AIR INLET WITH GOOD
DRAINAGE TO DOWN GROUND
151 x 76 RSC SUPPORTED ON
SPECIAL FABRICATED BRACKET
(SUPPLIED & FIXED BY OTHERS).

31.51 x 46 ANGLE
BOLTED TO RSC
ON FUME DISCHARGE
DUCT.

AS INSTALLED

THE BURSARS OFFICE UNIVERSITY COLLEGE LONDON GOWER STREET WC1E 6BT			
drawn: A.MCDONAR		Traced:	
date: NOVEMBER 85		scale: 1:50	
ENGINEERING BUILDING			
SECTIONS			
LAYOUT OF PLANT			
MECHANICAL SERVICES			
dwg no.	45	50	121