



PLAN


GARDEN

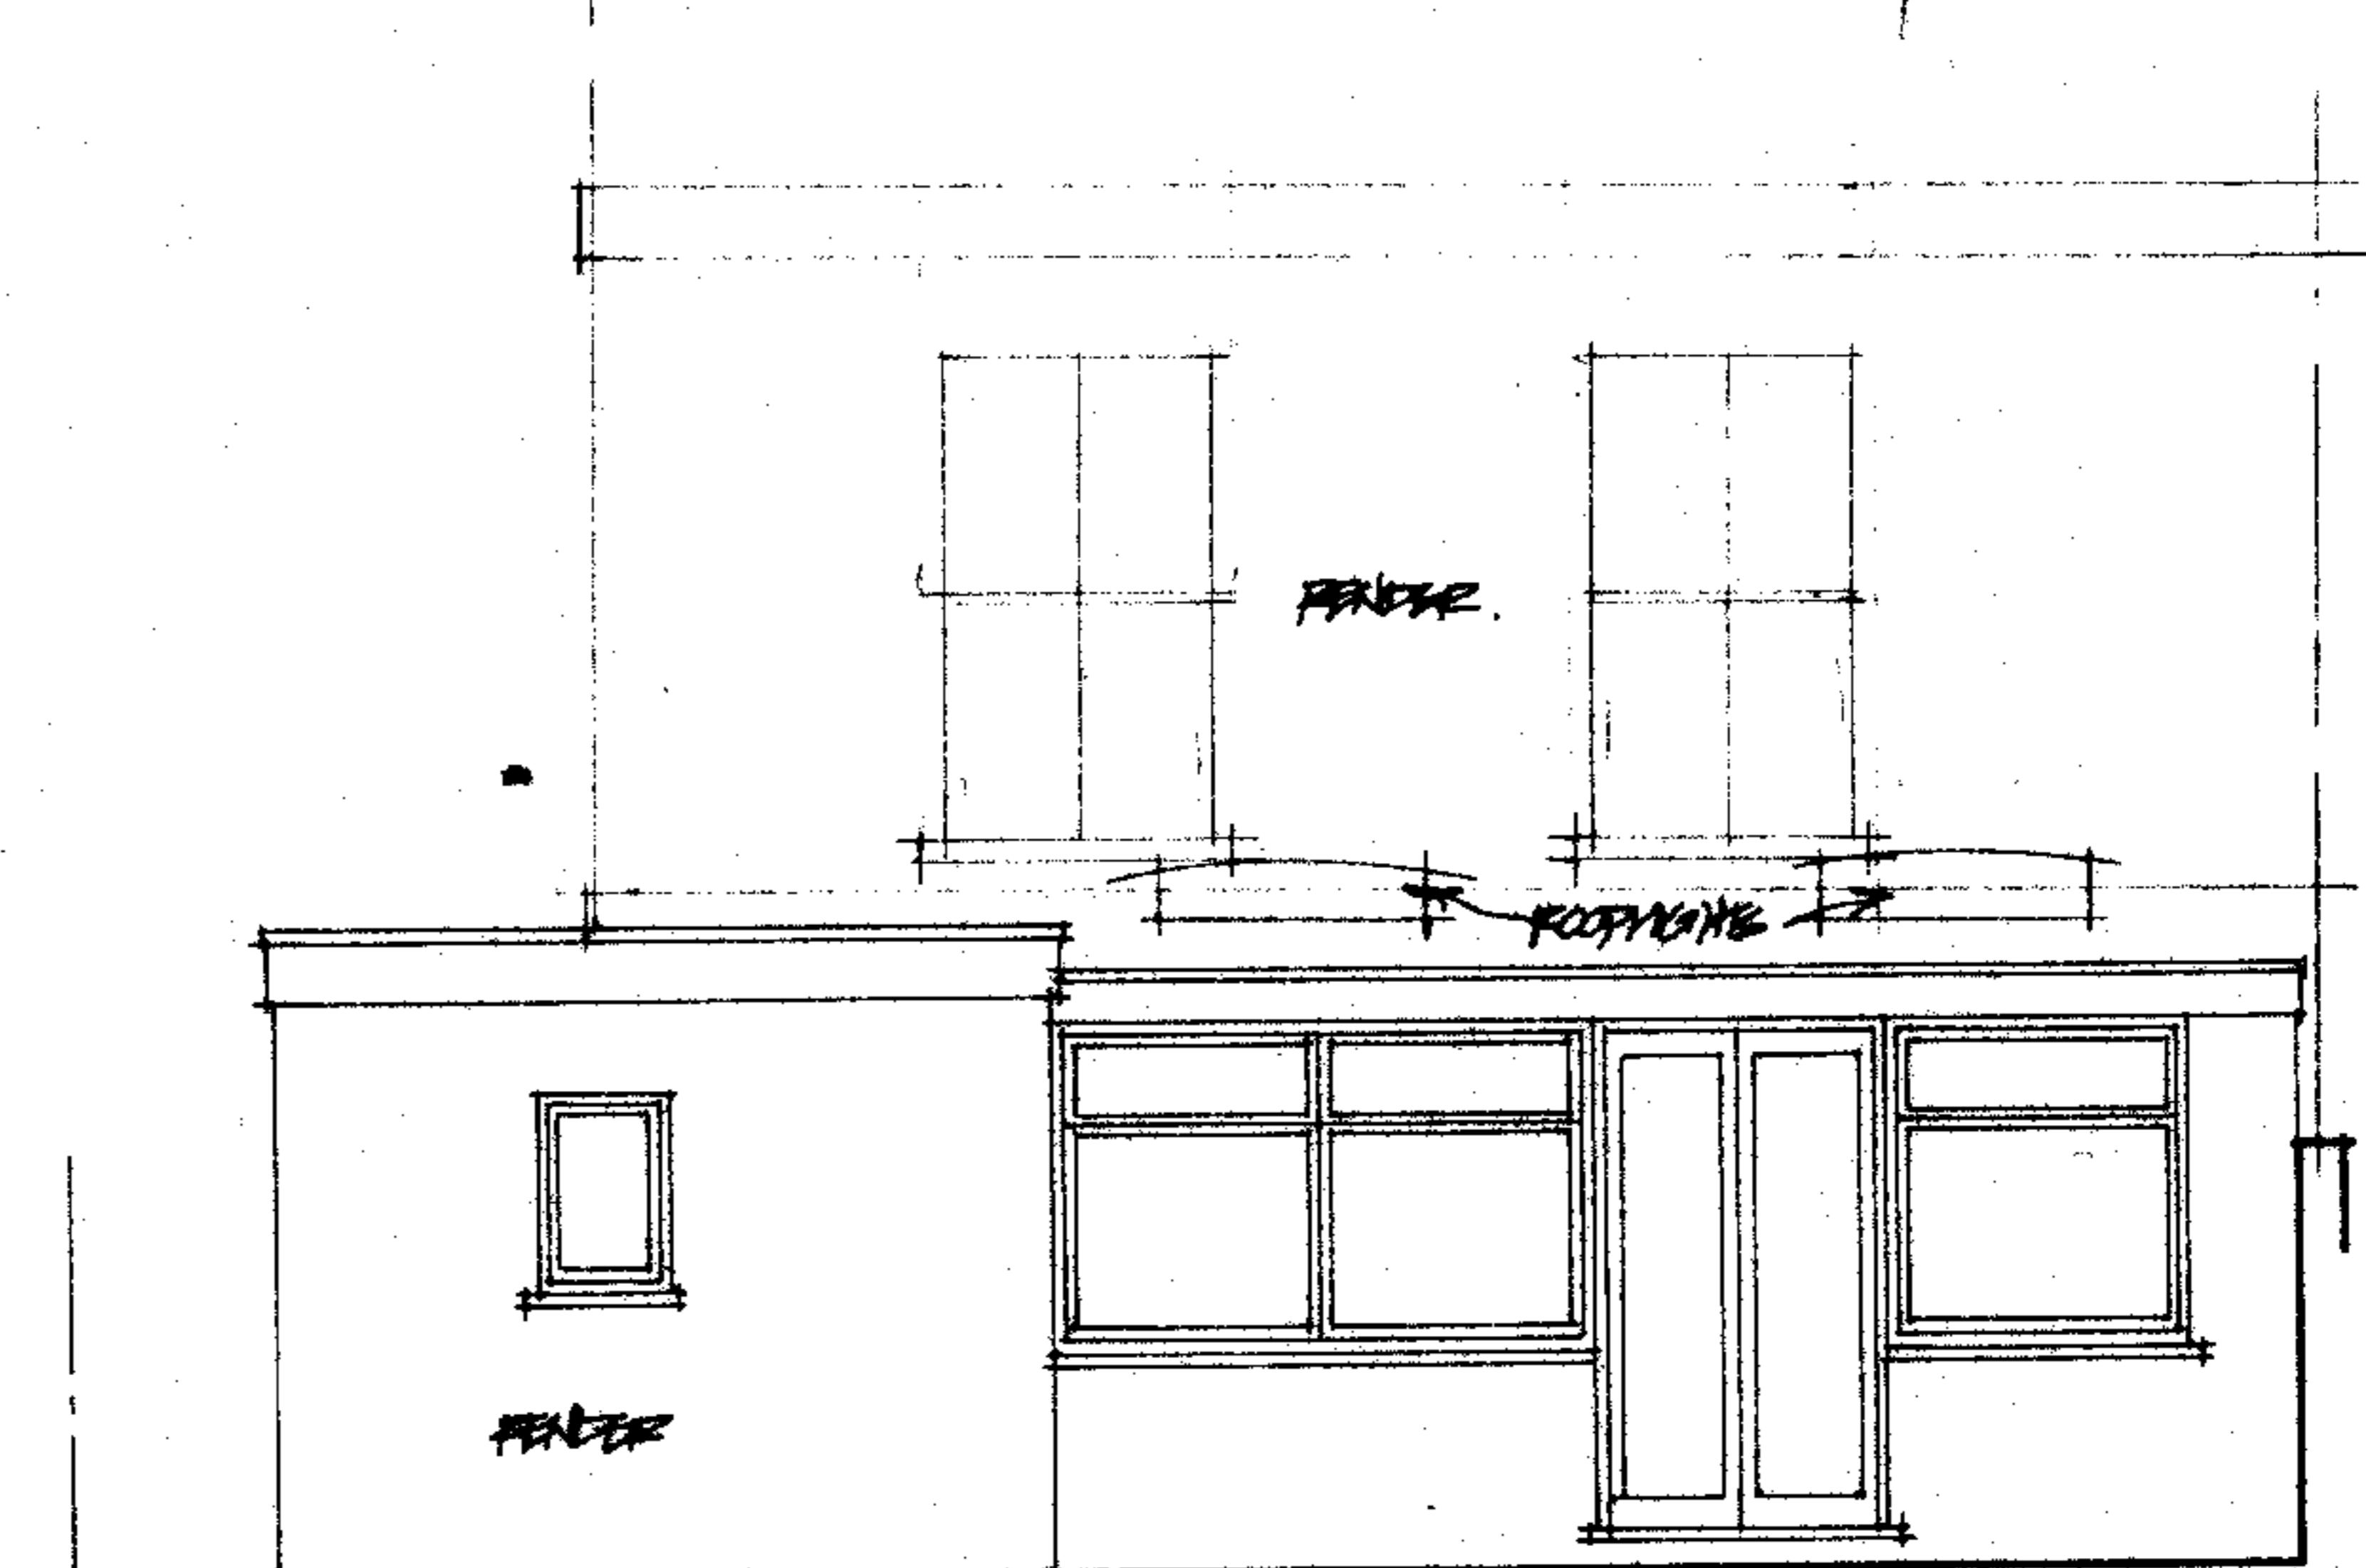

REAR ELEVATION

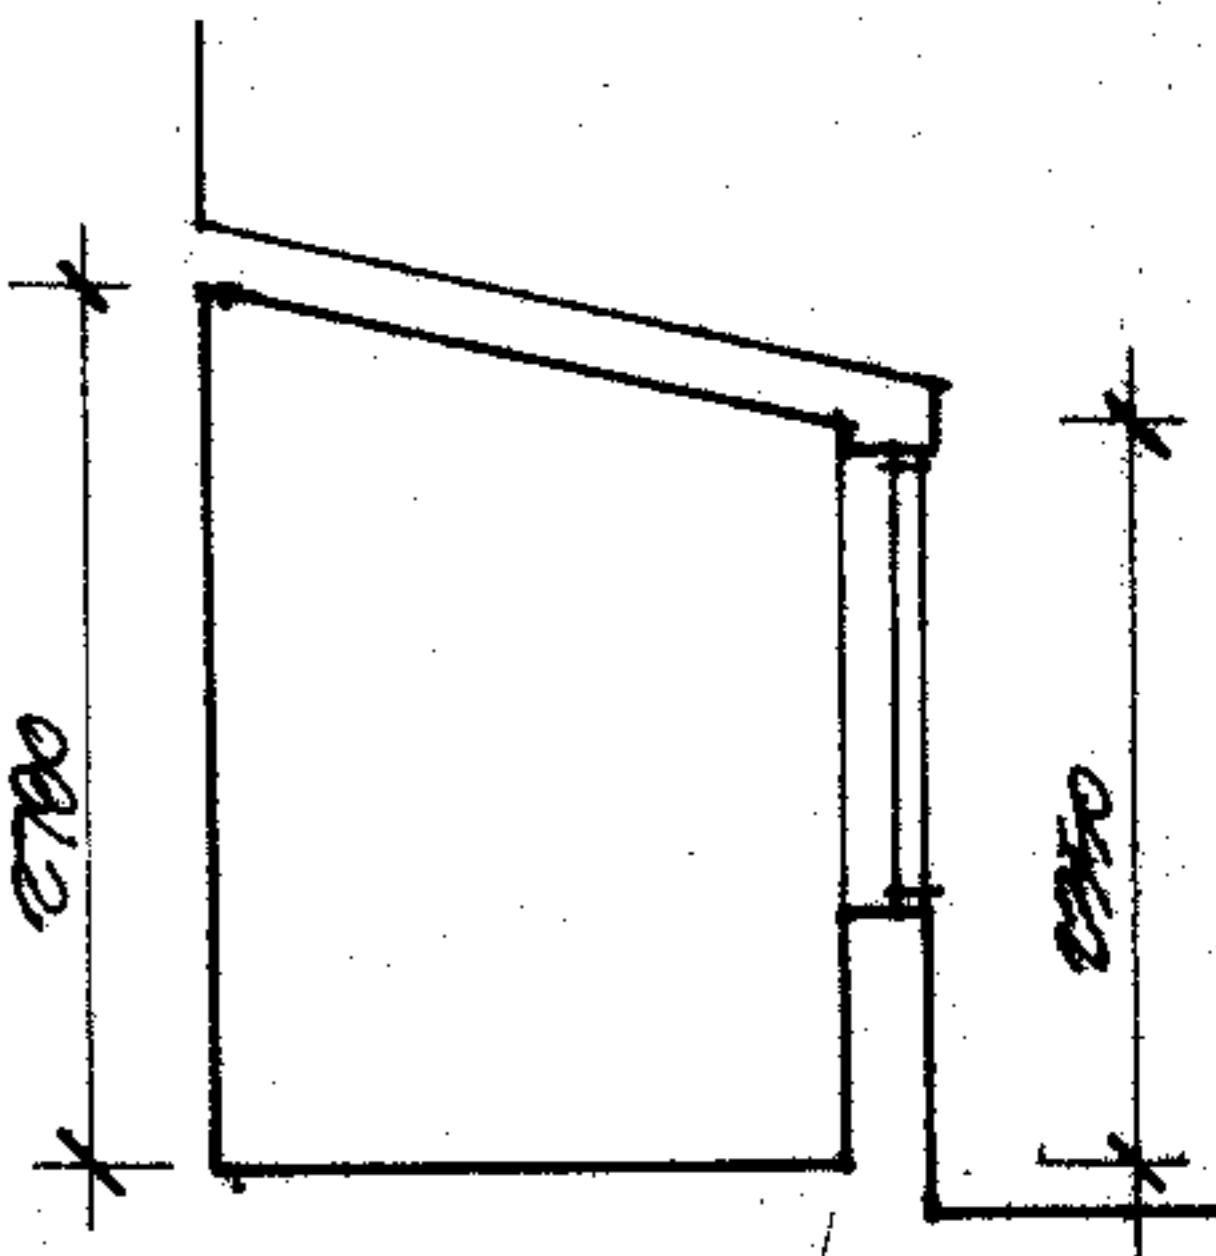

SECTION A-A


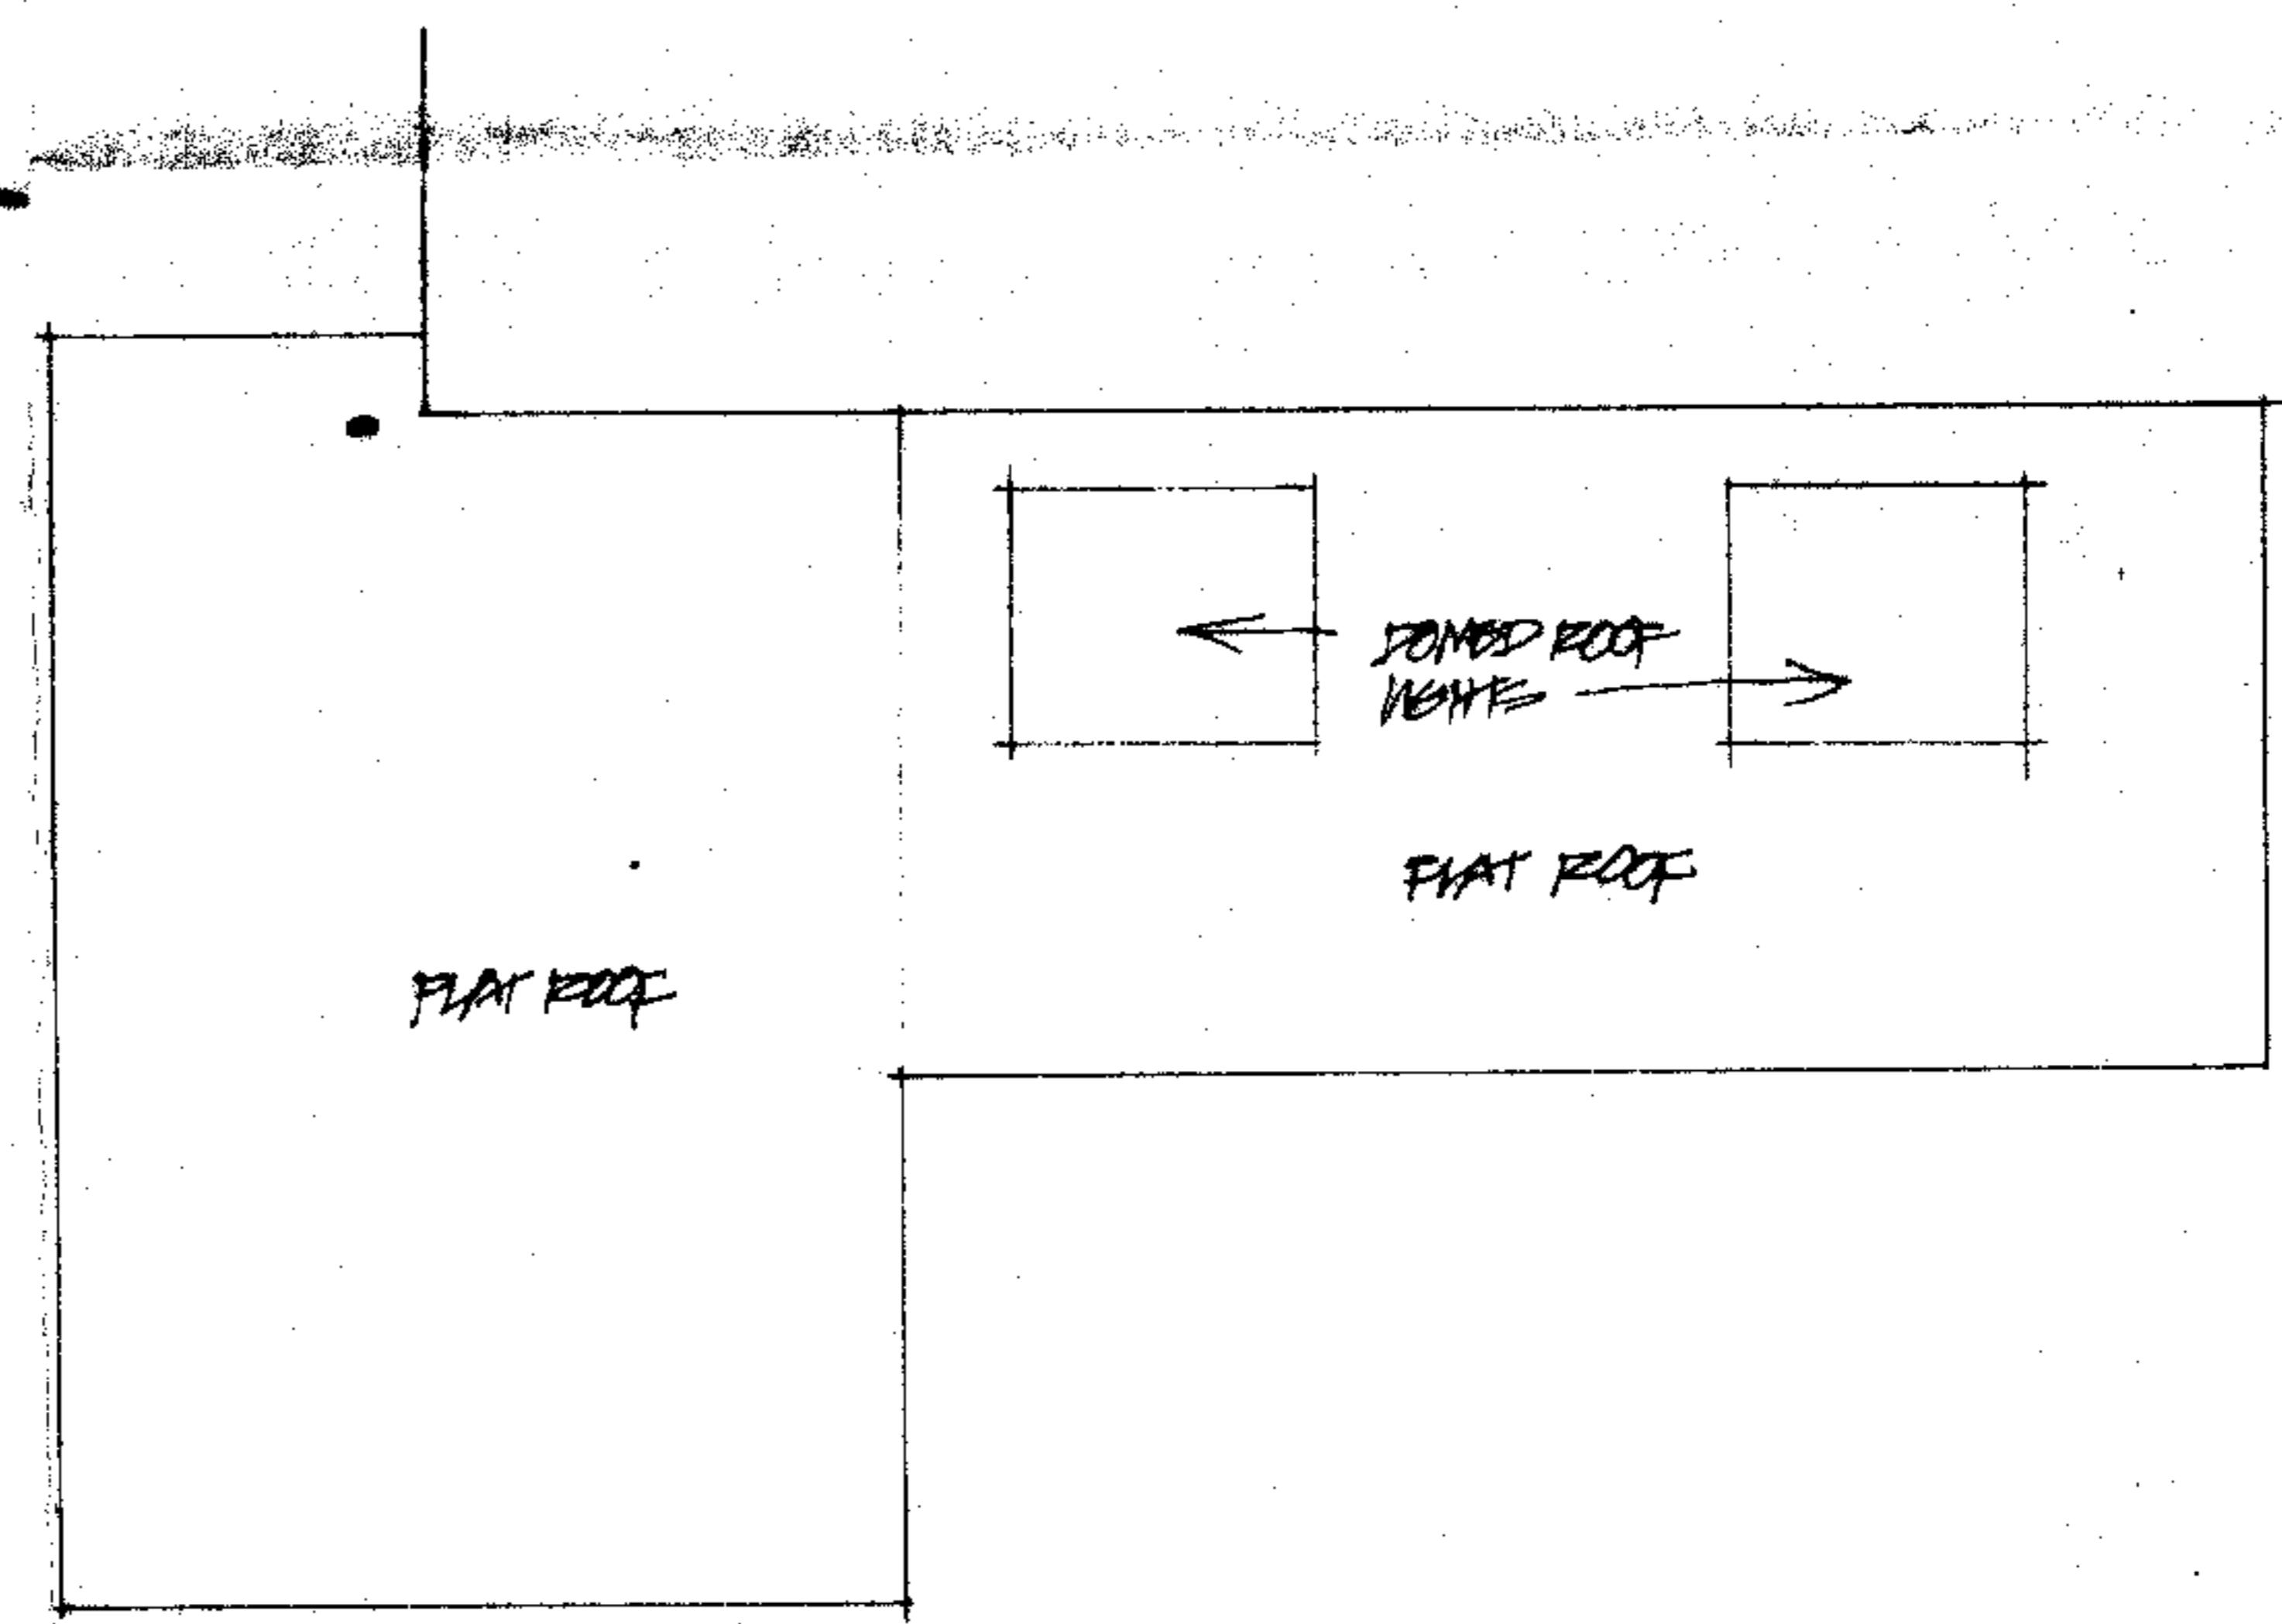


ROOF PLAN


DUAL BUILDING DESIGNS LTD  
21 PALMERSTON ROAD  
BOWES PARK  
LONDON NW2 8QS  
TEL/FAX 020 8921 1398

PROJECT  
GARDEN FLAT, 5 THURION ROAD,  
HAMPTON, LONDON  
DRAWING  
AS BUILT

SCALE 1:50	DATE AUG '06
DRWGR. D0633/1	

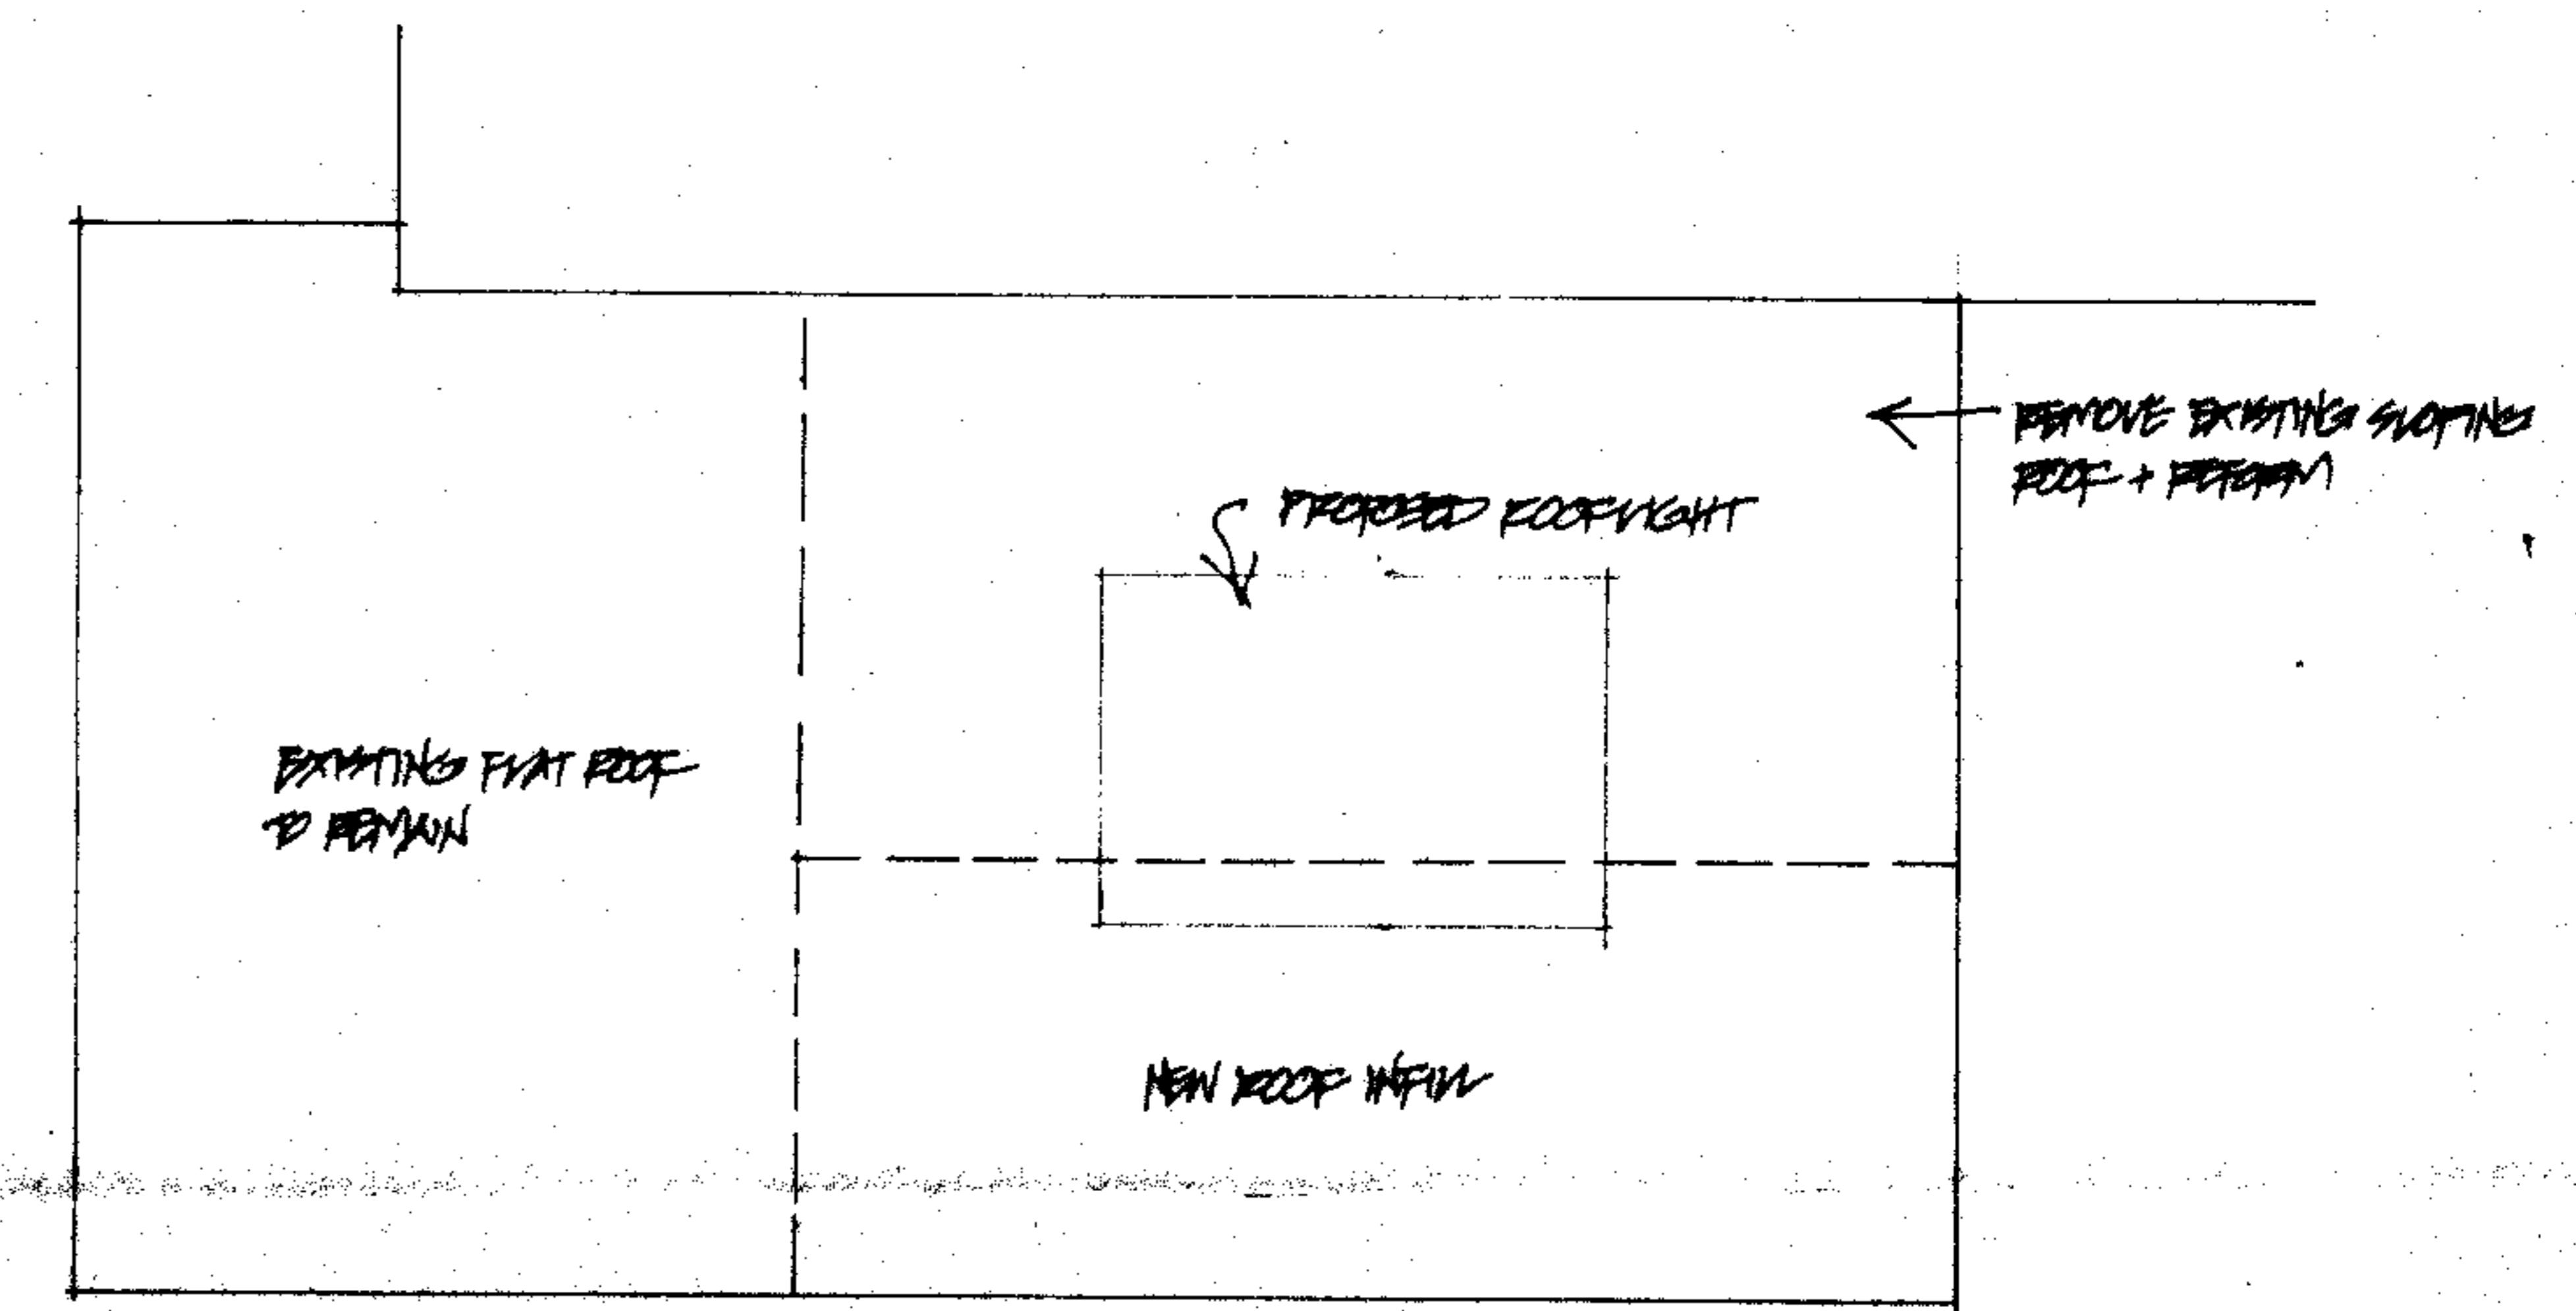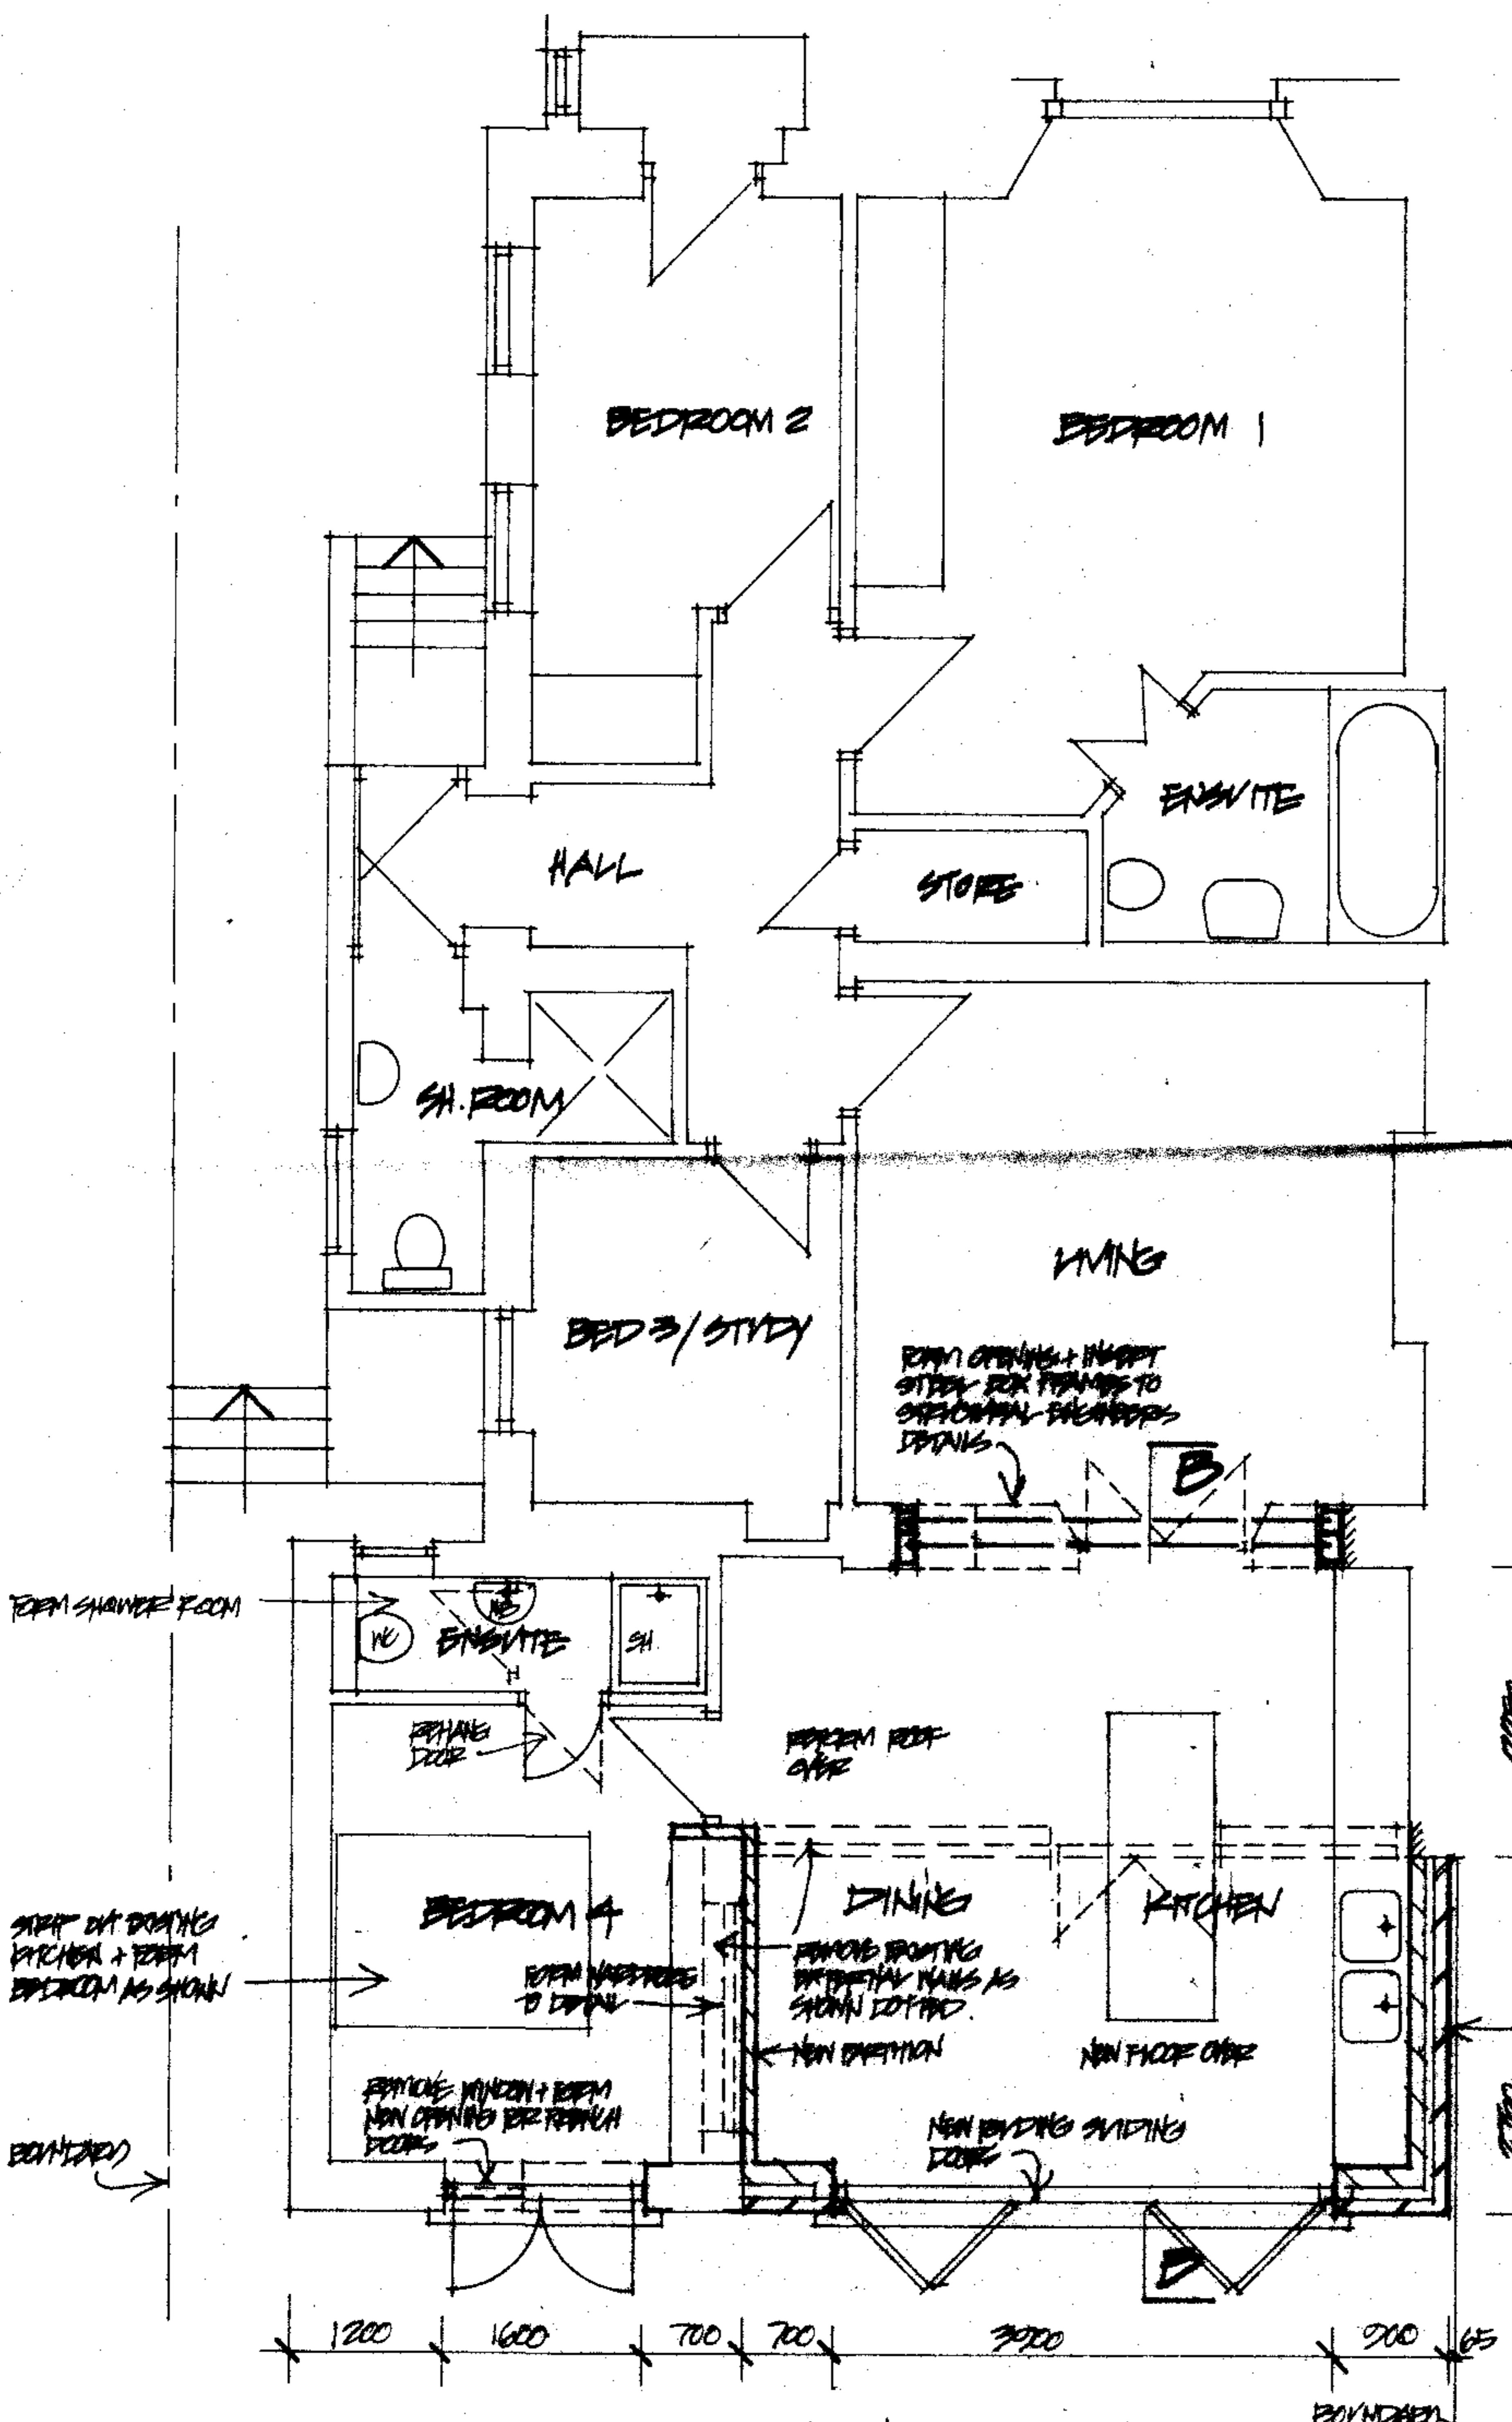


## **ROOF PLAN**

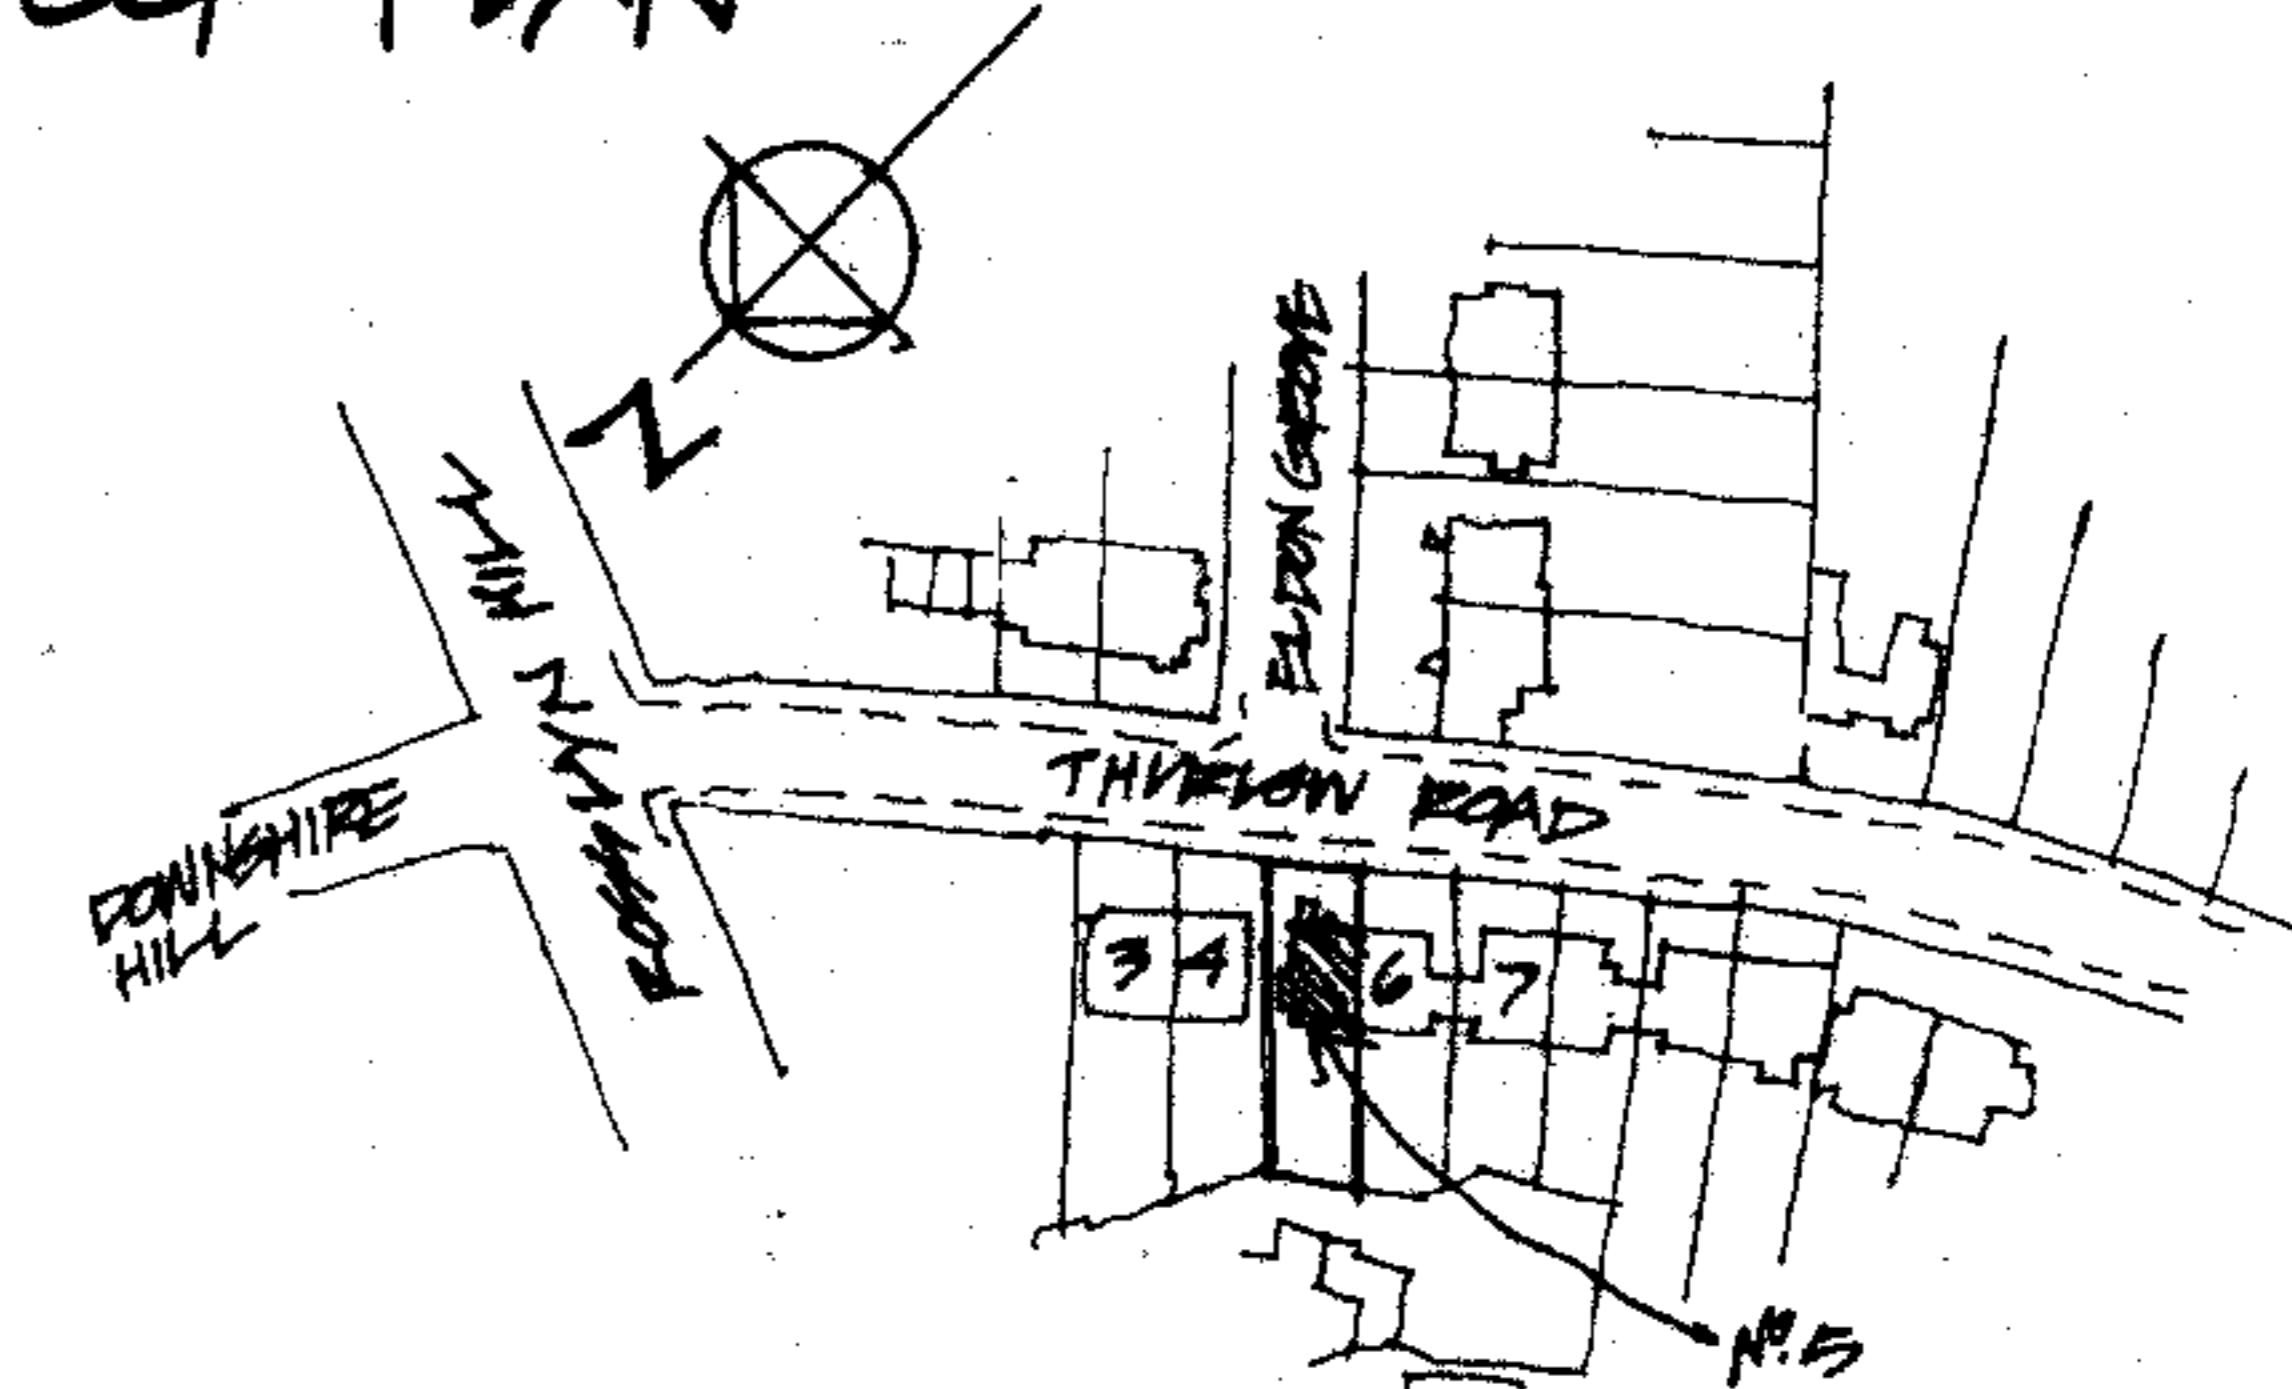

## LOCATION

DUAL BUILDING DESIGNS LTD 91 PALMERSTON ROAD DUNES PARK LONDON N22 8QH TEL/FAX 020 8800 1320	PROJECT GARDEN FLAT, 5 THURION ROAD, HAMPTON, LONDON	SCALE 1:50	DATE AUG '06
	DRAWING PROPOSED FLAT EXTENSION PLANS	DRAWING NO. D0633/2	

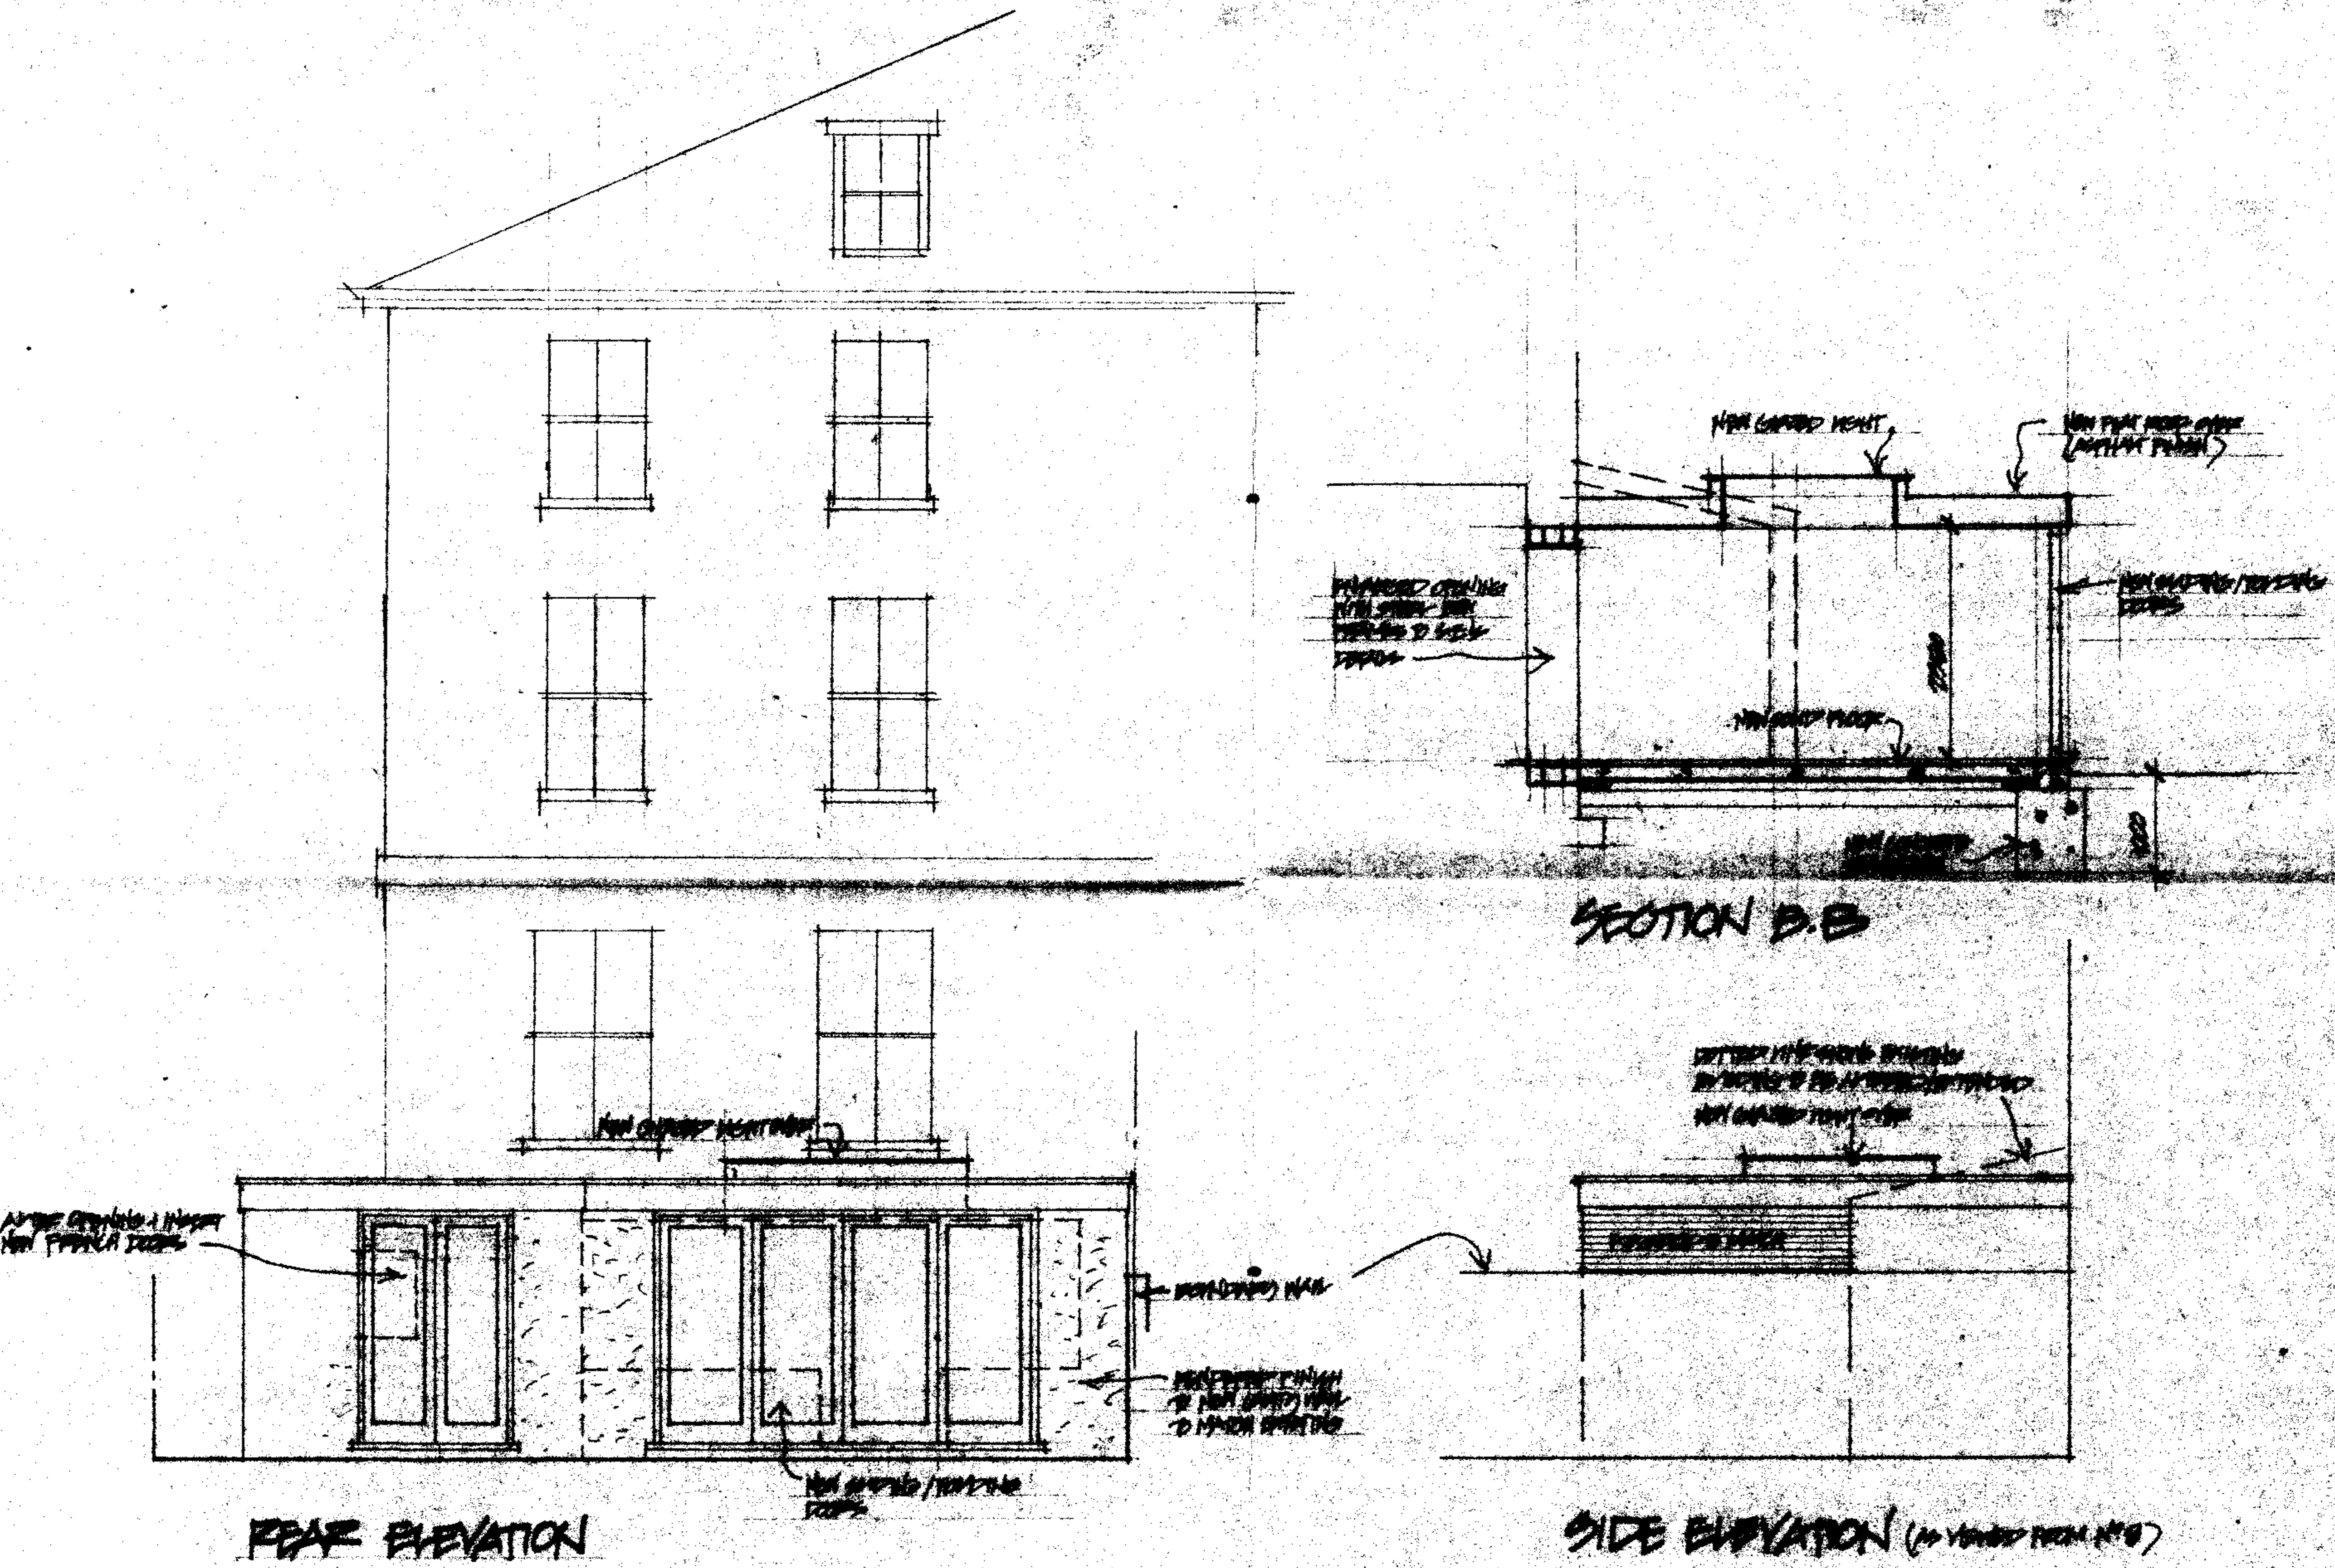

# PEACE PREDATION

THE BURGESS CLOUDS