



SIGN A scale 1:20



SECTION THROUGH SIGN A - 1:10

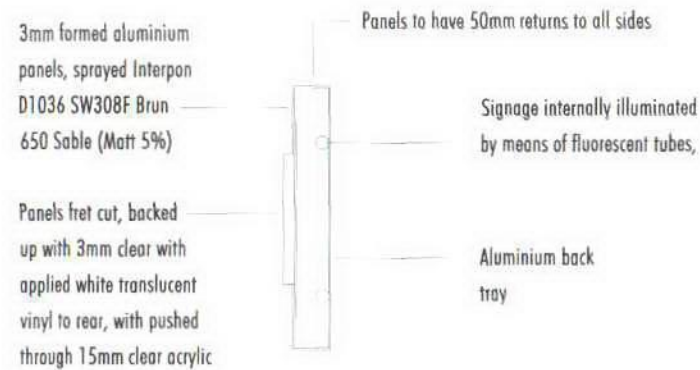

SIGN B scale 1:20

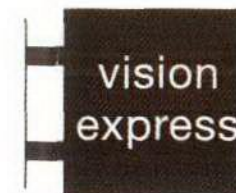

PROPOSED SIGNAGE



EXISTING SIGNAGE



SPECIFICATION

DIMENSIONS APPROX SUBJECT TO CONFIRMATION

SIGN A

DIMENSIONS (APPROX)

5000mm x 350mm

Letter Height 'i' - 175mm

DESCRIPTION

1 No Slimline internally illuminated fascia sign.
3mm formed aluminium panels, sprayed interpon D1036 SW308F Brun 650 Sable (Matt 5%) externally & white interpon 700 EW204F internally, fret cut with pushed through 15mm clear acrylic letters on clear carrier which is backed up with 2 layers of translucent vinyl. Letters to have polished edges.

SIGN B

DIMENSIONS

500mm x 500mm

DESCRIPTION

1 No double sided projecting sign.
Internally illuminated.

REVISION B 16-10-2006 CW

SIGN A - Changed from individual internally illuminated letters on formed aluminium fascia panels to slimline internally illuminated box unit. Section through added.

REVISION A 04-07-2006 CW

SIGN A - Changed from internally illuminated box unit to individual internally illuminated letters on formed aluminium fascia panels.


**BUTTERFIELD
SIGNS**

174 SUNBRIDGE ROAD, BRADFORD,
WEST YORKSHIRE. BD1 2RZ.
Tel : +44 (0) 1274 722244
Fax : +44 (0) 1274 848998
www.butterfieldsigns.co.uk


This document is the property of Butterfield Signs Ltd who own the copyright therein. The information in this document is given in confidence and without the written consent of Butterfield Signs Ltd, given by contract or otherwise the document must not be copied, reprinted or reproduced in any material form either wholly or in part nor must the contents of the document or any method or technique available therefrom be disclosed to any third party



CLIENT/SITE	VISION EXPRESS 37-39 High Holborn, London.		
DATE	02 May 2006	SCALE	AS SHOWN @ A3
SALES CONT.	JDS / JM	DRAWN BY	CW
JOB NO.	61671	DWG NO.	Vision Express / 049 / 2006 B

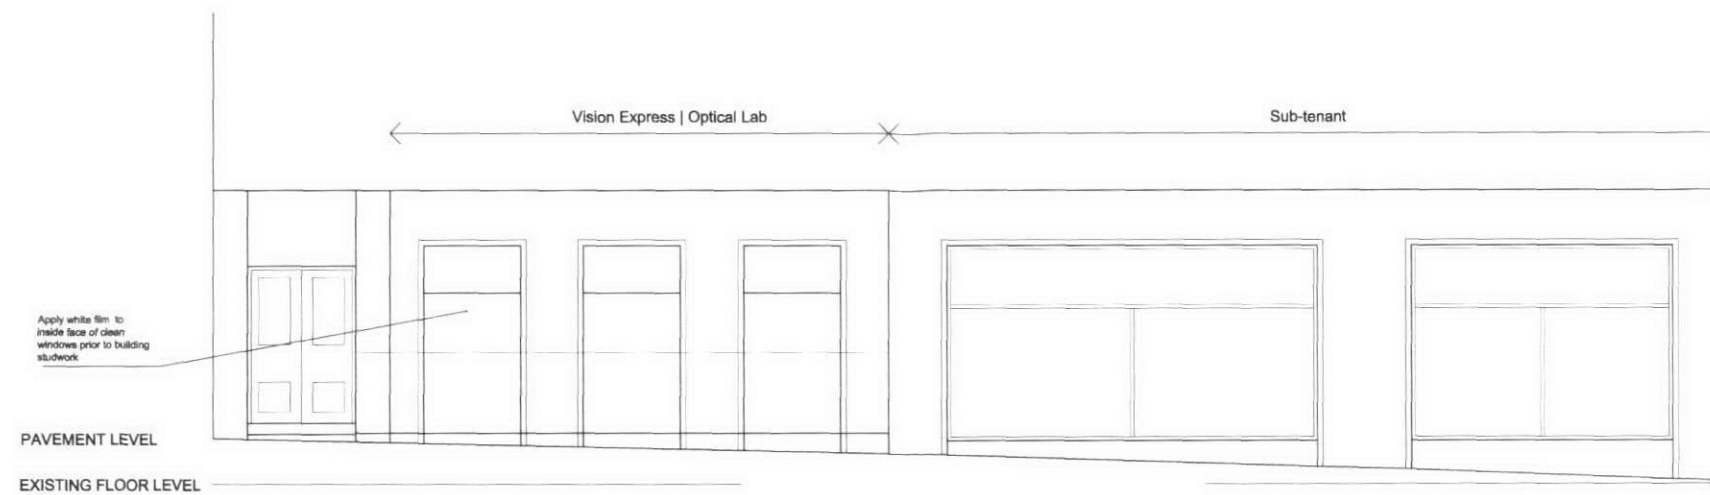

WARWICK CT. ELEVATION

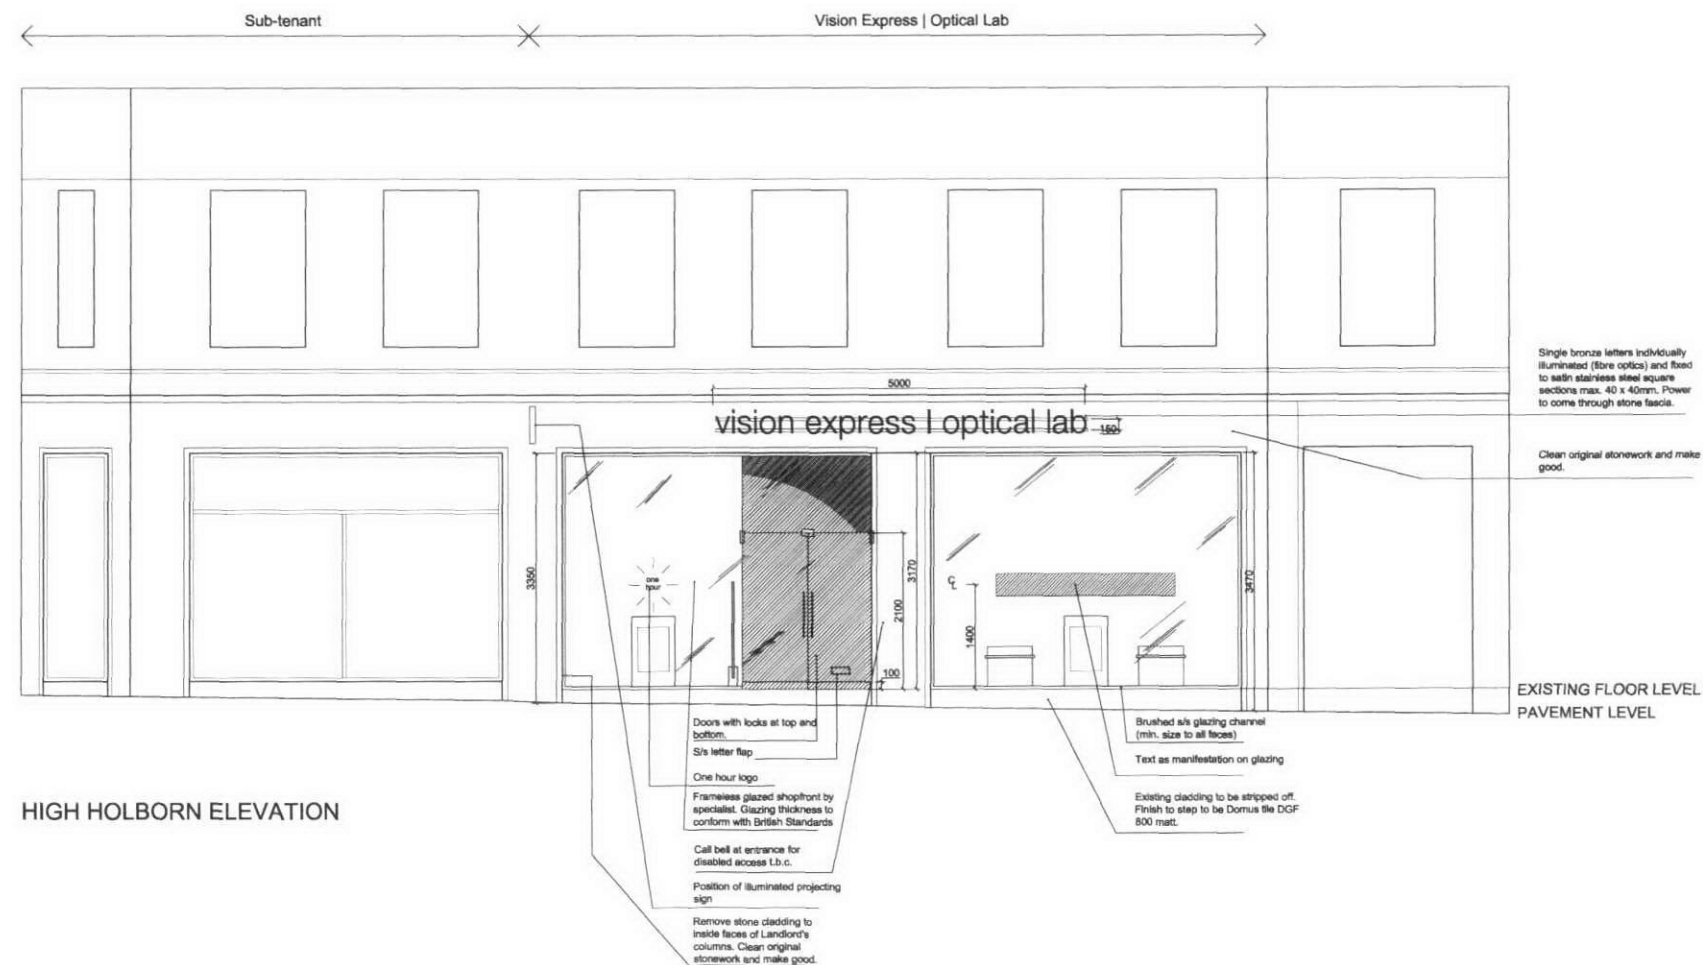

HIGH HOLBORN ELEVATION

Notes:
Do not scale from this drawing.
All dimensions to be checked on site.

Rev	Date	Description
H	16.11.00	Door hatch modified
I	14.12.00	Lenses on glazing omitted
J	25.01.01	Issued As Built

Rev	Date	Description
E	30.10.00	Notes added
F	06.11.00	S/s to face of shop front step, notes added.
G	14.11.00	Domus tile DGF 800 matt to face of shop front step, shop front signage fixed to s/s sections and illuminated by fibre optics.

Rev	Date	Description
A	9.08.00	Amended according to ground floor plan.
B	13.09.00	Existing step to shop front retained. Roller shutter added and doors recessed.
C	15.09.00	Roller shutter omitted and doors modified
D	26.09.00	Entry doors relocated and lobby reintroduced.

CHILD•GRADDON•LEWIS
CHARTERED ARCHITECTS
33 Fitzroy Street
London W1T 6EU
Telephone: (+44) 020 7636 2822 Fax: (+44) 020 7636 8377
e-mail: cgl@btinternet.com

Title: Shopfront Elevations				
Project: Vision Express Optical Lab 37-39 High Holborn				
Scale	Date	Drawn	Checked	Rev
1:50 @ A1	Aug 2000	cb		J
0042/05				