



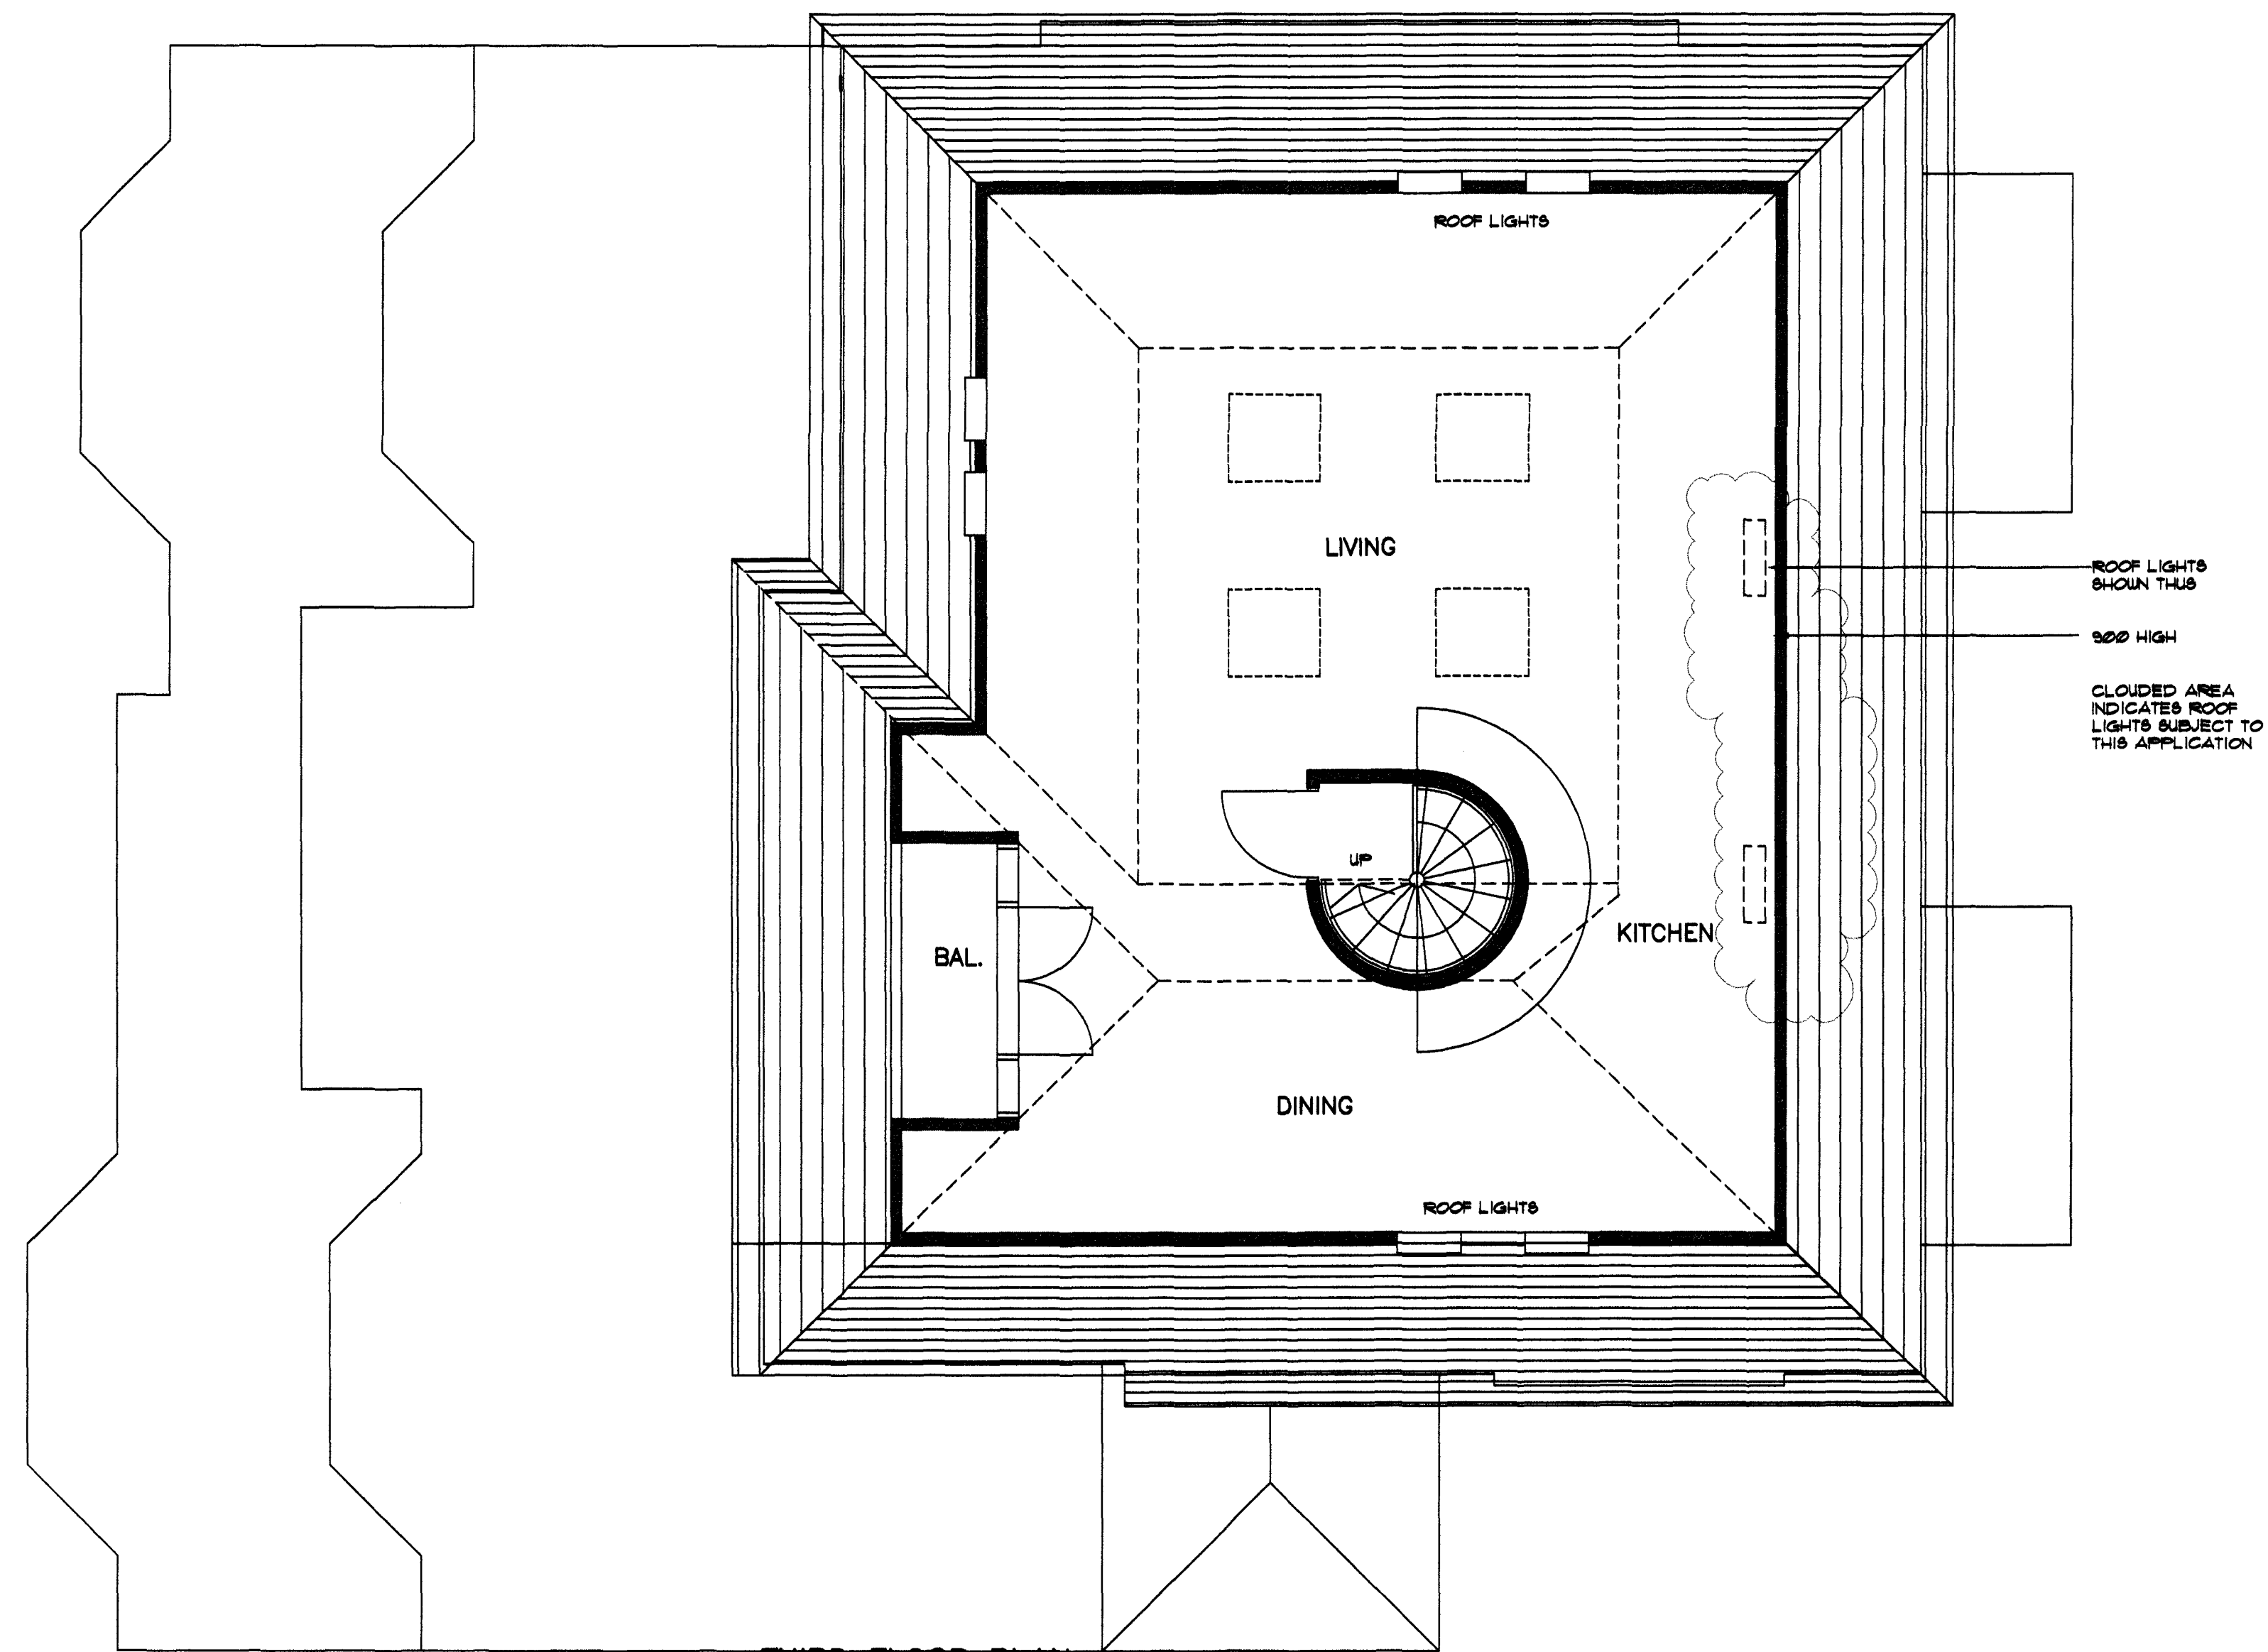

THIRD FLOOR PLAN

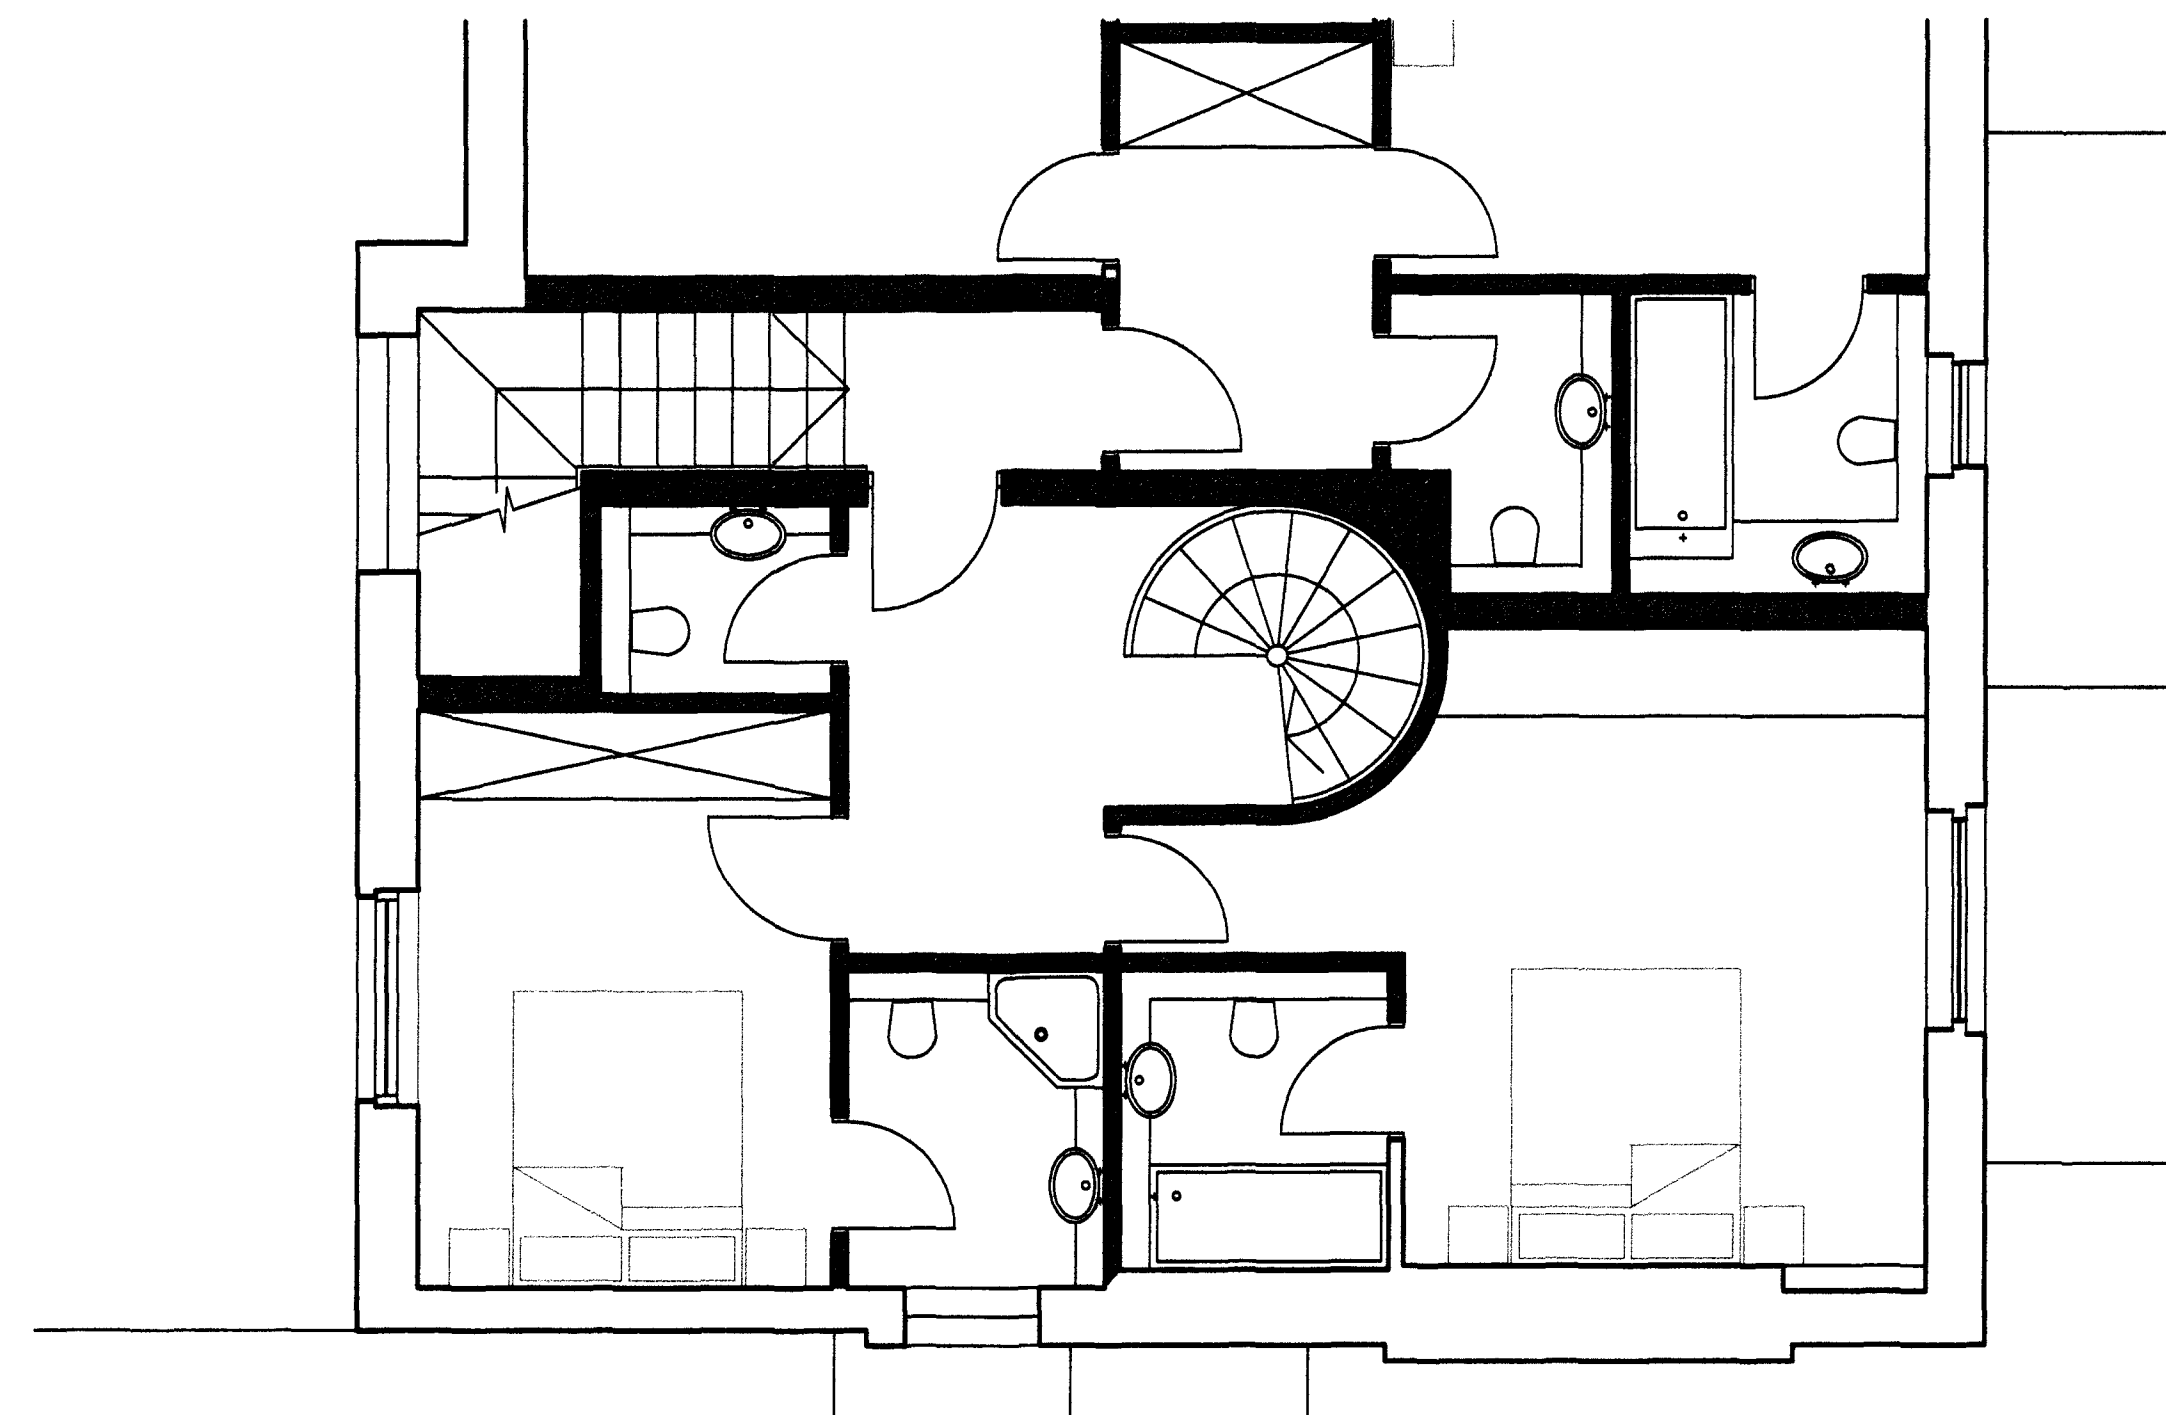

SECOND FLOOR PART PLAN



GCK ARCHITECTS LIMITED

6 FIELD WAY
CAMBRIDGE
CB1 8RW

TEL 01223 411631
MOBILE 07860 680239
FAX 01223 512078

Project: 27 FITZJOHNS AVENUE, LONDON NW3

Title: FLOOR PLANS-ROOF LIGHTS AS BUILT

Scale 1:50@A1

Date SEPT 2006

Project No:

Dwg Rev

Type Elem No.

78(PL).18



GCK ARCHITECTS LIMITED

Project: 27 FITZJOHNS AVENUE, LONDON NW3

Project No:

6 FIELD WAY
CAMBRIDGE
CB1 8RW

Title: FRONT ELEVATION - ROOF LIGHTS AS BUILT

Dwg Rev


TEL 01223 411631
MOBILE 07880 880239
FAX 01223 512078

Scale 1:50@A1

Date SEPT 2006

Type Elem No.

78(PL).19

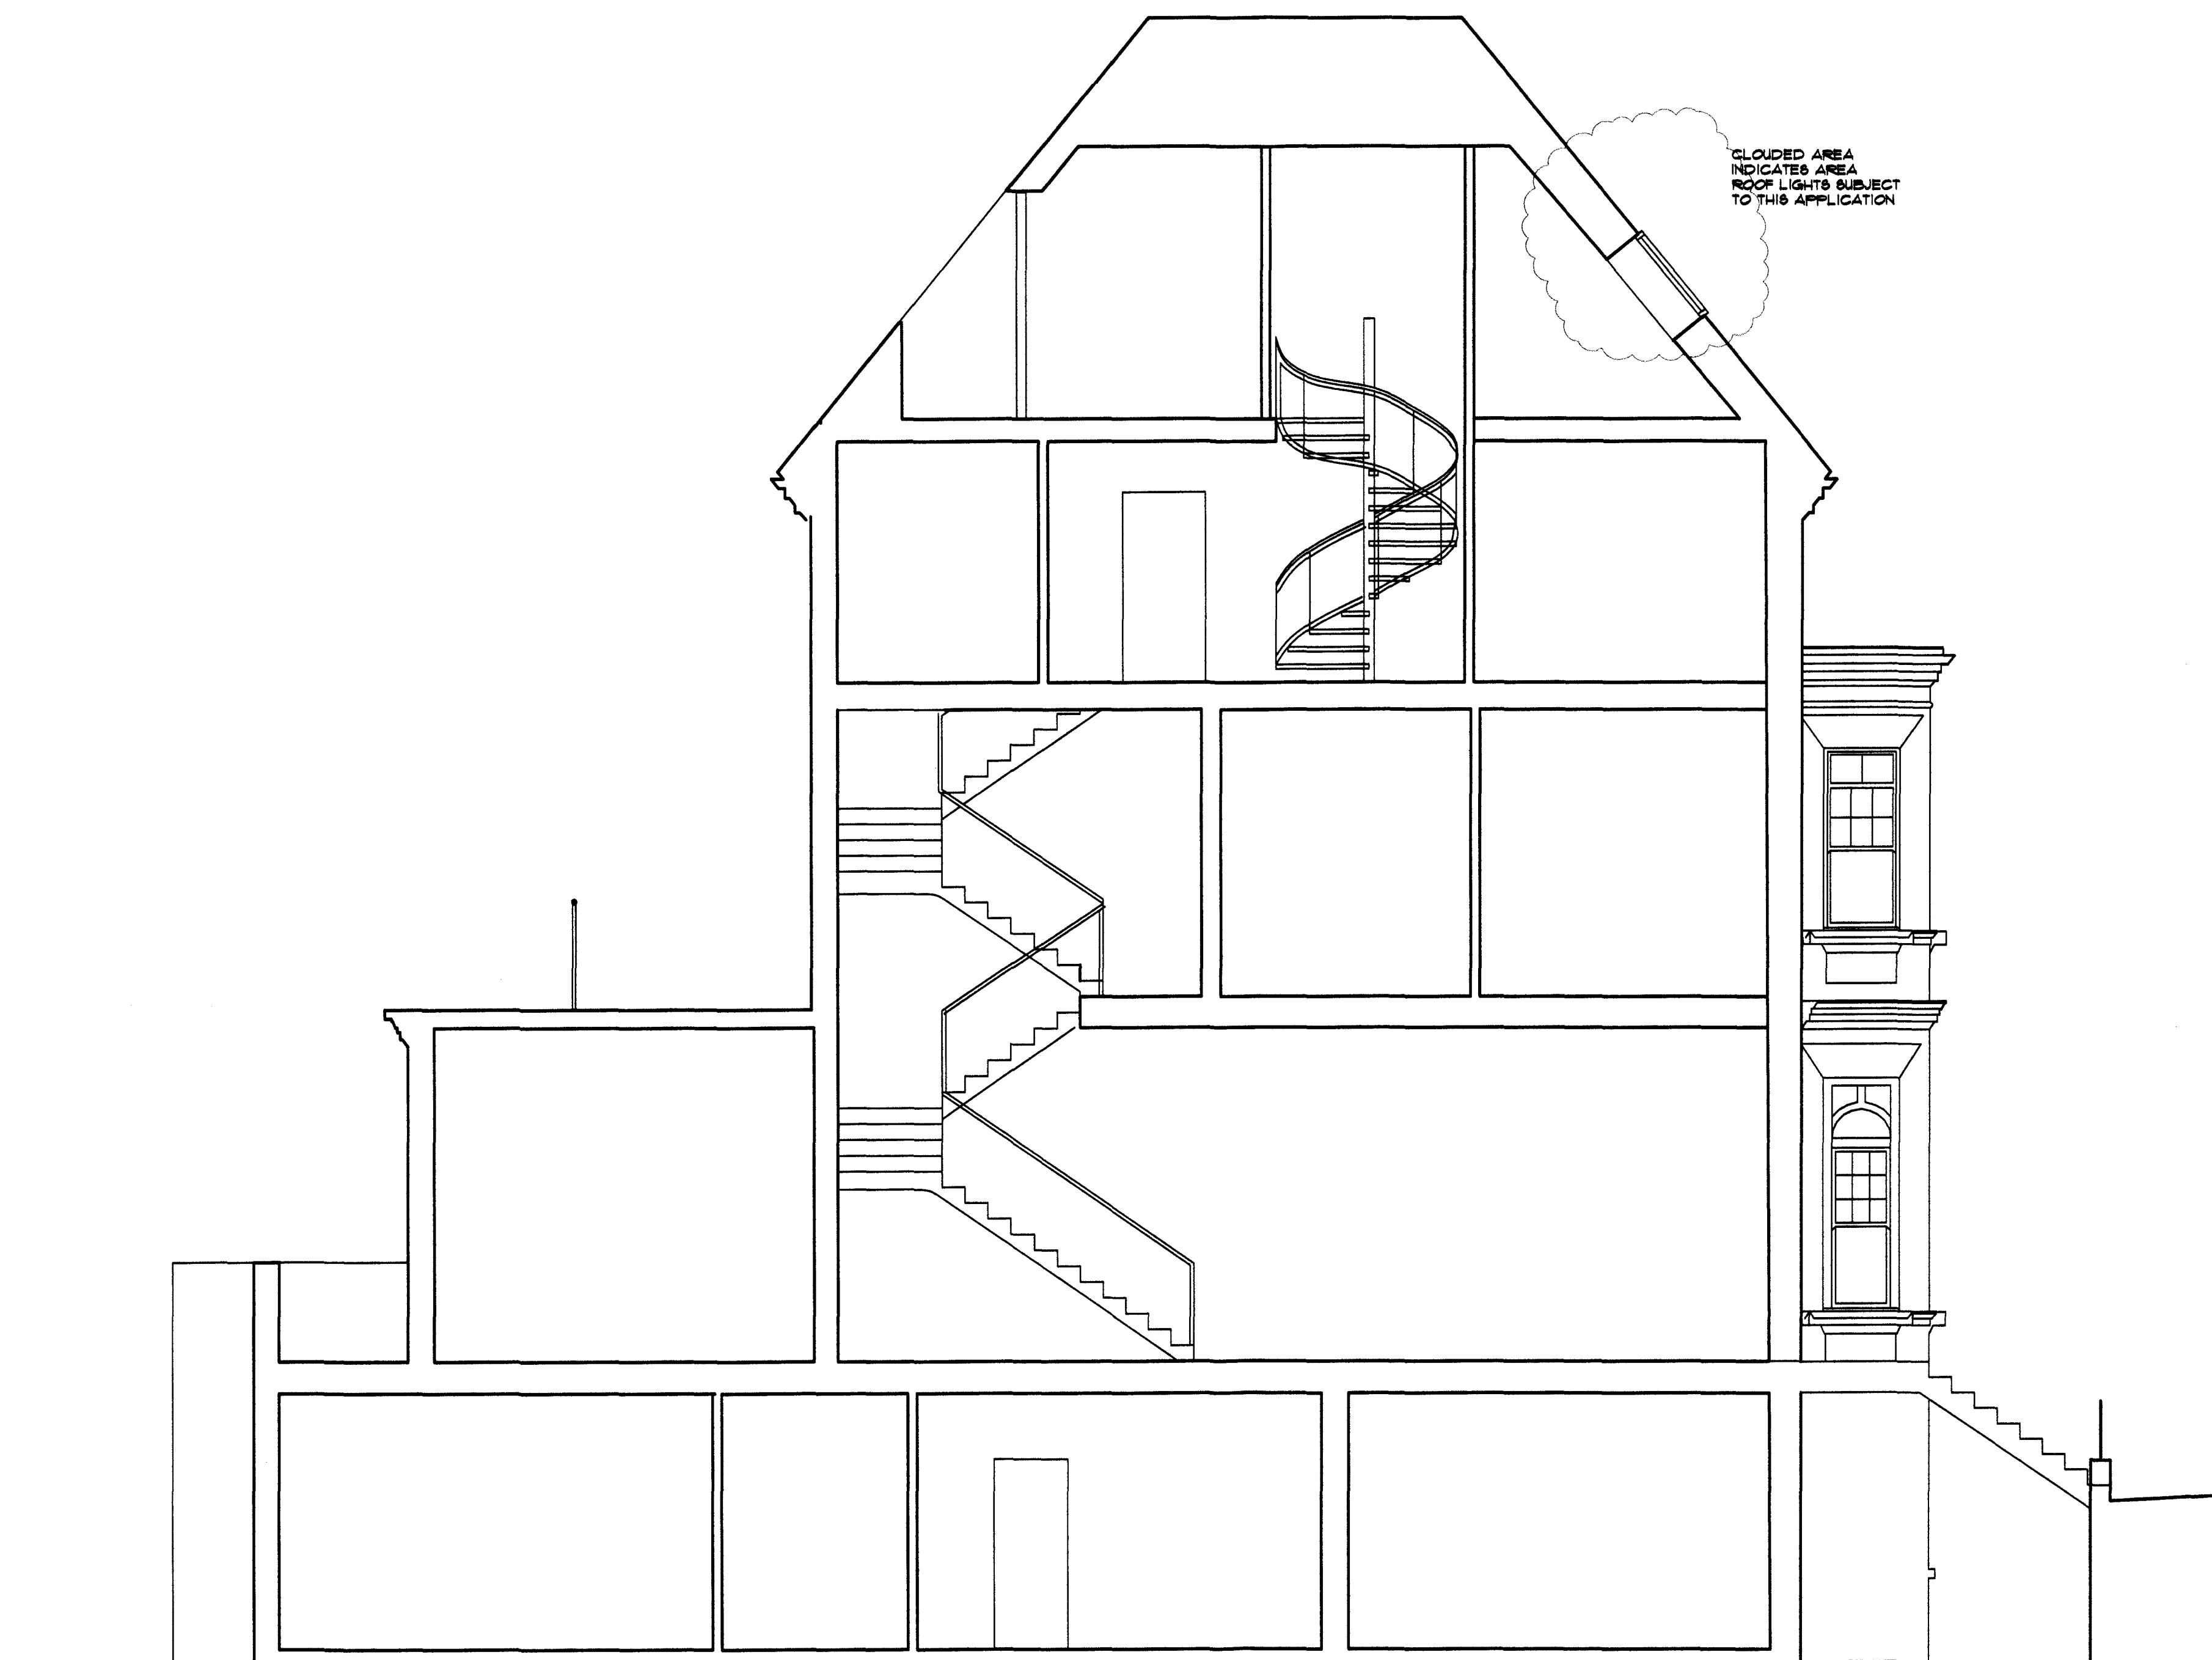

6 FIELD WAY
CAMBRIDGE
CB1 8RW

TEL 01223 411631
MOBILE 07860 650239
FAX 01223 512076

GCK ARCHITECTS LIMITED

Project: 27 FITZJOHNS AVENUE, LONDON NW3

Project No:

Dwg Rev

Title: SECTION - SHOWING ROOFLIGHTS AS BUILT

Type Elem No.

Scale 1:50@A1

Date SEPT 2006

78(PL).24