




SOUTH ELEVATION AS PROPOSED

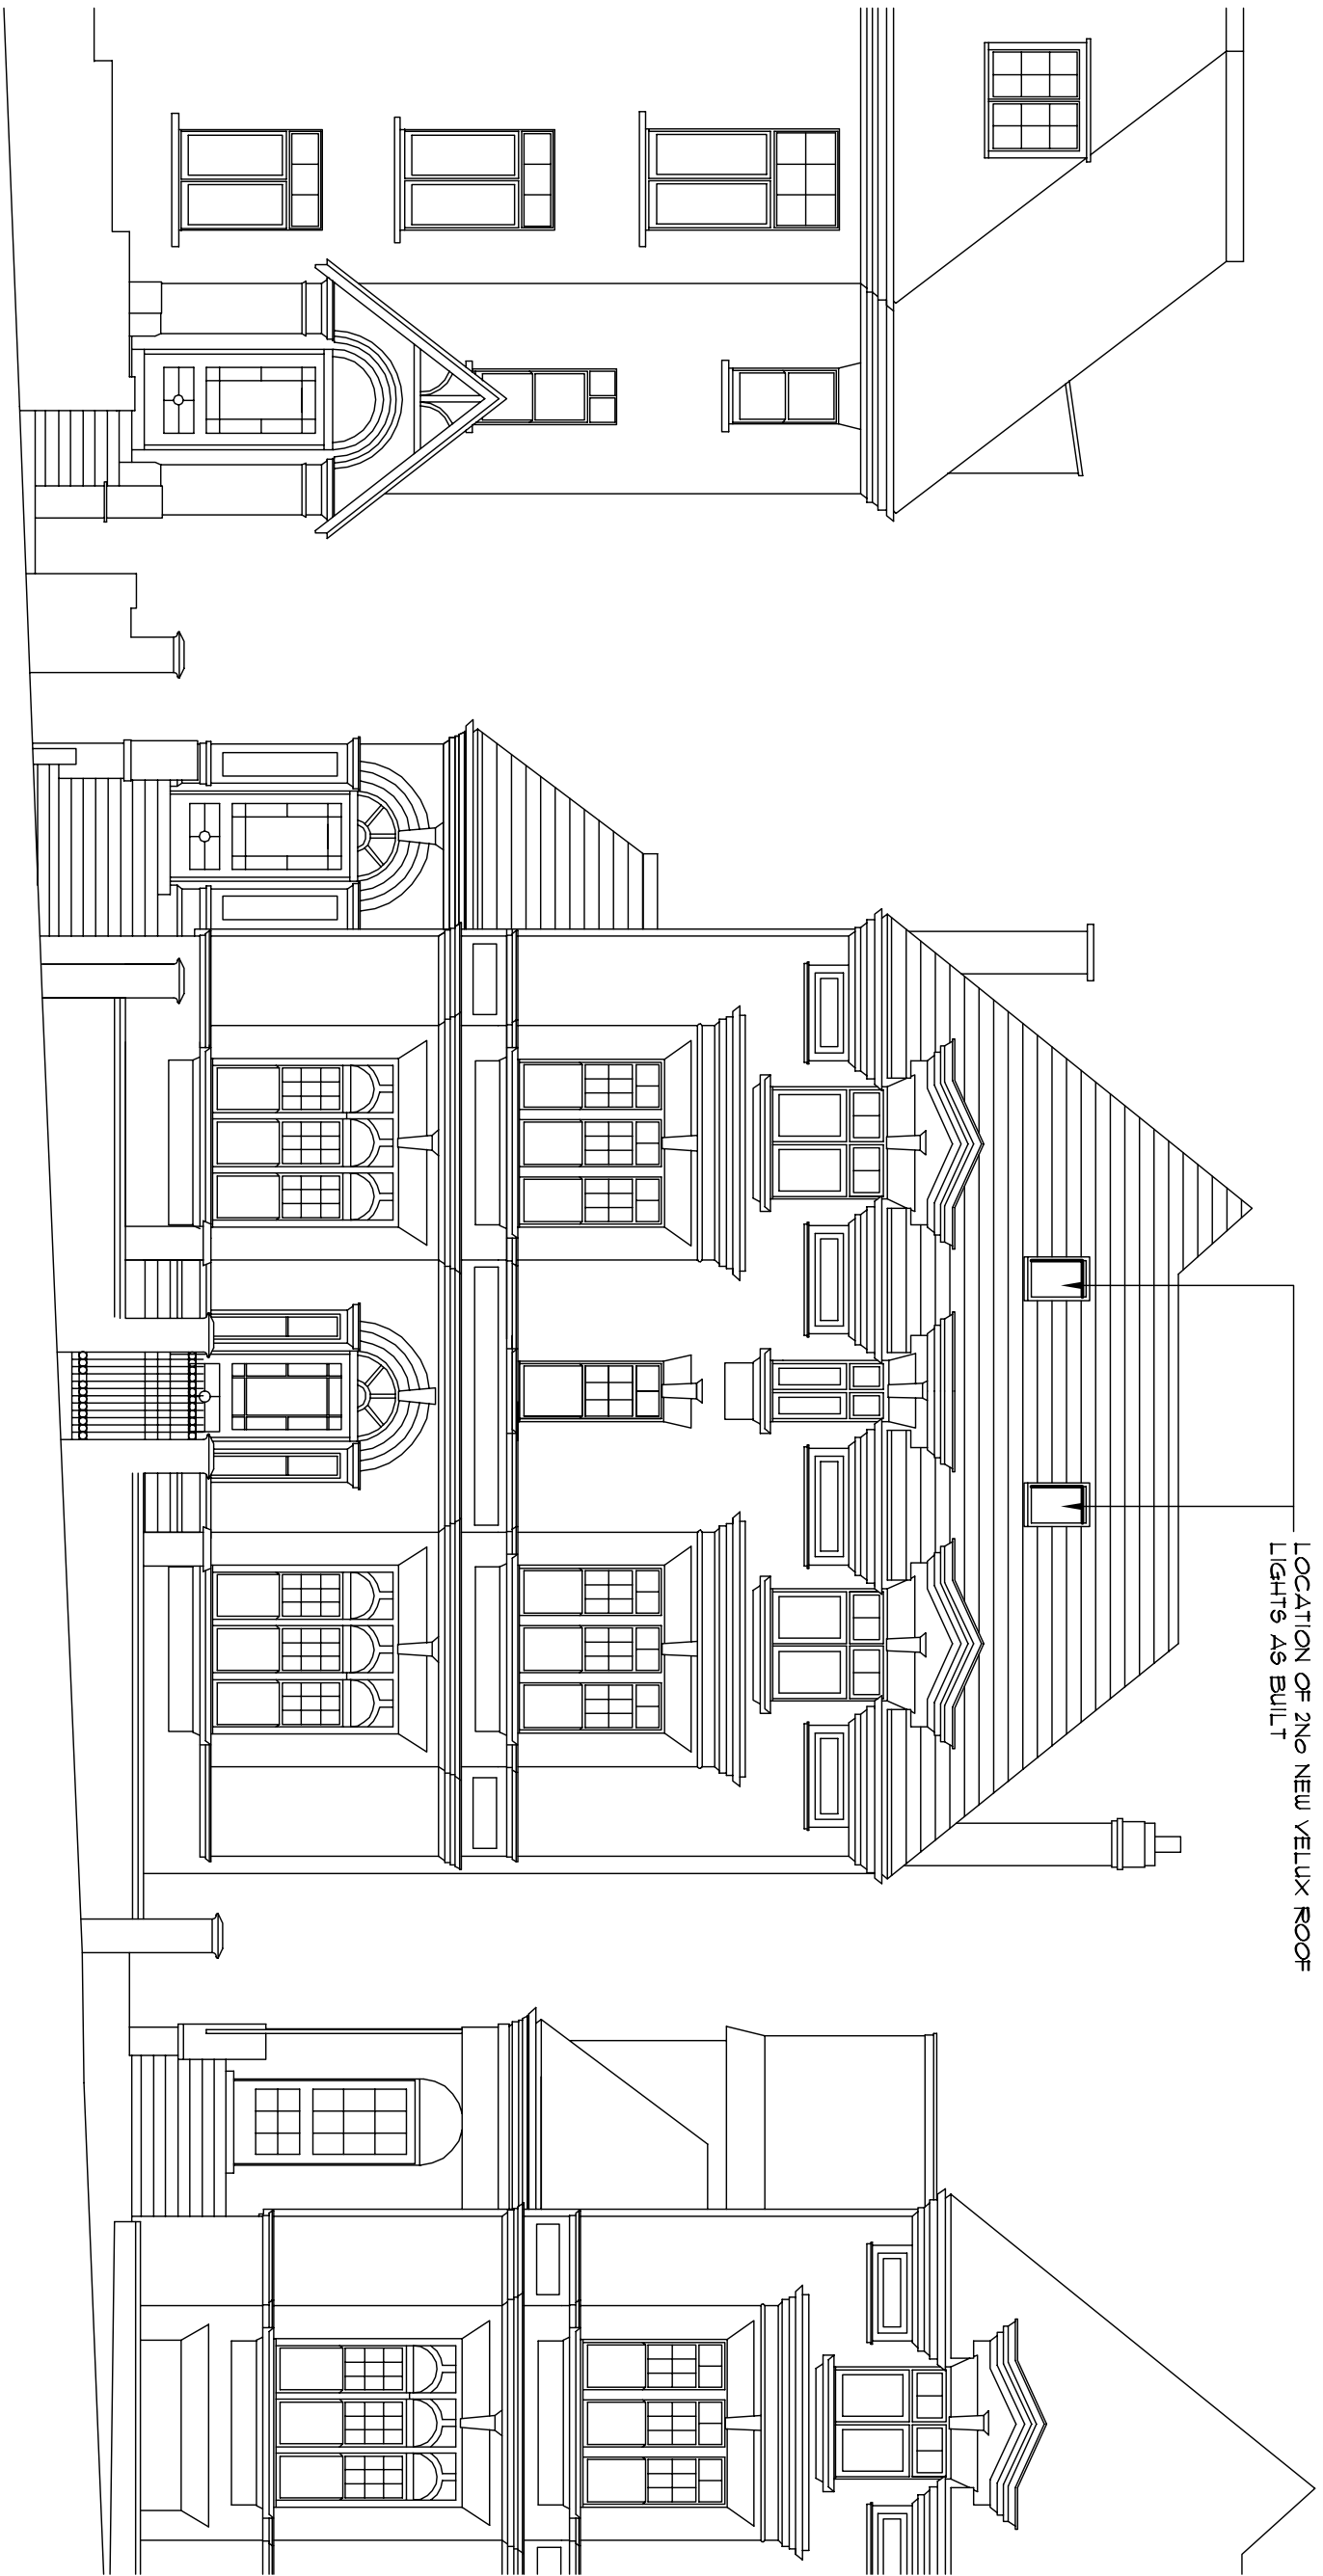

EAST ELEVATION AS PROPOSED
(PLANTING OMITTED FOR CLARITY)

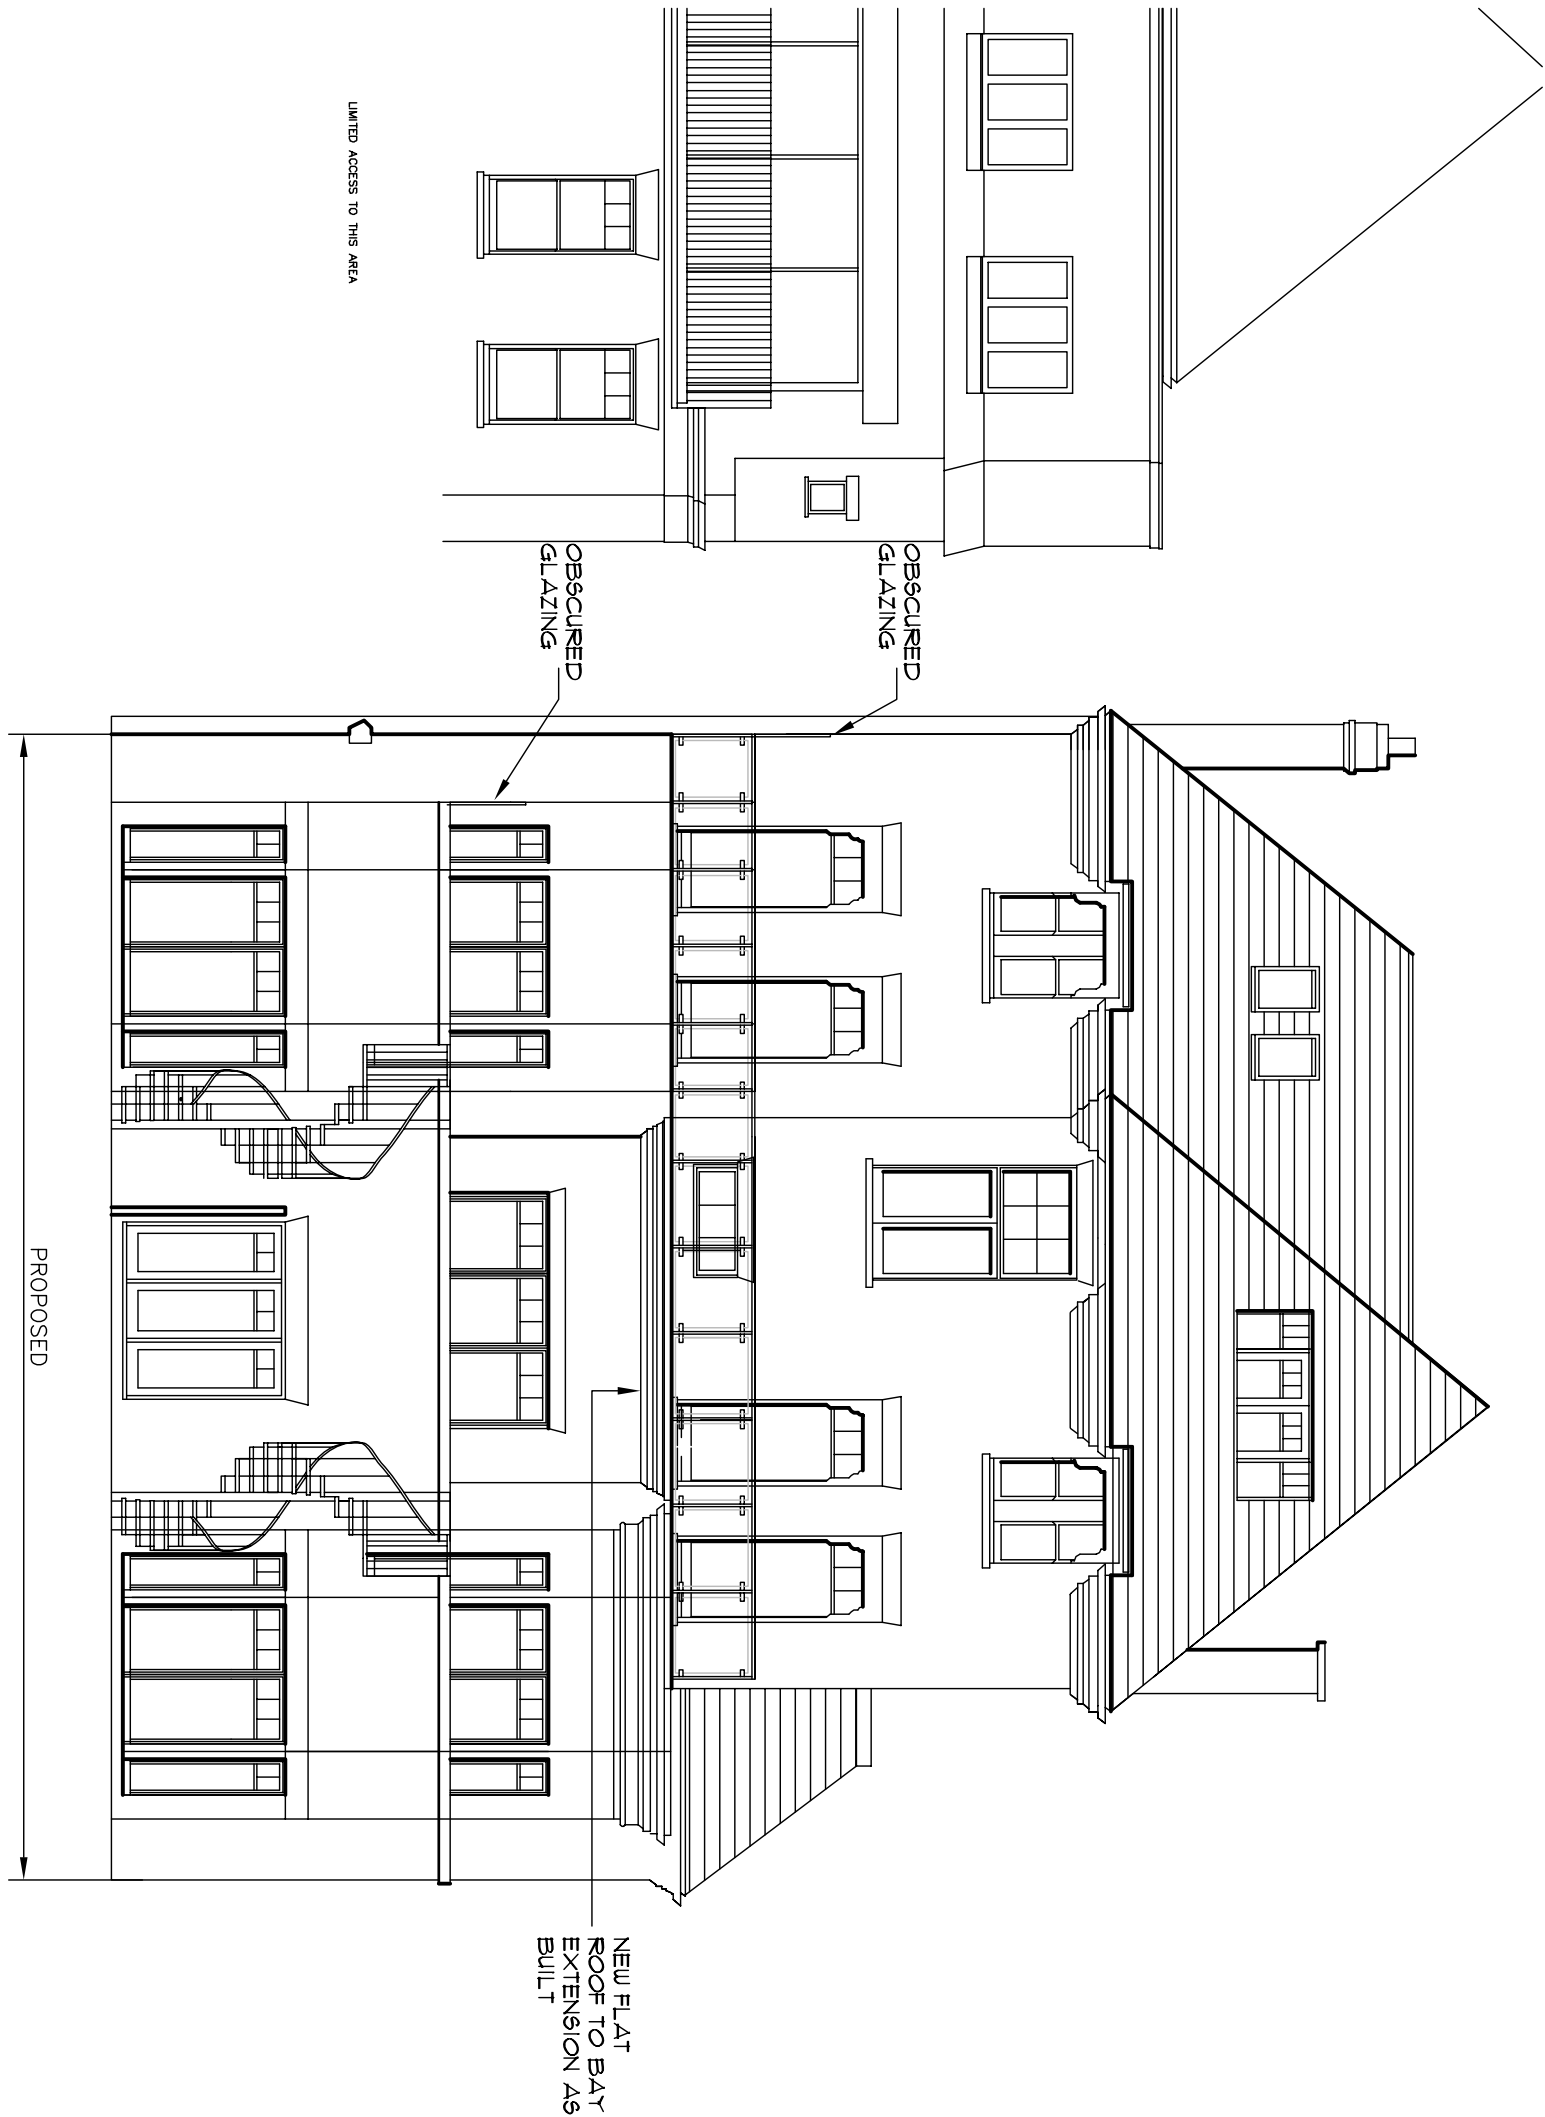

WEST ELEVATION AS PROPOSED

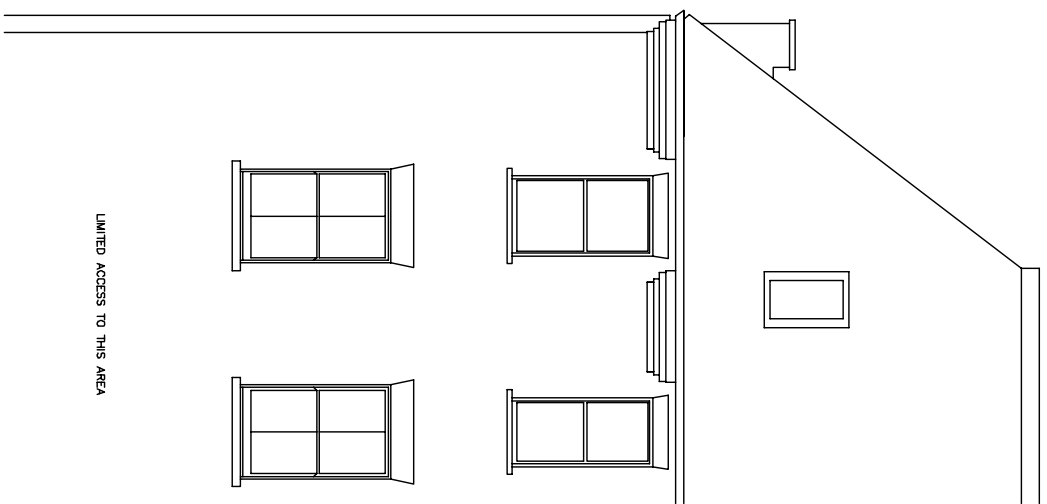

NORTH ELEVATION AS PROPOSED

PROPOSED MATERIALS

ROOF-- NEW CLAY TILES TO MATCH EXISTING
NEW ASPHALT FLAT ROOFS
TO MATCH EXISTING WITH CONCRETE
PAVING SLABS.

WALLS-- NEW BRICKWORK TO MATCH
EXISTING

NEW WINDOWS TO BE PAINTED
SOFTWOOD, DOUBLE GLAZED.
NEW GLAZED BALCONY
BALUSTRADING WITH METAL UPRIGHT
SUPPORTS & HANDRAILS.

REVISIONS

D	REVISIONS REQUIRED TO ACCORD WITH PLANNING REQUIREMENTS	SEPT 2003
E	GENERAL REVISIONS TO ACCORD WITH PLANNING REQUIREMENTS	OCT 2003
F	REAR EXTENSIONS TO FIRST AND SECOND FLOORS DETELED AND REAR 2ND ROOFLIGHTS SHOWN ON NORTH ELEVATION AS BUILT TO BE SUBMITTED AS PART OF A NEW SEPARATE PLANNING APPLICATION.	DEC 2003
G	ALTERNATION TO ROOF OF MID-SECTION BAY EXTENSION TO UPPER BUILT TO BE SUBMITTED AS PART OF A NEW SEPARATE PLANNING APPLICATION.	SEPT 2006

DRAWINGS PREPARED FROM SURVEY
DRAWINGS PRODUCED BY M. IZARA
ASSOCIATES

G C K A R C H I T E C T S L I M I T E D

Project: 27 FITZJOHNS AVENUE
LONDON NW3

6 FIELDWAY
CAMBRIDGE
CB1 8RW

TEL: 01223 411631
MOBILE 07860 660239
FAX 01223 512078

Project No.:
Type Exam No.

Drawn:
Rev:

TH: PROPOSED ELEVATIONS

Scale 1:100@A1 Date JAN 2003

78(P/L).13 G