


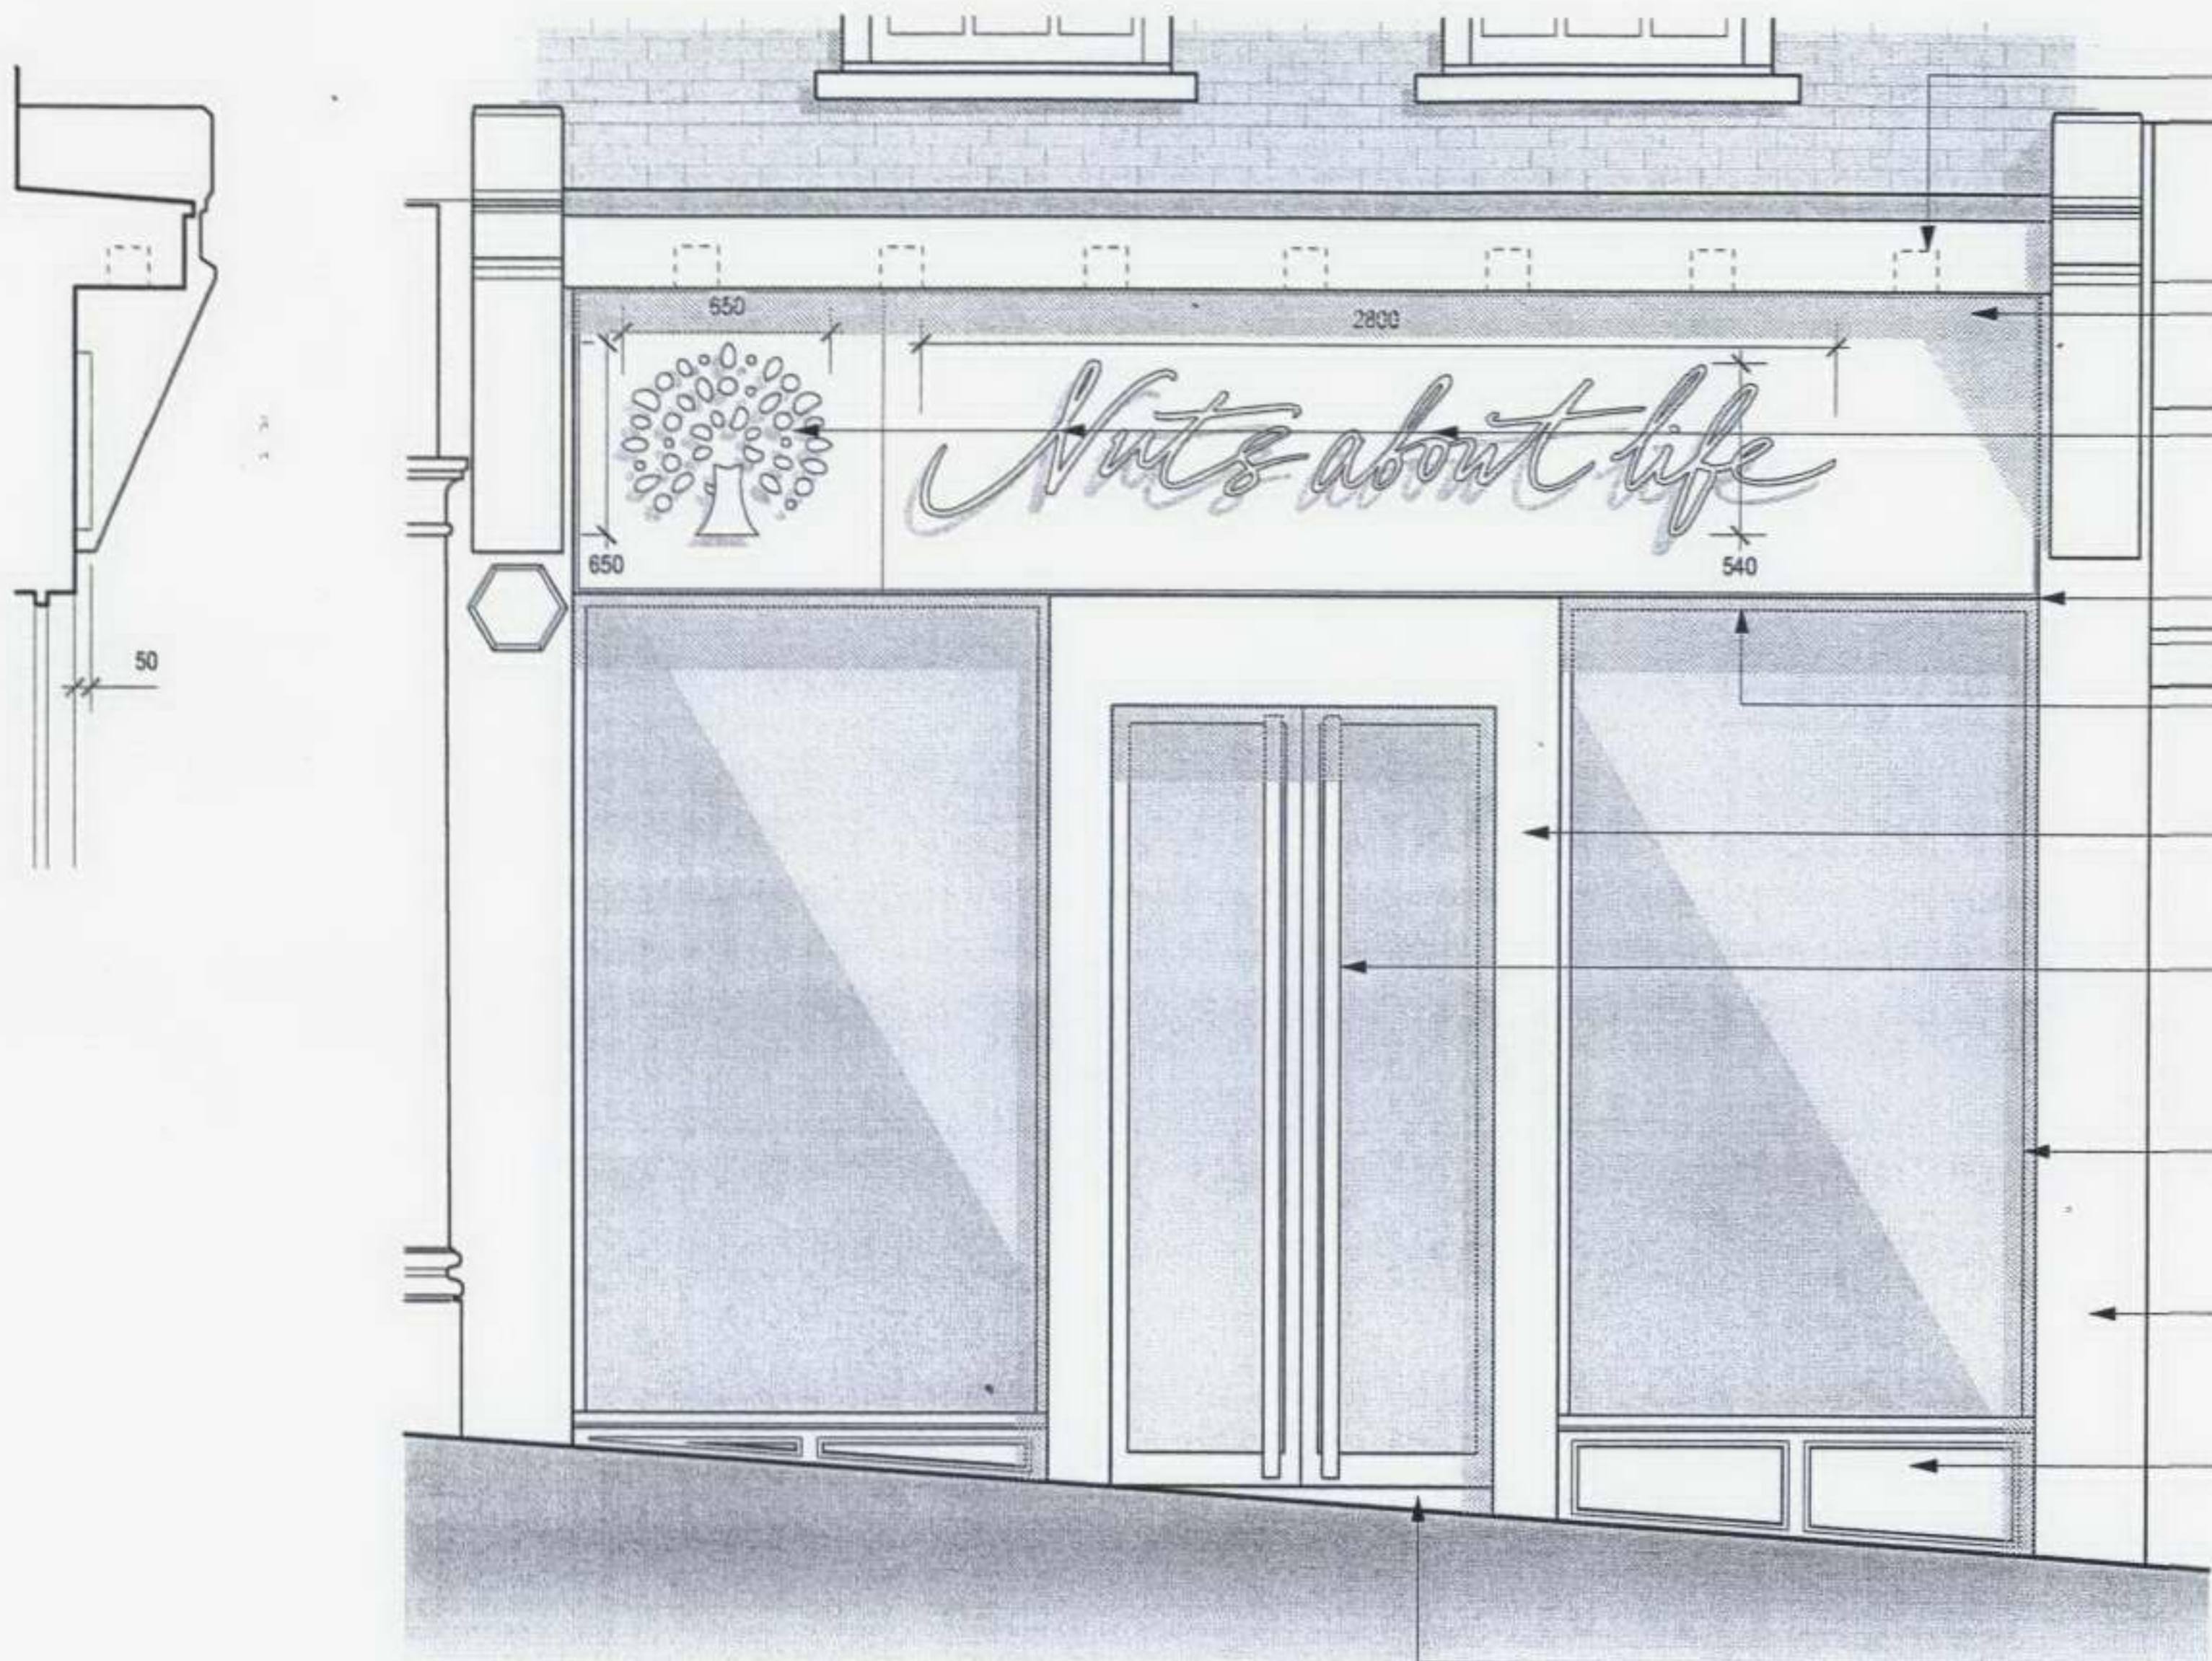

SHOPFRONT - PROPOSED

IMPORTANT:

Contractor To Undertake Check Survey And
Provide Setting Out Plan For Client Sign Off Prior
To Commencement Of Works

COLOUR REFS:

'NUTS ABOUT LIFE'

Lettering: Green DCP 72YY 47/743

Tree Logo:

Trunk: Brown DCP 84RR 05/082
Leaves: Orange: 50YR 21/603, Brown: 80YR 09/163,
Terracotta: 39YR 11/342, Red: 14YR 10/434,
Olive: 60YY 15/280, Cream: 35YY 74/372

New Downlights To Fascia Overhang.
Fascia Overhang To Be Painted
Brown: 80YR 09/163

New Timber Fascia To Be Painted Refs:
Brown DCP 84RR 05/082 (Behind Script)
Green DCP 72YY 47/743 (Behind Tree)

Fret Cut Metal Letters & Logo
Sprayed To A RAL Colour (See
Below), Space Mounted From Fascia
On Brass Locating Pins.
Final Artwork From Graphics Pack

Existing Internal Windowbed Security
Shutters To Be Removed.

Soffit To Entrance Door To Be Repaired
And Made Ready To Recieve New
Warm Air Curtain To Inside Face, By
M&E Contractor

Existing Door Surround Painted.
Brass Plaques Removed And Area
Made Good. Brown: 80YR 09/163

Existing Entrance Doors, On Hold
Open. Doors To Be Resprayed Black.
Replacement Stainless Steel
Doorhandles From Pool White (0207
2538117)

Existing Black Painted Aluminium
Window Frames, To Be
Redecorated Black

Shopfront Pilasters Painted
Brown: 80YR 09/163

Existing Timber Stallfront Riser With
Panelling Detail, Painted Brown:
80YR 09/163. Inside Face Of Glass
To Receive Black Opaque Matt Film
Ref: Metamark 7 Series
'M7-111M' (0845 345 5645)

Black Tiles To Front Of Step To Be
Replaced With Matte Black External
Quality Tiles. Black Grout

REVISIONS:

REV A: 20 Sept 05
Notation Ammended

REV B: 21 sept
Comments From Precontract
Site Meeting & Client Meeting
Added

REV C: 25 Oct 05
Signage Colours Added

REV D: 25 Oct 05
Pilaster Colours Added.
Stallriser Brown Changed

REV E: 28 Mar 06
As Built

redjacket

28-40 Glassfield Street
London
SE1 0QR

Tel: +44 (0)207 328 4466
Fax: +44 (0)207 328 4477
e mail: info@redjacketdesign.com

This drawing is the property of Redjacket design consultants,
copyright is reserved by them and the drawing is issued on the
condition that it is not copied, reproduced, retained or disclosed to
any unauthorised person, either wholly or in part without the consent
in writing of Redjacket design consultants.

Client: Al Rifai - "Nuts About Life"

Project: 44 Hampstead High Street

Drawing title: Shopfront Proposed 1


Date / Scale: 8/10.05 / 1:25

Drawing N°: AL151-WD-101 E

Drawing Status: AS BUILT

Dimensions are to be checked on site before construction and any
discrepancies are to be notified to the designers.

Do not scale.

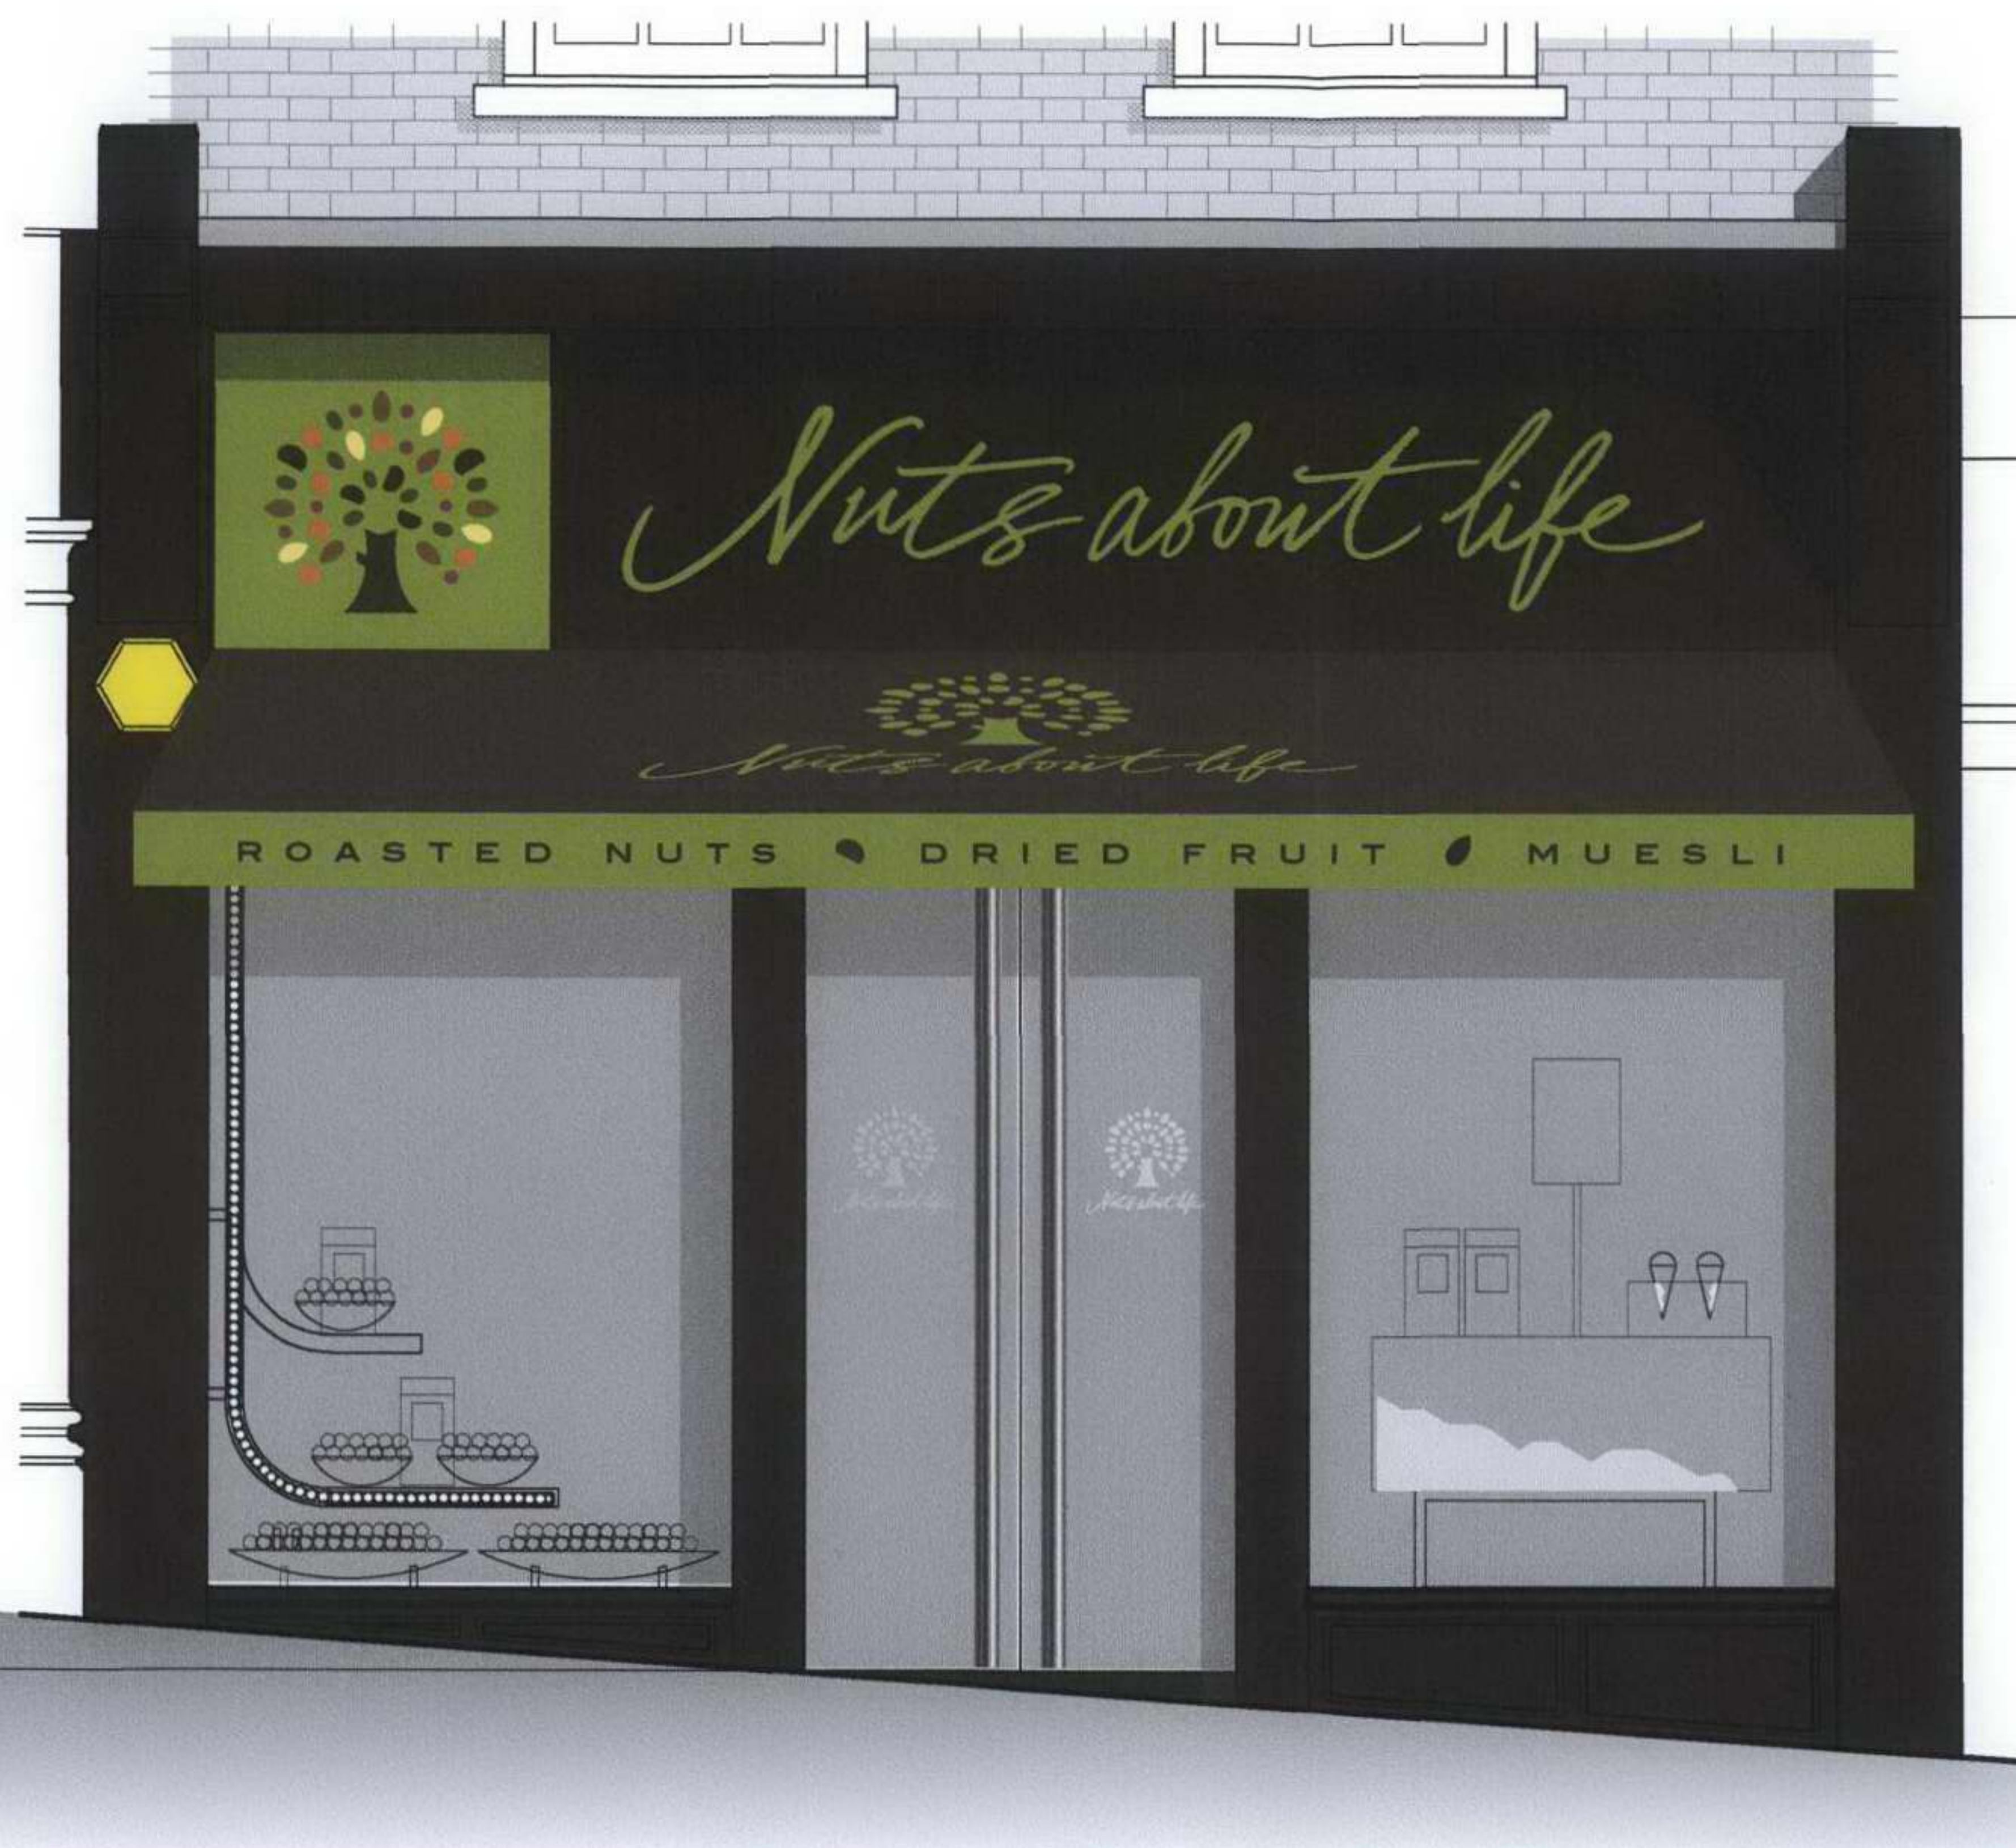

REVISIONS:

redjacket

35-40 Glasshill Street
London
SE1 0QR

Tel: +44 (0)207 828 4466
Fax: +44 (0)207 828 4477
e mail: info@redjacketdesign.com

This drawing is the property of Redjacket design consultants, copyright is reserved by them and the drawing is issued on the condition that it is not copied, reproduced, retained or disclosed to any unauthorized person, either wholly or in part without the consent in writing of Redjacket design consultants.

Client **Al Rifai - "Nuts About Life"**

Project **44 Hampstead High Street**

Drawing title **PROPOSED AWNING**

Date / Scale **01/08/06 1:25**

Drawing N° **PL-001**

Drawing Status

Dimensions are to be checked on site before construction and any discrepancies are to be notified to the designers.

Do not scale.