




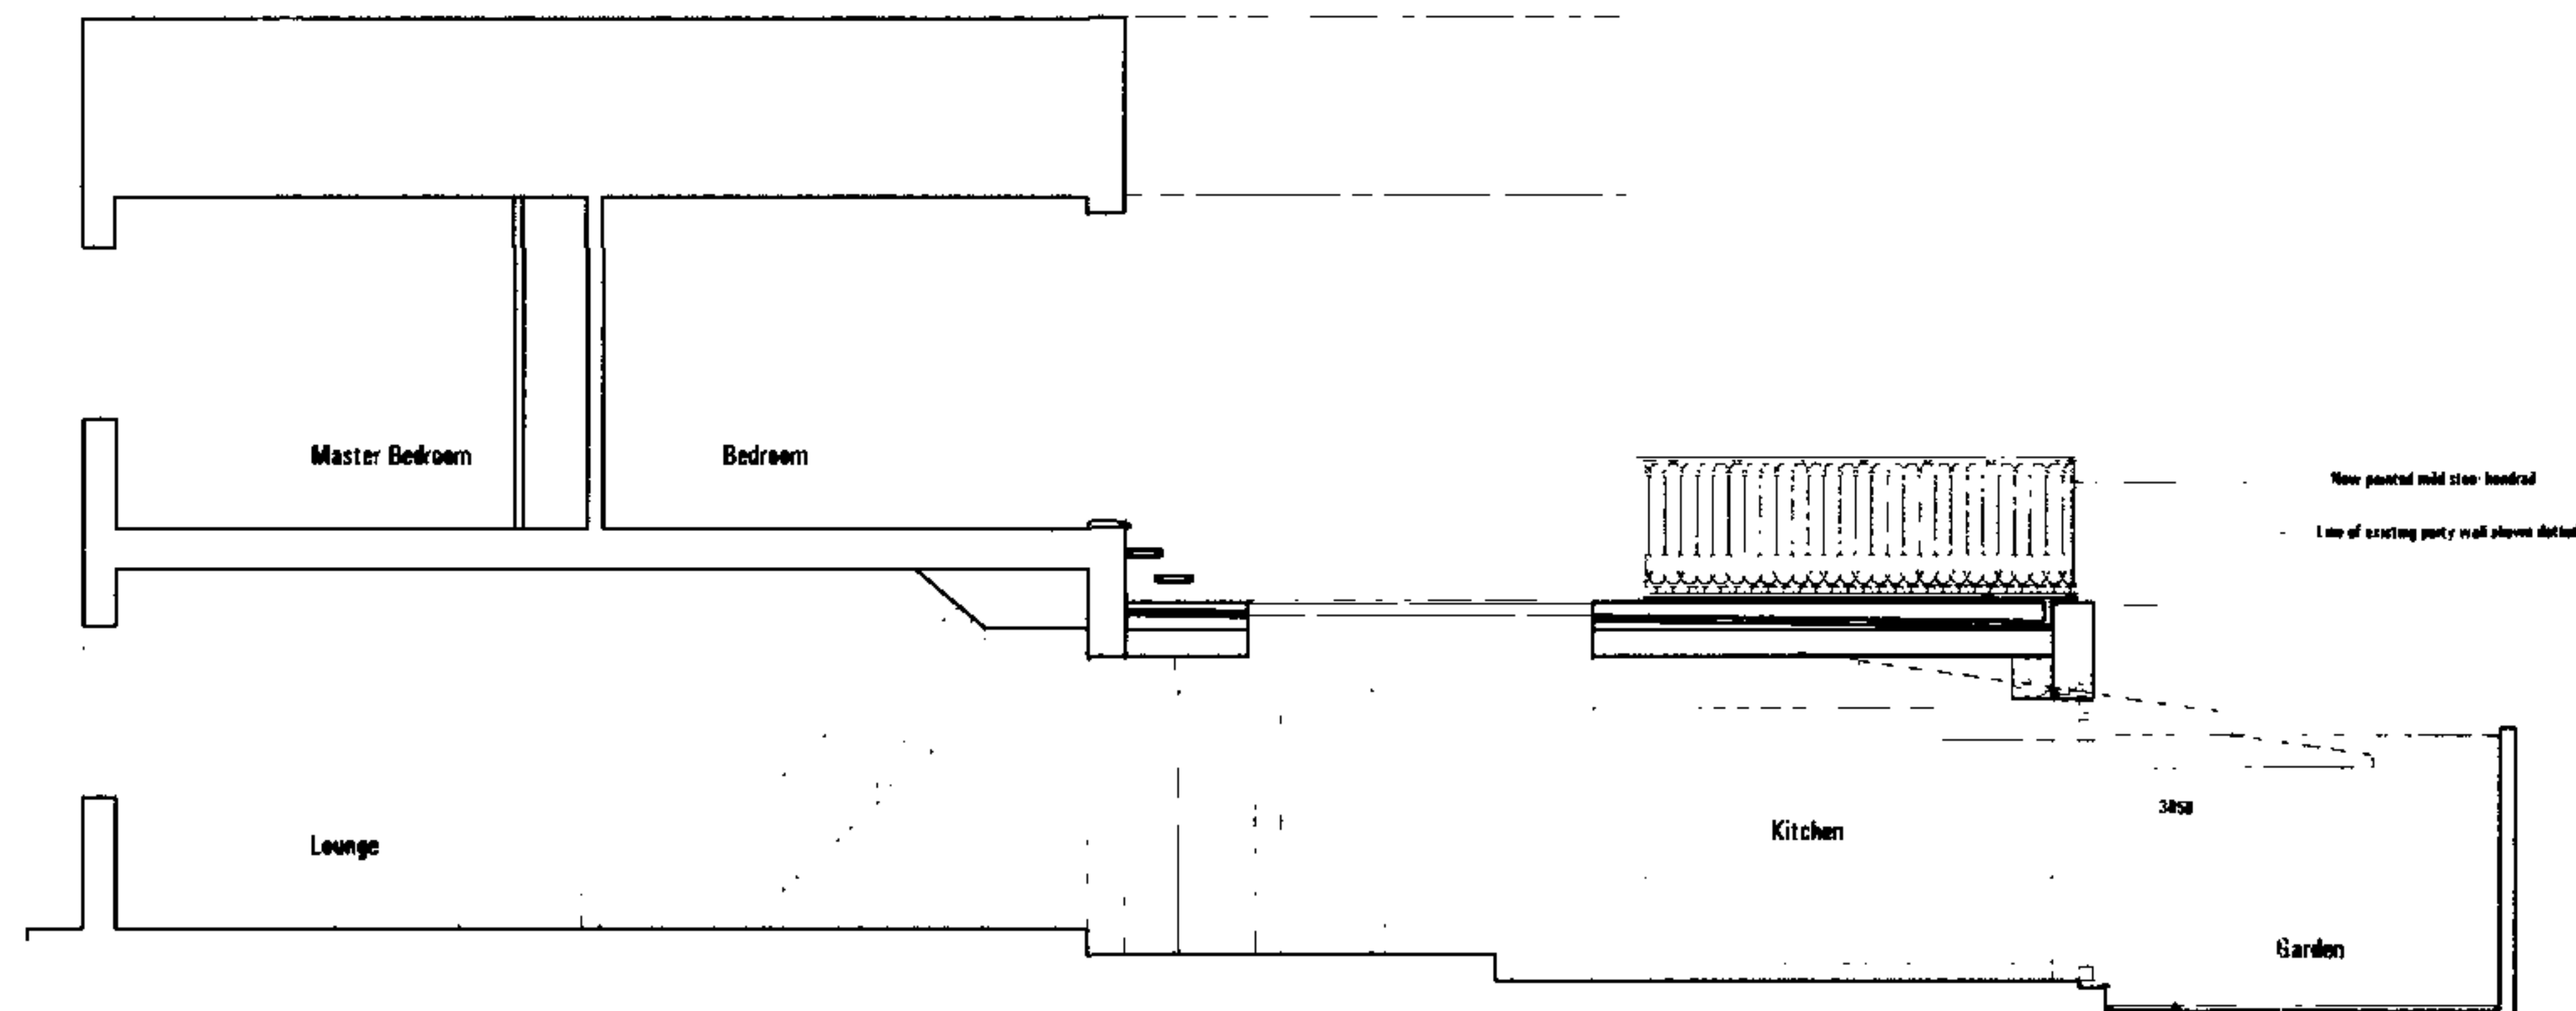


1. Section BB

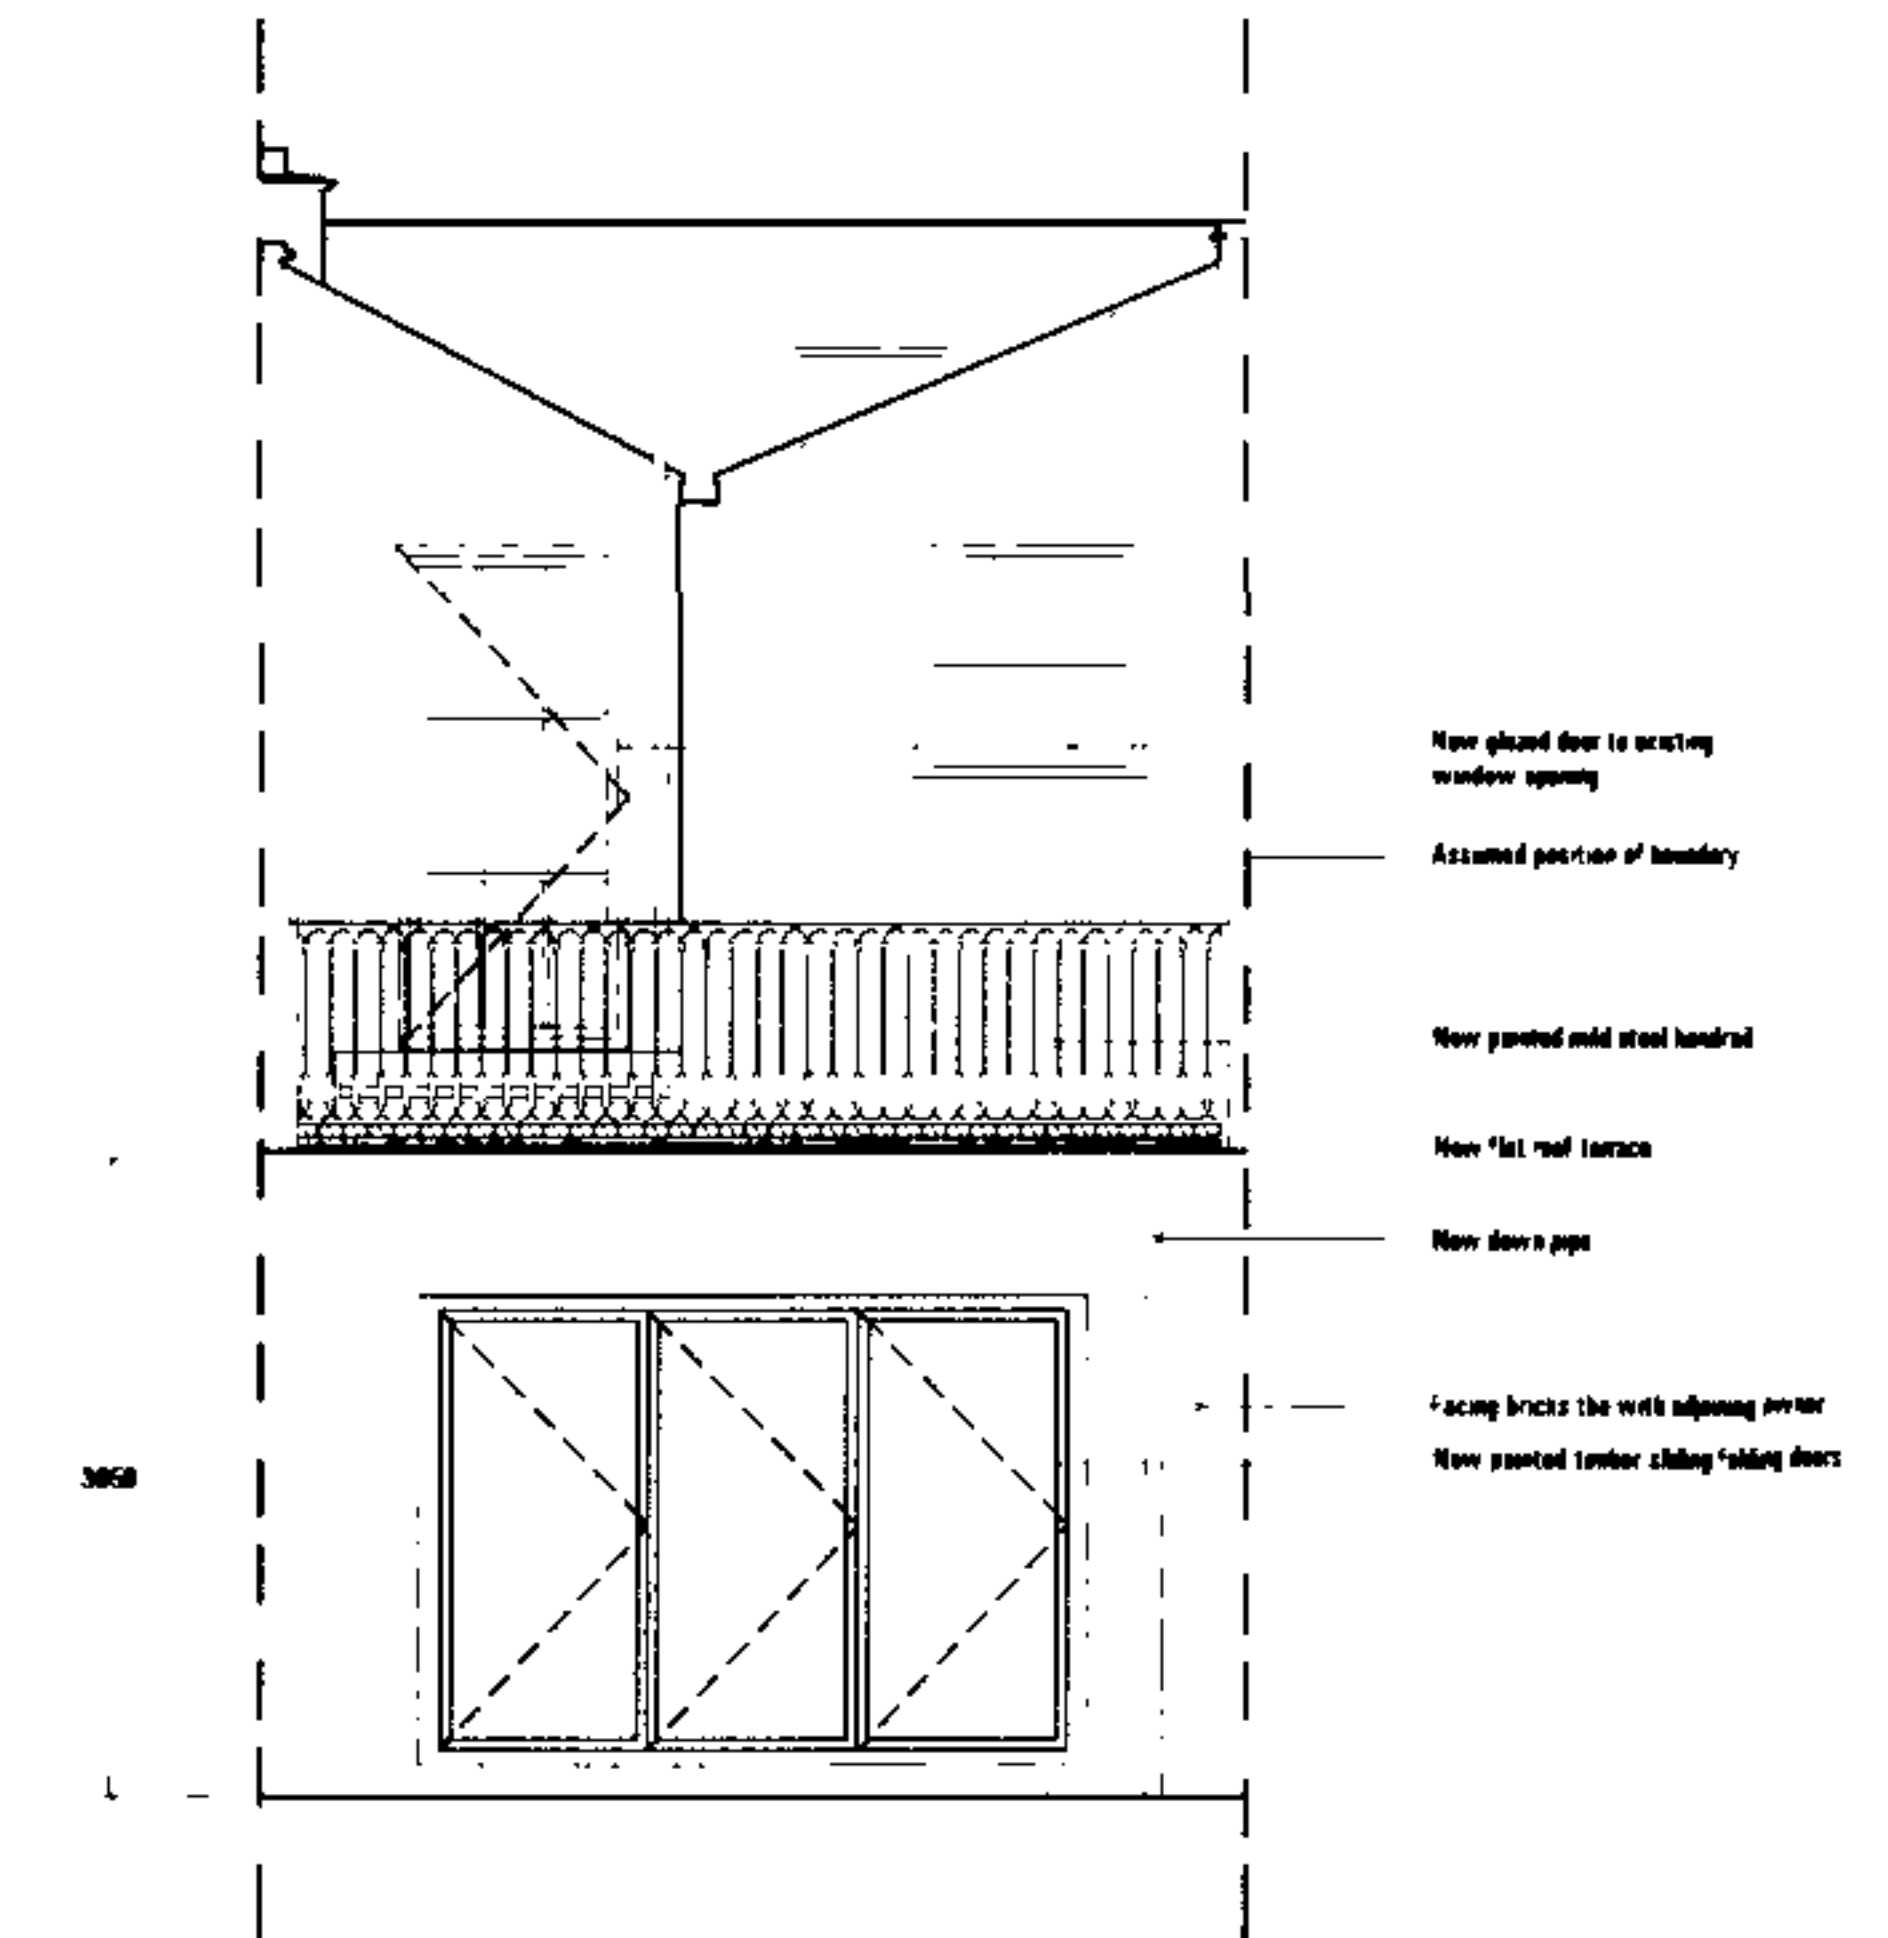

2. Elevation

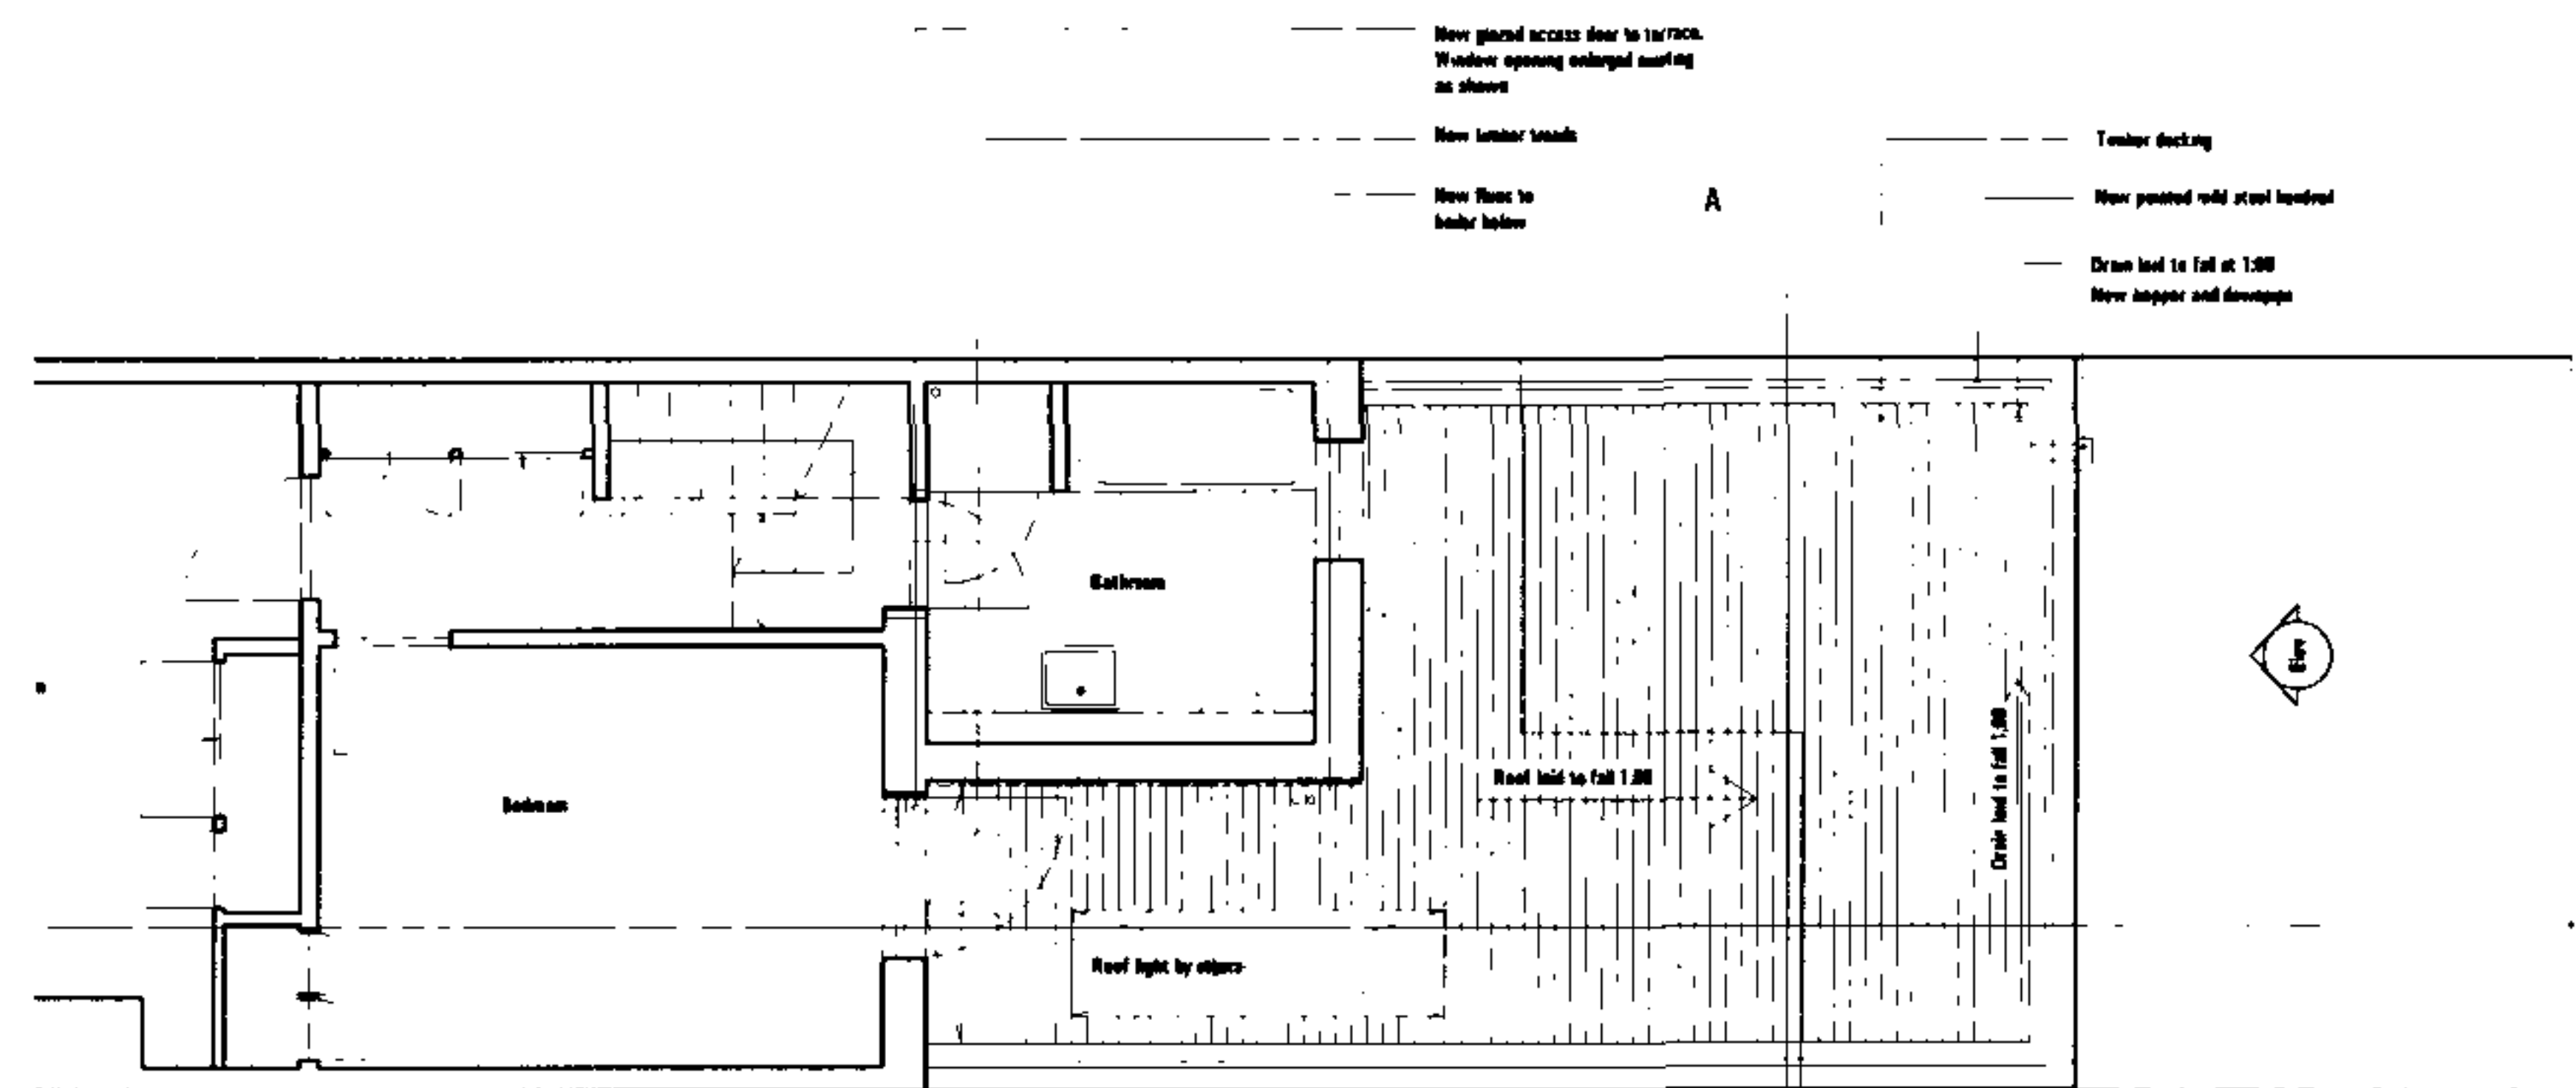

3. Roof Terrace Plan

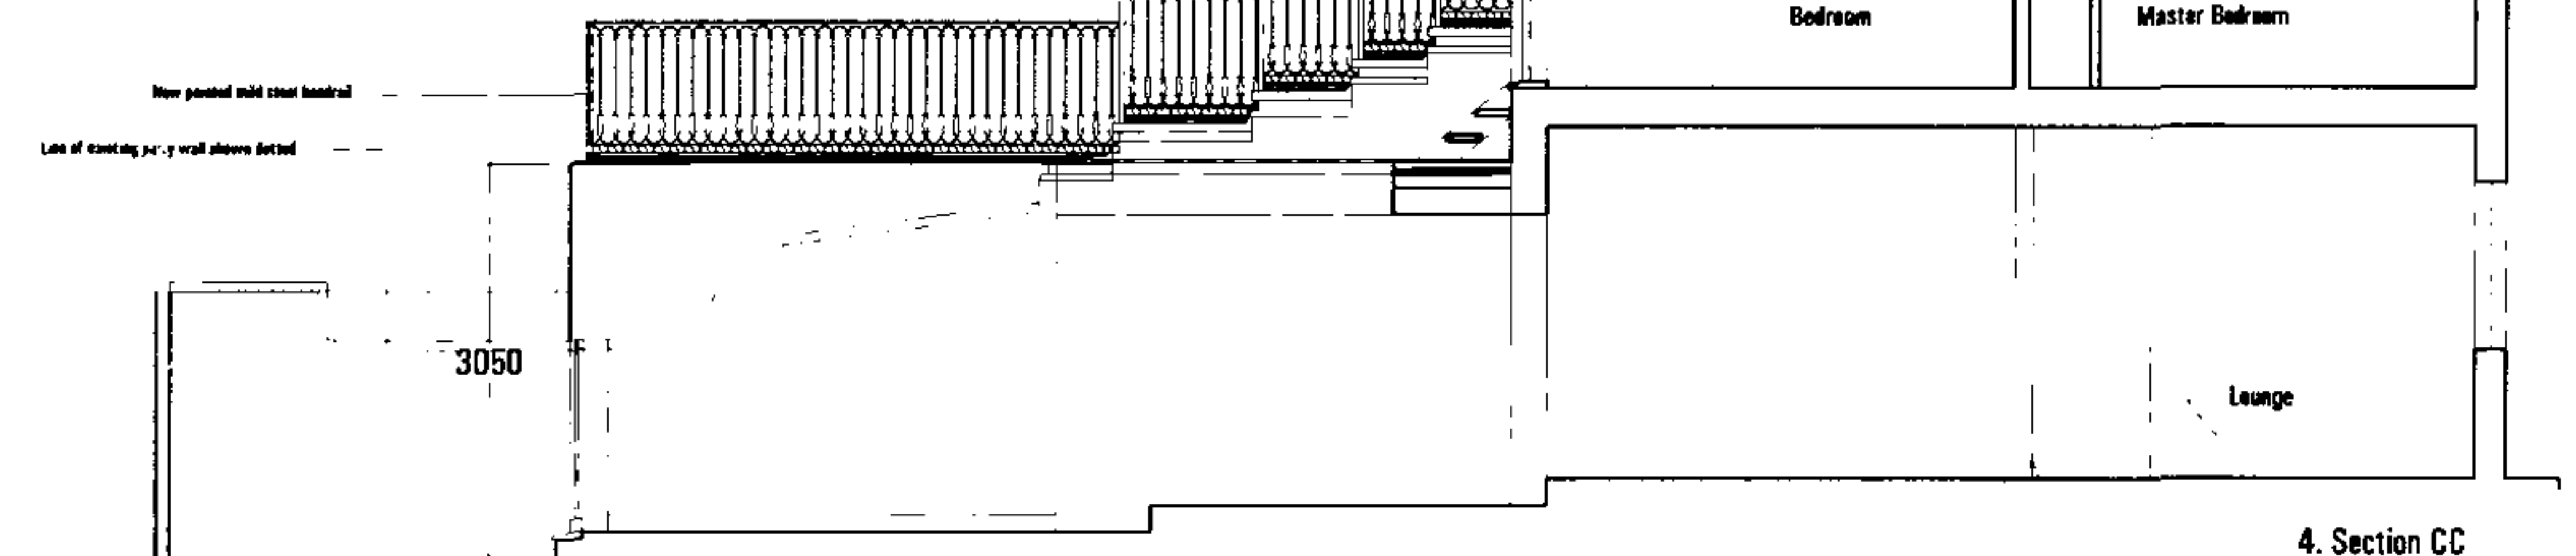

4. Section CC

date rev revisions

key plan

notes

DMFK Architects Ltd take no responsibility for dimensions obtained by scaling from this drawing. If no dimension is shown the recipient must ascertain the dimension specifically from the architect or by site measurement and may not rely on the drawing. Supply of the drawing in digital form is solely for convenience and no reliance may be placed on any data in digital form. All data must be checked against hard copy. This drawing is issued for design intent only and should not be used for construction unless stated.

copyright
This drawing is the property of dMFK Architects Ltd. No disclosure or copy of it may be made without the written permission of dMFK Architects Ltd.

address: unit 4 250 finchley road london nw3 3dn t 020 7435 1144 f 020 7435 0884 mail info@dmfk.co.uk
project 3 Wildwood Grove

client Emma Zerdin


drawing title
As Built Roof Terrace Plan
Sections & Elevation

scale at A1	scale at A3	drawn	date
1:50	1:100	TD	14.02.06
project no.	drawing no.	revision	
1340	A600	-	

dMFK

DE METZ FORBES KNIGHT ARCHITECTS

17 FEB 2006

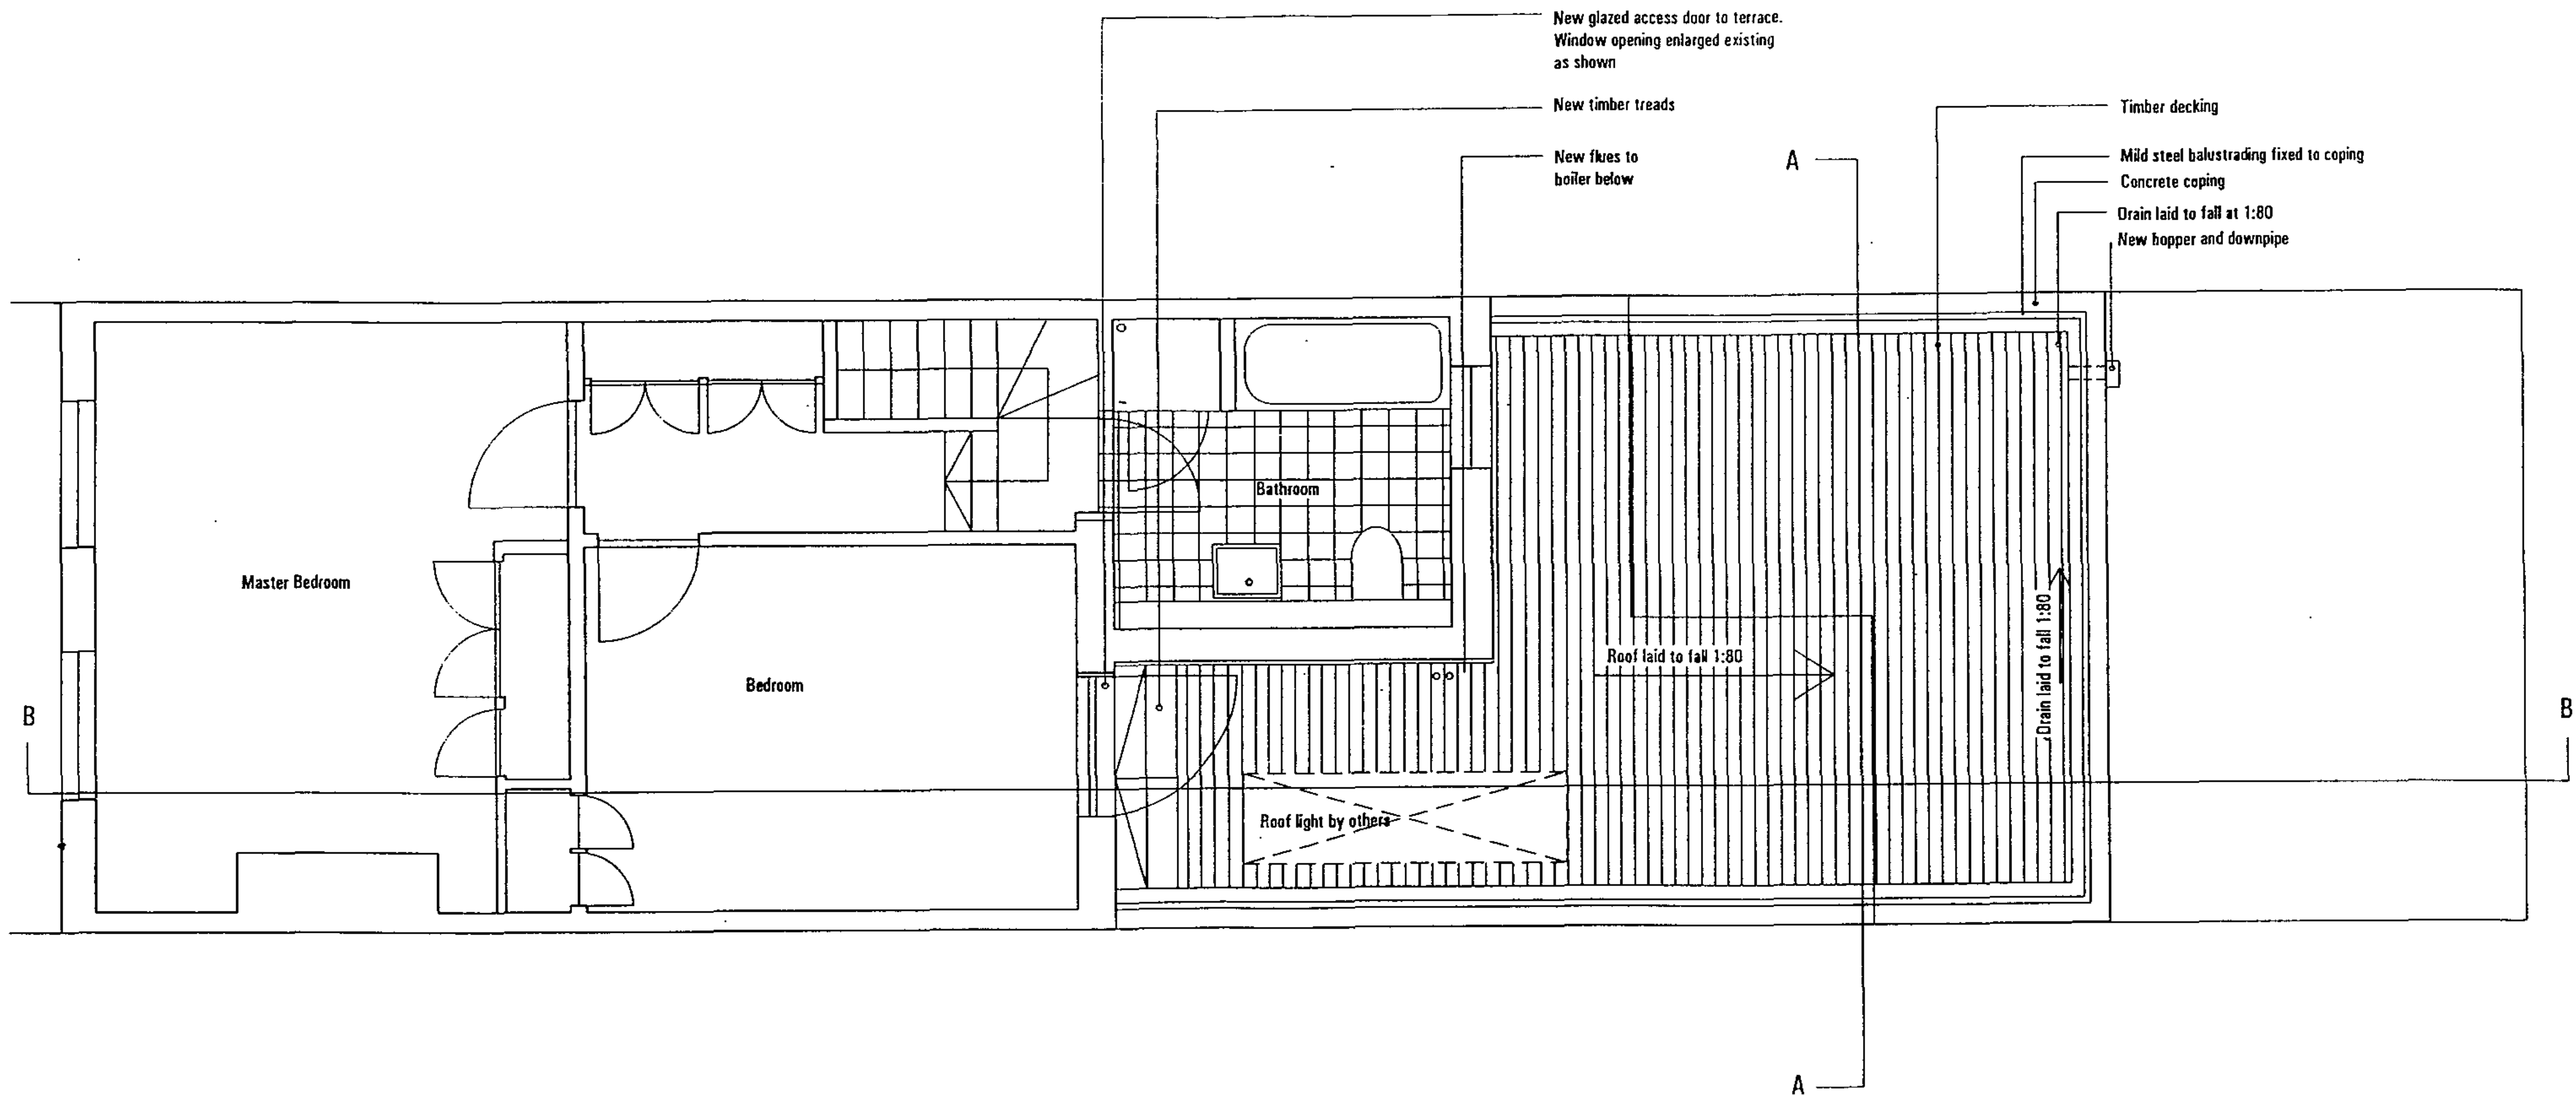

Copyright
This drawing is the property of de Metz Architects Ltd.
No disclosure or copy of it may be made without the written permission of de Metz Architects Ltd.

Note:
de Metz takes no responsibility for dimensions obtained by scaling from this drawing. If no dimension is shown the recipient must ascertain the dimension specifically from the architect or by site measurement and may not rely on the drawing. Supply of the drawing in digital form is solely for convenience and no reliance may be placed on any data in digital form. All data must be checked against hard copy. This drawing is issued for design intent only and should not be used for construction unless stated.

rev	comments	date	rev	comments	date


de metz architects address unit 4 250 finchley road london n2 8dn t 020 7435 1144 f 020 7435 0884 e mail info@demetz.co.uk

de metz
architects

project
3 Wildwood Grove

title
Proposed First floor plan

status
scale 1:50 @ a3 date April 04
no 1310 dra GA02

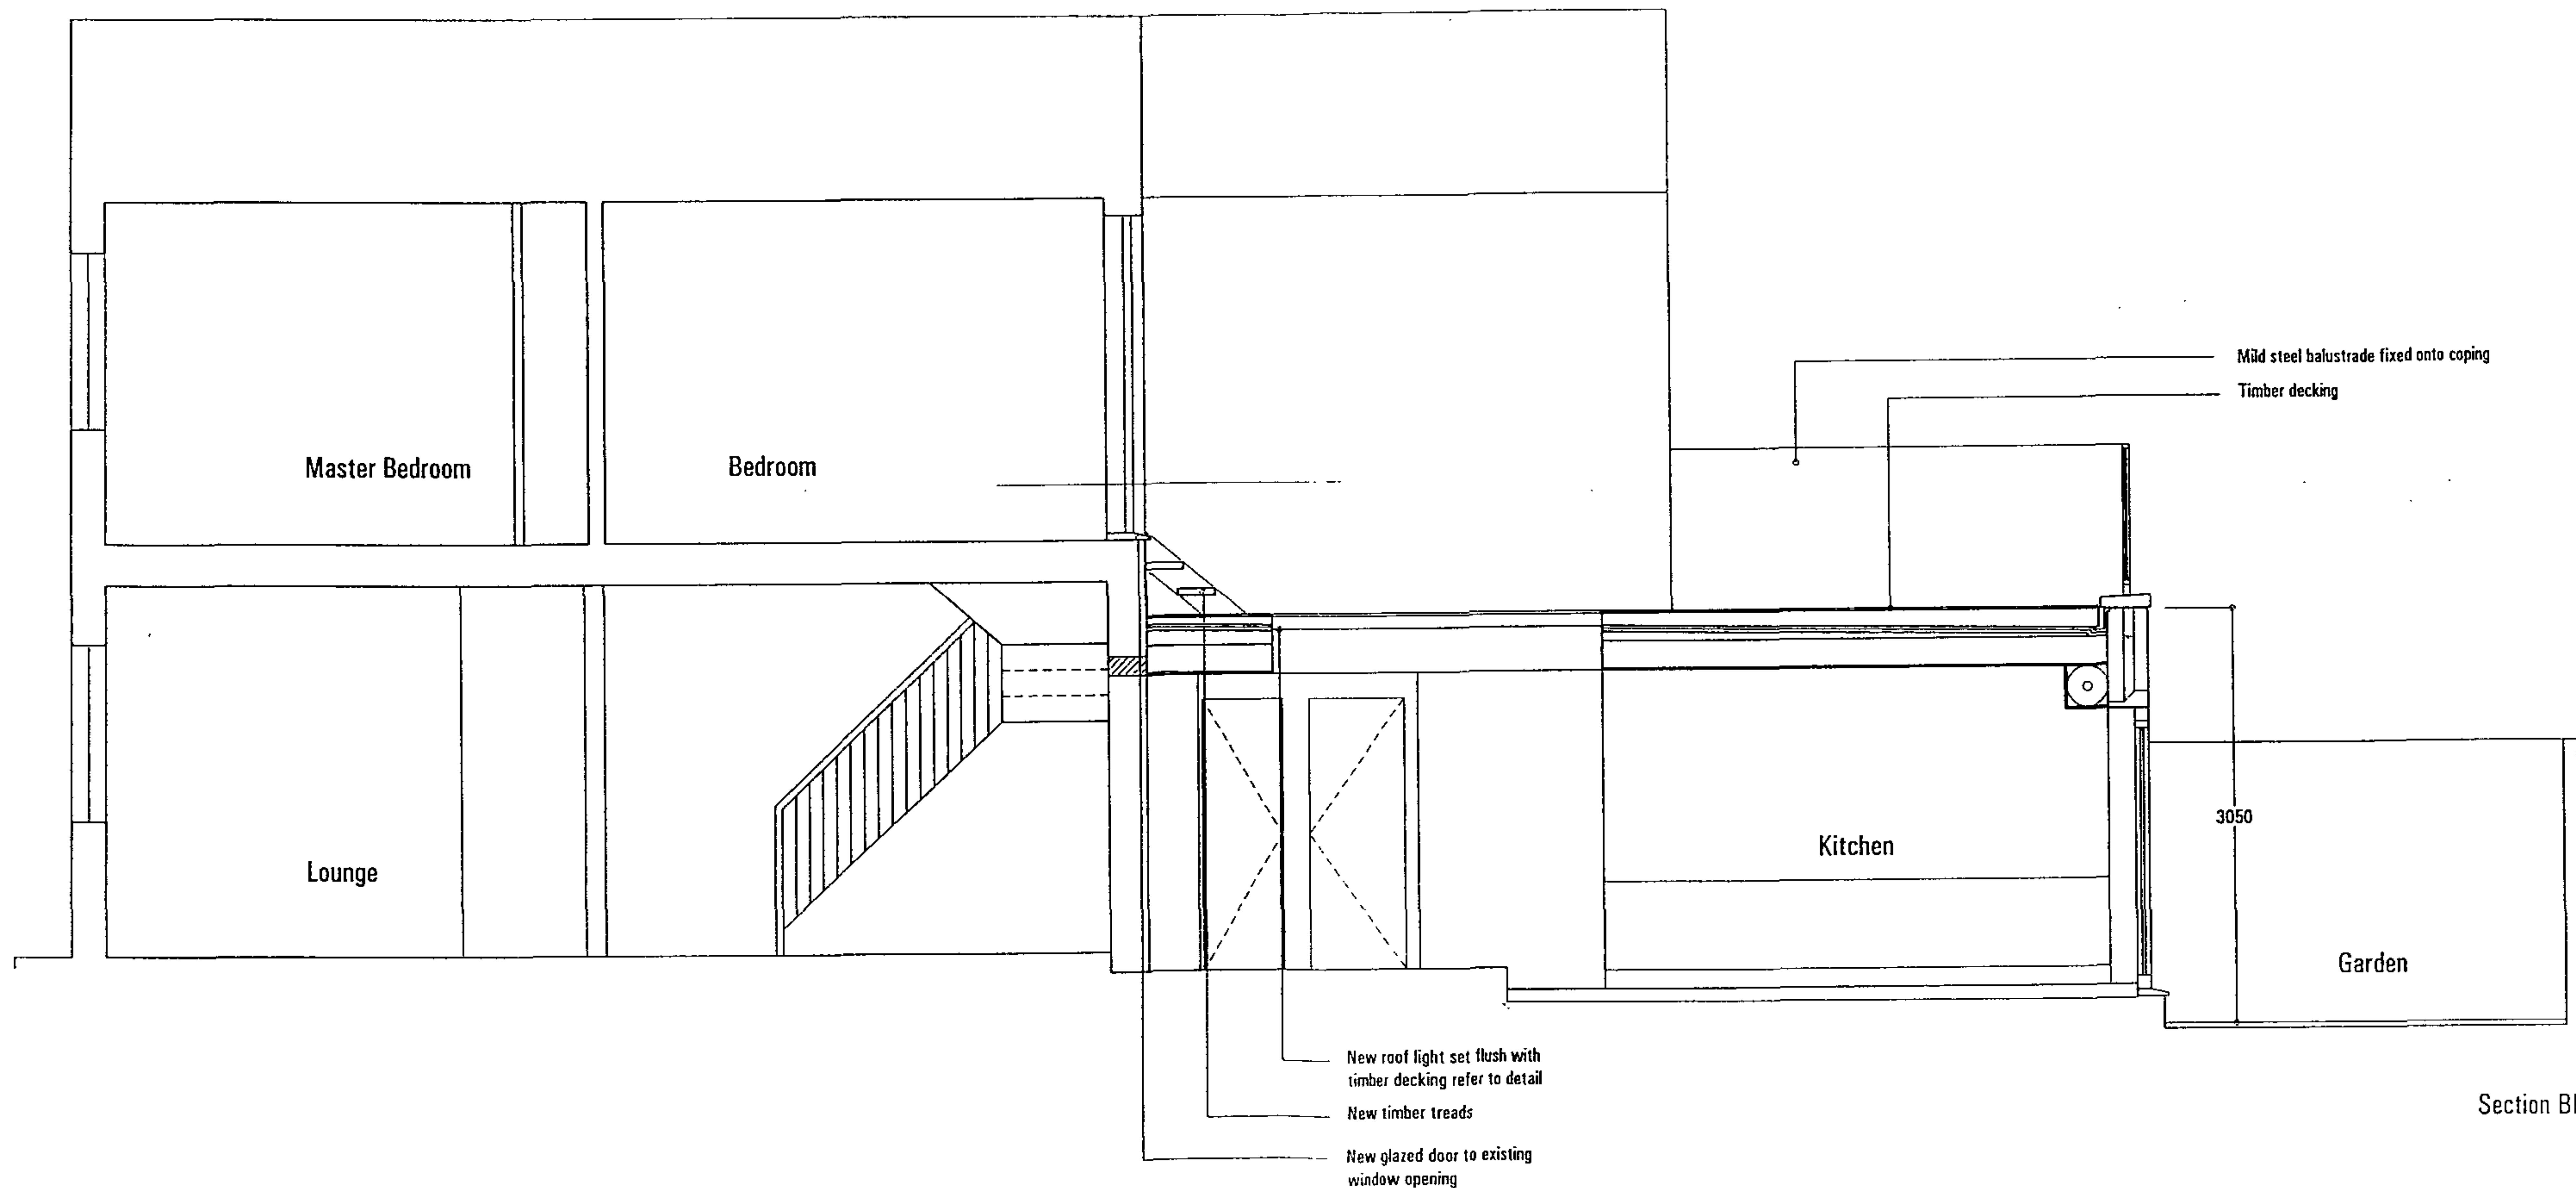

Copyright
This drawing is the property of de Metz Architects Ltd.
No disclosure or copy of it may be made without the written permission of de Metz Architects Ltd.

Note:
de Metz takes no responsibility for dimensions obtained by scaling from this drawing. If no dimension is shown the request must ascertain the dimension specifically from the architect or by site measurement and may not rely on the drawing. Supply of the drawing in digital form is solely for convenience and no reliance may be placed on any data in digital form. All data must be checked against the paper. This drawing is issued for design intent only and should not be used for construction.


rev	comments	date	rev	comments	date

de metz architects

de metz architects address unit 4 250 finchley road london nw3 6dn t 020 7435 1144 f 020 7435 0884 e mail info@demetz.co.uk

project
3 Wildwood Grove

title	Proposed Section BB
status	
scale	1:50 @ a3
date	April 04
no	1340
rev	GA/03

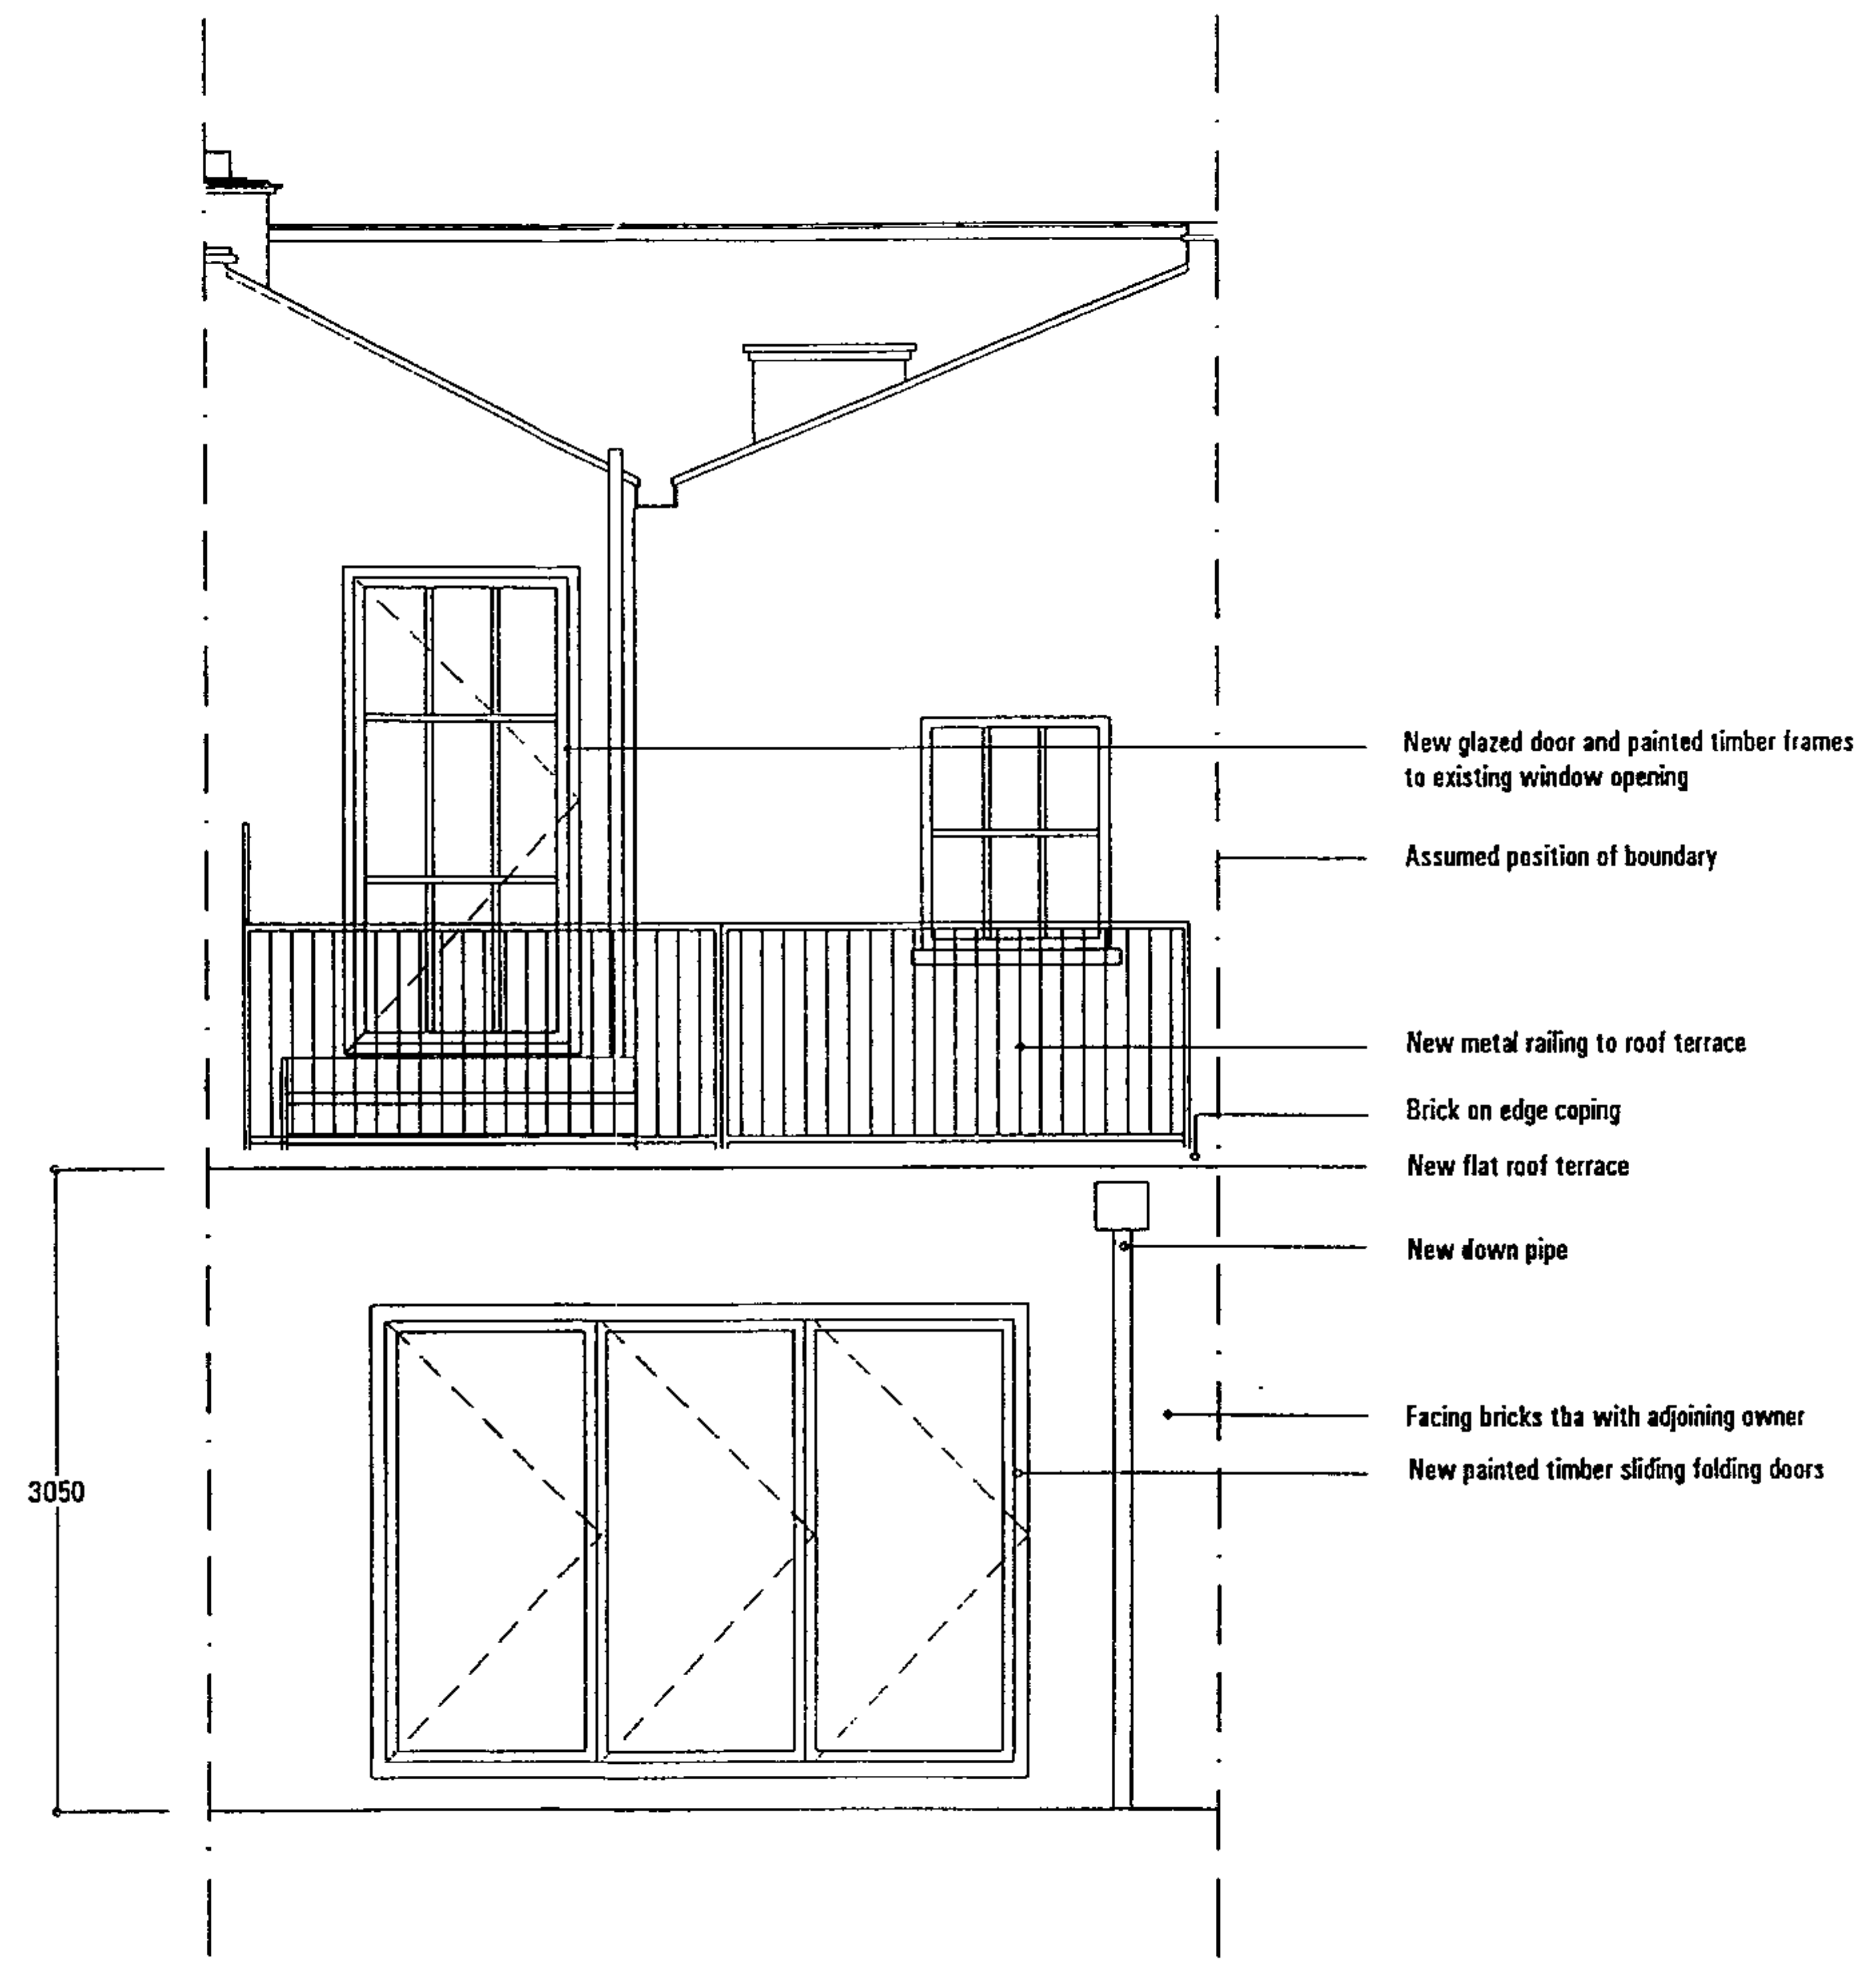

Copyright
This drawing is the property of de Metz Architects Ltd.
No disclosure or copy of it may be made without the written permission of de Metz Architects Ltd.
Note:
de Metz takes no responsibility for dimensions obtained by scaling from this drawing. If no dimension is shown the recipient must ascertain the dimension specifically from the architect or by site measurement and may not rely on the drawing. Supply of this drawing in digital form is solely for convenience and no reliance may be placed on any data in digital form. All data must be checked against hard copy. This drawing is for the recipient's use only and should not be used for construction unless stated.

rev	comments	date	rev	comments	date


de metz architects address unit 4 250 brixton road london nw3 6dn t 020 7435 1144 f 020 7435 0884 e-mail info@demetz.co.uk

de metz
architects

project
3 Wildwood Grove

title
Proposed rear elevation and section AA

status	
scale	1:50 @ a3
date	April 04
no	1340
rev	GA/04

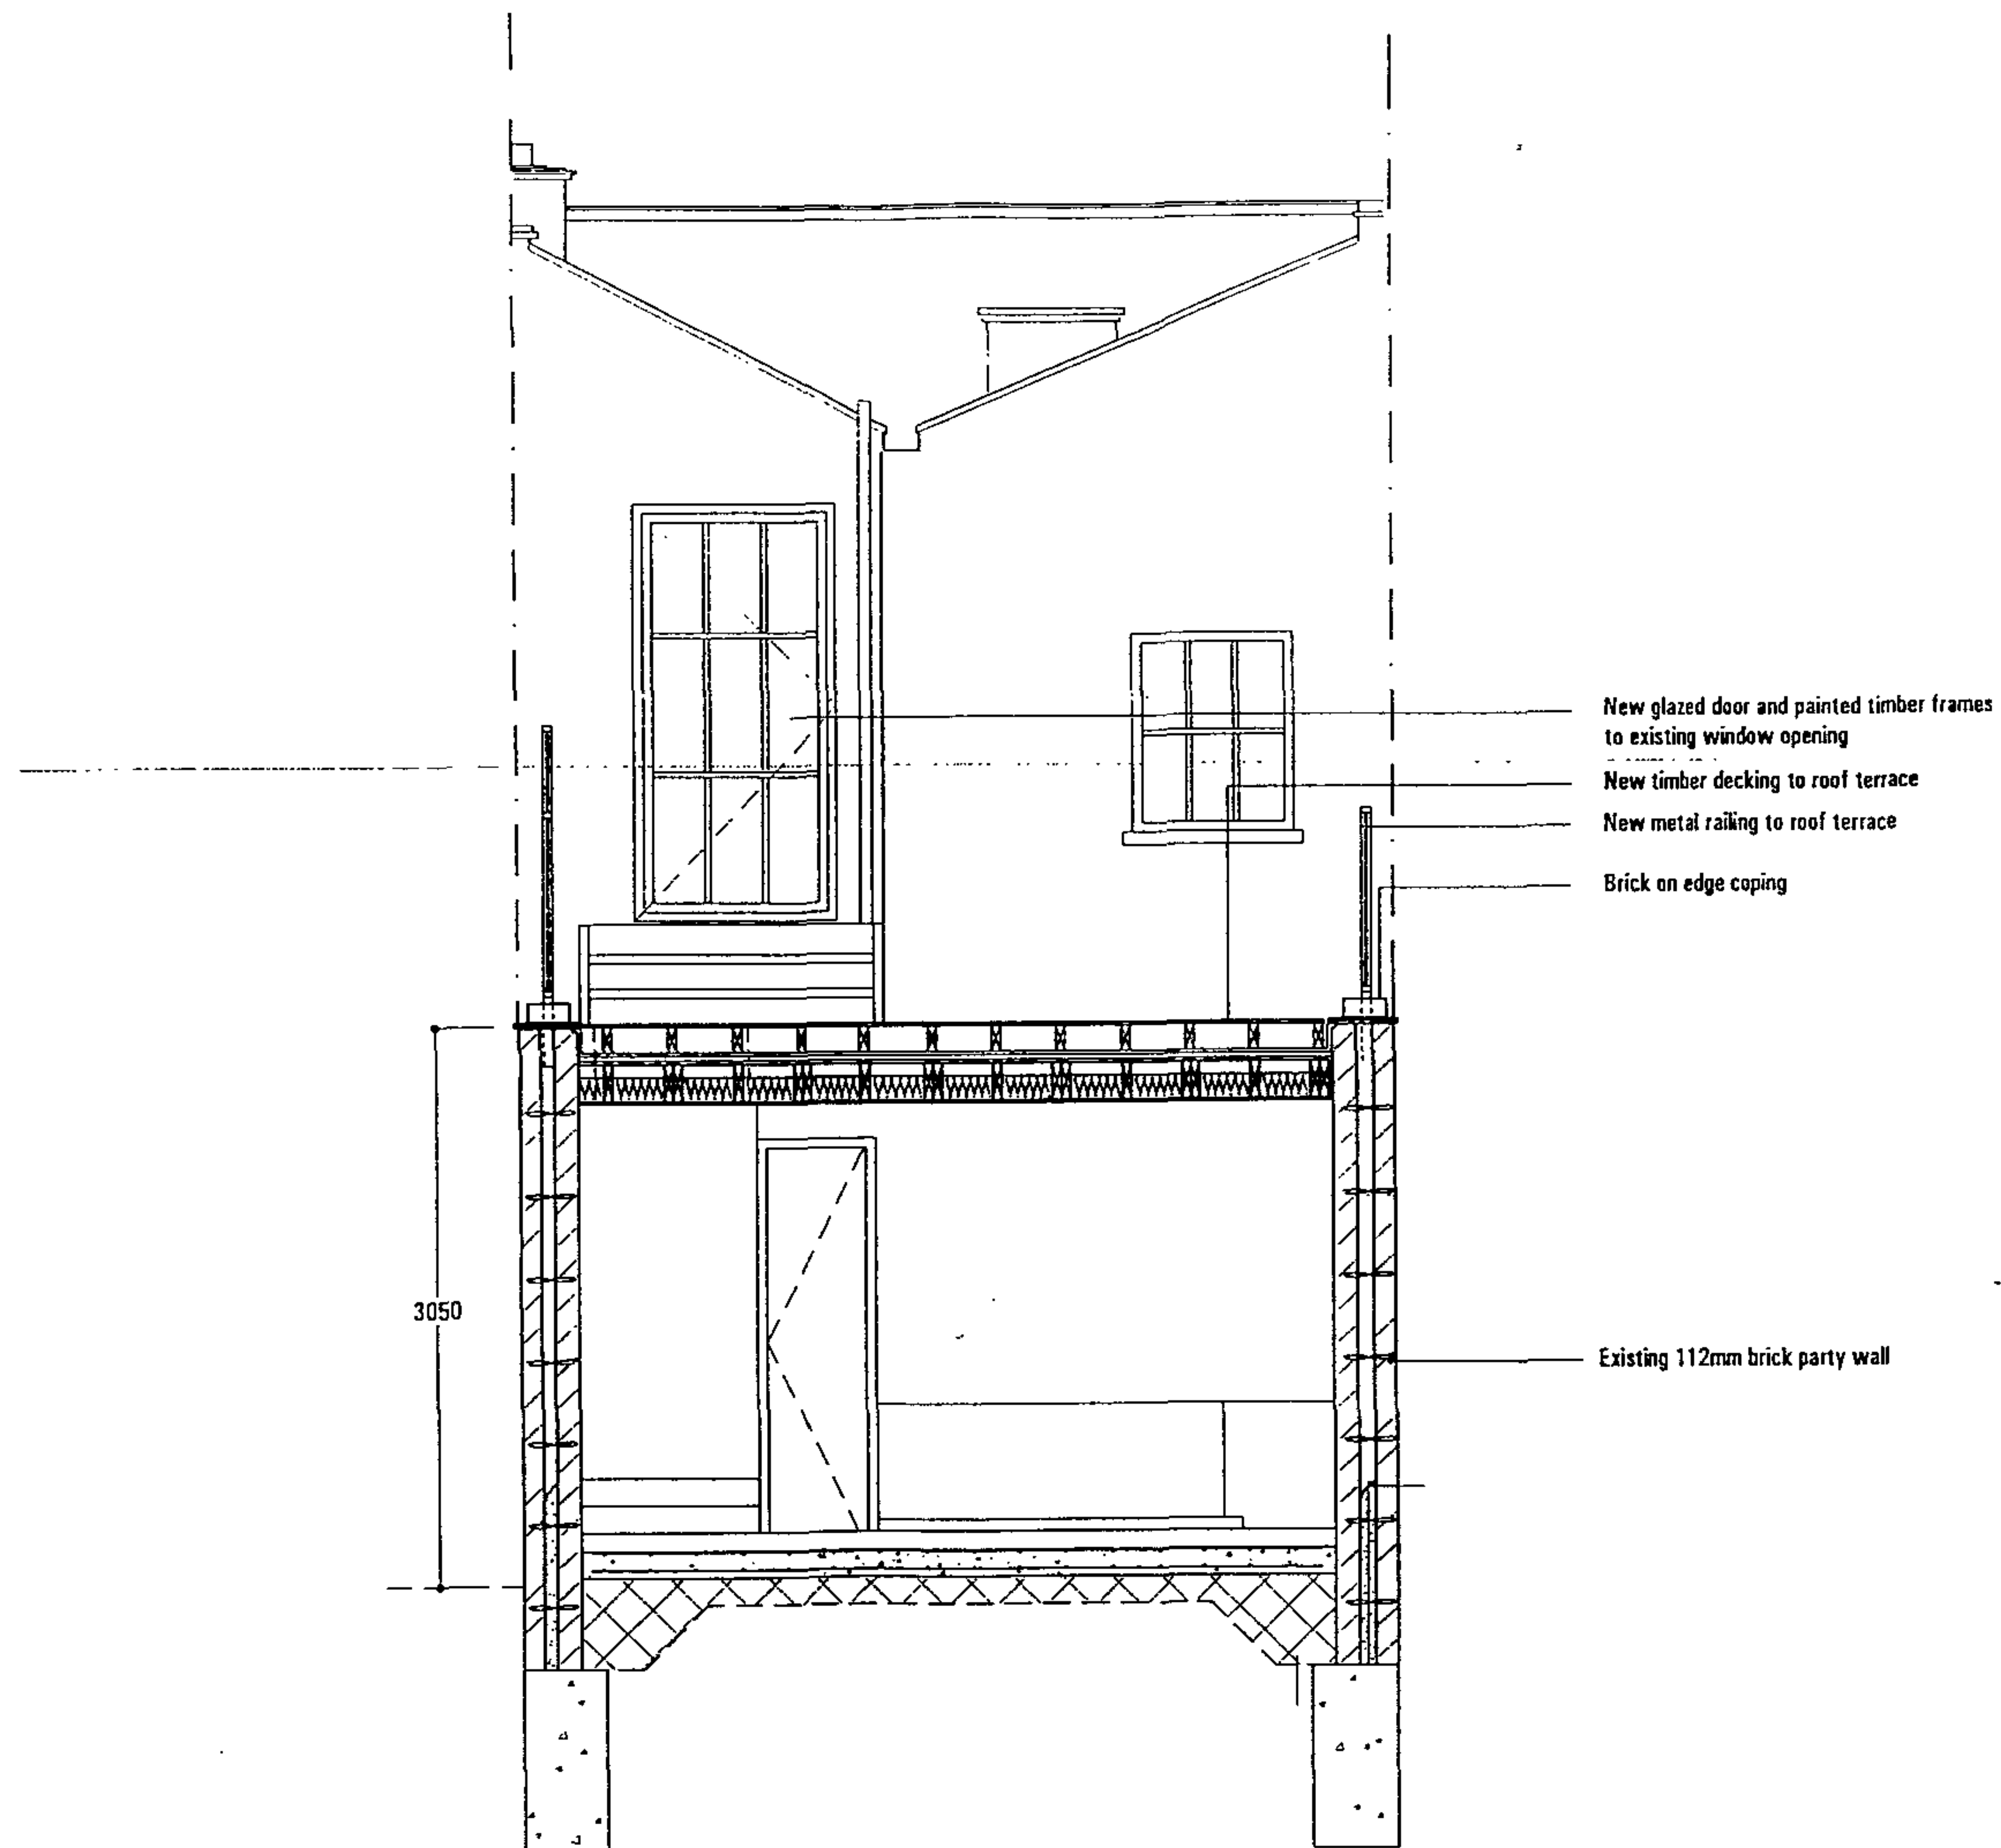

Copyright
This drawing is the property of de Metz Architects Ltd.
No disclosure or copy of it may be made without the written permission of de Metz Architects Ltd.

Note:
de Metz takes no responsibility for dimensions obtained by scaling from this drawing. If no dimension is shown the recipient must ascertain the dimension specifically from the architect or by site measurement and may not rely on the drawing. Supply of the drawing in digital form is solely for convenience and no reliance may be placed on any data in digital form. All data must be checked against hard copy. This drawing is issued for design intent only and should not be used for construction unless stated.

rev	comments	date	rev	comments	date

de metz architects address unit 4 250 linchier road london n12 3 5dn t 020 7435 1144 f 020 7435 0884 e-mail info@demetz.co.uk

de metz
architects

project
3 Wildwood Grove

title
Proposed structural section AA

status		date
scale	1:50 @ a3	April 04
job	1340	105