



42 - 40.

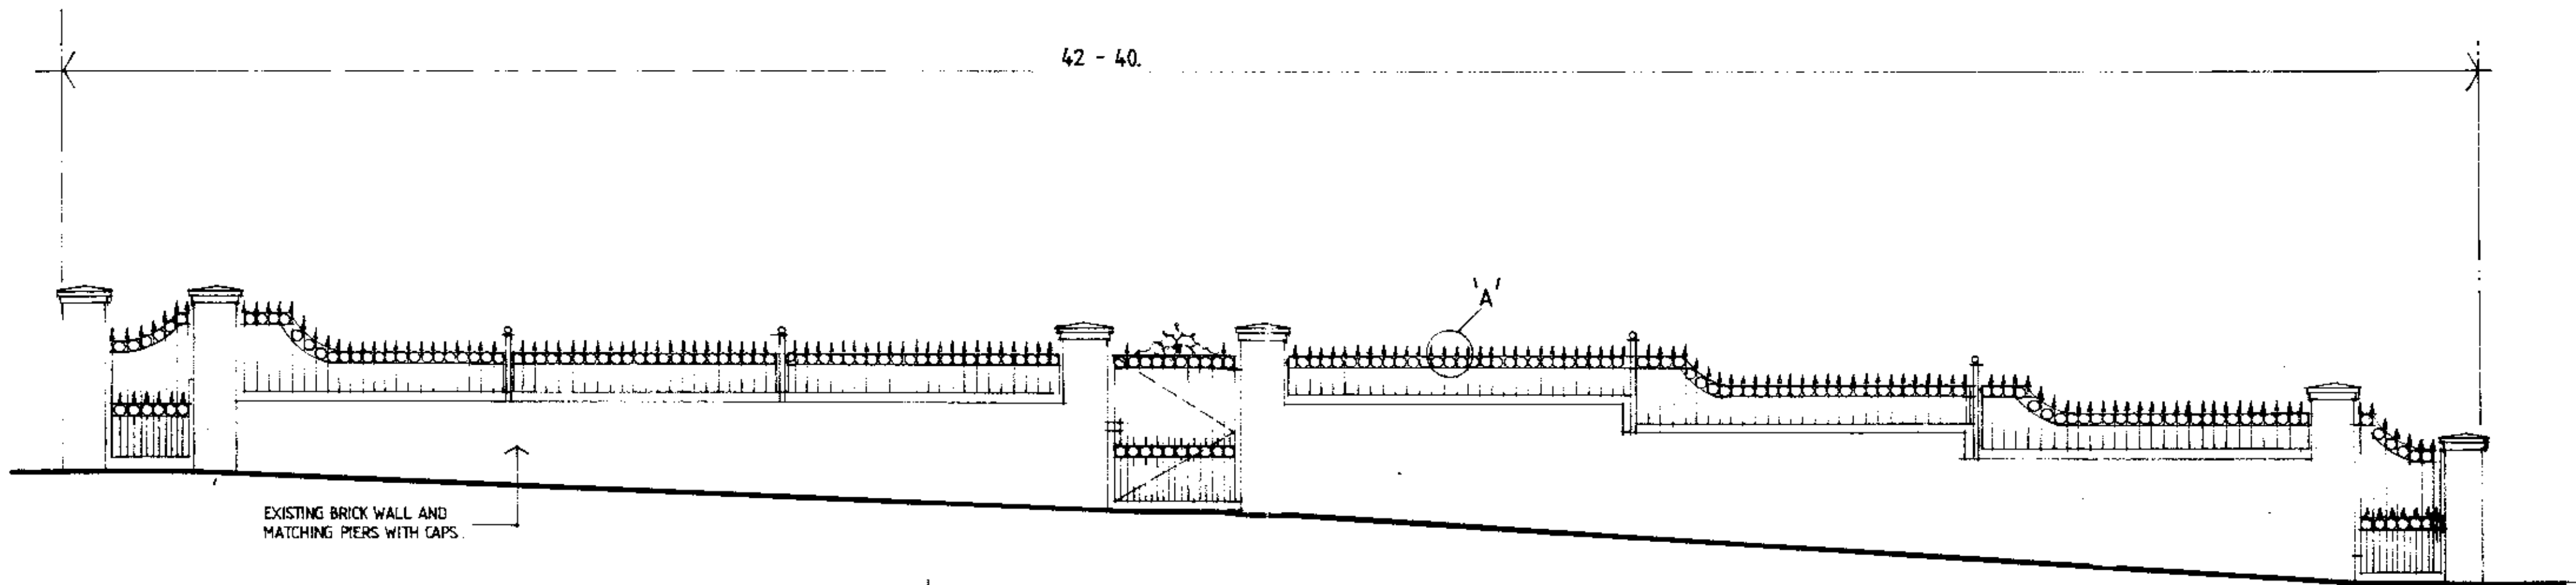

EXISTING BRICK WALL AND MATCHING PIERS WITH CAPS.

ELEVATION AS BUILT VIEW TO FITZJOHNS AVE.

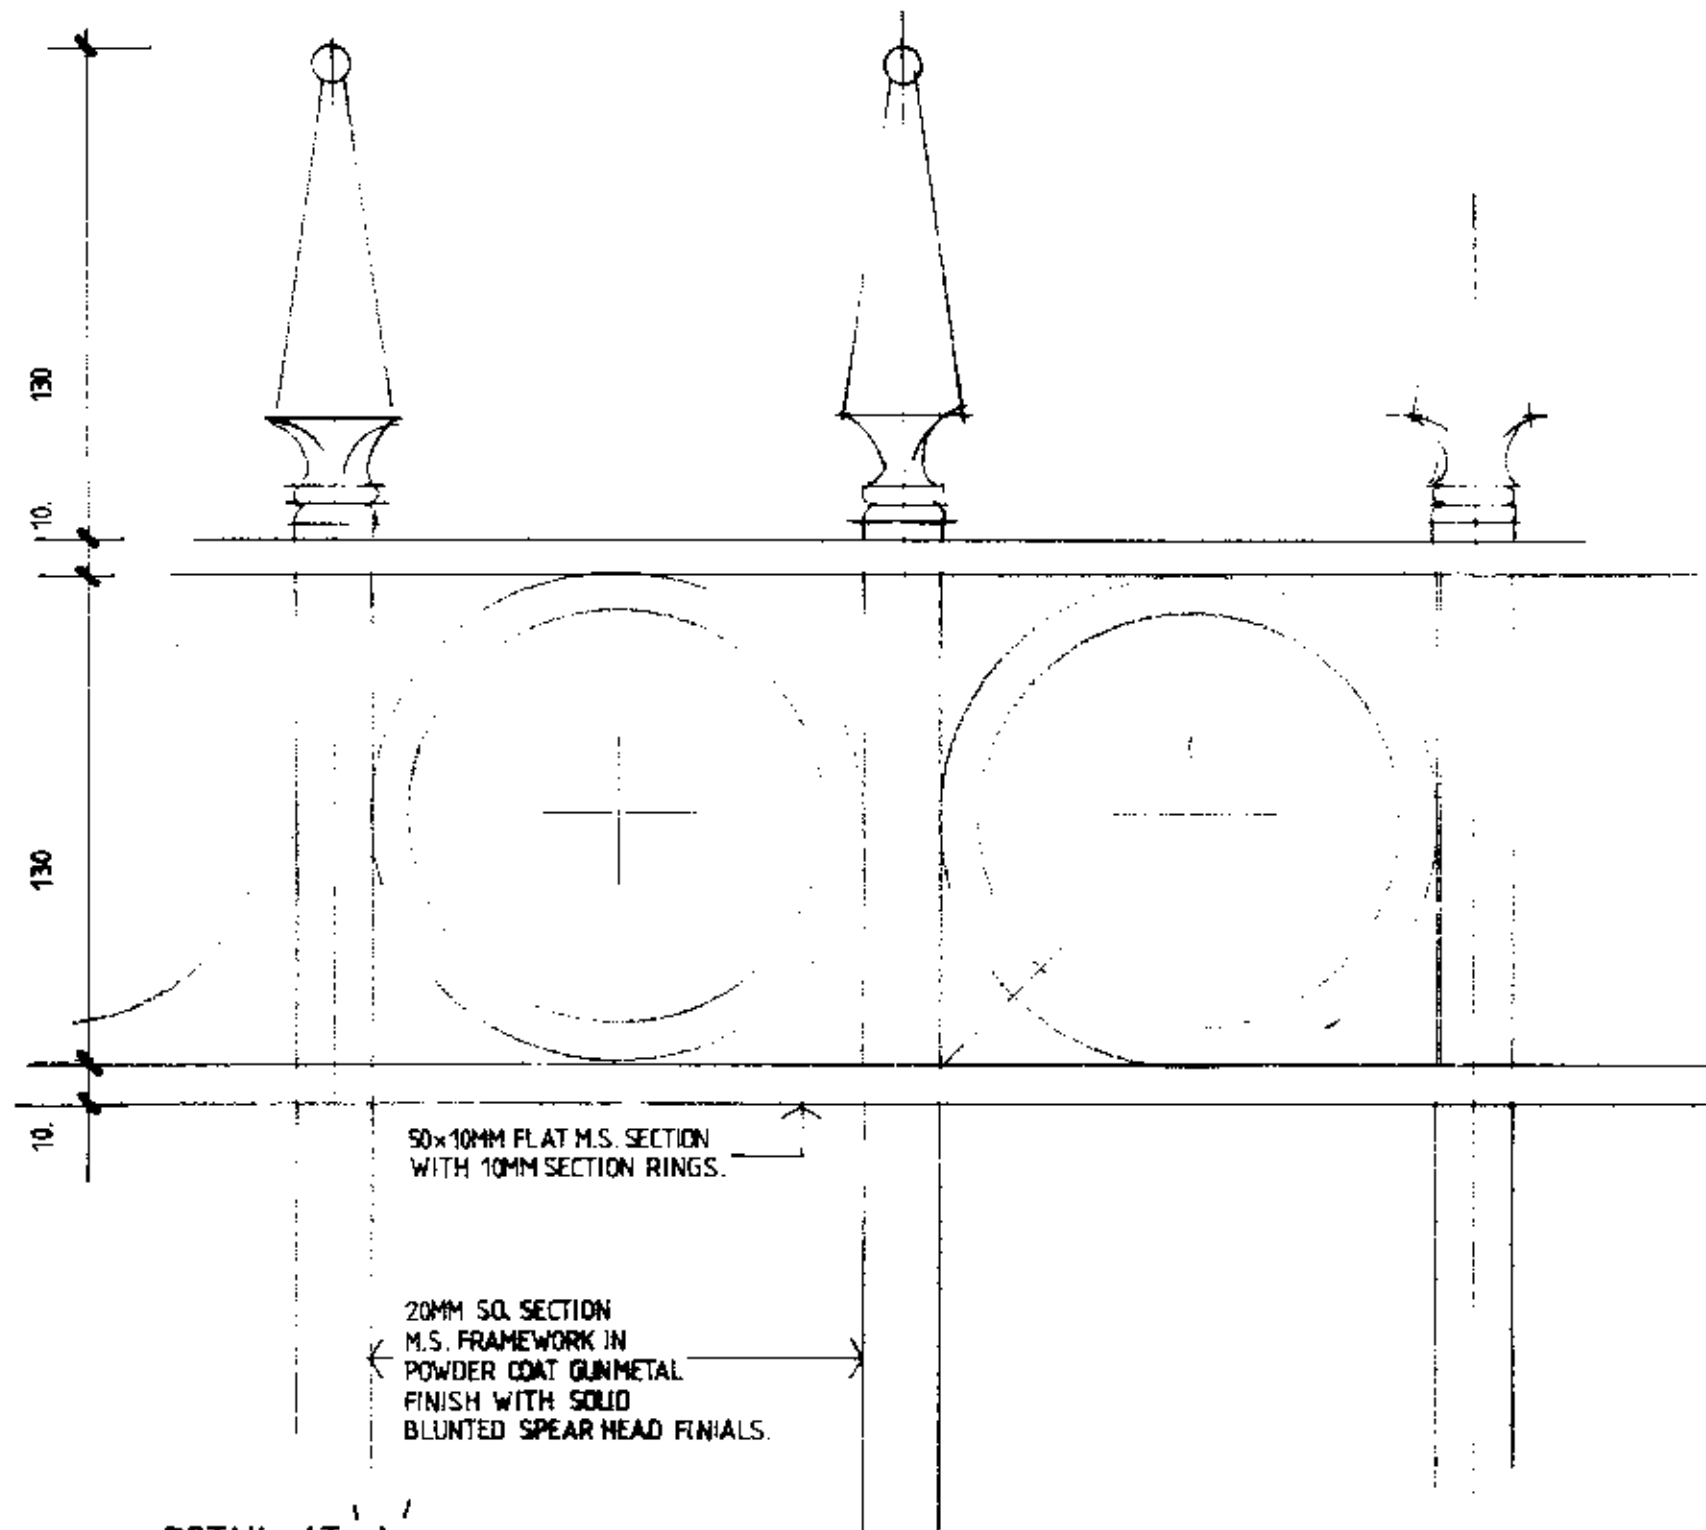


50x10MM FLAT M.S. SECTION WITH 10MM SECTION RINGS.

20MM SQ. SECTION M.S. FRAMEWORK IN POWDER COAT GUNMETAL FINISH WITH SOLID BLUNTED SPEAR HEAD FINIALS.

DETAIL AT 'A'

9902135

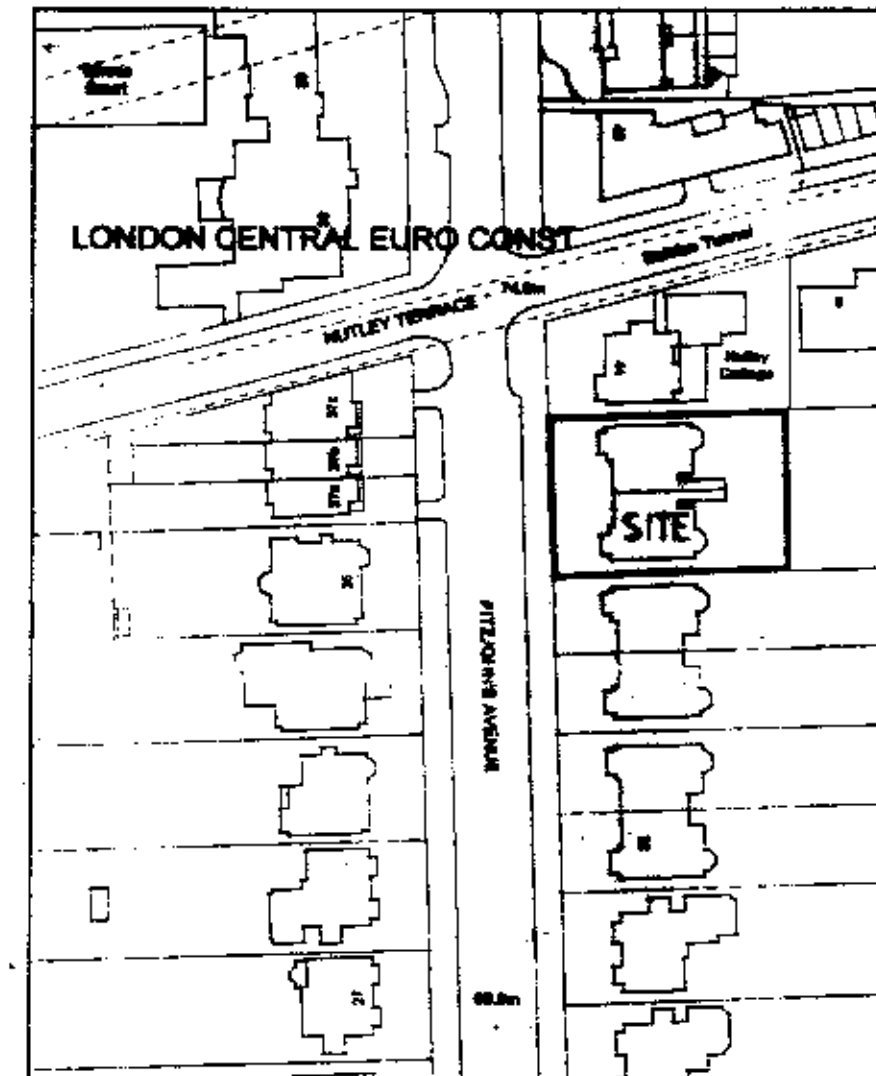

LOCATION PLAN.



MICHAEL MILLER ASSOCIATES

CHARTERED ARCHITECTS & CONSULTANT DESIGNERS

69 MULBERRY WAY
SOUTH WOODFORD LONDON E18 1EE

40-42 FITZJOHNS AVENUE
HAMPSTEAD NW3
FOR K.F. PROPERTIES.

EXTERNAL RAILINGS.

SCALE 1:50, 1:2
DATE FEB 1999.

PROJECT NO. DRAWING NO. SECTION

1441 | 106. |

THIS DRAWING IS COPYRIGHT
NO DIMENSIONS SHOULD BE SCALED FROM THIS DRAWING
ALL STATED DIMENSIONS SHOULD BE VERIFIED ON SITE BEFORE COMMENCING WORK OR PREPARING SHOP DRAWINGS

International 44 181 530 4167.
Telephone : 0181 530 4167
Fax: 0181 530 4167

