



~ NOTES ~

ALL WORK TO BE TO CLIENT & LOCAL AUTHORITY APPROVAL.
ALL RELEVANT BS's & CP's TO BE COMPLIED WITH.
ANY DISTURBANCE TO BE MADE GOOD TO MATCH EXISTING.
ARCHITRAVES, CORNICES, DOORS & SKIRTINGS TO MATCH.
SERVICES TO BE ALTERED & EXTENDED AS NECESSARY.

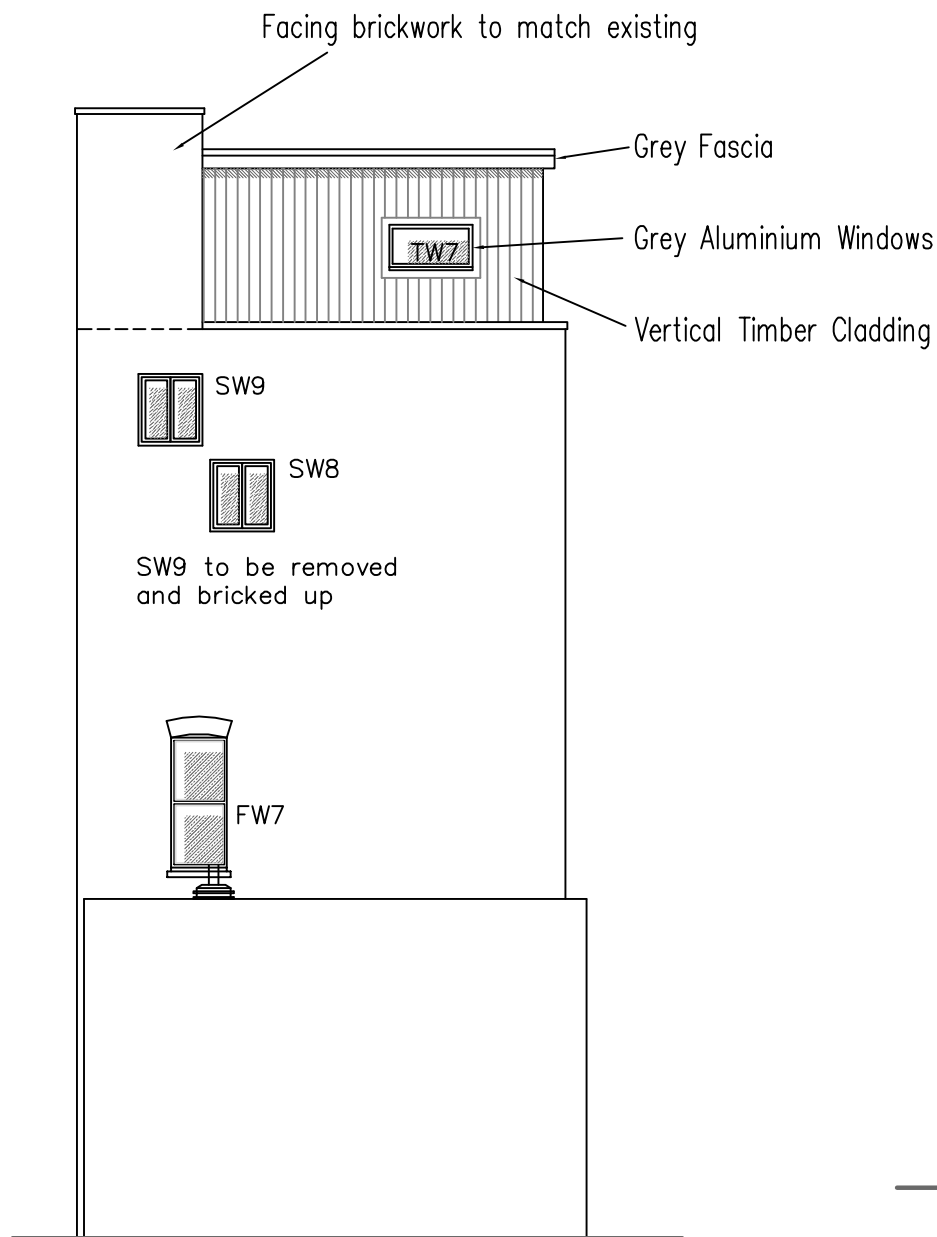

SIDE ELEVATION AS PROPOSED
KINGSGATE ROAD VIEW

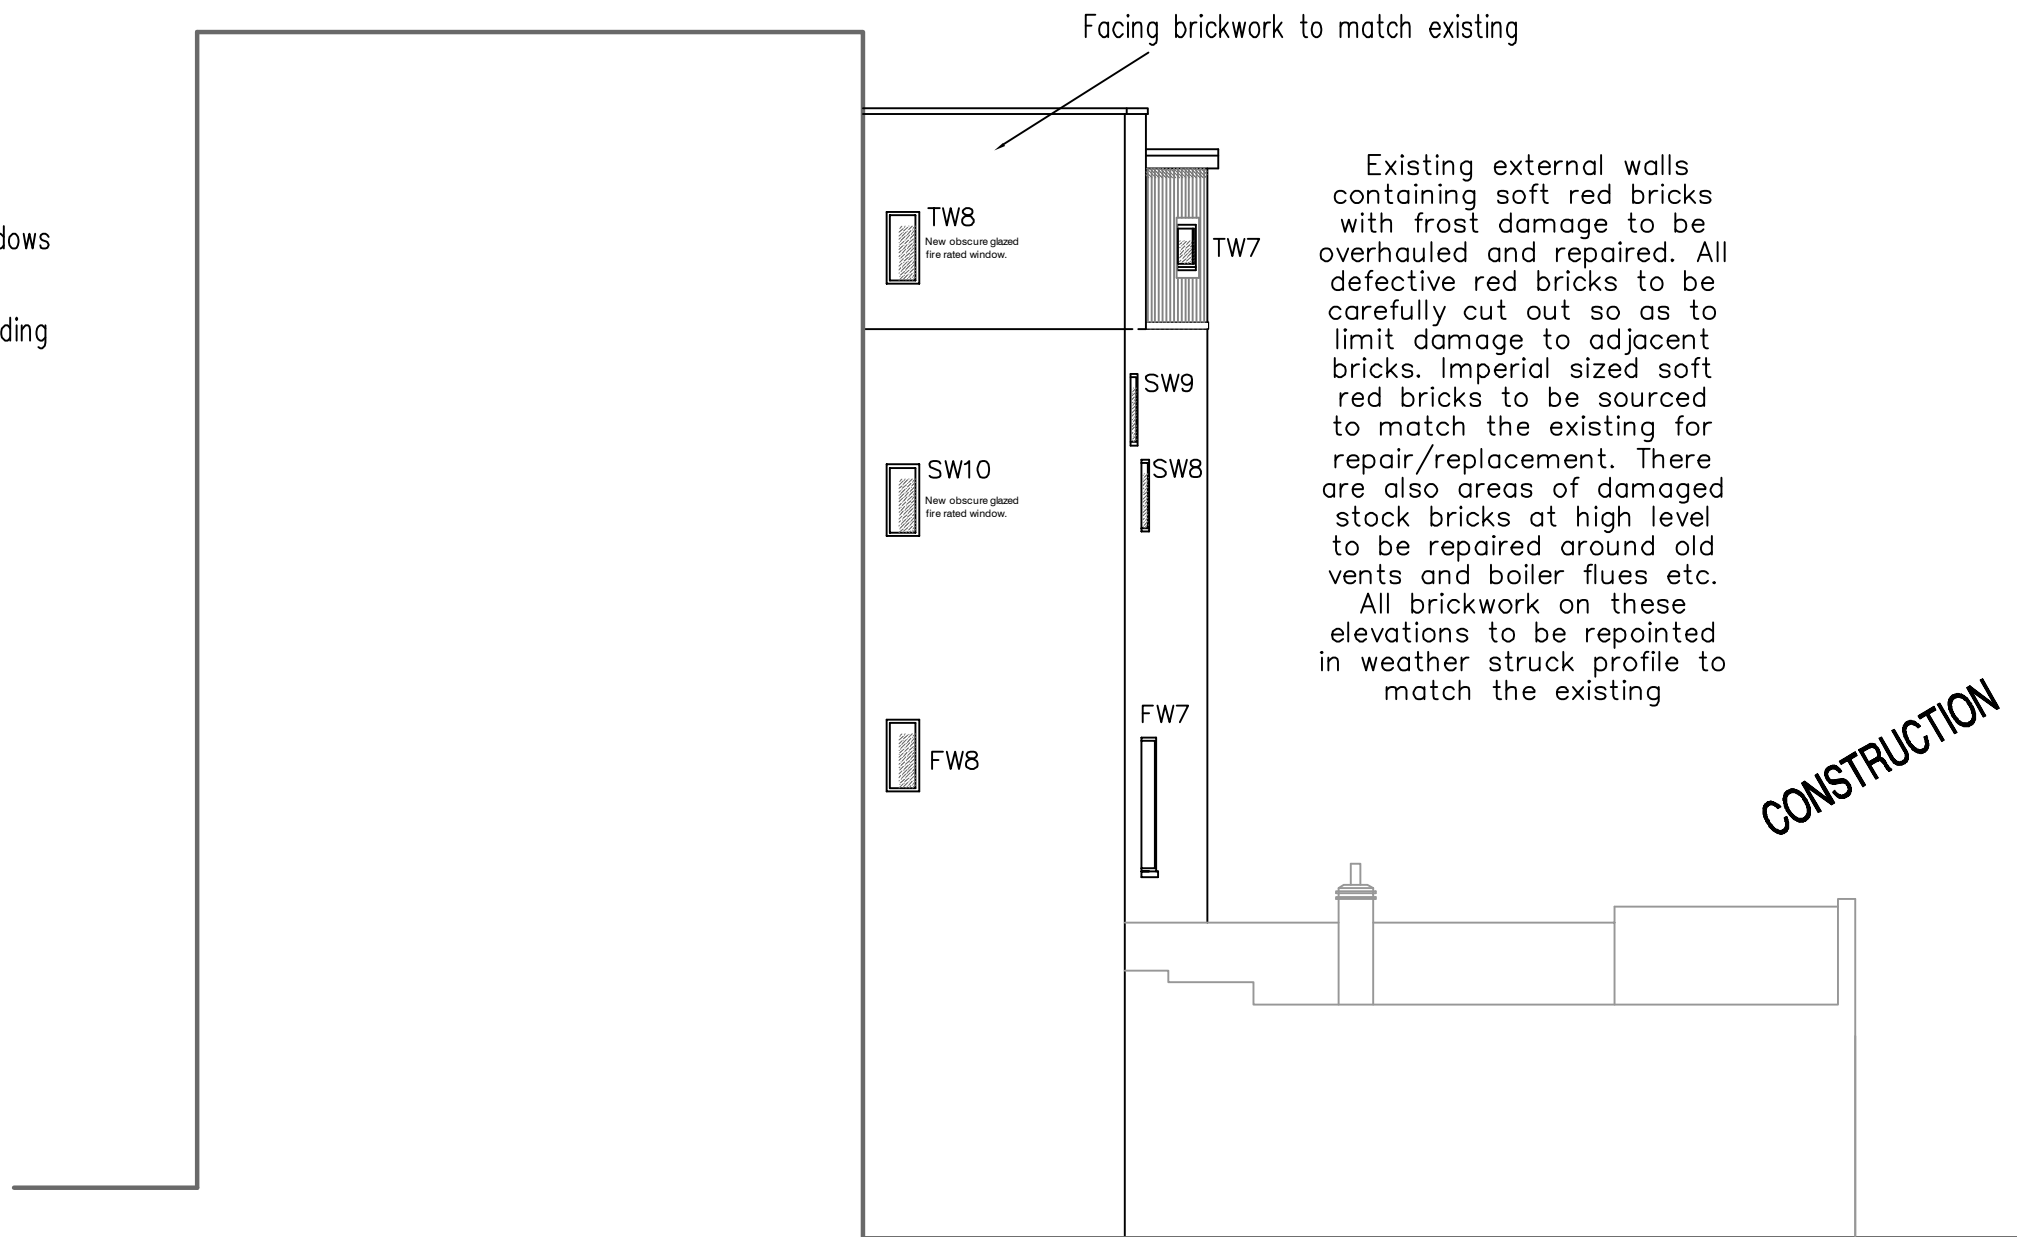

REAR ELEVATION AS PROPOSED
BEACON HOUSE VIEW

Rev D - Rear wall revised to as built	07/07/2014
Rev C - Clarification with window schedule	12/12/2013
Rev B - Issued for construction	23/09/2013
Rev A - Window references indicated	02/09/2013
REVISIONS	DATE
Architectural Design & Planning	
32 Grange Road Plymouth PL7 2HY	
t: 01752 341696 f: 07973 136876	
TITLE PROPOSED ELEVATIONS [2 of 2]	
ADDRESS 65 HEMSTAL ROAD LONDON NW6 2AE	
CLIENT COBSTAR Ltd	
SCALE A3 1:100 & 1:50	DATE JUNE 2013
DRAWING No. 130613/ PL/ 06	REV. D