


Sodexo, One Southampton Row - Southampton Place Elevation



Ventilation Grill Locations (1:50@A3)


Grills to be located within mansard roof lead flashing behind and below the parapet wall.

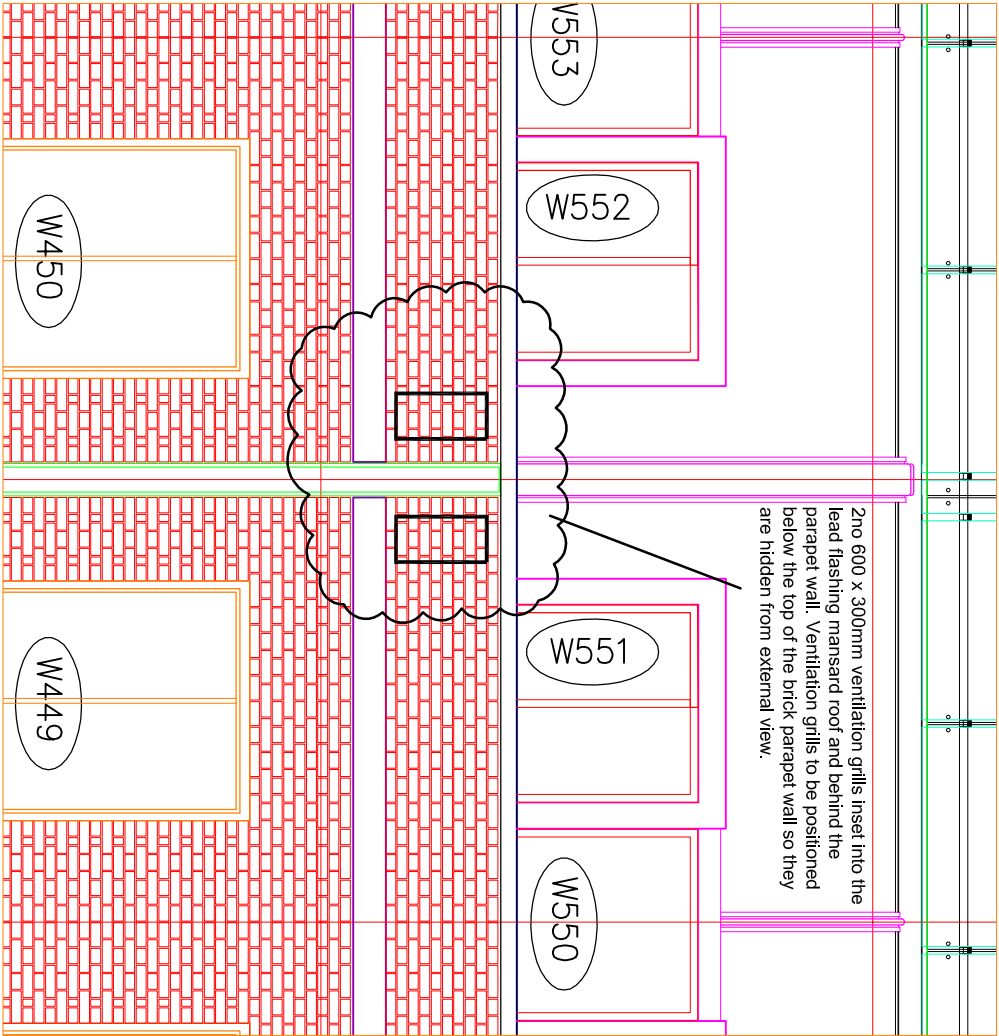

Grill Locations



Parapet Wall

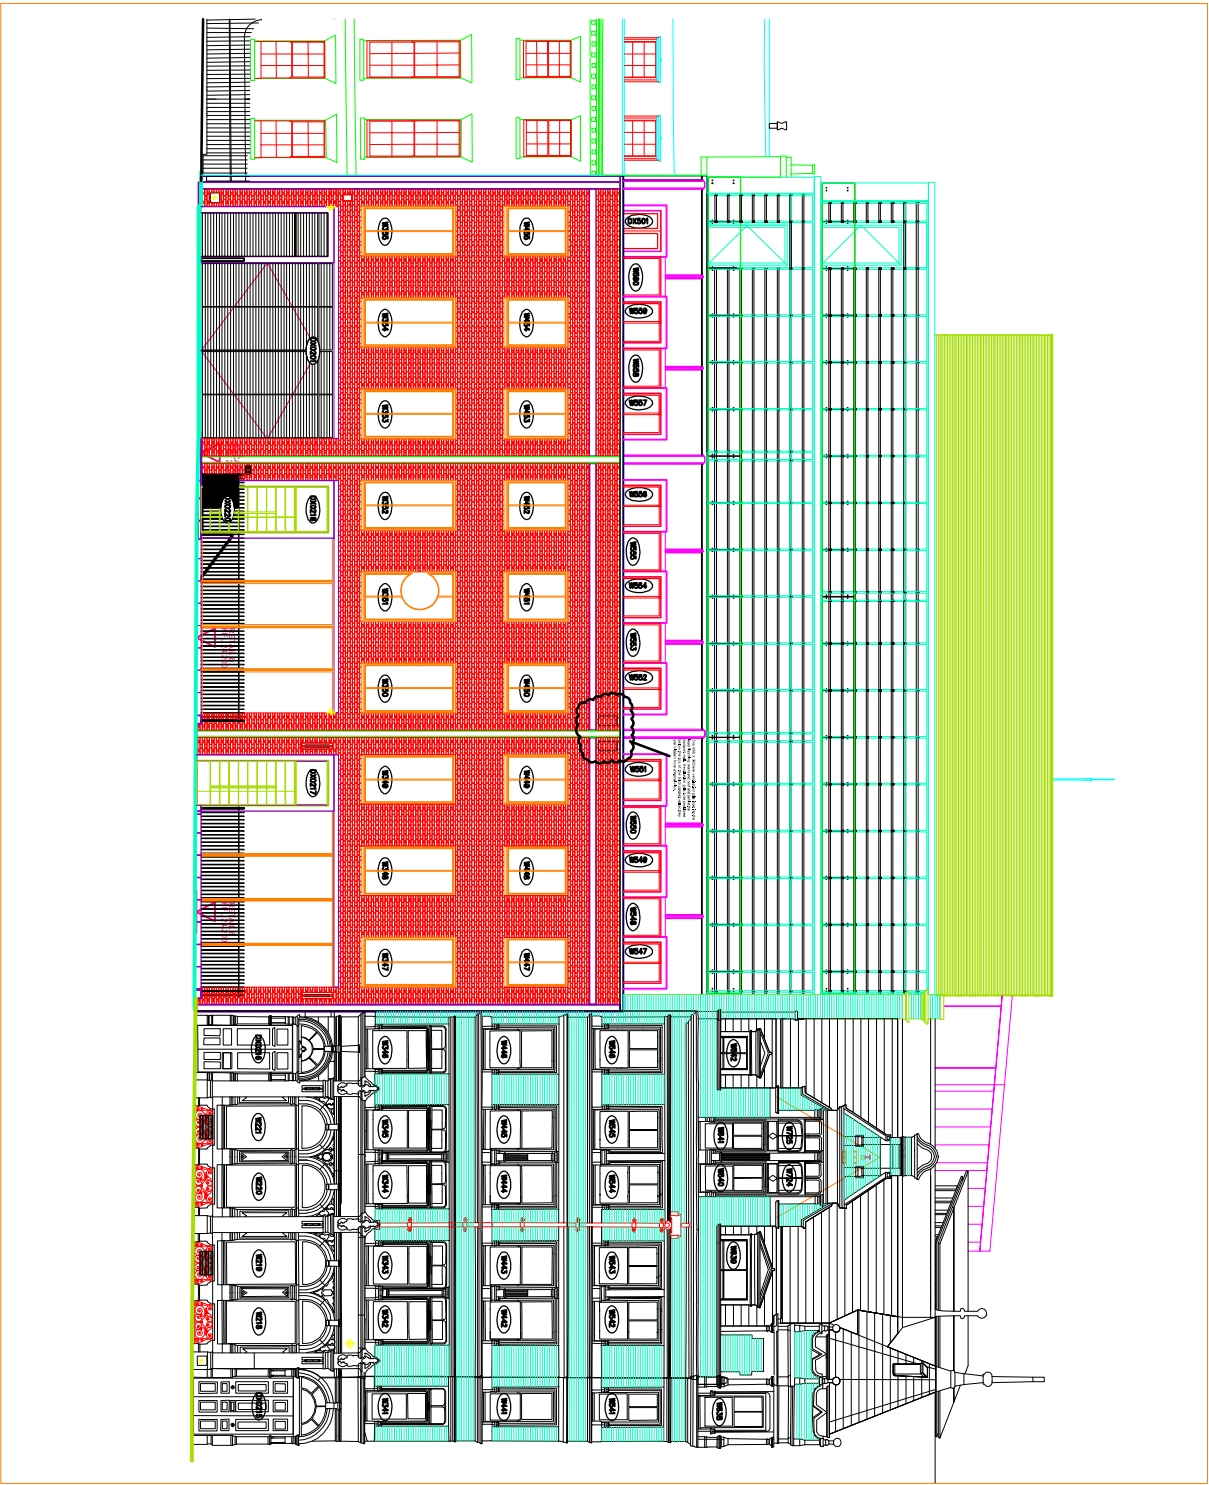

Sodexo, One Southampton Place Elevation (NTS)

FOR INFORMATION

NOTE:
ALL DIMENSIONS MUST BE CHECKED ON SITE
AND NOT SCALED FROM THIS DRAWING

© This document is the property of AOS UK.
Copyright is reserved by them, and the drawing is issued on condition that it is not copied, reproduced, or retained by, nor used in any way, without the consent in writing from AOS UK.
Drawings are for general arrangement only. Dimensions are to be checked on site by the contractor and discrepancies to be reported in writing prior to commencement of work.

Rev	Description	By	Date	Checked By	Date
As Built					
Construction Issue					
Tender Issue					
Sign Off					
Designed By	SJ	Checked By	NU	Date	10.06

Realising. Creating. Sustaining
Successful Space
138 Cheapside,
London, EC2V 6BSJ
TEL: +44(0) 20 7288 6580, FAX: +44 (0) 20 7397 8260

AOS
studley

Client	Sodexo
Project	3rd Floor One Southampton Row Holborn
Drawing	Ventilation Grill Locations One Southampton Place Elevation
Scale	As Shown
Date	10.06.14
Job No.	03
Area / Floor	DET14
Rev	0
Job No.	SOD140202