
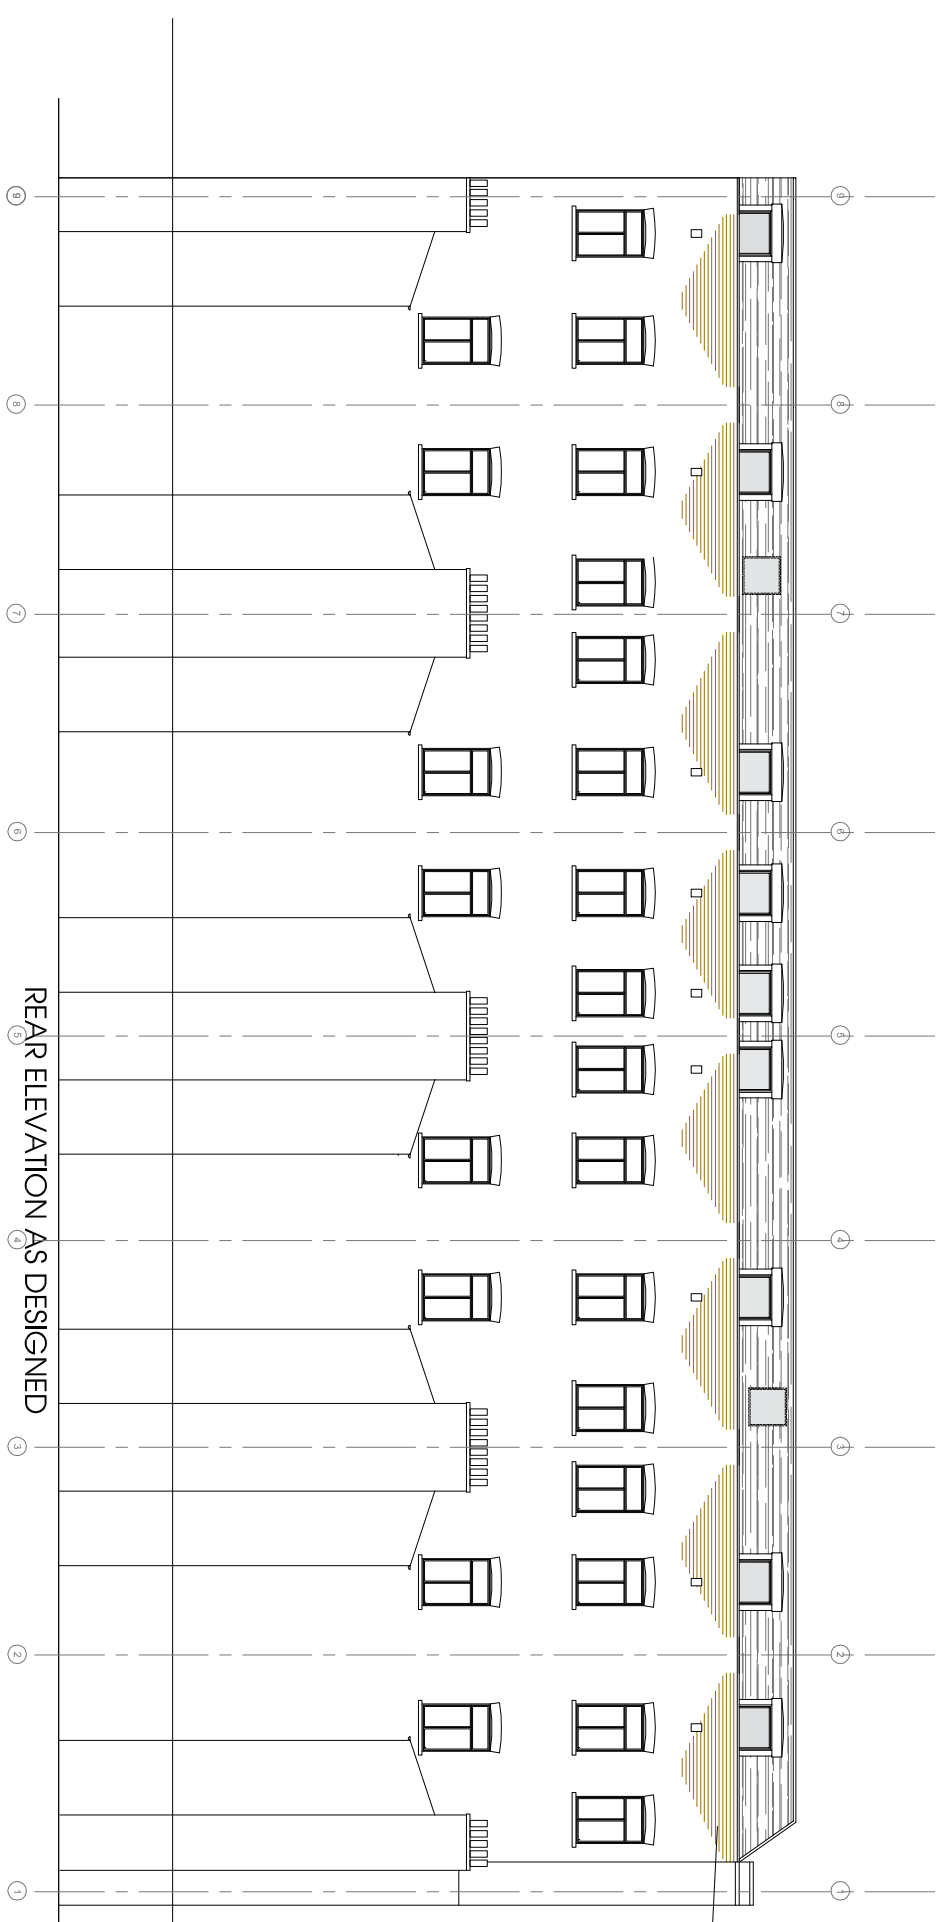


artificial slate to pitched roof
 lead roof to dormer
 white rendered dormer cheeks
 white aluminium windows

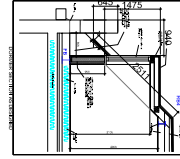

artificial slate to pitched roof
 lead roof to dormer
 white rendered dormer cheeks
 white aluminium windows
 face brick to match extg

FRONT ELEVATION AS DESIGNED

REAR ELEVATION AS DESIGNED

TITLE ELEVATIONS AS BUILT

CLIENT RAINBOW PROPERTIES LTD.

ADDRESS LINBURN HOUSE, 340-354 KILBURN HIGH ROAD,
 LONDON, NW6 2QJ

SCALE 1:200 @ A3

DRAWING NO. 02

DATE AUG 2014
 REV. B