


FLOOR PLAN

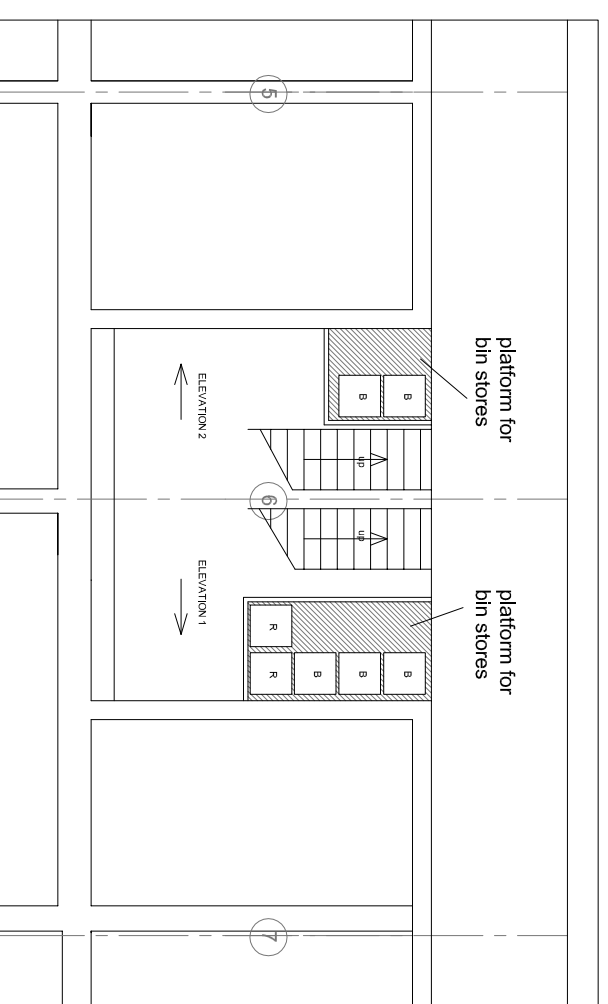

FLOOR PLAN

TITLE **ELEVATIONS AS BUILT**

ADDRESS **LINBURN HOUSE, 340-354 KILBURN HIGH ROAD.**

CLIENT **RAINBOW PROPERTIES LTD.**

LONDON, NW6 2QJ

SCALE **1:200 & 1:100 @ A3**

DATE **AUG 2014**

DRAWING NO. **condition 1**

REV. **B**