


revision	date	author	revision notes
T1	17.05.13	GLJ	First draft tender.
C1	30.08.13	GLJ	For construction issue.
C2	10.02.14	GMH	Extension stretched to fit site dims.
C3	27.02.14	GLJ	General amendments to as built shot glass link amended.
C4	21.07.14	ame	dimensions added; scale amended

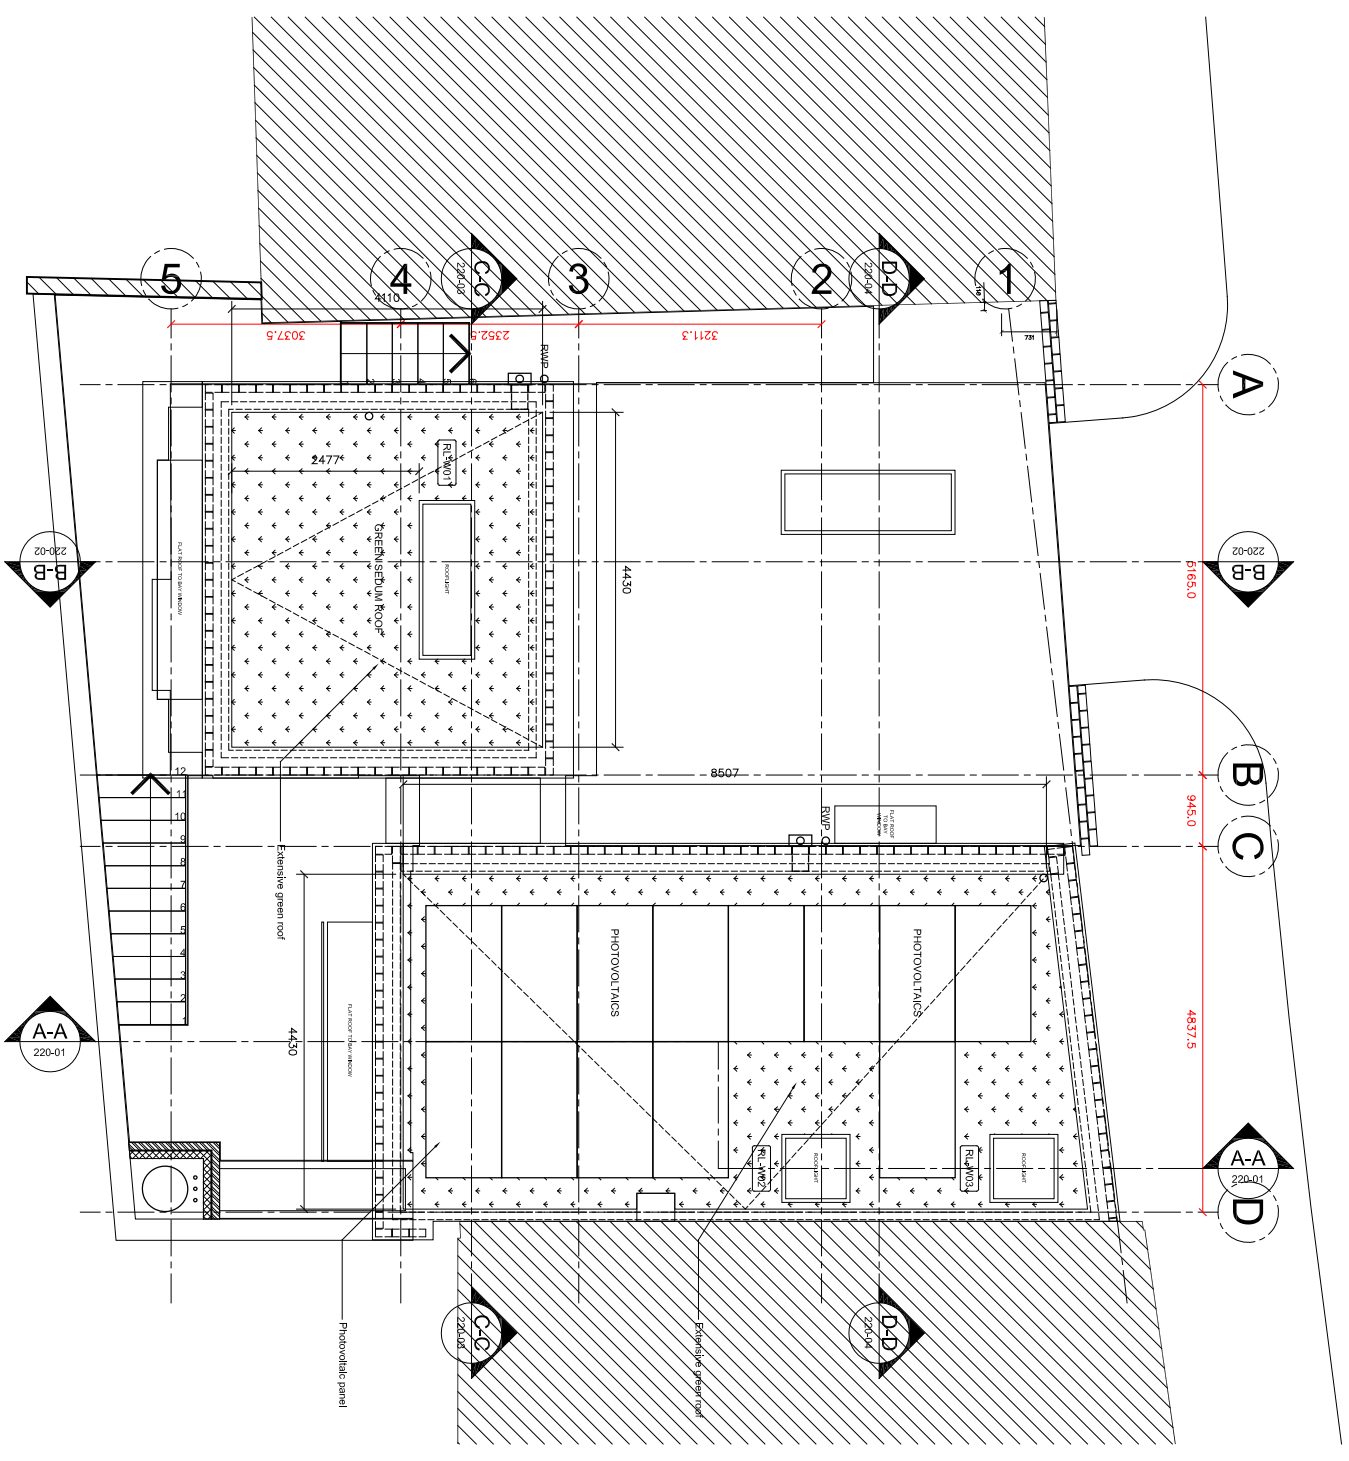

FOR CONSTRUCTION

PROJECT: 43 Belisle Lane, NW3
 DRAWING: GA Roof Plan
 SCALE: 1:50 @ A3
 DATE: 09.08.12
 AUTHOR: GLJ
 PROJECT NO.: 100-05
 DRAWING NO.: C4