


ALL NEW TILES TO MATCH EXISTING



PROPOSED REAR ELEVATION

NEW VELUX 2660.7 MM TILE CLADDING TO FACE AND CHEEKS

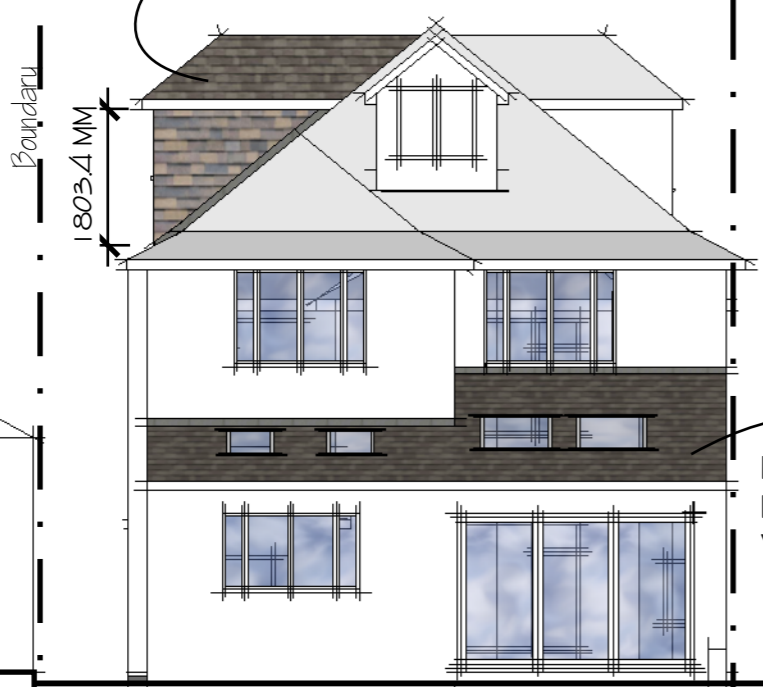


PROPOSED FRONT ELEVATION

NEW PITCHED ROOF WITH VELUX


LINE OF NEIGHBOURS PROPERTY

means of escape  
First floor windows to have an opening area of at least 750x450 with the cill no more than 1100mm from floor

glazed areas within 800mm of floor level to be laminated or toughened glass - within 1500mm from FFL in doors

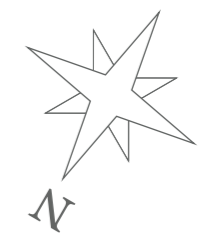


OBSCURE GLAZED

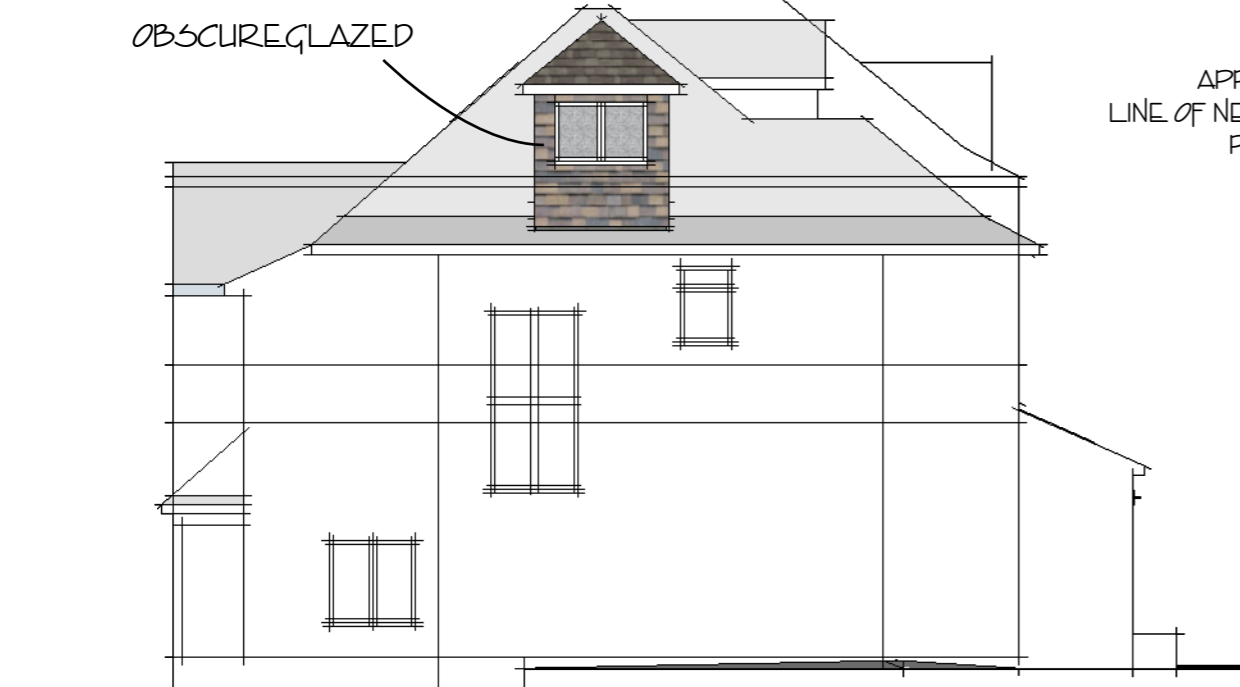

PROPOSED SIDE ELEVATION

APPROXIMATE LINE OF NEIGHBOURS PROPERTY

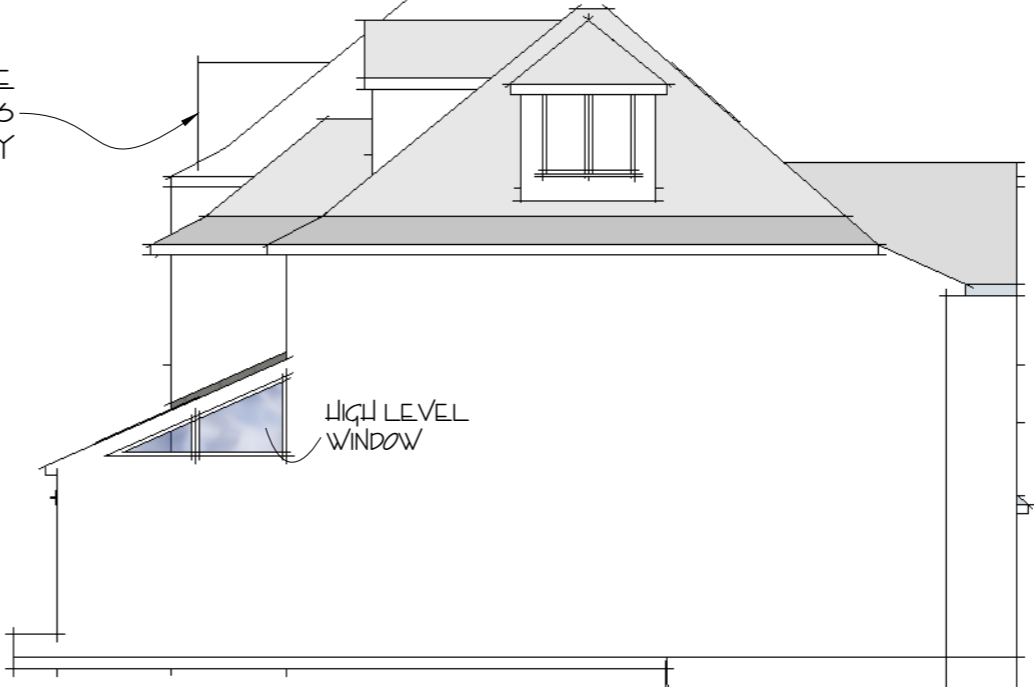


PROPOSED SIDE ELEVATION

**ATK DESIGNS**  
16 SCHOOL LANE  
OFFLEY  
NR LITTLIN  
HERTS  
SG5 3AZ  
TEL 07595293528  
E-MAIL atkdesigns2@gmail.com

client  
MR M BRAHAM  
17 MAKEPEACE ROAD  
LONDON  
N6 6EL

project  
NEW SIDE DORMER  
AND RETENTION OF  
PITCHED ROOF TO REAR  
EXTENSION

AS BUILT

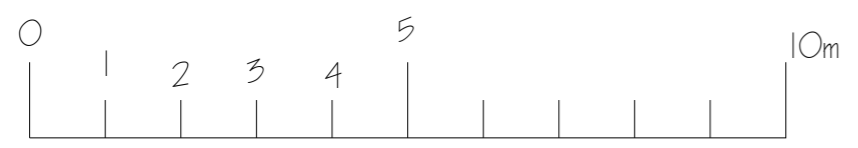

drawing no ATK/13/JM/TP1A	<b>A3</b>
date JULY 2014	
scale 1:100	