

Elevations showing louvre locations

3210-DR-2000 West Elevation Building 2 showing air intake
louvres at level 5

3210-DR-2001 West Elevation Building 1 showing air intake
louvres at level 5


3210-DR-2010 East Elevation Building 2

3210-DR-2020 East Elevation Building 1


RSHP-99-DR-0801 East elevation building 1 showing ductwork

RSHP-99-DR-0805 East elevation building 4 showing ductwork

RSHP-99-DR-0811 West elevation building 2 showing ductwork

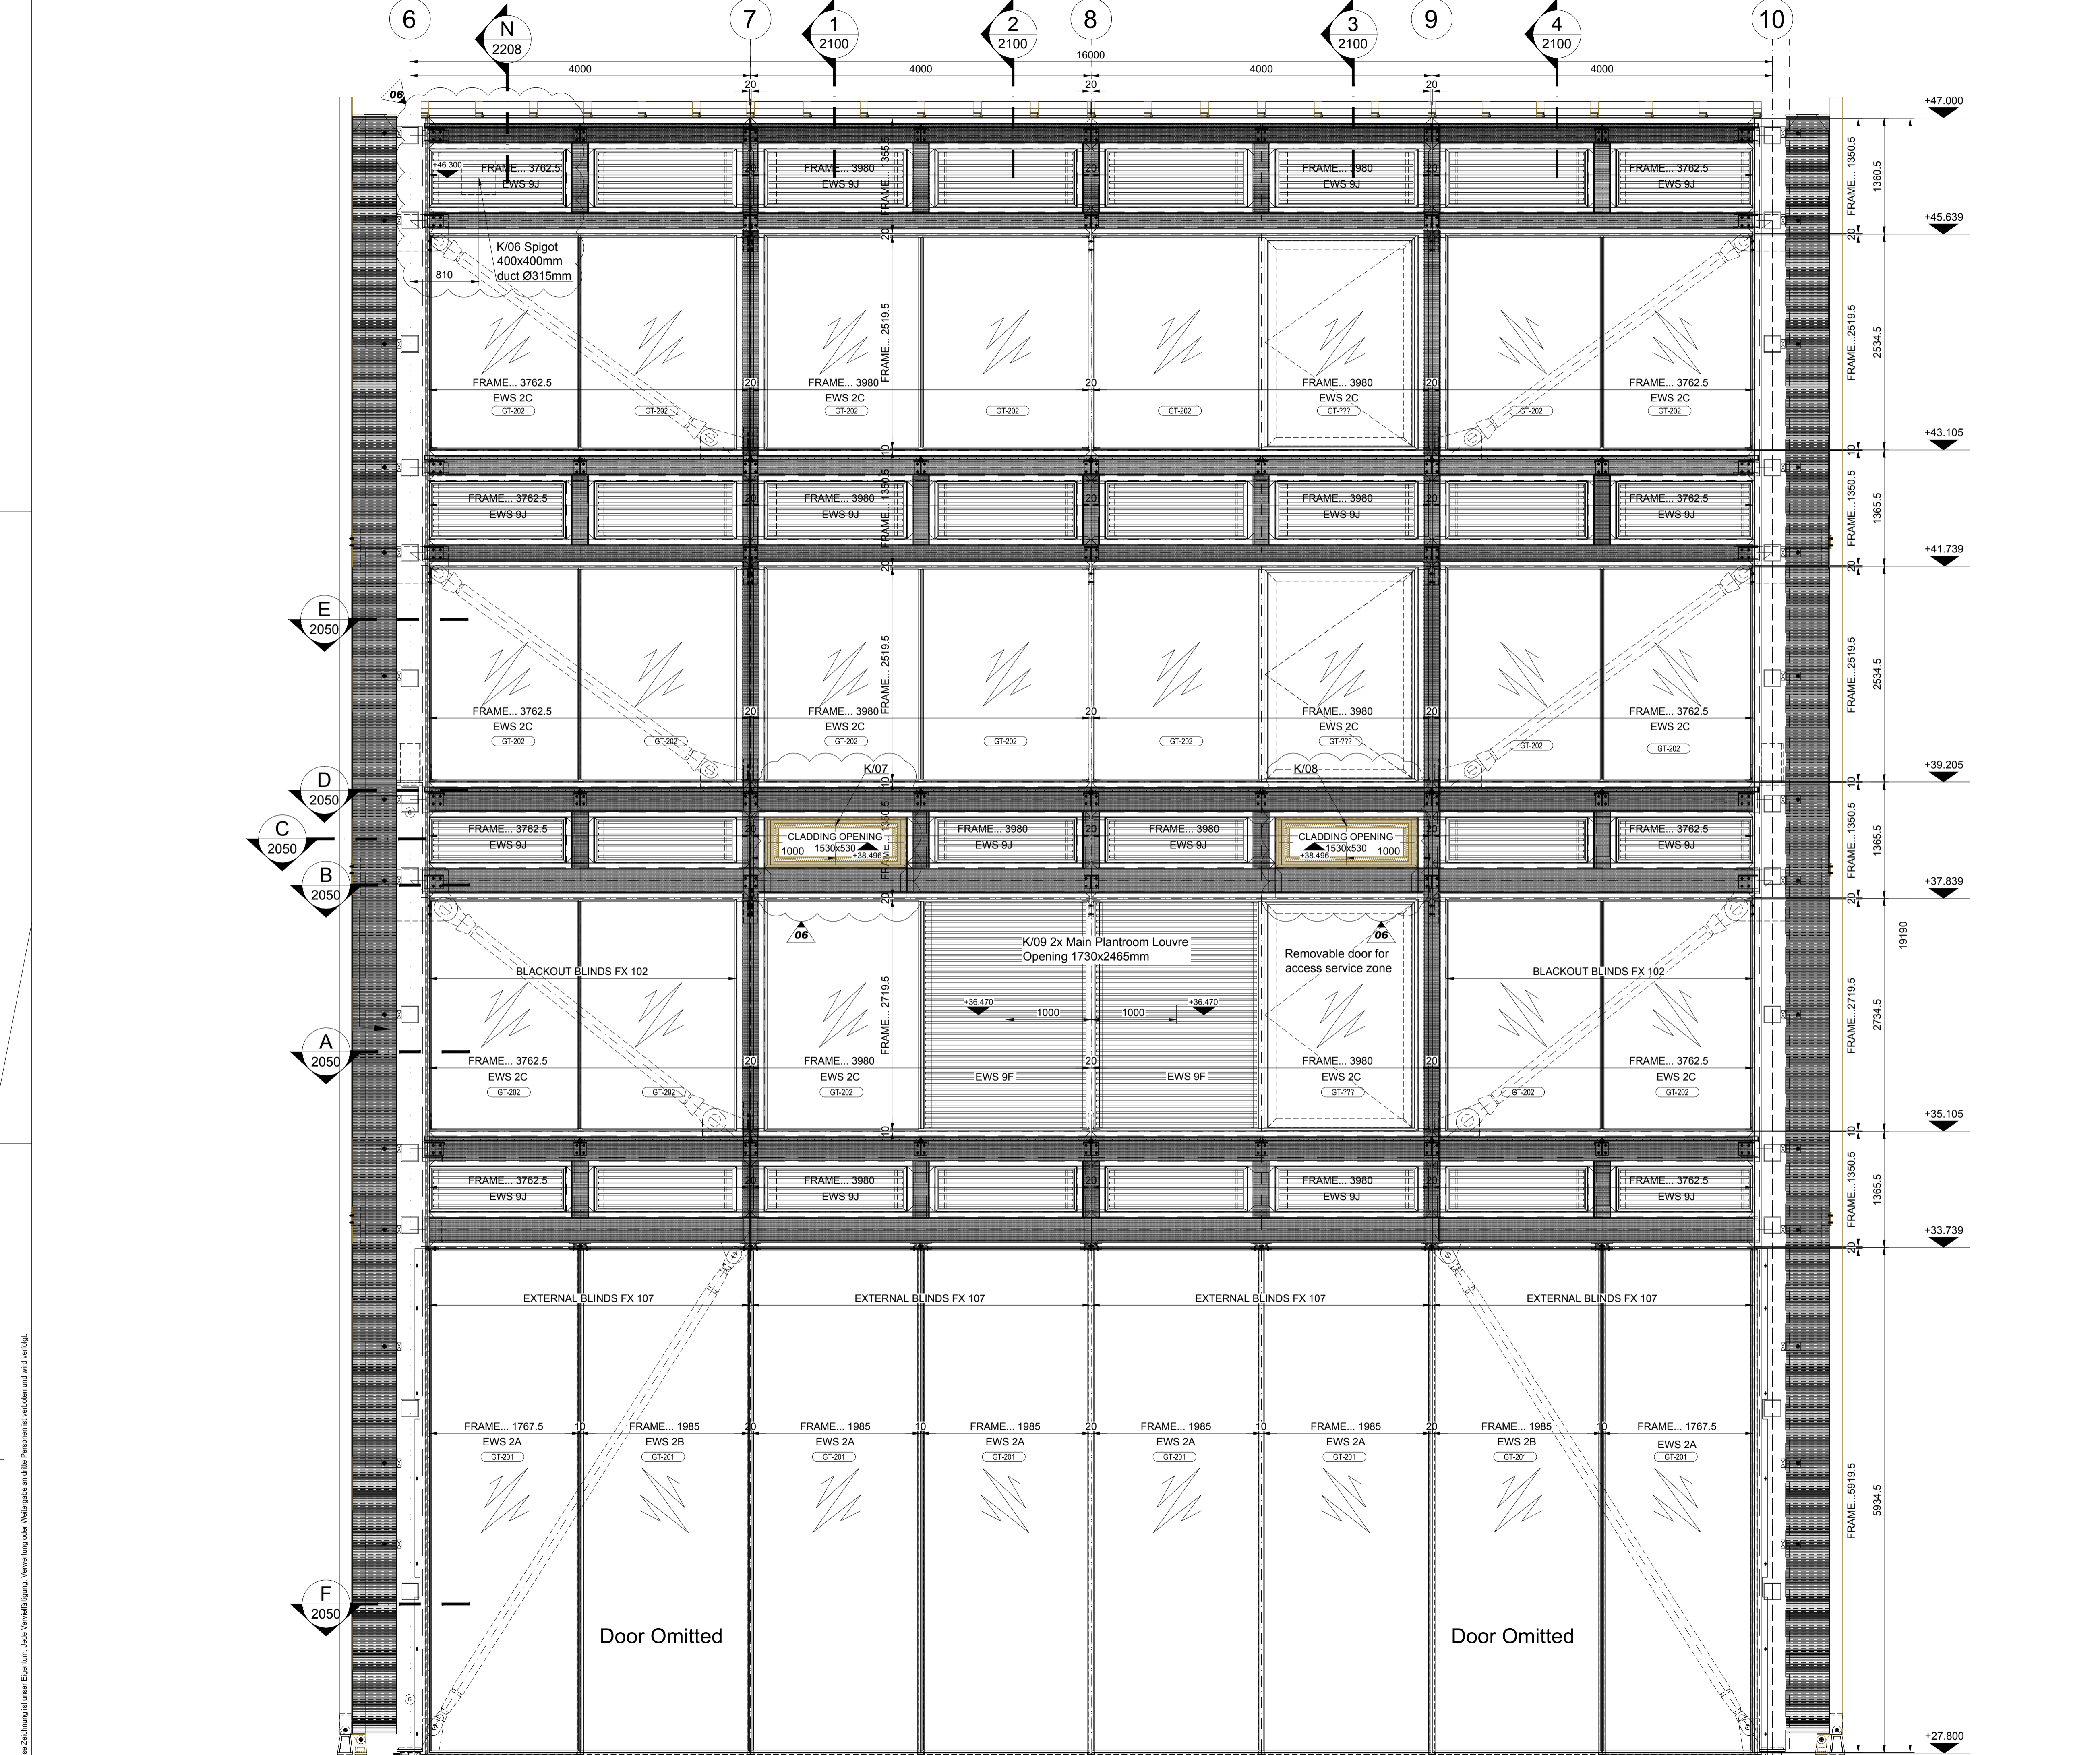

Diese Zeichnung ist unser Eigentum. Jede Vervielfältigung, Verwertung oder Weitergabe an Dritte Personen ist verboten und wird verfolgt.



THE BRITISH MUSEUM
World Conservation and Exhibitions Centre

GIG FASSADEN GmbH
Industriestraße 3D
A-4850 Althaus-Puchheim
Tel.: +43(0)7674602-0
www.gig.at

DOCUMENT / DRAWING STATUS

TENDER

PRELIMINARY / DRAFT

FOR INFORMATION

STATUS

FOR APPROVAL / COM.

FOR CONSTRUCTION

AS BUILT

STATUS DATE

A 28.09.2012

NO.	REVISION / DESCRIPTION	DATE
06	Ductwork reconciled with MJL	18.12.2012
05	As built	27.11.2012
04	Updated according comments	20.08.2012
03	Updated according EWS 02 comments	07.05.2012
02	revisions/updates updated	8.03.2012
01	updated acc. comments	24.02.2012

PROJEKT / PROJECT	British Museum; London Great Russell Street, London WC1B 3DG	KOMM. NR. / COM. NO.	110073
BAUHERR / CLIENT	The British Museum Great Russell Street, London WC1B 3DG	DATUM / DATE	26.01.2012
GENERALUNTERNEHMER / MAIN CONTRACTOR	Mace (Construction Manager)	GEZEICHNET / DRAWN	IYO
ARCHITEKT / ARCHITECT	Rogers Stirk Harbour & Partners Thames Water, Riverside Road, London W6 9JA	MASSTAB / SCALE	1:25
BEZEICHNUNG / DRAWING TITLE	ELEVATION K-BUILDING 2 EWS 02-ELEVATION	PACKAGE NO.	3210-DR-2000
		TYPE	DWG NO.
			REVISION
			06

C:\Programme\2011\1007300_Termin300_GIG\Drawings\3210_EWS_02\EWS_02-ELEVATION_K-Building_2_REV.03.dwg; 3210-DR-2000; 18.12.2012 13:35:35; von WEB