


Section AA



Section BB

- 1. Metal balustrade (as built)
- 2. Flat roof (as built)
- 3. Levelled gable wall (as built)
- 4. French Doors
- 5. Proposed lockable balustrade. Openable for maintenance to flat roof only
- 6. French door changed to open inwards

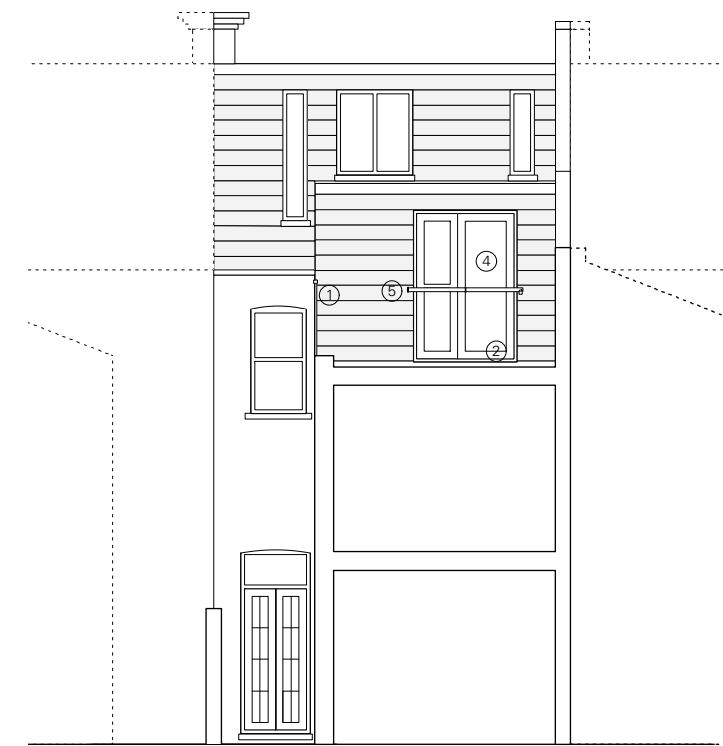

**revisions**

Rev. A - Notes added	27.03.14
Rev. B - Section BB Added / notes amended	19.09.14
Rev. C - Gable wall amended	01.10.14

**notes**

all information contained in this drawing is sole copyright of hugh strange architects

**project** 71 Sumatra Road

**drawing** Proposed Section AA/BB

**job. no.** 20    **dwg. no.** 07    **rev.** C    **scale** 1:100@A3    **date** 25.03.14

**issued for** Information