



Do not Scale. Use figured dimensions only.

The base drawing, dimensions & reference grid are produced from an externally sourced survey. All datums & dimensions are to be checked on site before working drawings are completed or construction work begins.

All drawings to be read in conjunction with the Engineers' drawings. Any discrepancies between consultants drawings to be reported to the Architect before any work commences.

Refer to Floor Finish Scope Drawings for FFLs. FFLs are based on the SES survey info received from GFLC.

The Contractor's attention is drawn to the Health & Safety matters identified in the Health & Safety plan as being potentially hazardous. These items should not be considered as a complete and final list. The Work Package Contractor's normal Health and Safety obligations still apply when undertaking constructional operations both on and off site.

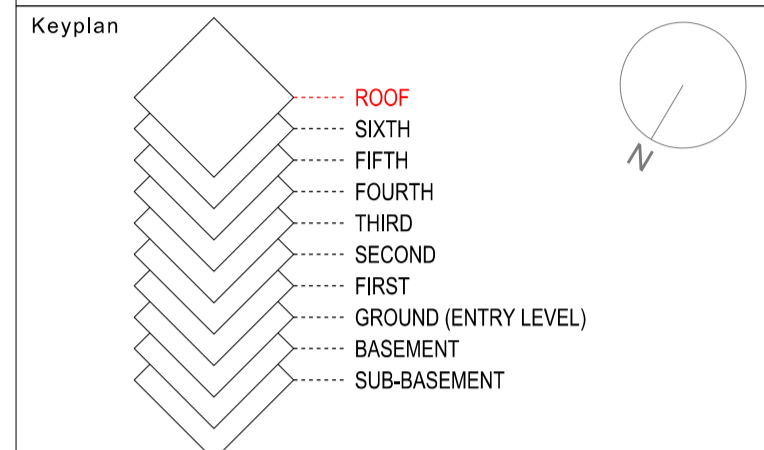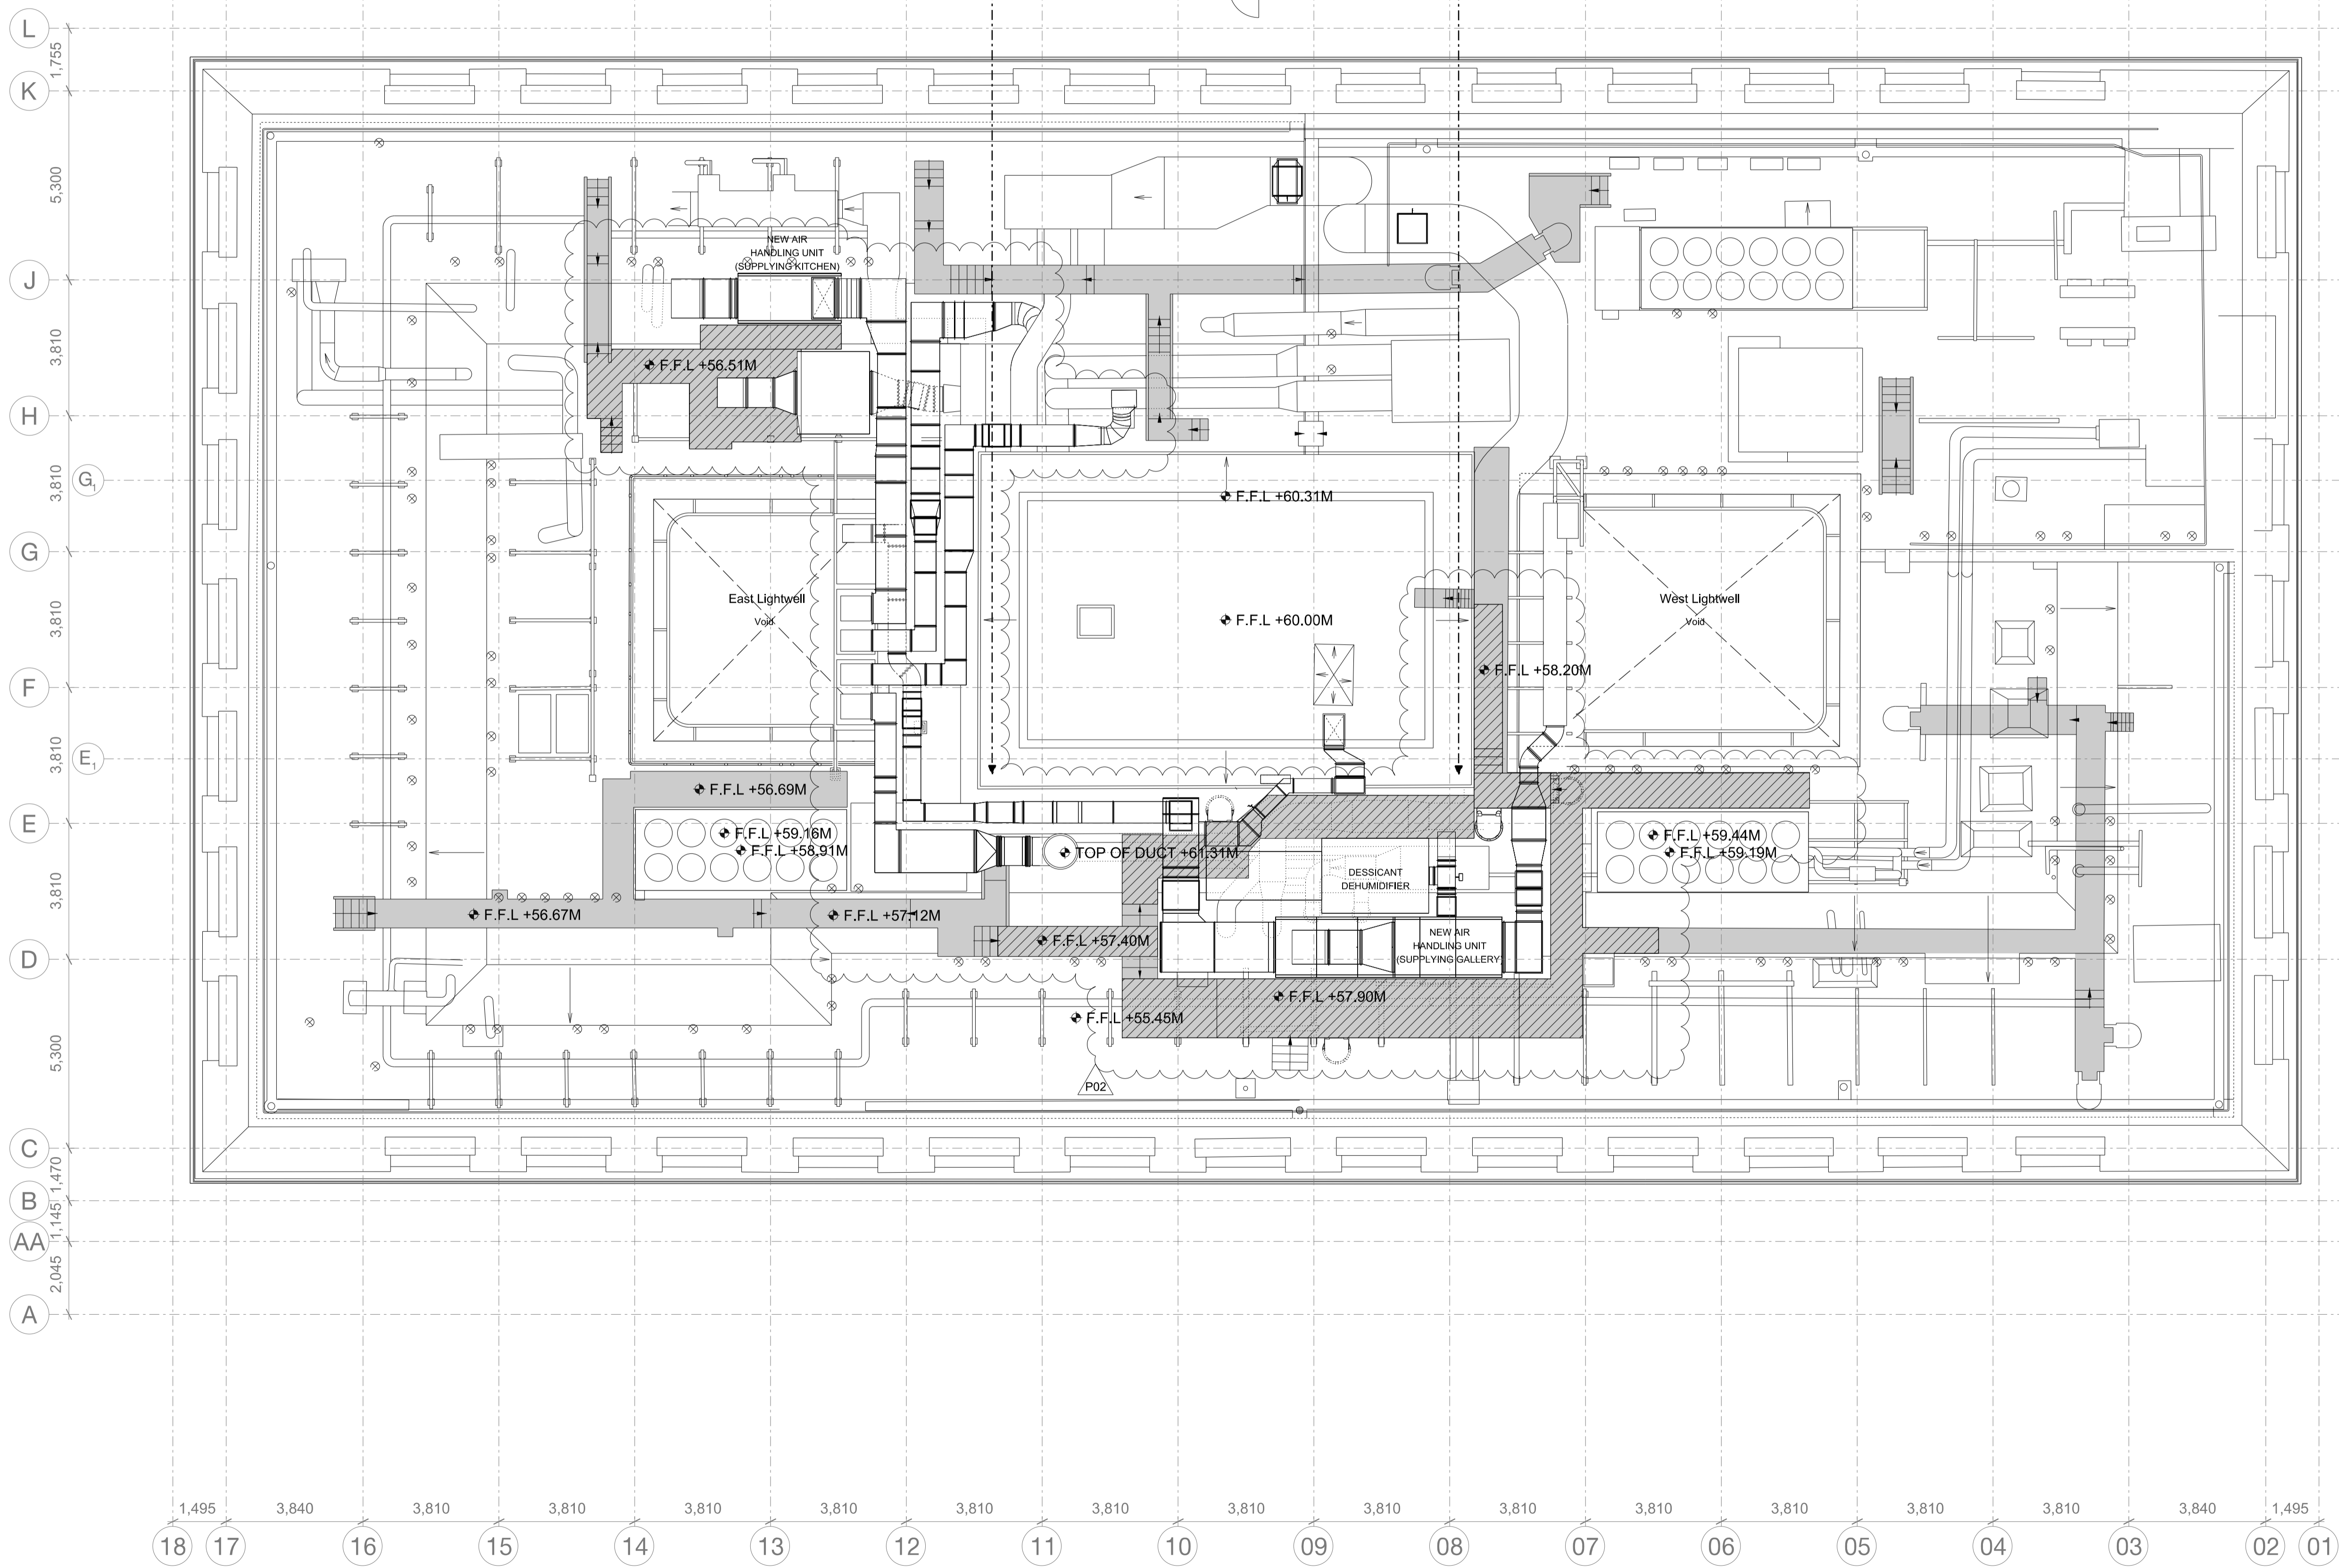

- KEY
- Existing Hook Eyes for Fall Arrest System
 - Extent of Gantries
 - New Gantries to Match Existing
 - New Handrail
 - Existing Handrail - Relocated

READ IN CONJUNCTION WITH M&E CONSULTANT INFORMATION

Advance Works Package boundary line (indicative to C/L of wall); all works within boundary line by Advance Works contractor unless otherwise stated

Issue	Date	Description	By	Chkd
P00	13/02/2013	PLANNING	CD	GC
P01	03/07/2014	"AS BUILT" CONDITION	MD	GC
P02	24/09/2014	PLANNING AMENDMENT	ARM	GC

33 Bowling Green Lane
London
EC1R 0BJ

+44 (0) 20 7608 7900 T
+44 (0) 20 7608 7901 F
www.wilkinsonseyre.com

WilkinsonEyre.Architects

Client
WELLCOME TRUST

Logo

welcometrust

Project
WELLCOME COLLECTION DEVELOPMENT PROJECT

Drawing Title
ROOF PLAN - PROPOSED

Scale at A1
1:100

Issue Status
PLANNING

Drawing and CAD File Number
00820-10-P-1210

Issue
P02