


GENERAL NOTES:
 DO NOT SCALE FROM THIS DRAWING
 ALL DIMENSIONS TO BE CHECKED ON SITE
 ANY OMISSIONS OR DISCREPANCIES TO BE
 REPORTED TO THE ARCHITECT IMMEDIATELY
 IF IN DOUBT ASK

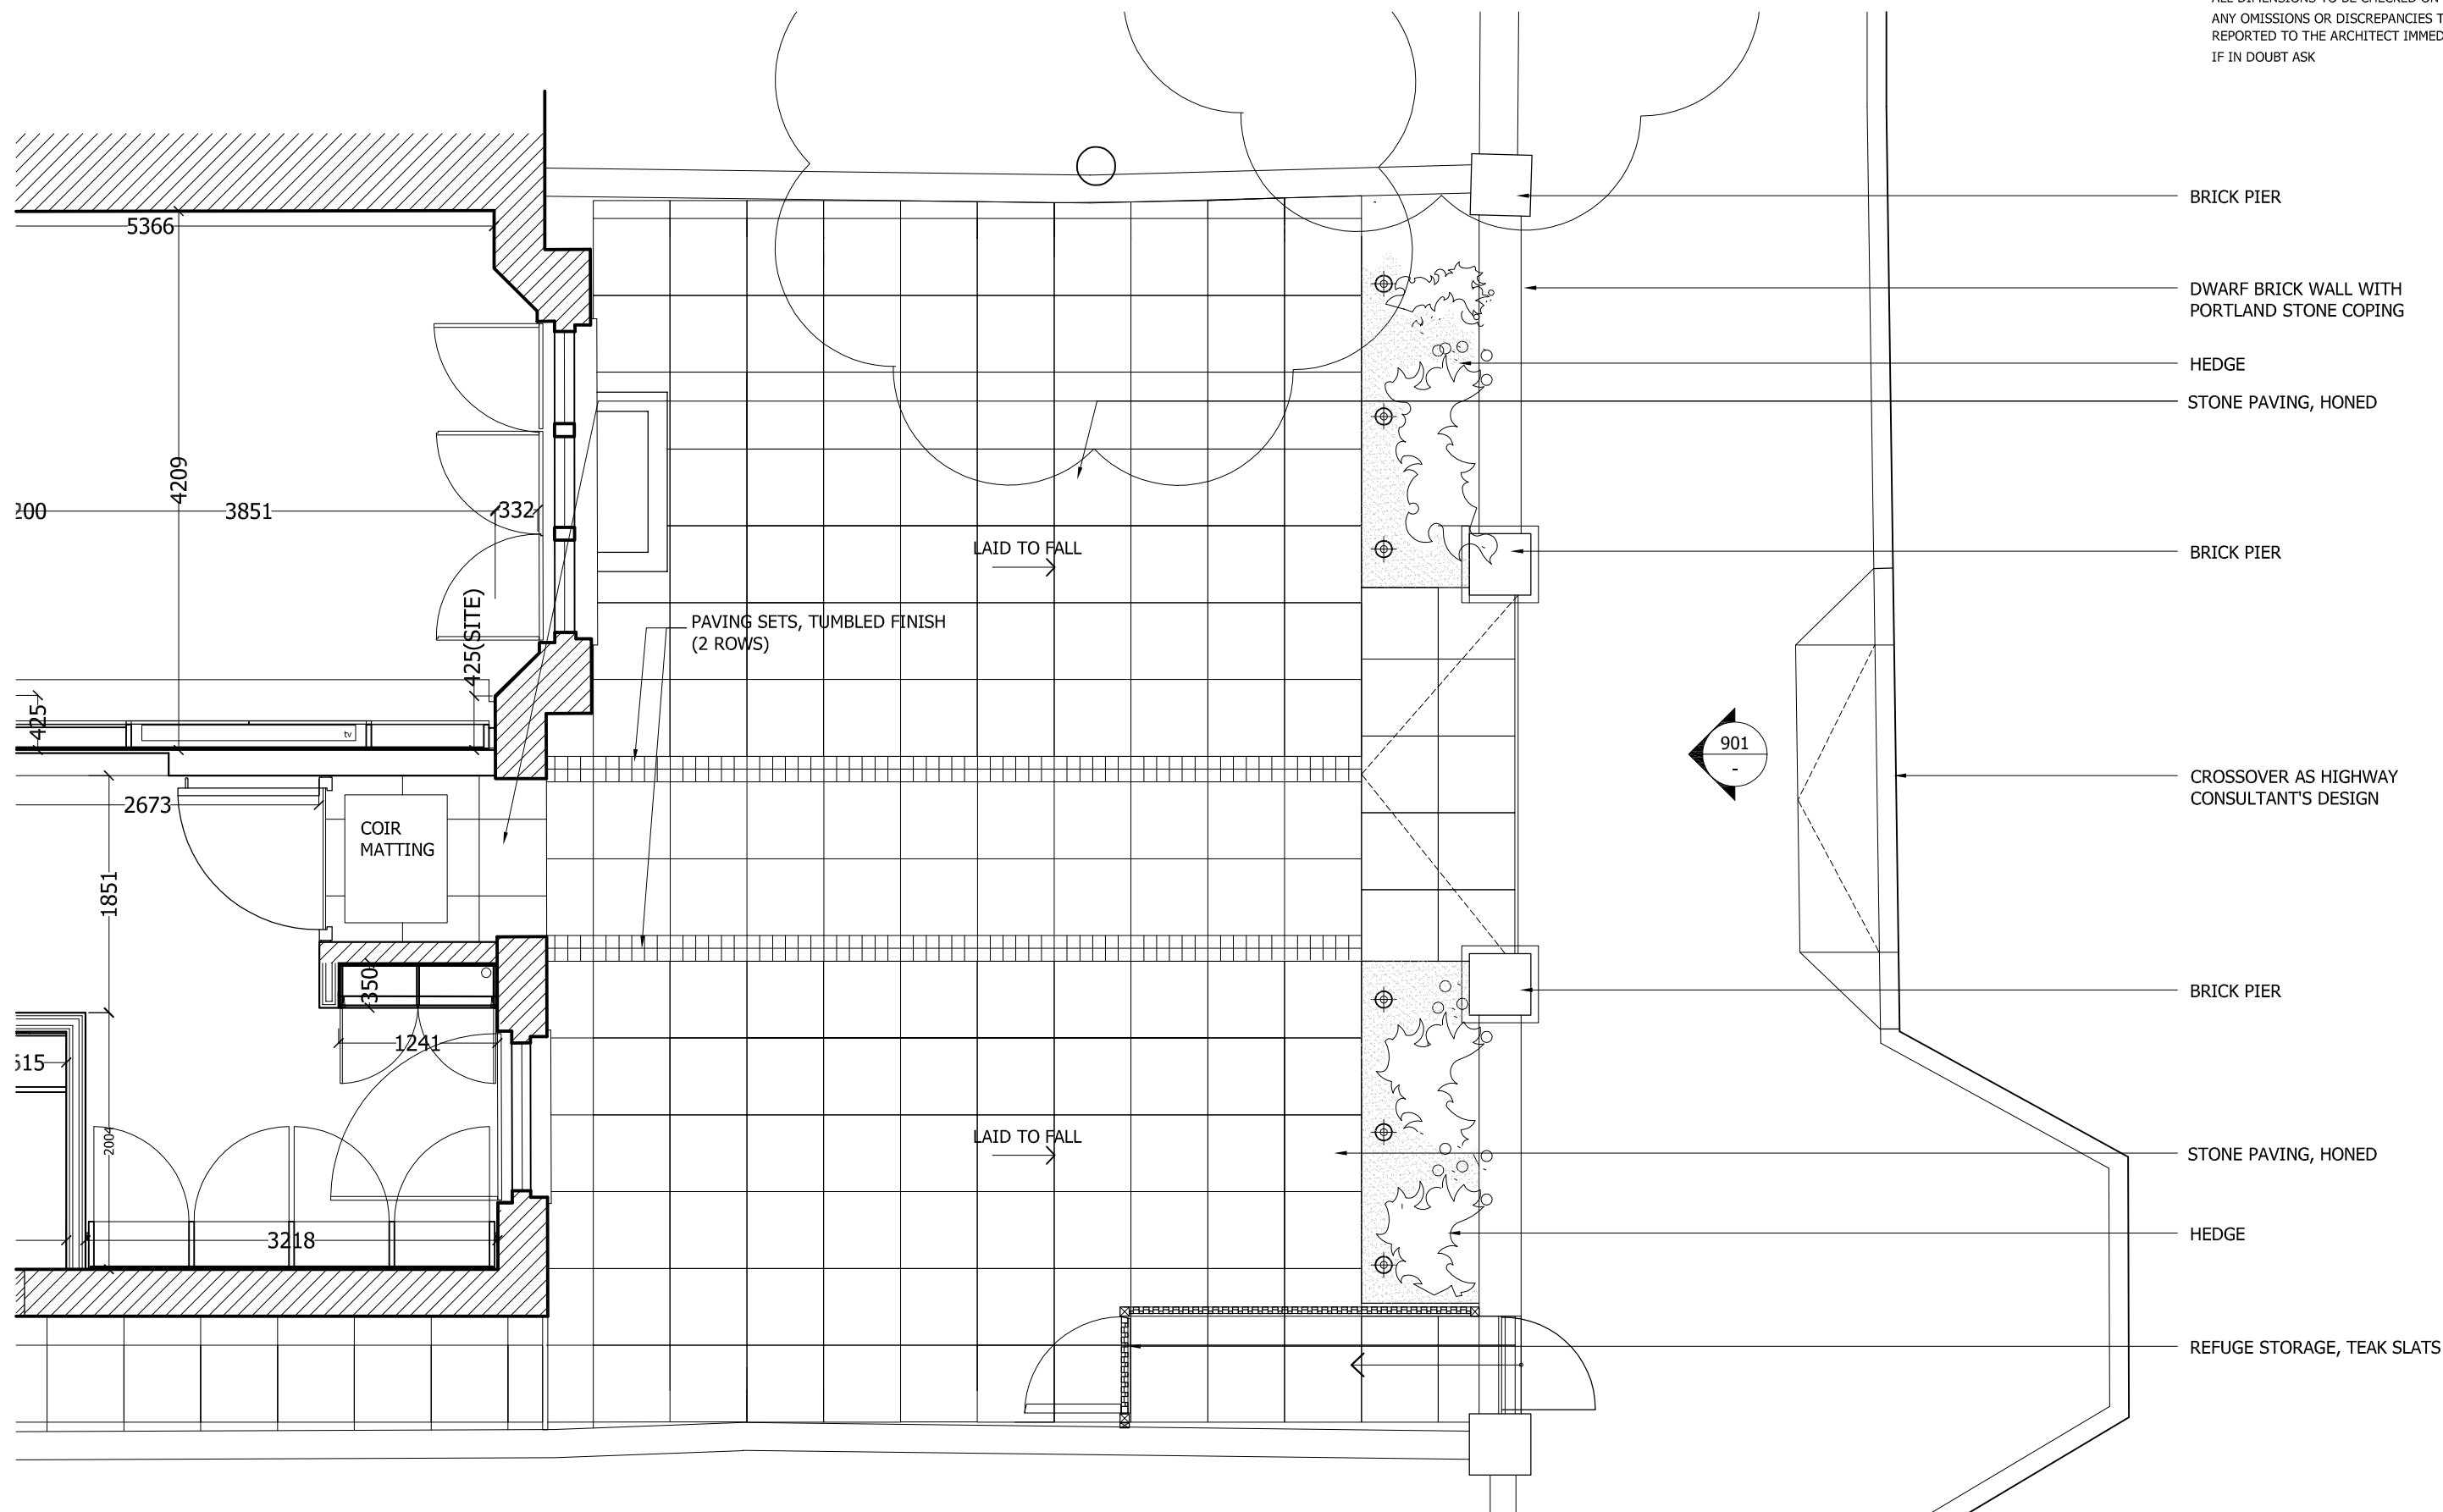

Finkernagel Ross Architects

Third Floor, Unicorn House
 221-222 Shoreditch High Street
 London E1 6PJ

Tel: 020 7377 5114
 info@finkernagelross.com
 www.finkernagelross.com

CLIENT			DRAWING STATUS		PROJECT		DRAWING NO		REVISION	
Private			PLANNING		16 ELSWORTHY ROAD LONDON, NW3		16ELS-900		P1	
DRAWN	DR. DATE	CHECKED	SCALE		SHEET SIZE	DRAWING TITLE				
PS	29.09.14	FF	1:50		A3	AS BUILT PLAN				
REV	DATE	NOTES	DR							