




PROPOSED LOWER GROUND FLOOR
AS BUILT MAY 2014

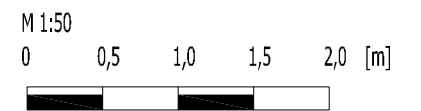


INDIGO DESIGN ASSOCIATES LIMITED			
7A FILMER MEWS, 75 FILMER ROAD LONDON, SW6 7JF			
TEL: 020 7610 6122		FAX: 020 7610 6941	
www.indigo.gb.net		mail@indigo.gb.net	
PROJECT	SCALE	DATE	DWG NO
2 CHALCOT SQUARE LONDON NW1	1:50 @ A3	SEP 2014	AB 01
REVISION			

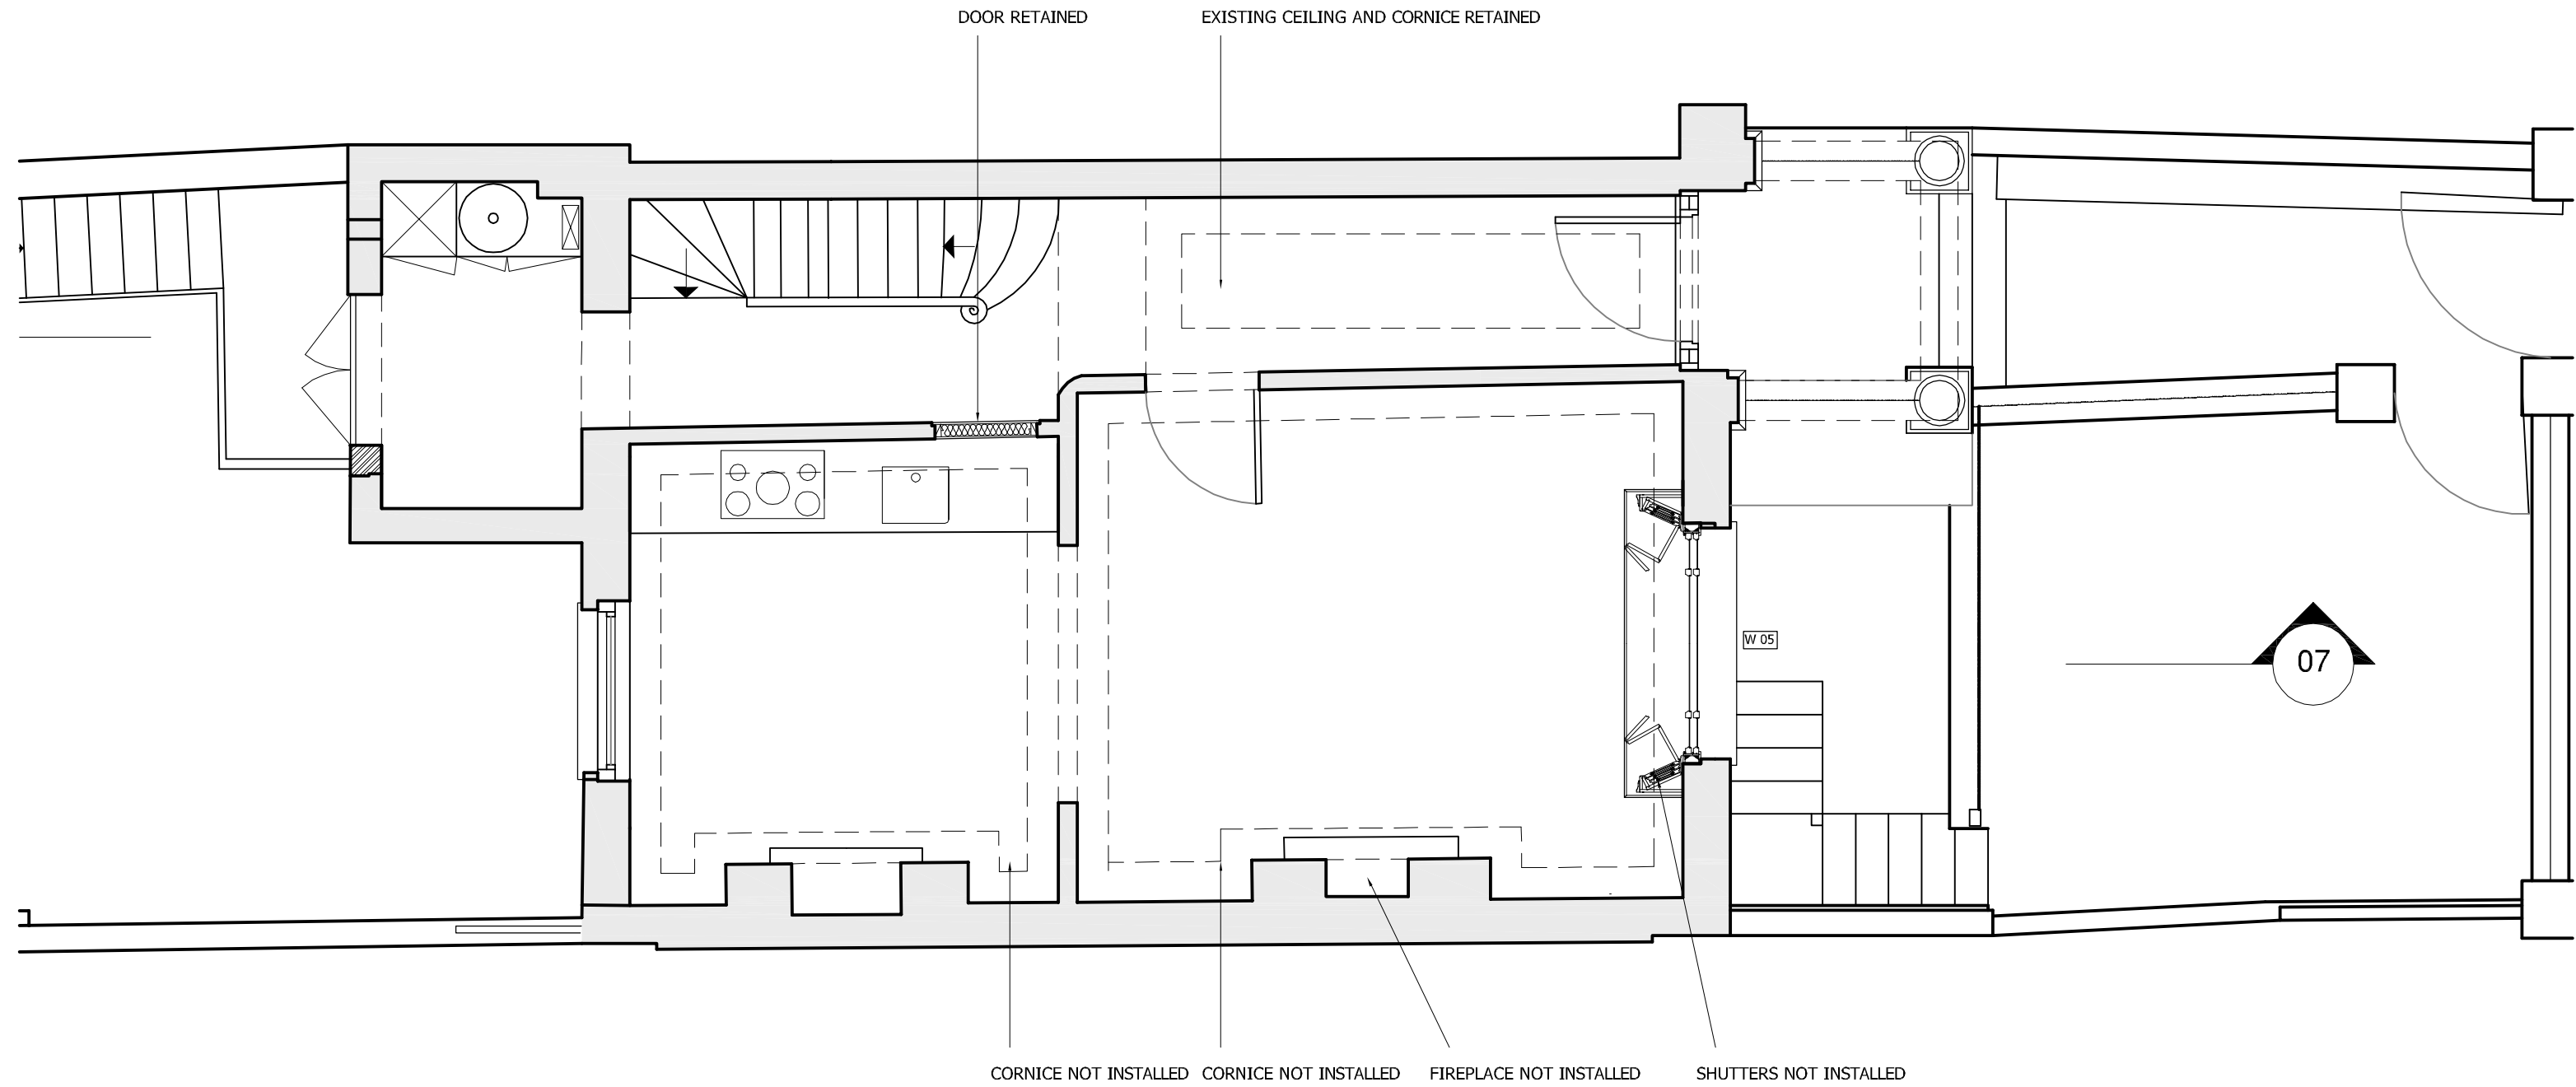


PROPOSED GROUND FLOOR PLAN
AS BUILT MAY 2014

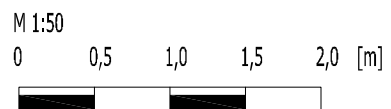


INDIGO DESIGN ASSOCIATES LIMITED			
7A FILMER MEWS, 75 FILMER ROAD LONDON, SW6 7JF			
TEL: 020 7610 6122		FAX: 020 7610 6941	
www.indigo.gb.net		mail@indigo.gb.net	
PROJECT	SCALE	DATE	DWG NO
2 CHALCOT SQUARE LONDON NW1	1:50 @ A3	SEP 2014	AB 02
PROPOSED UPPER GROUND FLOOR		REVISION	

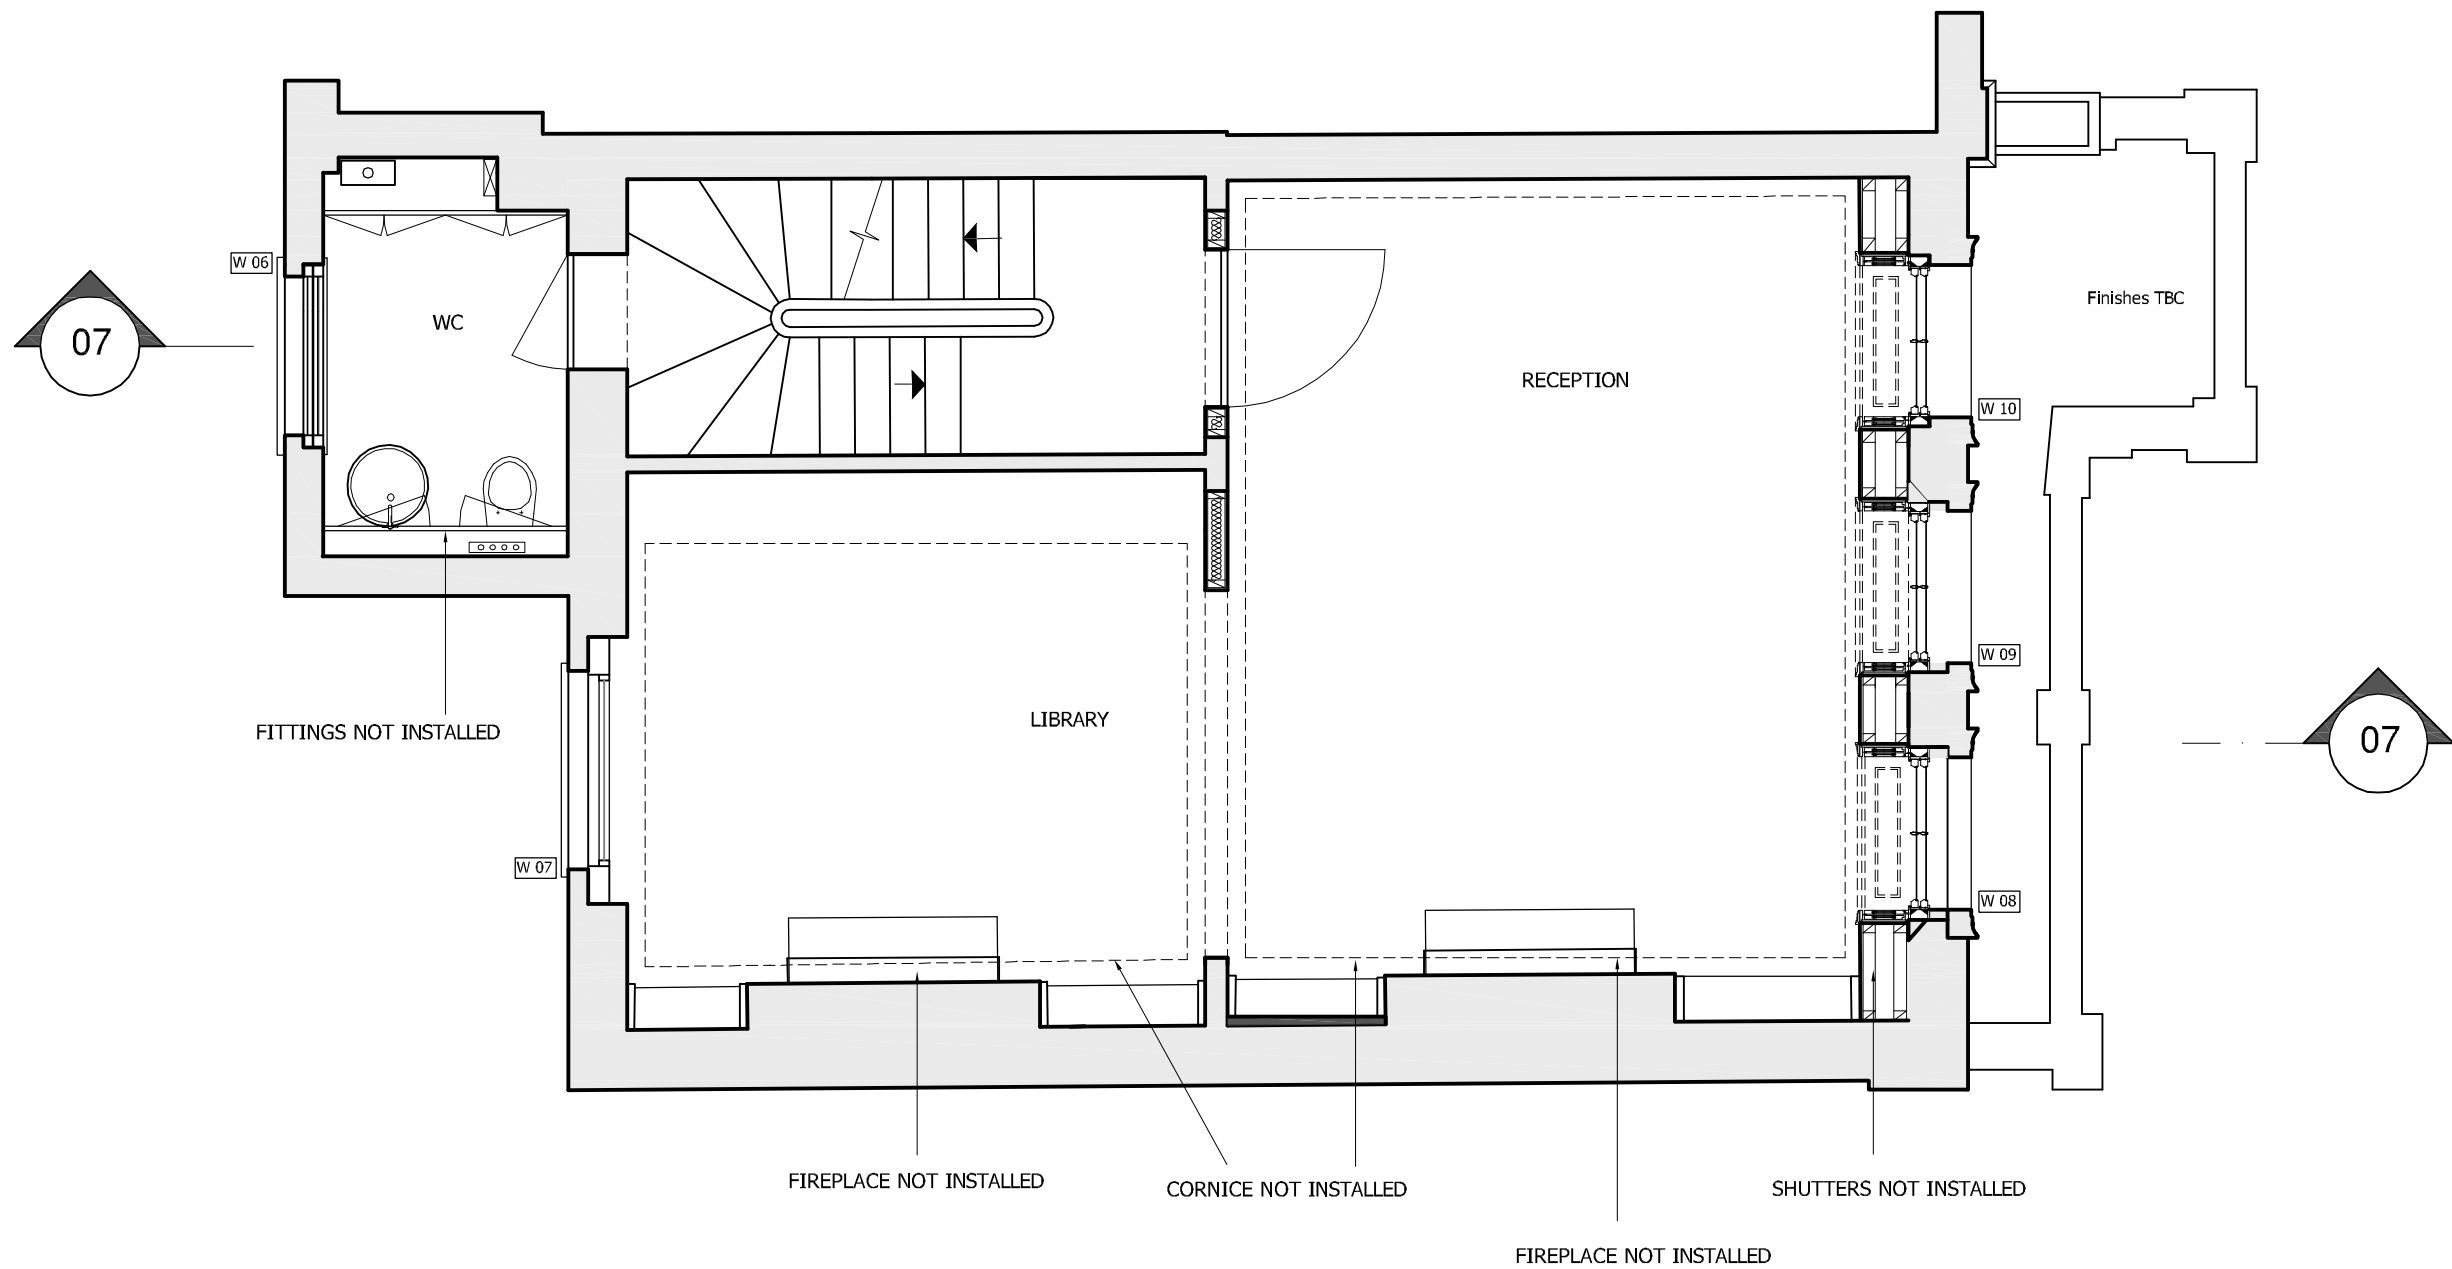


PROPOSED FIRST FLOOR PLAN
AS BUILT MAY 2014

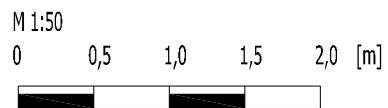


INDIGO DESIGN ASSOCIATES LIMITED			
7A FILMER MEWS, 75 FILMER ROAD LONDON, SW6 7JF			
TEL: 020 7610 6122		FAX: 020 7610 6941	
www.indigo.gb.net		mail@indigo.gb.net	
PROJECT	SCALE	DATE	DWG NO
2 CHALCOT SQUARE LONDON NW1	1:50 @ A3	SEP 2014	AB 03
PROPOSED FIRST FLOOR		REVISION	

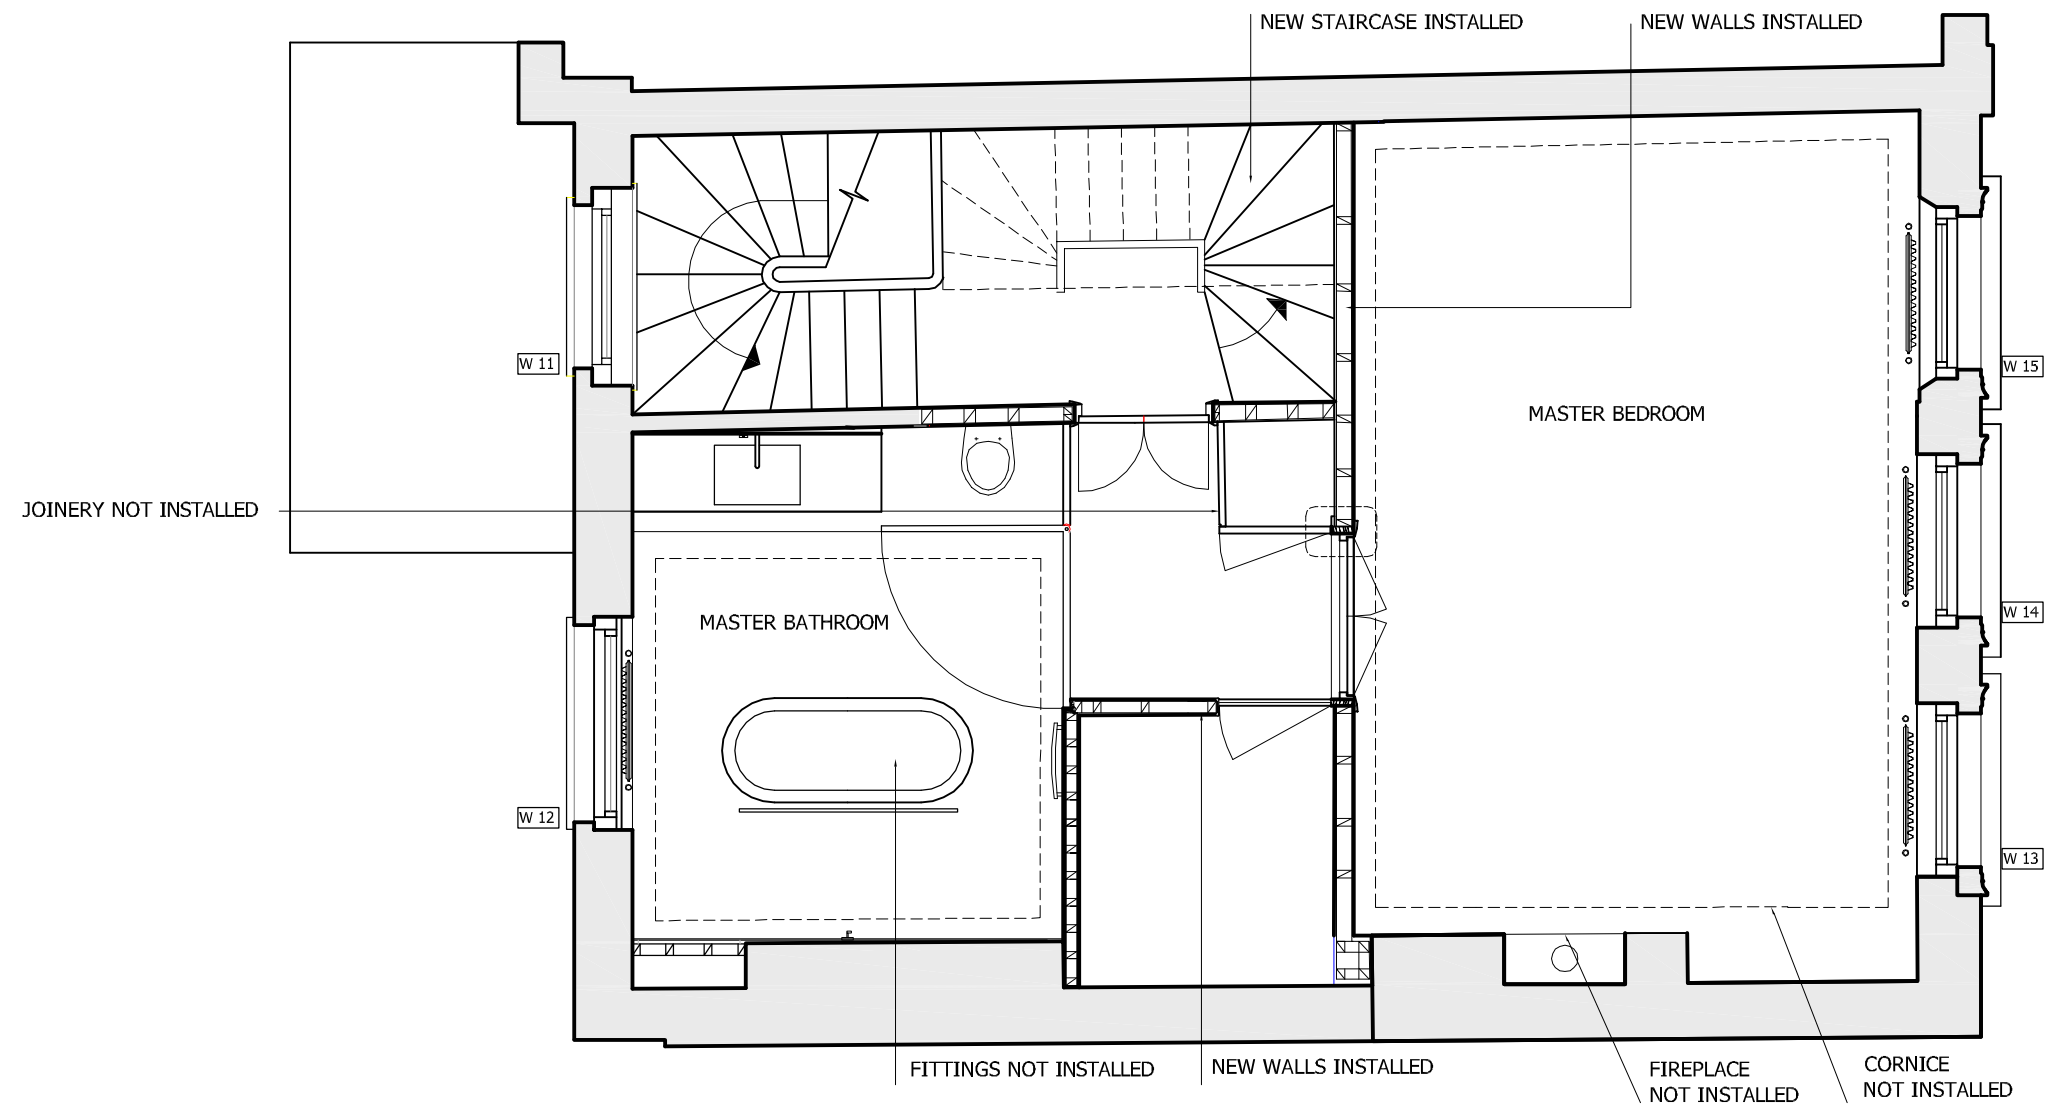



PROPOSED SECOND FLOOR PLAN
AS BUILT MAY 2014

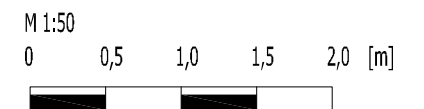

INDIGO DESIGN ASSOCIATES LIMITED			
7A FILMER MEWS, 75 FILMER ROAD LONDON, SW6 7JF			
TEL: 020 7610 6122 www.indigo.gb.net		FAX: 020 7610 6941 mail@indigo.gb.net	
PROJECT	SCALE	DATE	DWG NO
2 CHALCOT SQUARE LONDON NW1	1:50 @ A3	SEP 2014	AB 04
PROPOSED SECOND FLOOR		REVISION	

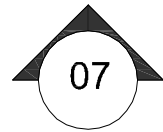

NEW WALL IN OLD LOCATION

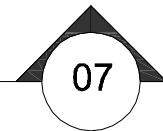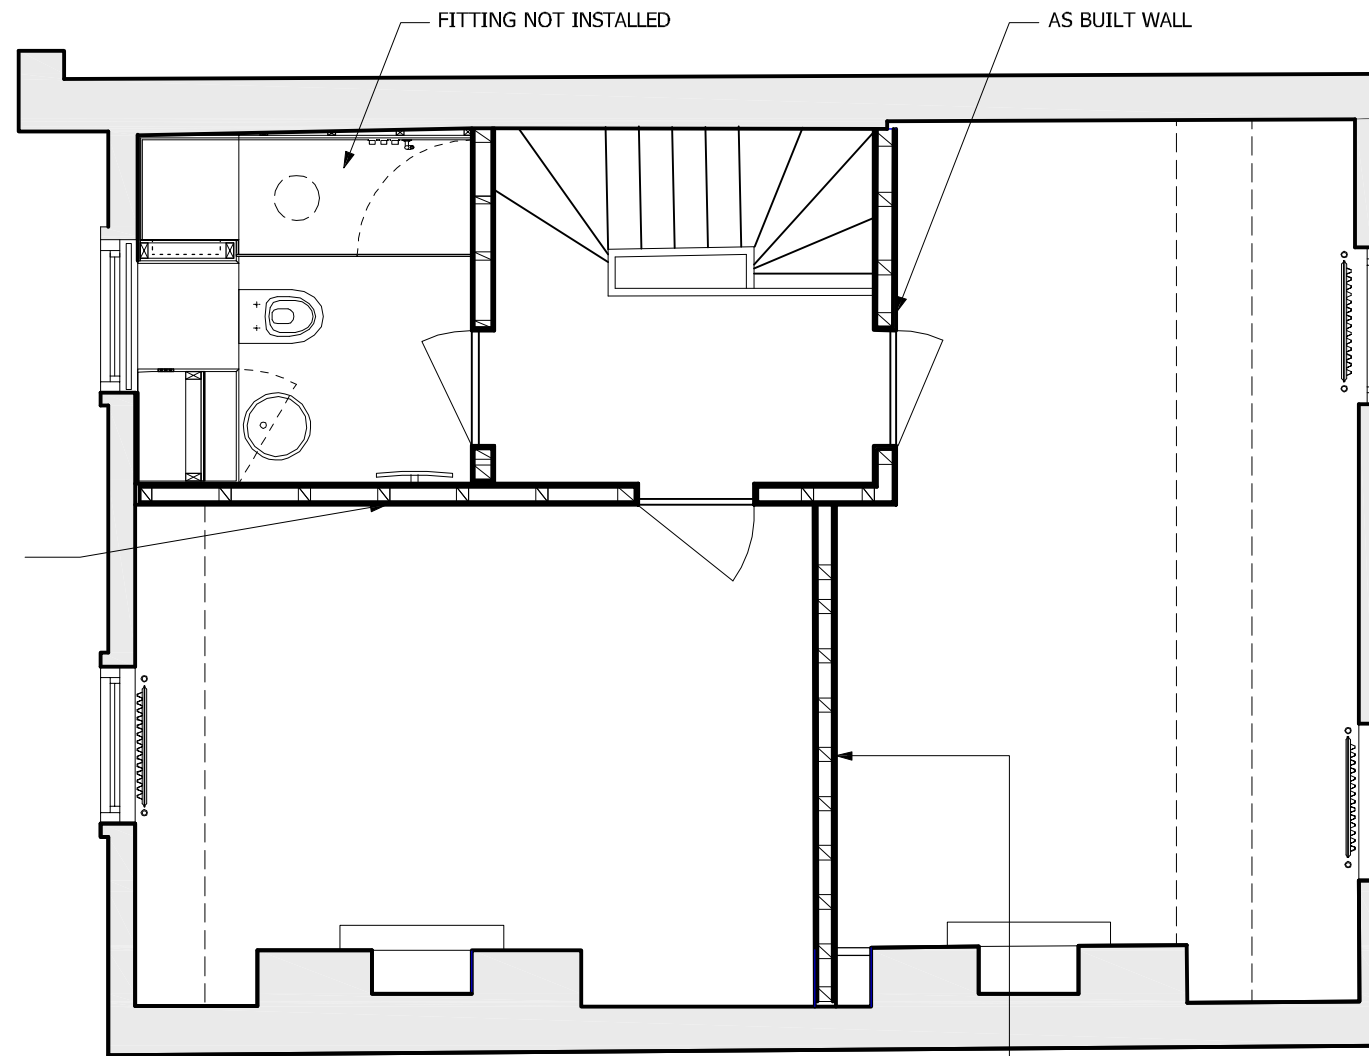

PROPOSED THIRD FLOOR PLAN
AS BUILT MAY 2014

AS BUILT WALL

INDIGO DESIGN ASSOCIATES LIMITED			
7A FILMER MEWS, 75 FILMER ROAD LONDON, SW6 7JF			
TEL: 020 7610 6122		FAX: 020 7610 6941	
www.indigo.gb.net		mail@indigo.gb.net	
PROJECT	SCALE	DATE	DWG NO
2 CHALCOT SQUARE LONDON NW1	1:50 @ AS	SEP 2014	AS 05
PROPOSED THIRD FLOOR		REVISION	