



* Air conditioning wall mounted unit contained within timber housing decorated to match existing timber cladding, openings created for fan and air circulation

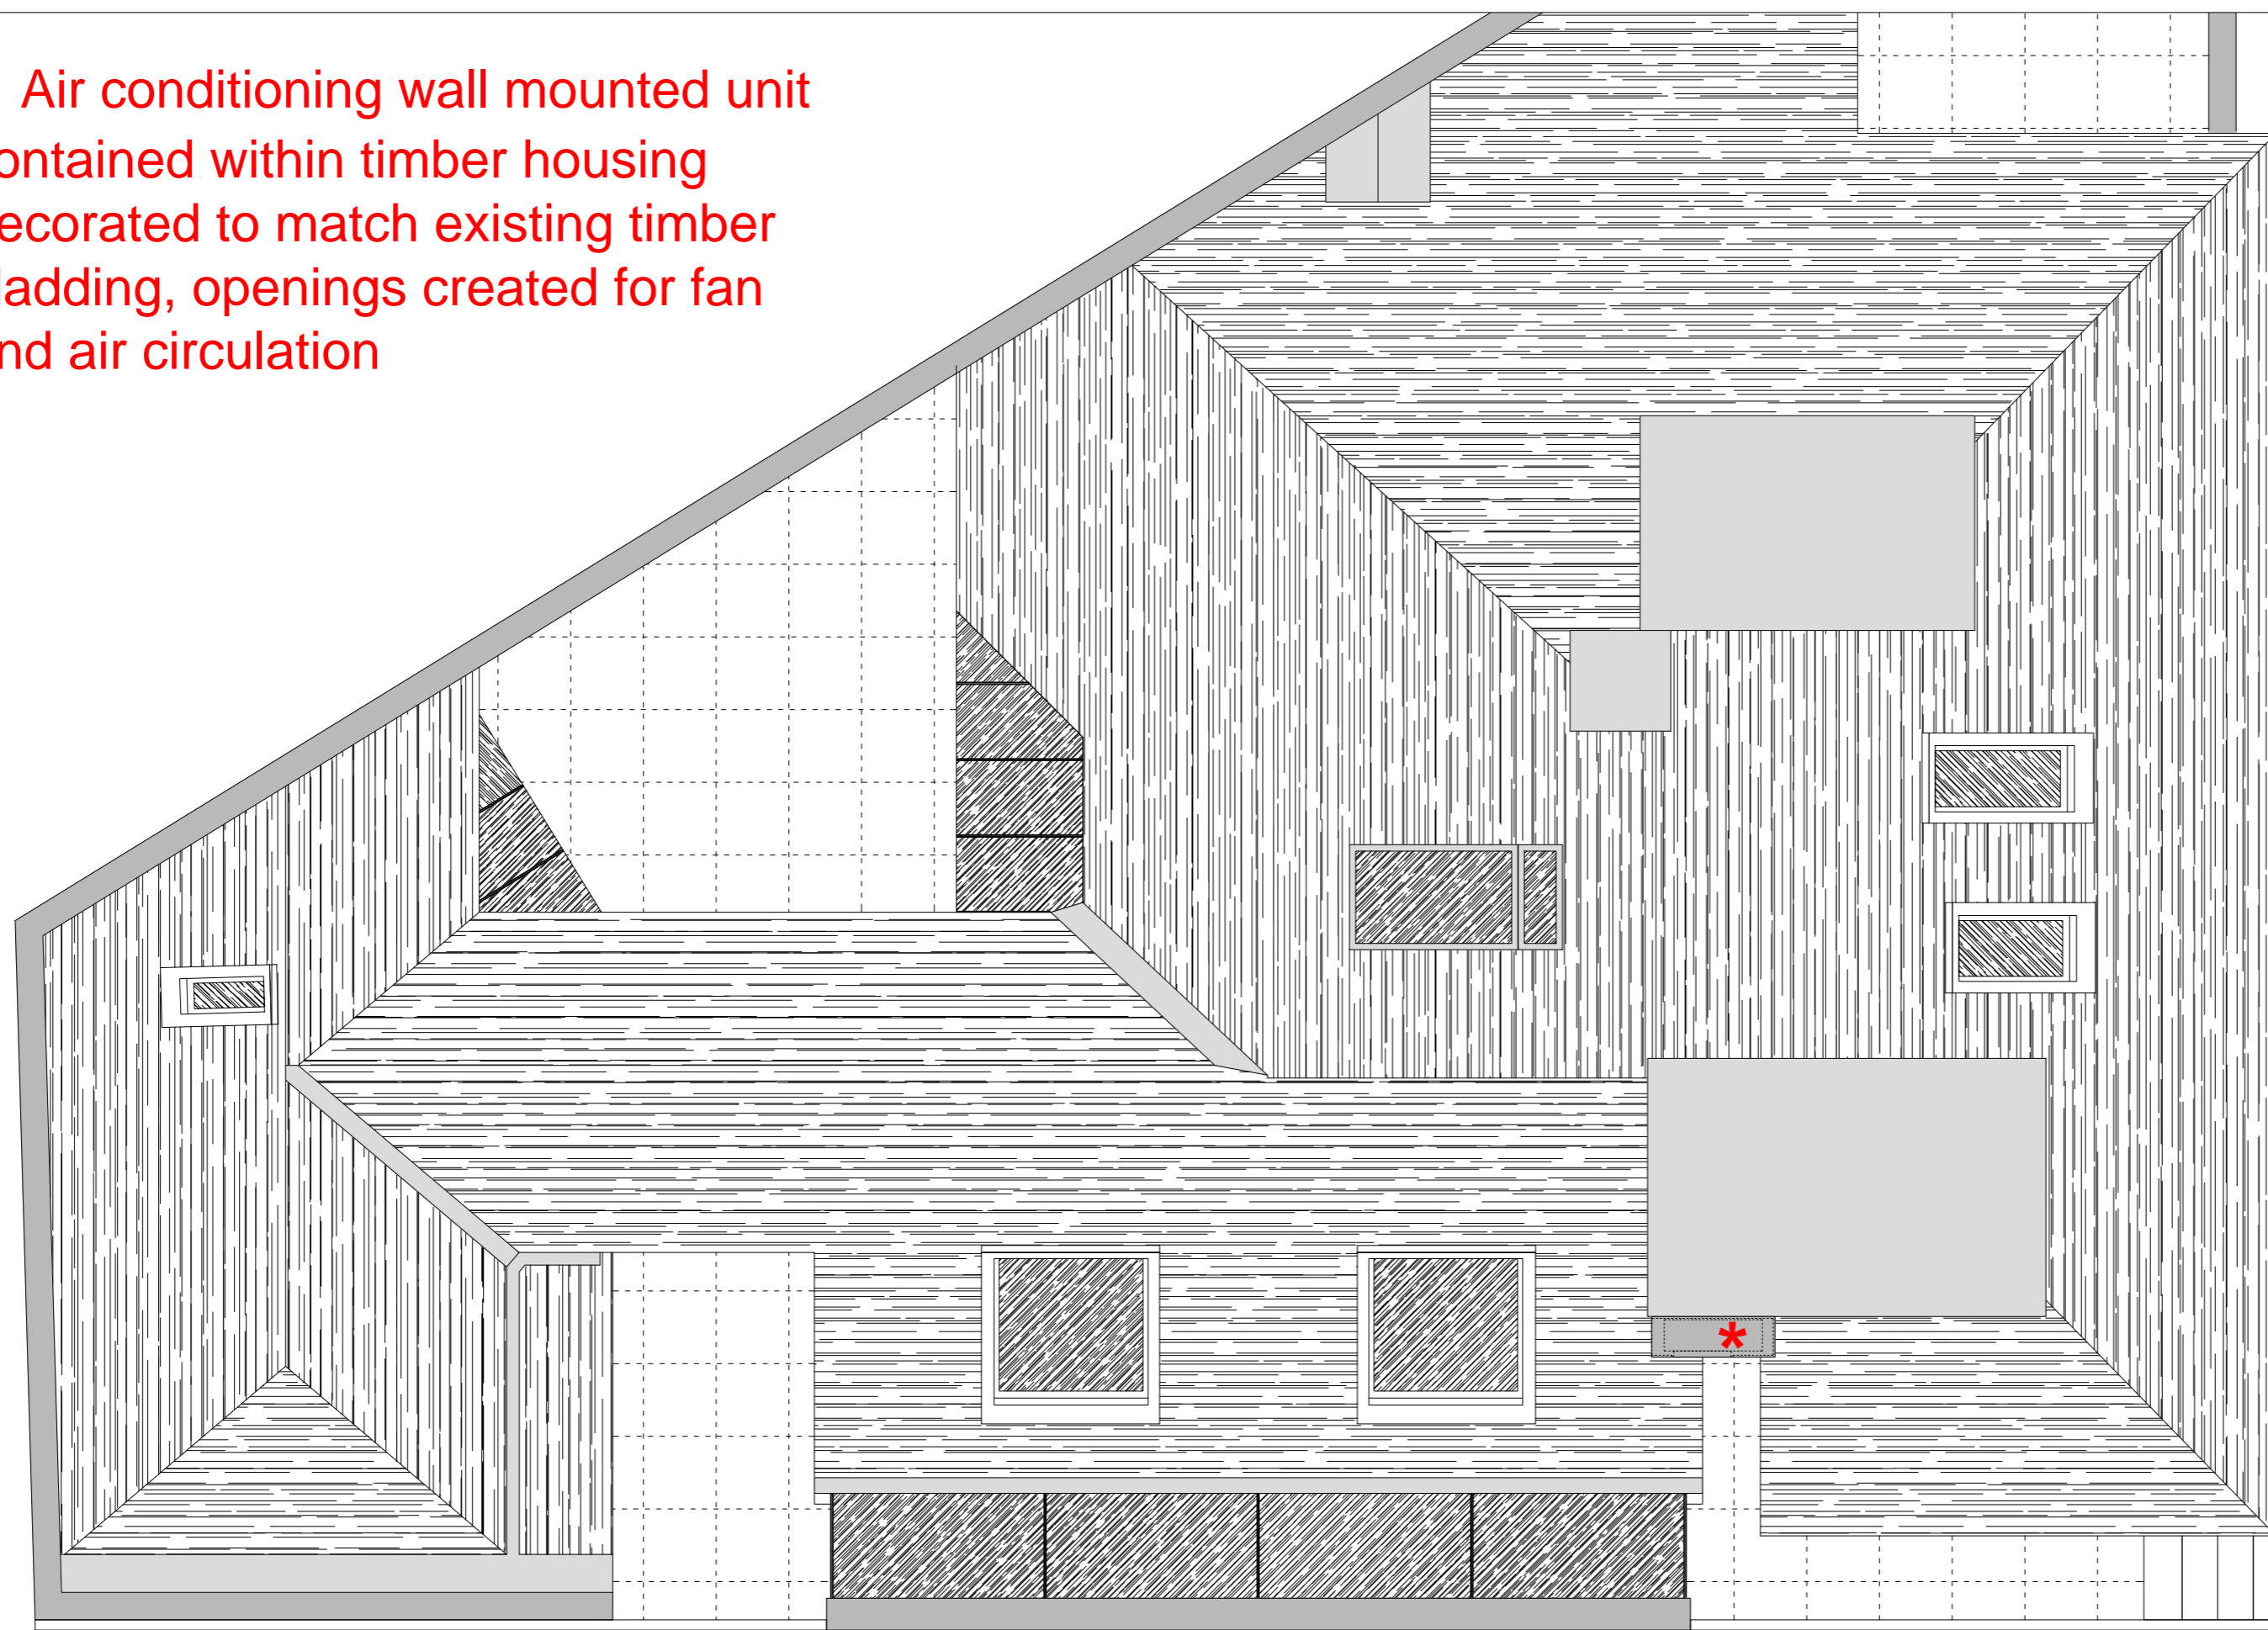

Roof Plan

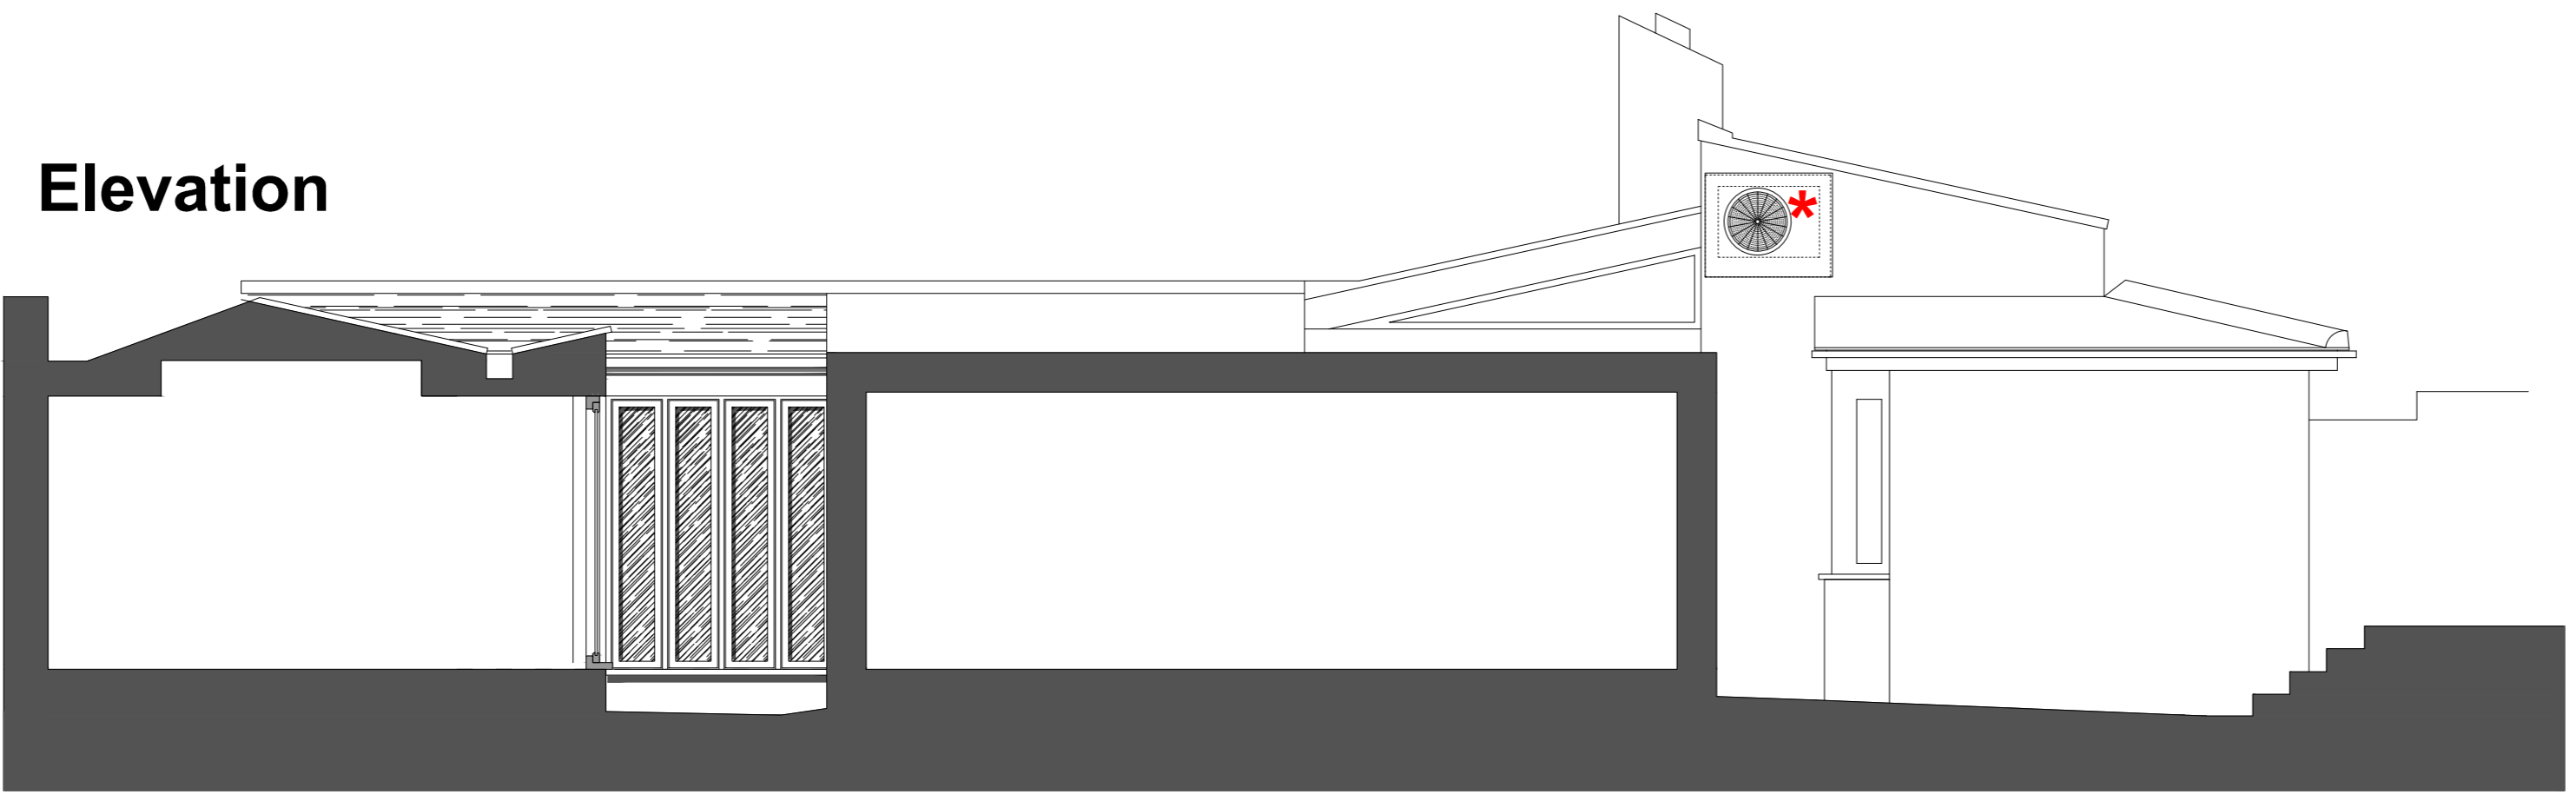

Elevation

STRUCTURE SHOULD BE BUILT TO DIMENSIONS UNLESS OTHERWISE SPECIFIED. ALL DIMENSIONS TO BE CHECKED ON SITE.

revision	changes	date
A	Additional detail added to reflect as installed arrangement	24.11.14
date of issue	scale	paper size
December 2013	1:50	A2
7 Akenside Road Air conditioning external unit Plan and elevational position		area
job number	drawing number	revision
172	172 : 18	A

ANDREW TAYLOR ARCHITECTS LTD
www.andrewtaylor.co.uk