

Drawn by	Scale


Notes

This drawing represents a performance gadio upon which the contractor must base his/her working drawings & details include all necessary dimensions to manufacture and install.

Contractor to undertake a full survey of the area to establish all dimensions & ensure accurate set out.

Advise on suitability of all details shown to ensure structural stability and economy of construction.

Refer to digital master artwork in regard to all graphic work shown.

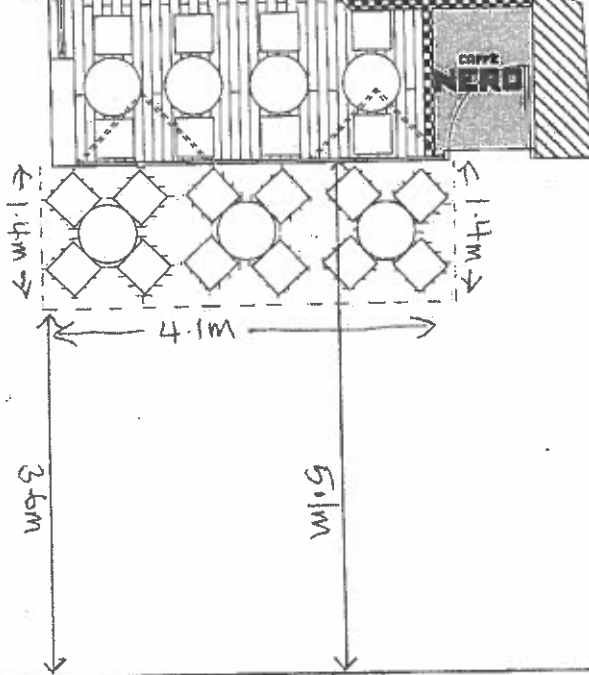

HERB EDGE

AS BUILT

bedrock
 Design & Construction Ltd
 1 Bedrock Way, ECH 8EN
 T: 020 7715 0000
 F: 020 7715 0001
 info@bedrockdesign.co.uk

Client: Caffo Nero

Project: Hampstead - refurb

Description: Merchandise G.A

Scale	Drawn by	Date
1/50	JB	30/10/11
Revision		
CN034/001		

This drawing is the copyright of Bedrock Design & Construction Ltd. This drawing is not to be reproduced, modified or distributed to any unauthorized person without prior permission written from the designer.