



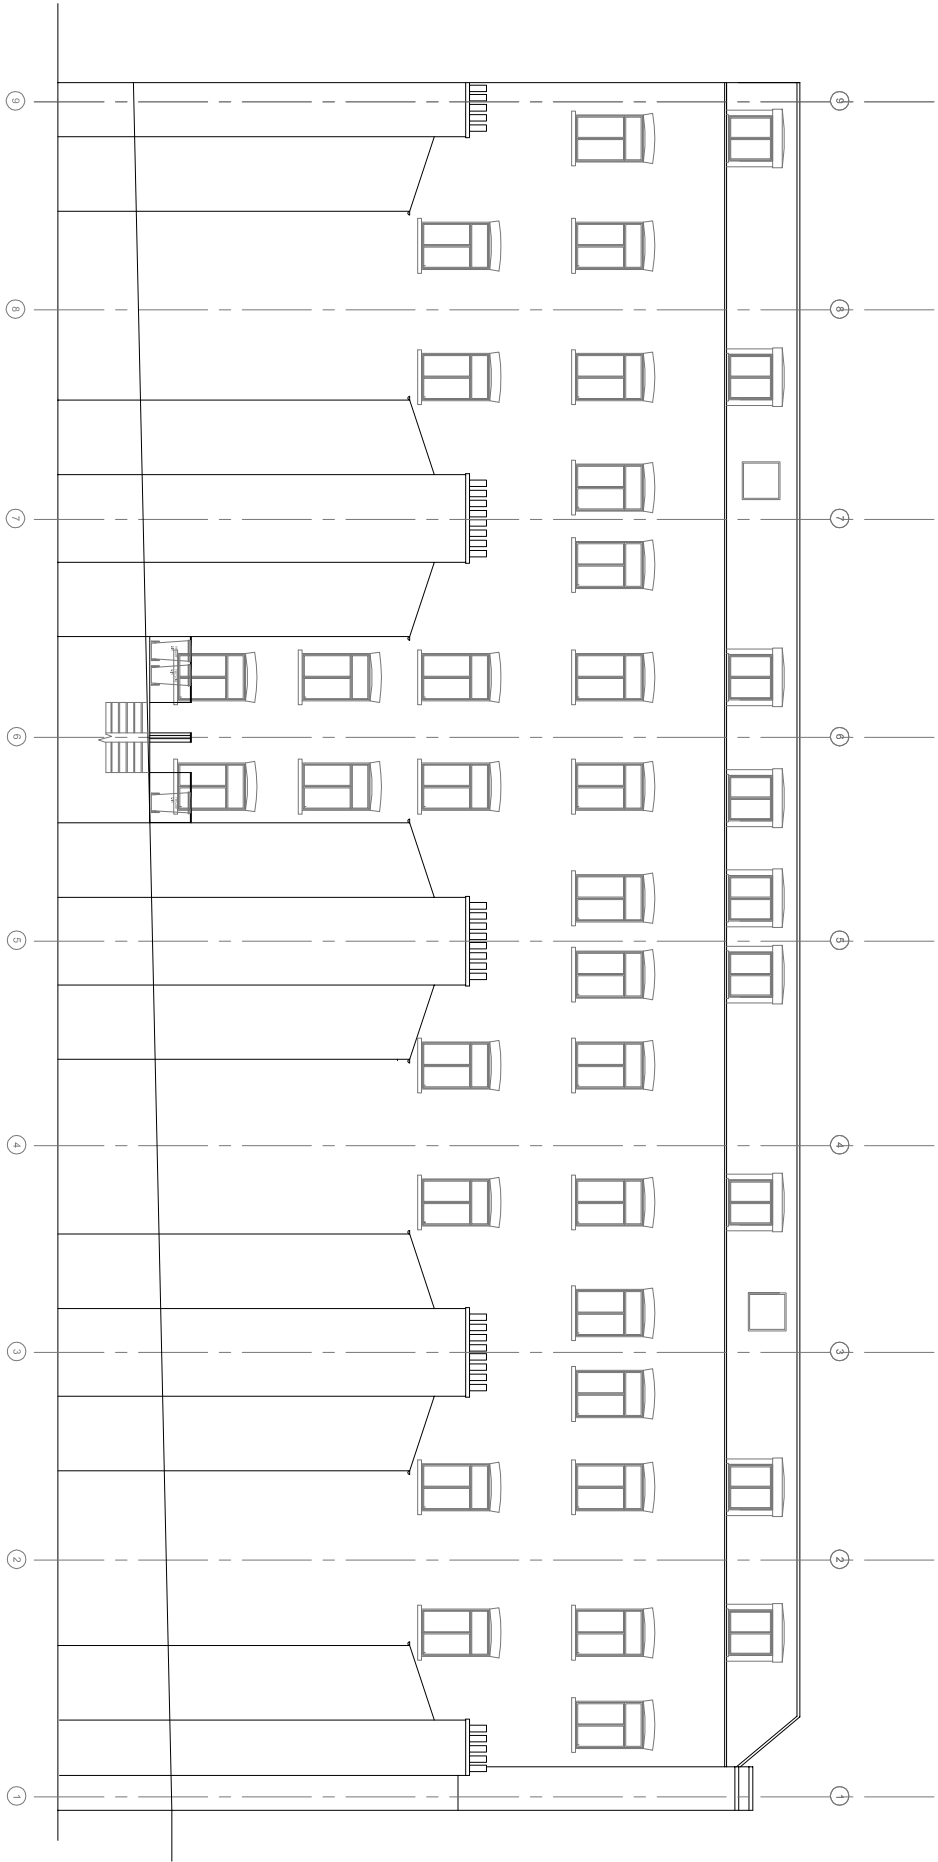

REAR ELEVATION

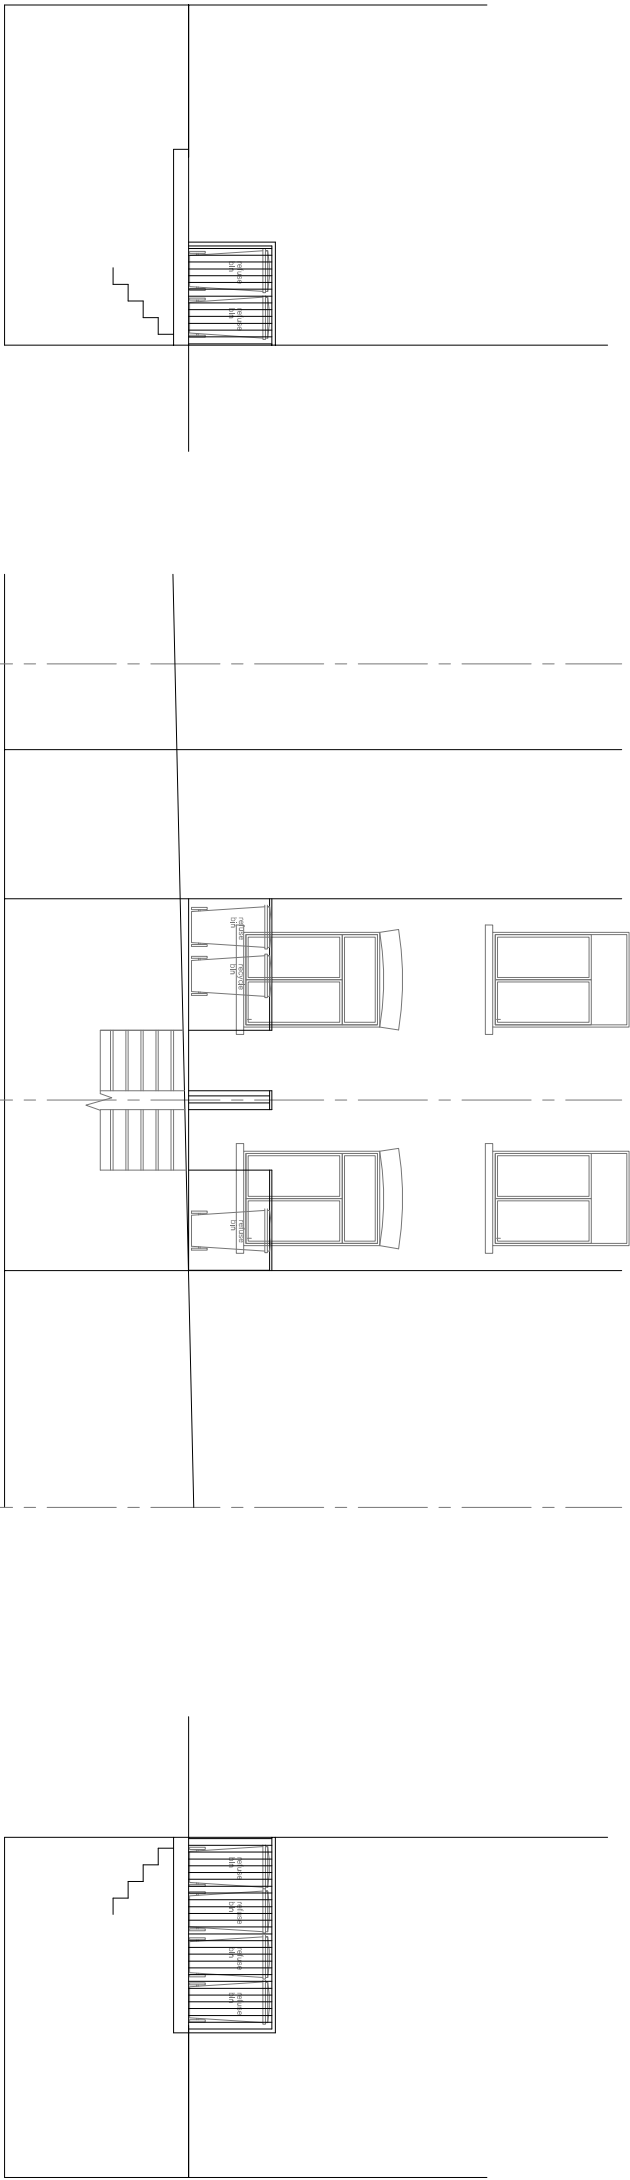

ELEVATION 2

REAR ELEVATION

ELEVATION 1

TITLE		ADDRESS	
ELEVATIONS AS BUILT		LINBURN HOUSE, 340-354 KILBURN HIGH ROAD.	
CLIENT		RAINBOW PROPERTIES LTD.	
SCALE		1:200 & 1:100 @ A3	DATE
DRAWING NO.		condition 2	REV.
			B



URBAN REGEN LONDON Ltd.

Tel: 07970 647 449 Fax: 020 8963 9991 Email: urondon@oql.com