


EAST ELEVATION
AS EXISTING

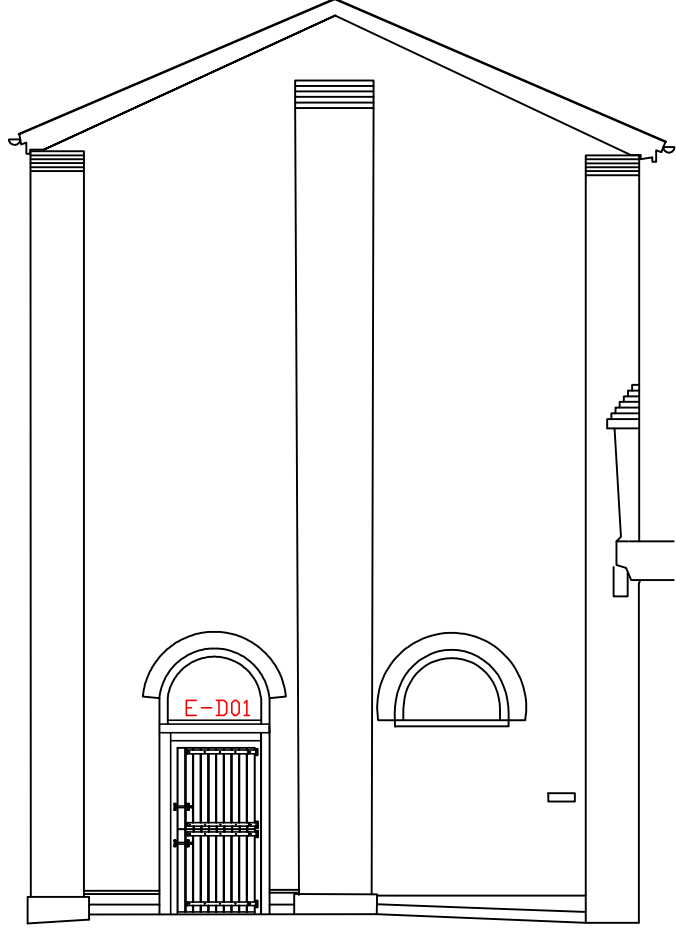


EAST ELEVATION
AS PROPOSED

Provender Stores South and East Elevations as existing and as proposed.

- Red hatching marks the window in need of replacement as part of this application



- Each window has a reference number marked in red

- Area hatched in red on the South Elevation marks the fire damage caused in May 2014

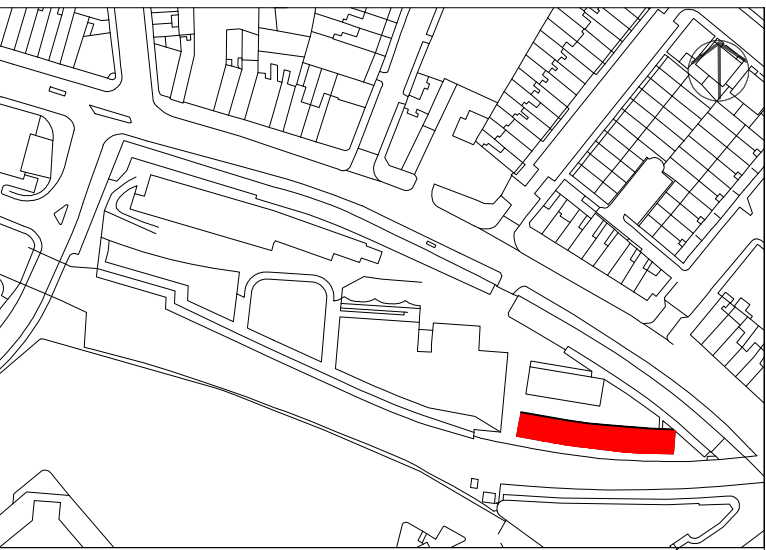


Please note that information used to produce these drawings is based on measured survey supplied by others; Heritage Architecture can not be held responsible for any inaccuracies that may exist. Please do not scale drawings. All dimensions should be verified on site.

S-W01

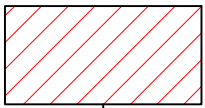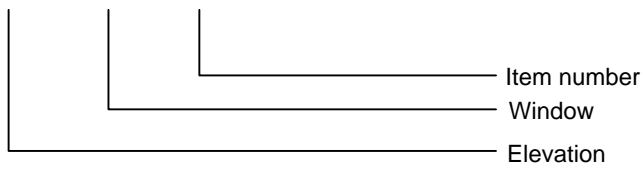

Area of fire damage from
May 2014

South Elevation as Existing
(Hatched area denotes fire damage)

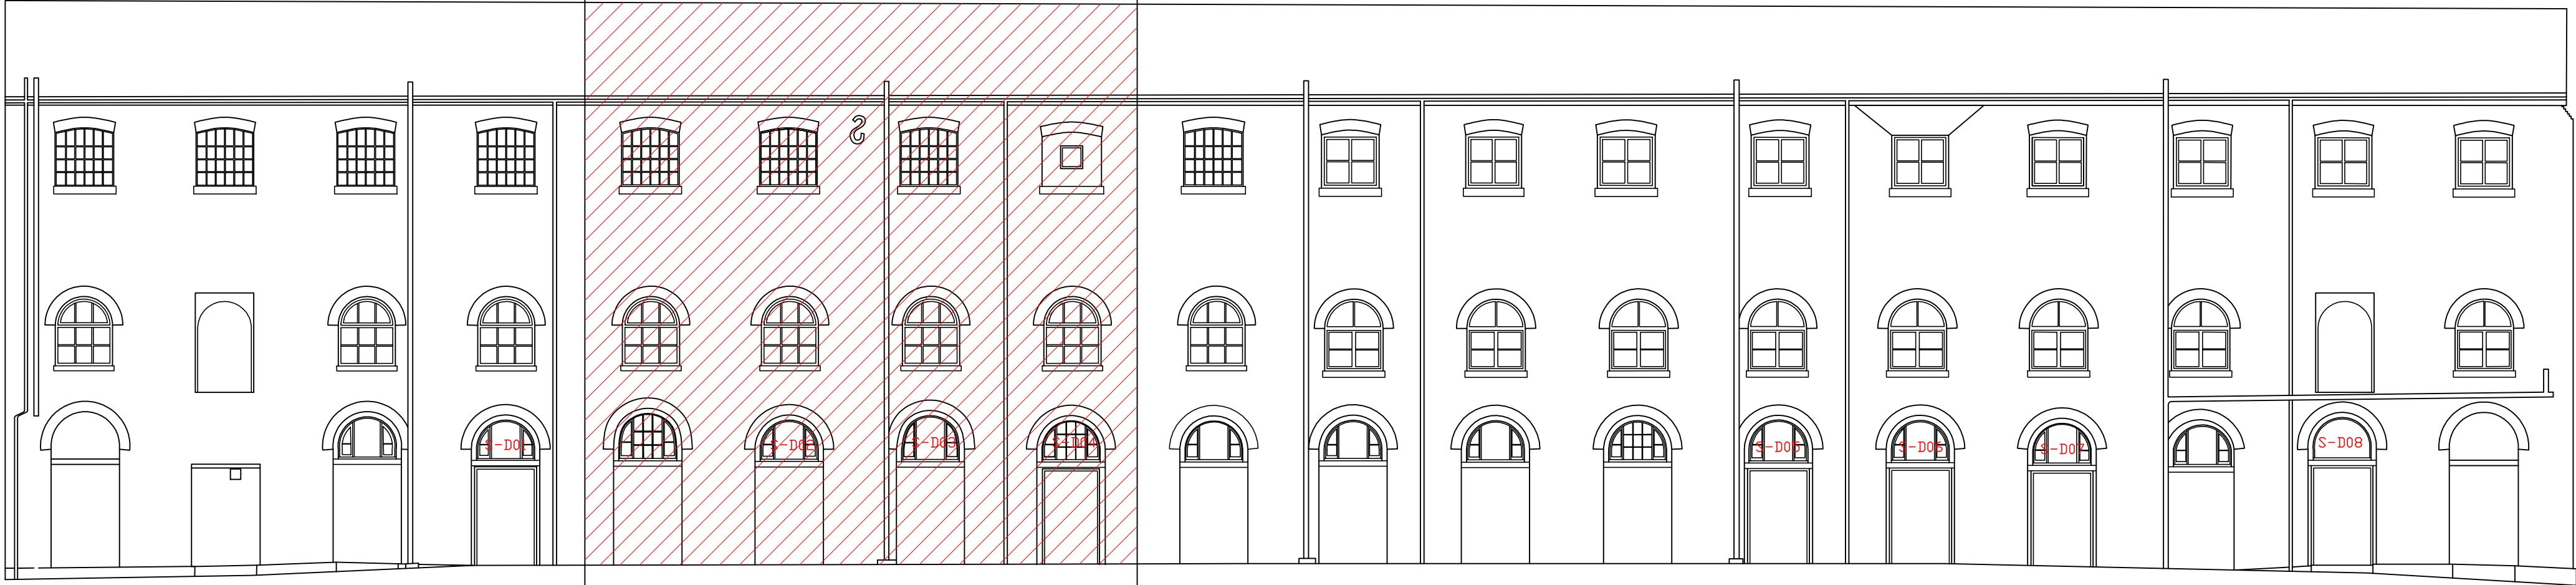

South Elevation as Proposed
(Hatched area denotes fire damage)



Camden Stables Market
London
NW1
United Kingdom

STANLEY SIDINGS

Camden Stable Market
Provender Stores

Drawing Title

PROVENDER STORES
SOUTH & EAST ELEVATION DOORS
AS EXISTING AND AS PROPOSED

To fit A1

Drawing Status
Listed Building Consent

December 2014
Drawing No
B-SE&EE-Ref



STEPHEN LEVRANT HERITAGE ARCHITECTURE
62 British Grove, London, W4 2NL
E-mail: info@heritageemail.co.uk