


NOTES

- "As built" drawings are based on:
(a) CAD files by KYSON, supplied by the client;
(b) Images of the existing / 'as built'.

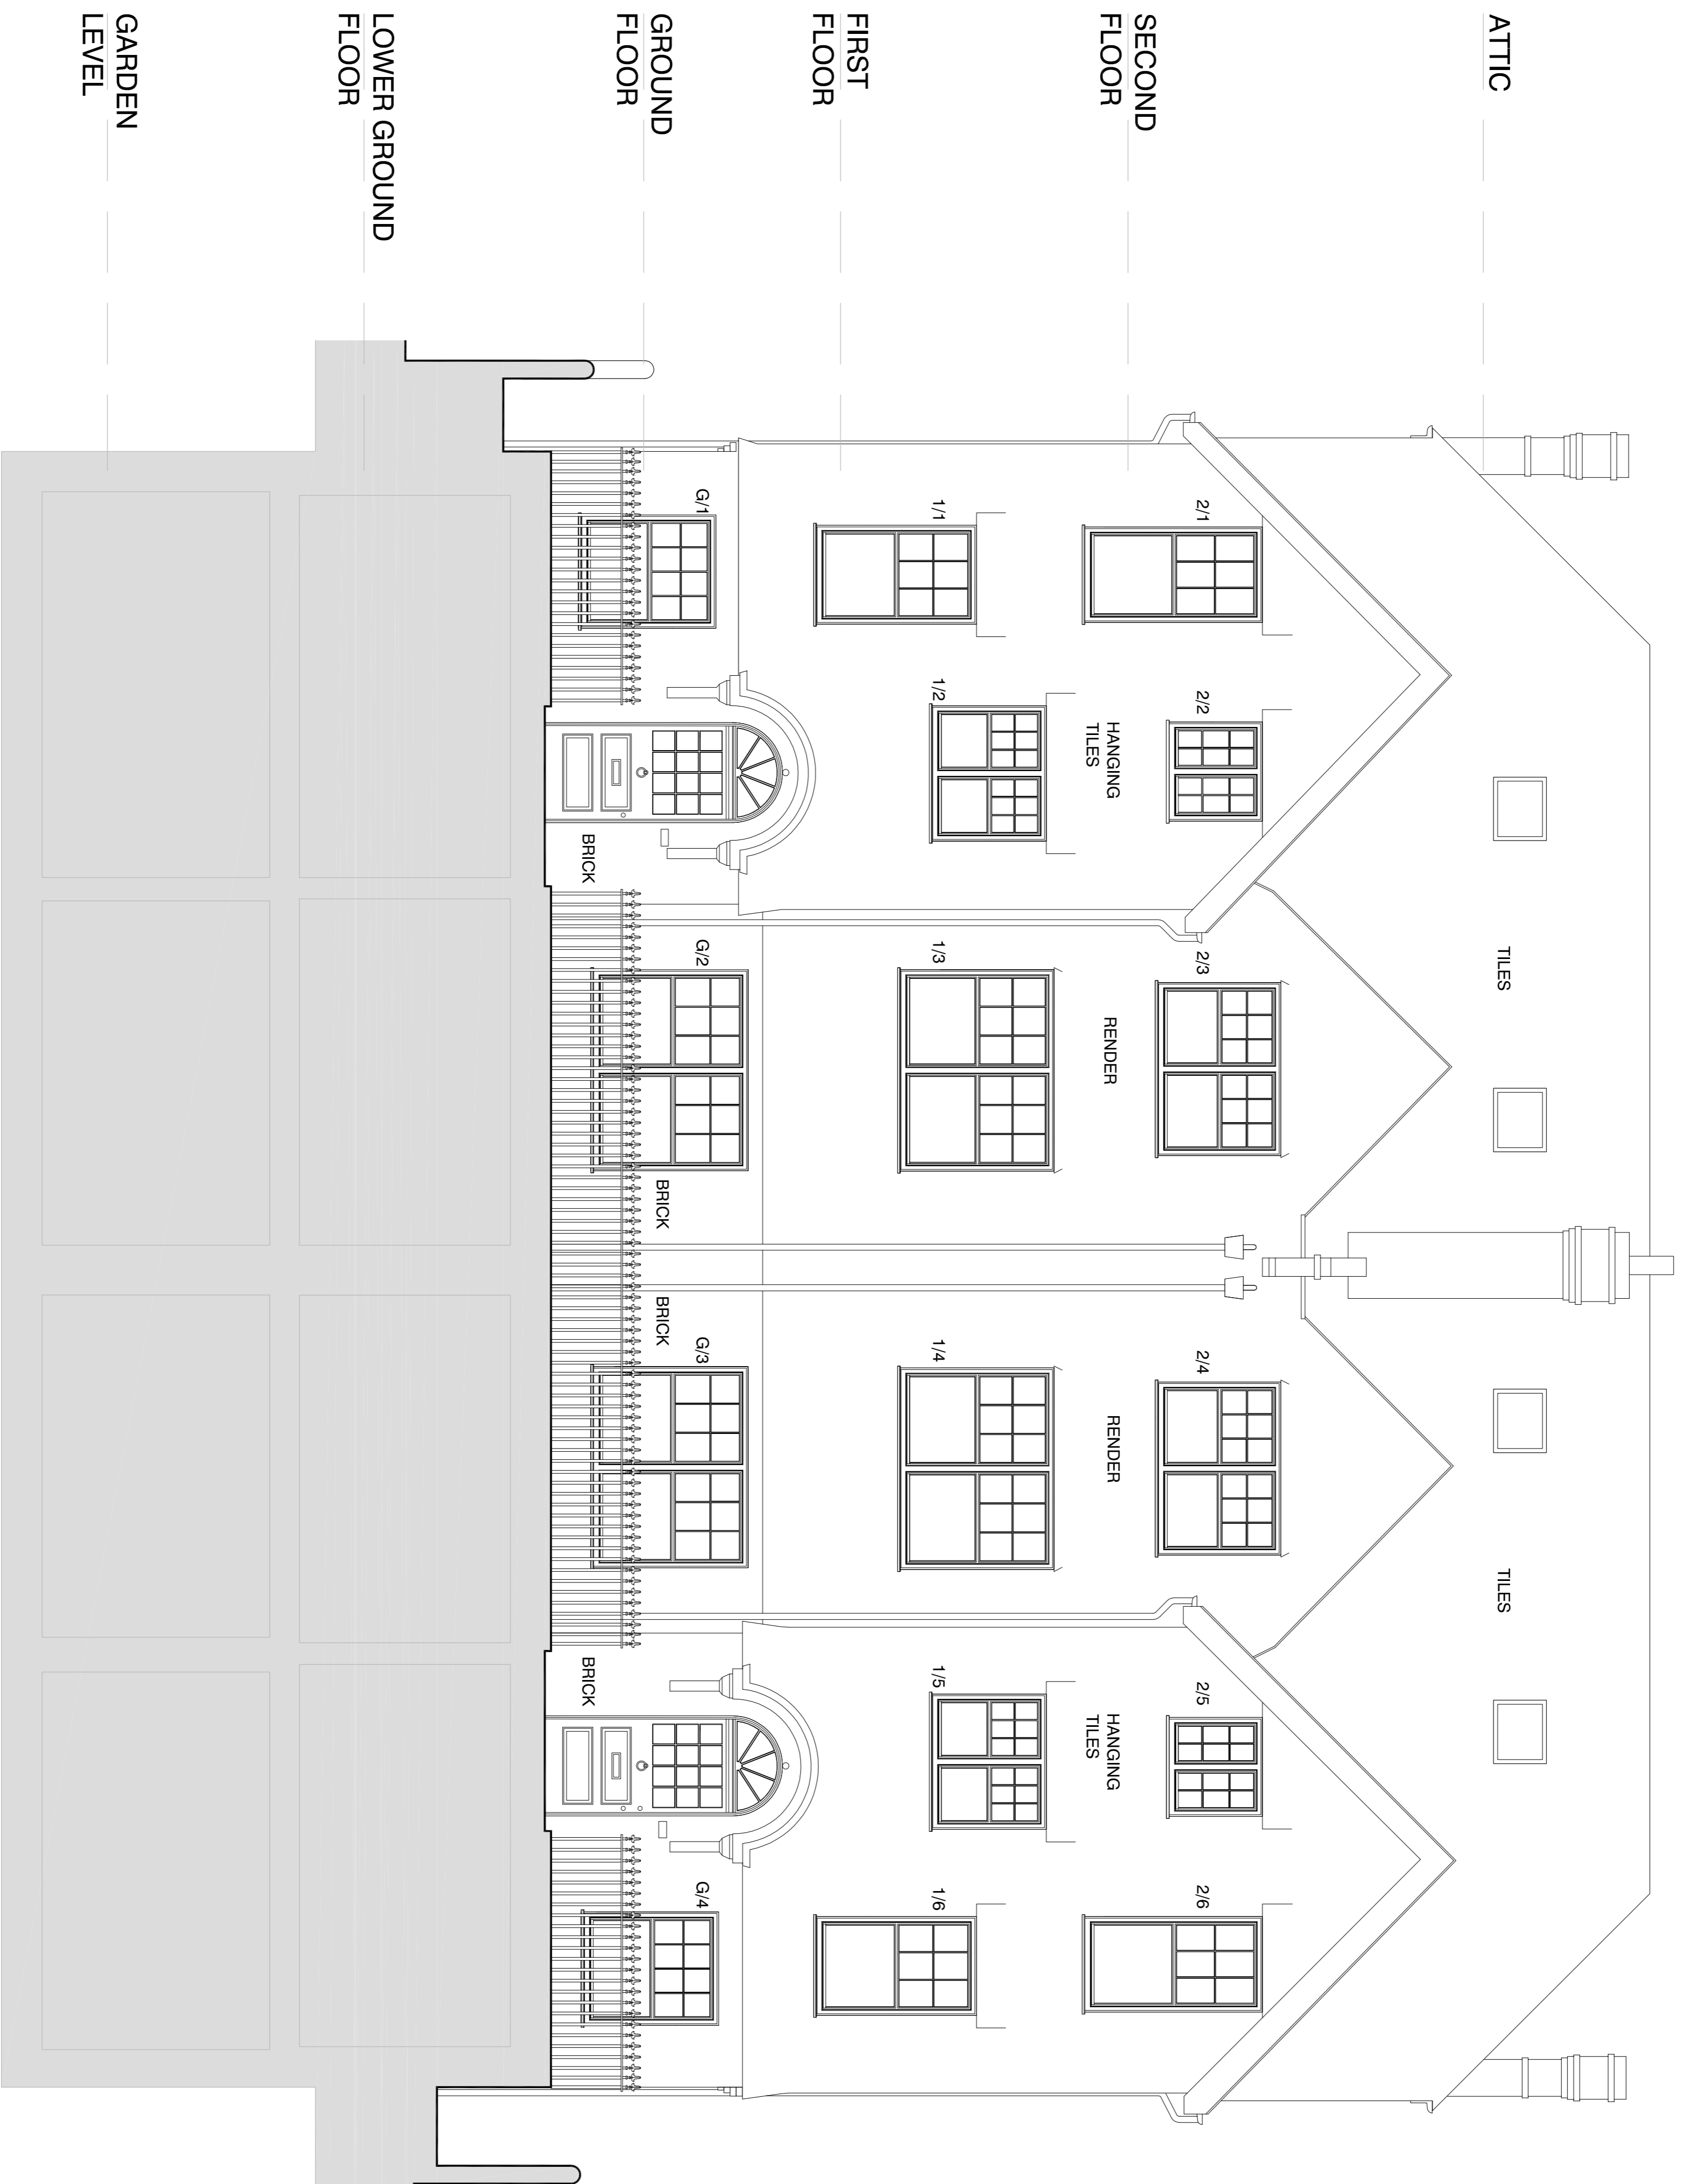

client: SHAKIB & Co
project

2082 29-30 LYNDHURST ROAD
ALTERATIONS TO: FENESTRATION OF FRONT
AND REAR FACADES, UPPER LEVEL DORMERS
TO REAR; RETENTION OF ROOF TERRACE,
RETAINING WALL AND OPENINGS AT LG AND
GARDEN LEVELS AS BUILT

D1100 - AS BUILT

rev:00
scale: 1:50 at A1
date: 13/07/2015

FRONT ELEVATION

CONSERVATION PD
planning + design

^a Phoenix Yard
65-69 Kings Cross Road
London WC1X 9LW
^t 020 7096 1504
^f 020 7504 1701
^e eleninakrri@conservationpd.com
^w www.conservationpd.co.uk