


NOTES

"As built" drawings are based on:

- (a) CAD files by KYSON, supplied by the client;
- (b) images of the existing / 'as built'.

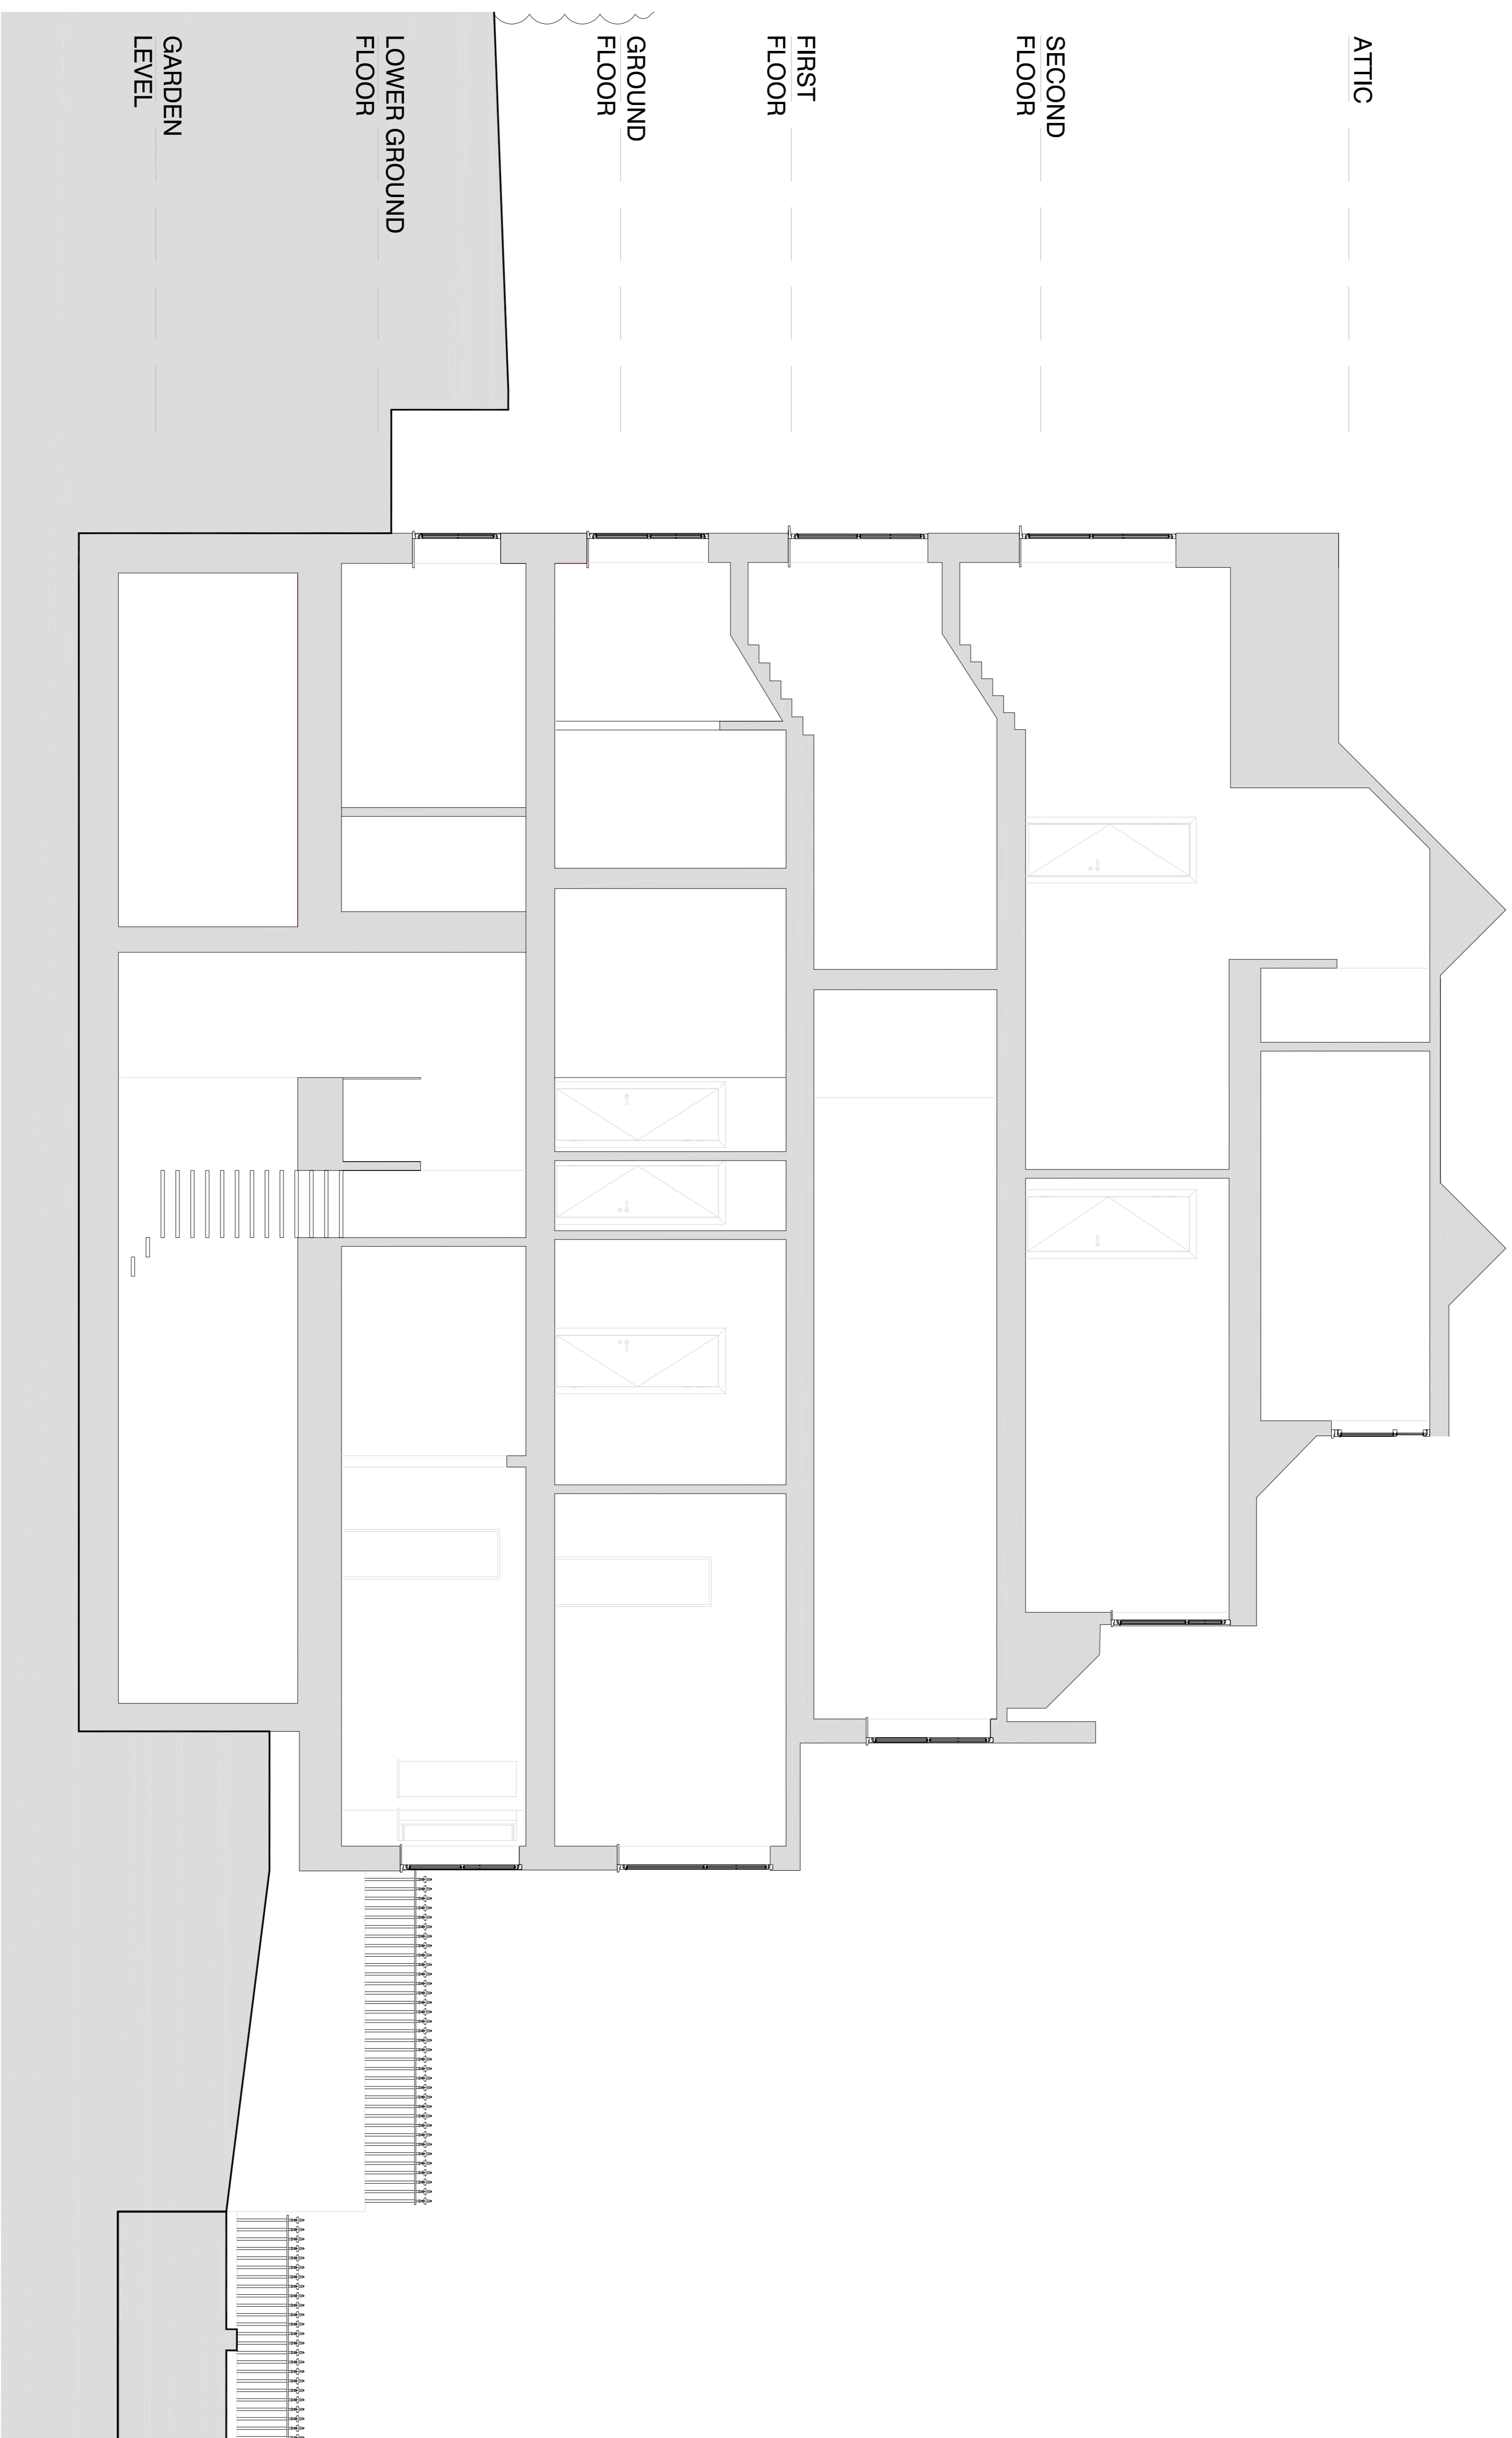

client: SHAKIB & Co
project
2082 29-30 LYNDHURST ROAD
ALTERATIONS TO: FENESTRATION OF FRONT
AND REAR FACADES, UPPER LEVEL DORMERS
TO REAR; RETENTION OF ROOF TERRACE,
RETAINING WALL AND OPENINGS AT LG AND
GARDEN LEVELS AS BUILT

D1130 - AS BUILT
rev:00
scale: 1:50 at A1
date: 13/01/2015

SECTION AA

CONSERVATION PD
planning + design

a Phoenix Yard
65-69 Kings Cross Road
London WC1X 9LW
t 020 7096 1504
f 020 7504 1701
e eleninakri@conservationpd.com
w www.conservationpd.co.uk