


## NOTES

"As built" drawings are based on:

- (a) CAD files by KYSSON, supplied by the client;
- (b) Images of the existing / 'as built'.

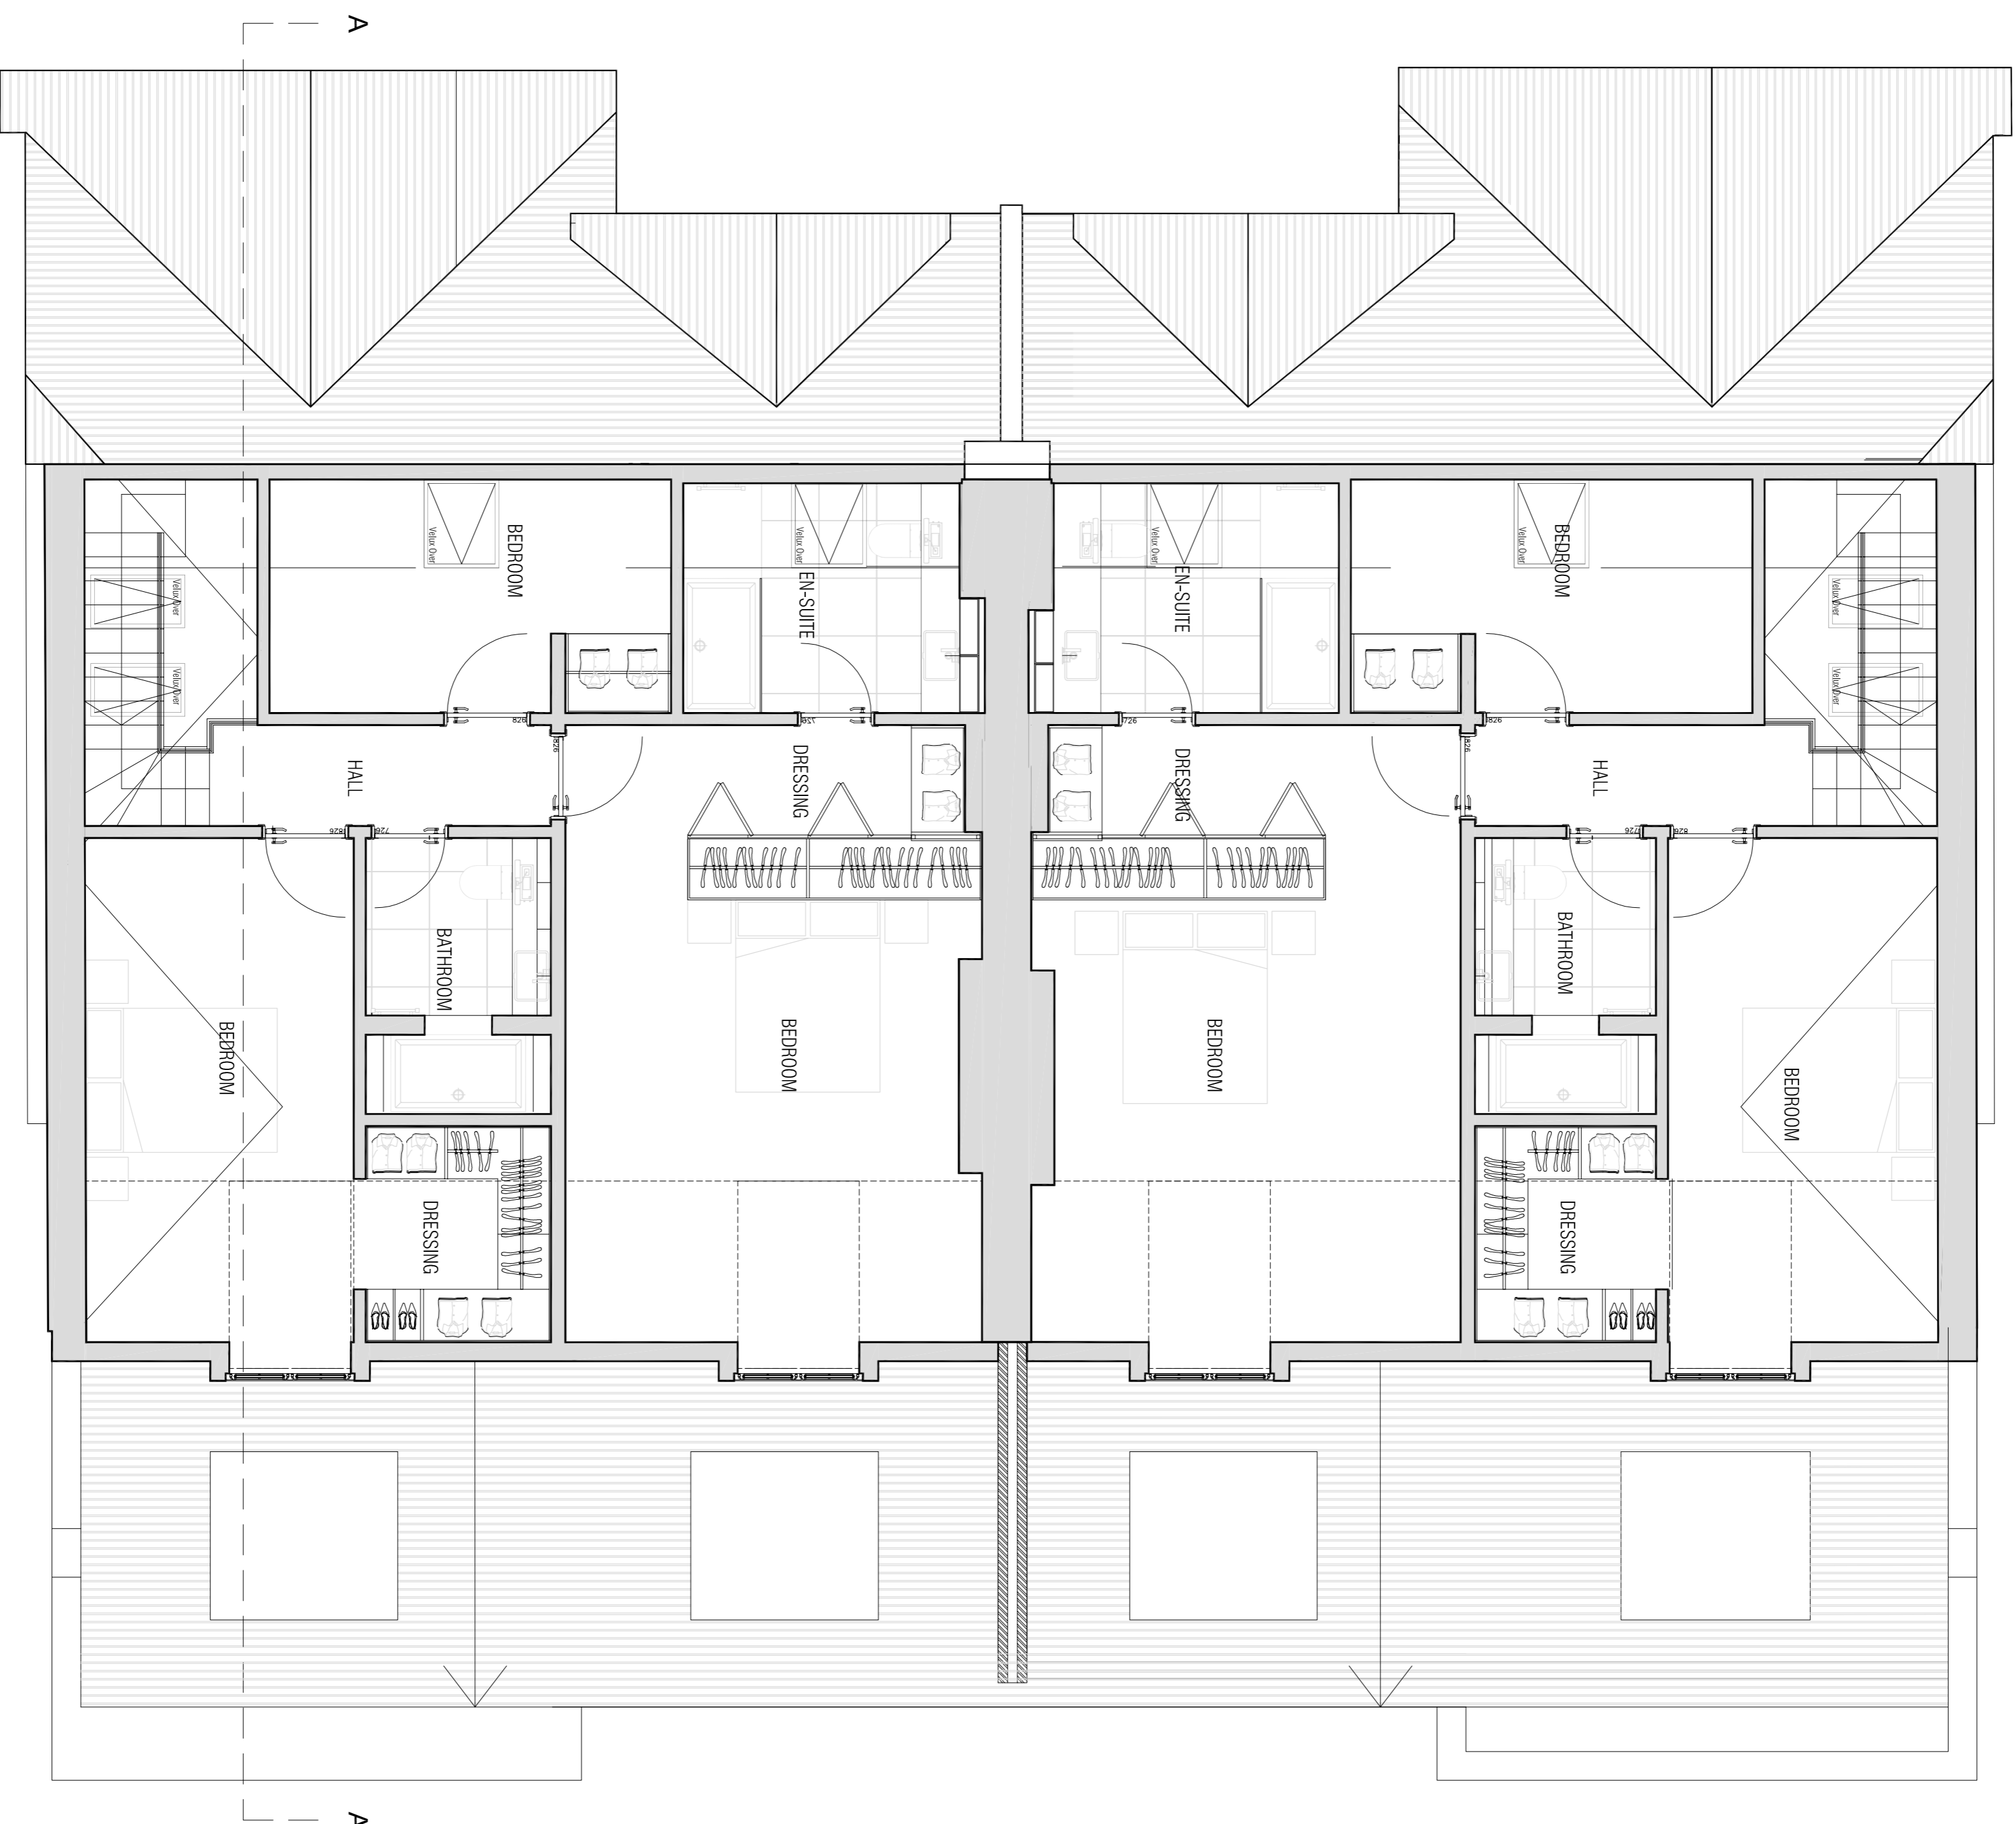

Attic Floor

**D1120 - AS BUILT**  
rev:00  
scale: 1:50 at A1  
date: 13/01/2015

## ATTIC PLAN

client: SHAKIB & Co  
project

**2082 29-30 LYNDRHURST ROAD**  
ALTERATIONS TO: FENESTRATION OF FRONT  
AND REAR FACADES, UPPER LEVEL DOMINERS  
TO REAR, RETENTION OF ROOF TERRACE,  
RETAINING WALL AND OPENINGS AT LG AND  
GARDEN LEVELS AS BUILT

**CONSERVATION PD**  
planning + design

a Phoenix Yard  
65-69 Kings Cross Road  
London WC1X 9LW  
t 020 7096 1504  
f 020 7504 1701  
e [elenimakri@conservationpd.com](mailto:elenimakri@conservationpd.com)  
w [www.conservationpd.co.uk](http://www.conservationpd.co.uk)