


Flat 24

Red lines indicate existing timber frame size

Replacement Aluminium windows
Elevation of unit + new details
Ground floor to 4th floor

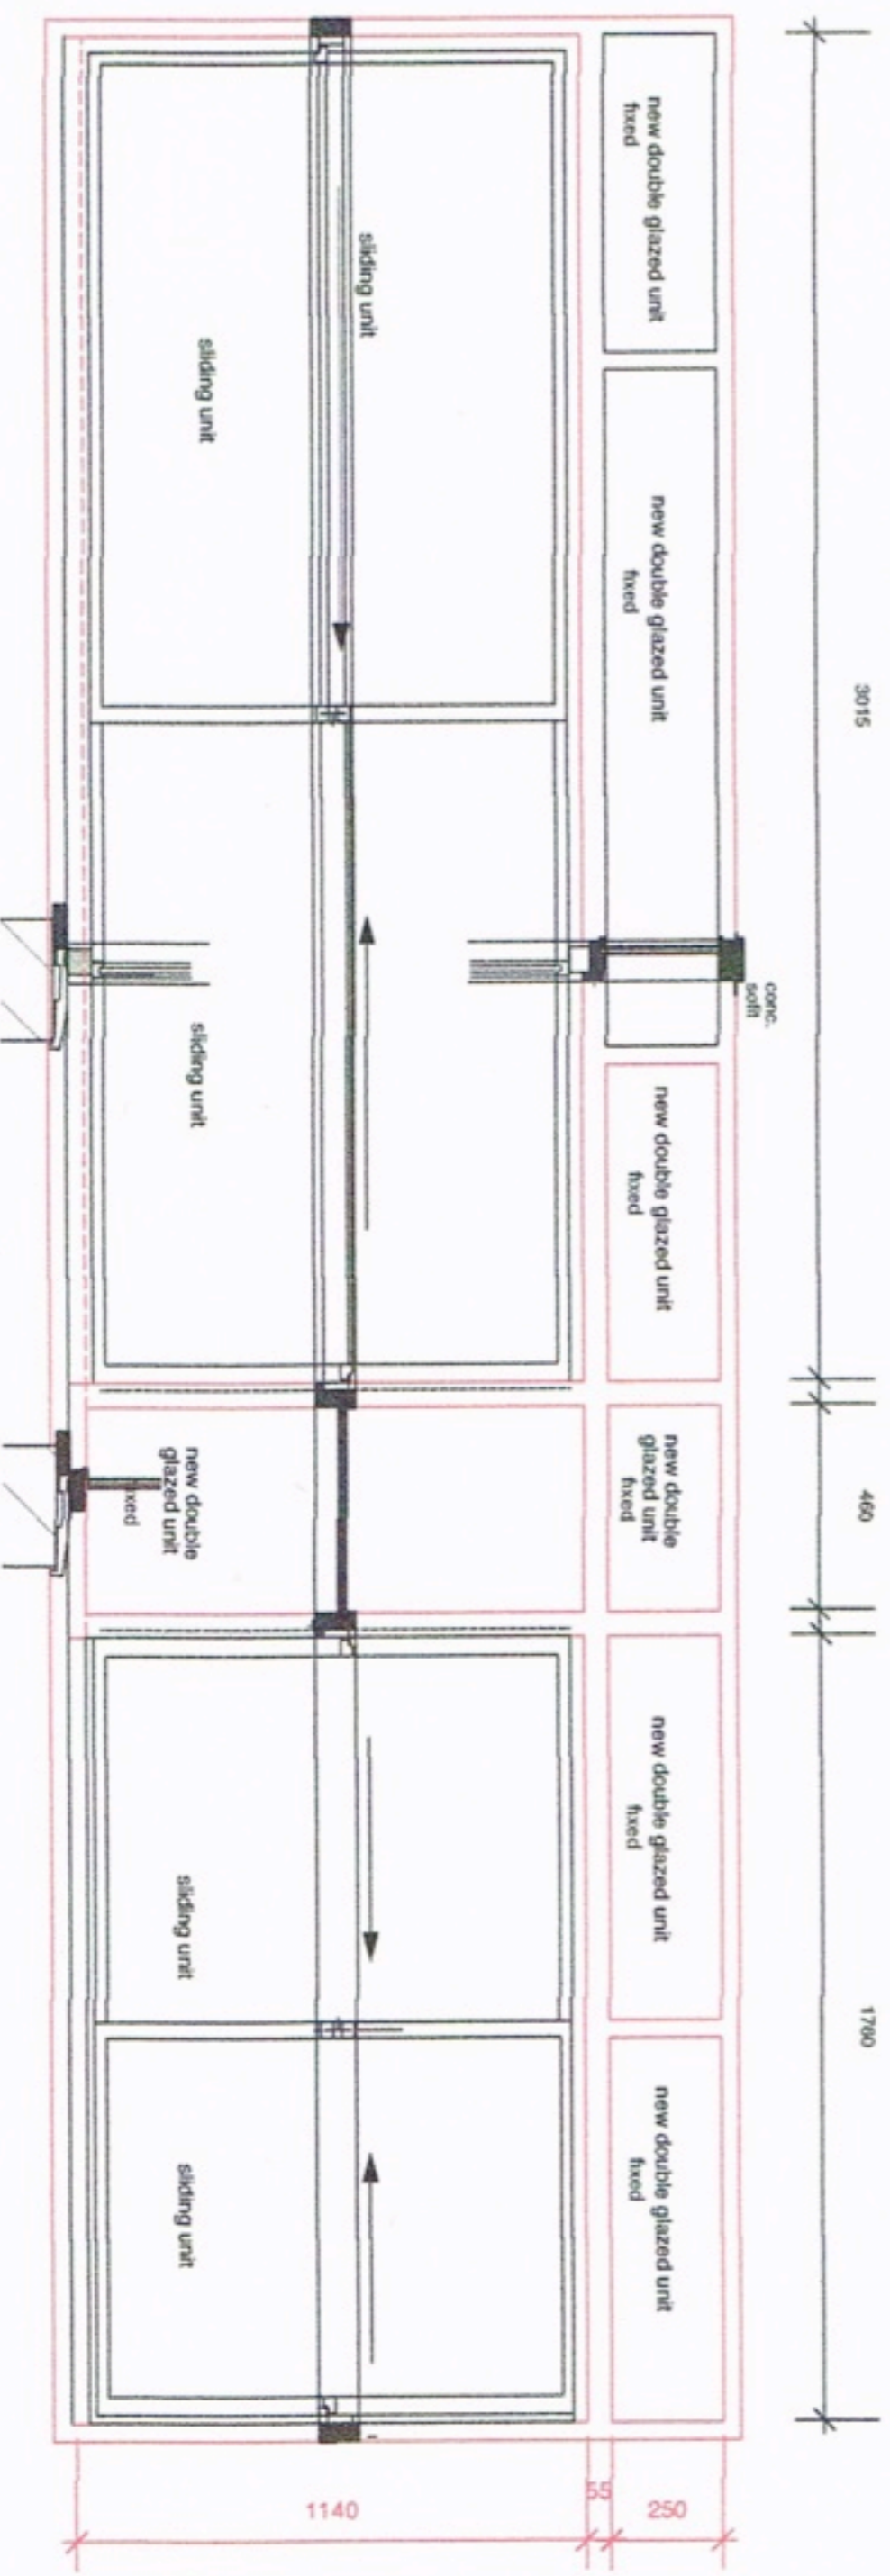

Flat 53

Red lines indicate existing timber frame size



Architects and Project Managers
S3 Romney Court
141 Haverstock Hill
London NW3 4HX
Tel: 020 7483 3979
Fax: 07770 450054
E Mail: tim.drewitt@btinternet.com

Romney Court
Haverstock Hill
London NW3

Rev C: Detail of windows from ground to 4th added July '14
Rev B: Duration Prime windows + alum. cil: May 14
Rev A: Duration Prime windows, May 14

Replacement Aluminium windows
Elevation of unit + new details
Ground to 5th floor

Scale: 1:20 @ A3
Date: May 2014

Drawg No: RCM/07/C