


DO NOT SCALE OFF THIS DRAWING
 ALL DIMENSIONS MUST BE CHECKED ON SITE
 INFORM THE ARCHITECT OF ANY DISCREPANCIES PRIOR TO CONSTRUCTION
 PLOT SIZE: A1
 PLOT FILE REF: 1764/004/F/208-p50
 X-REF FILES: ELEV-W

NOTES:

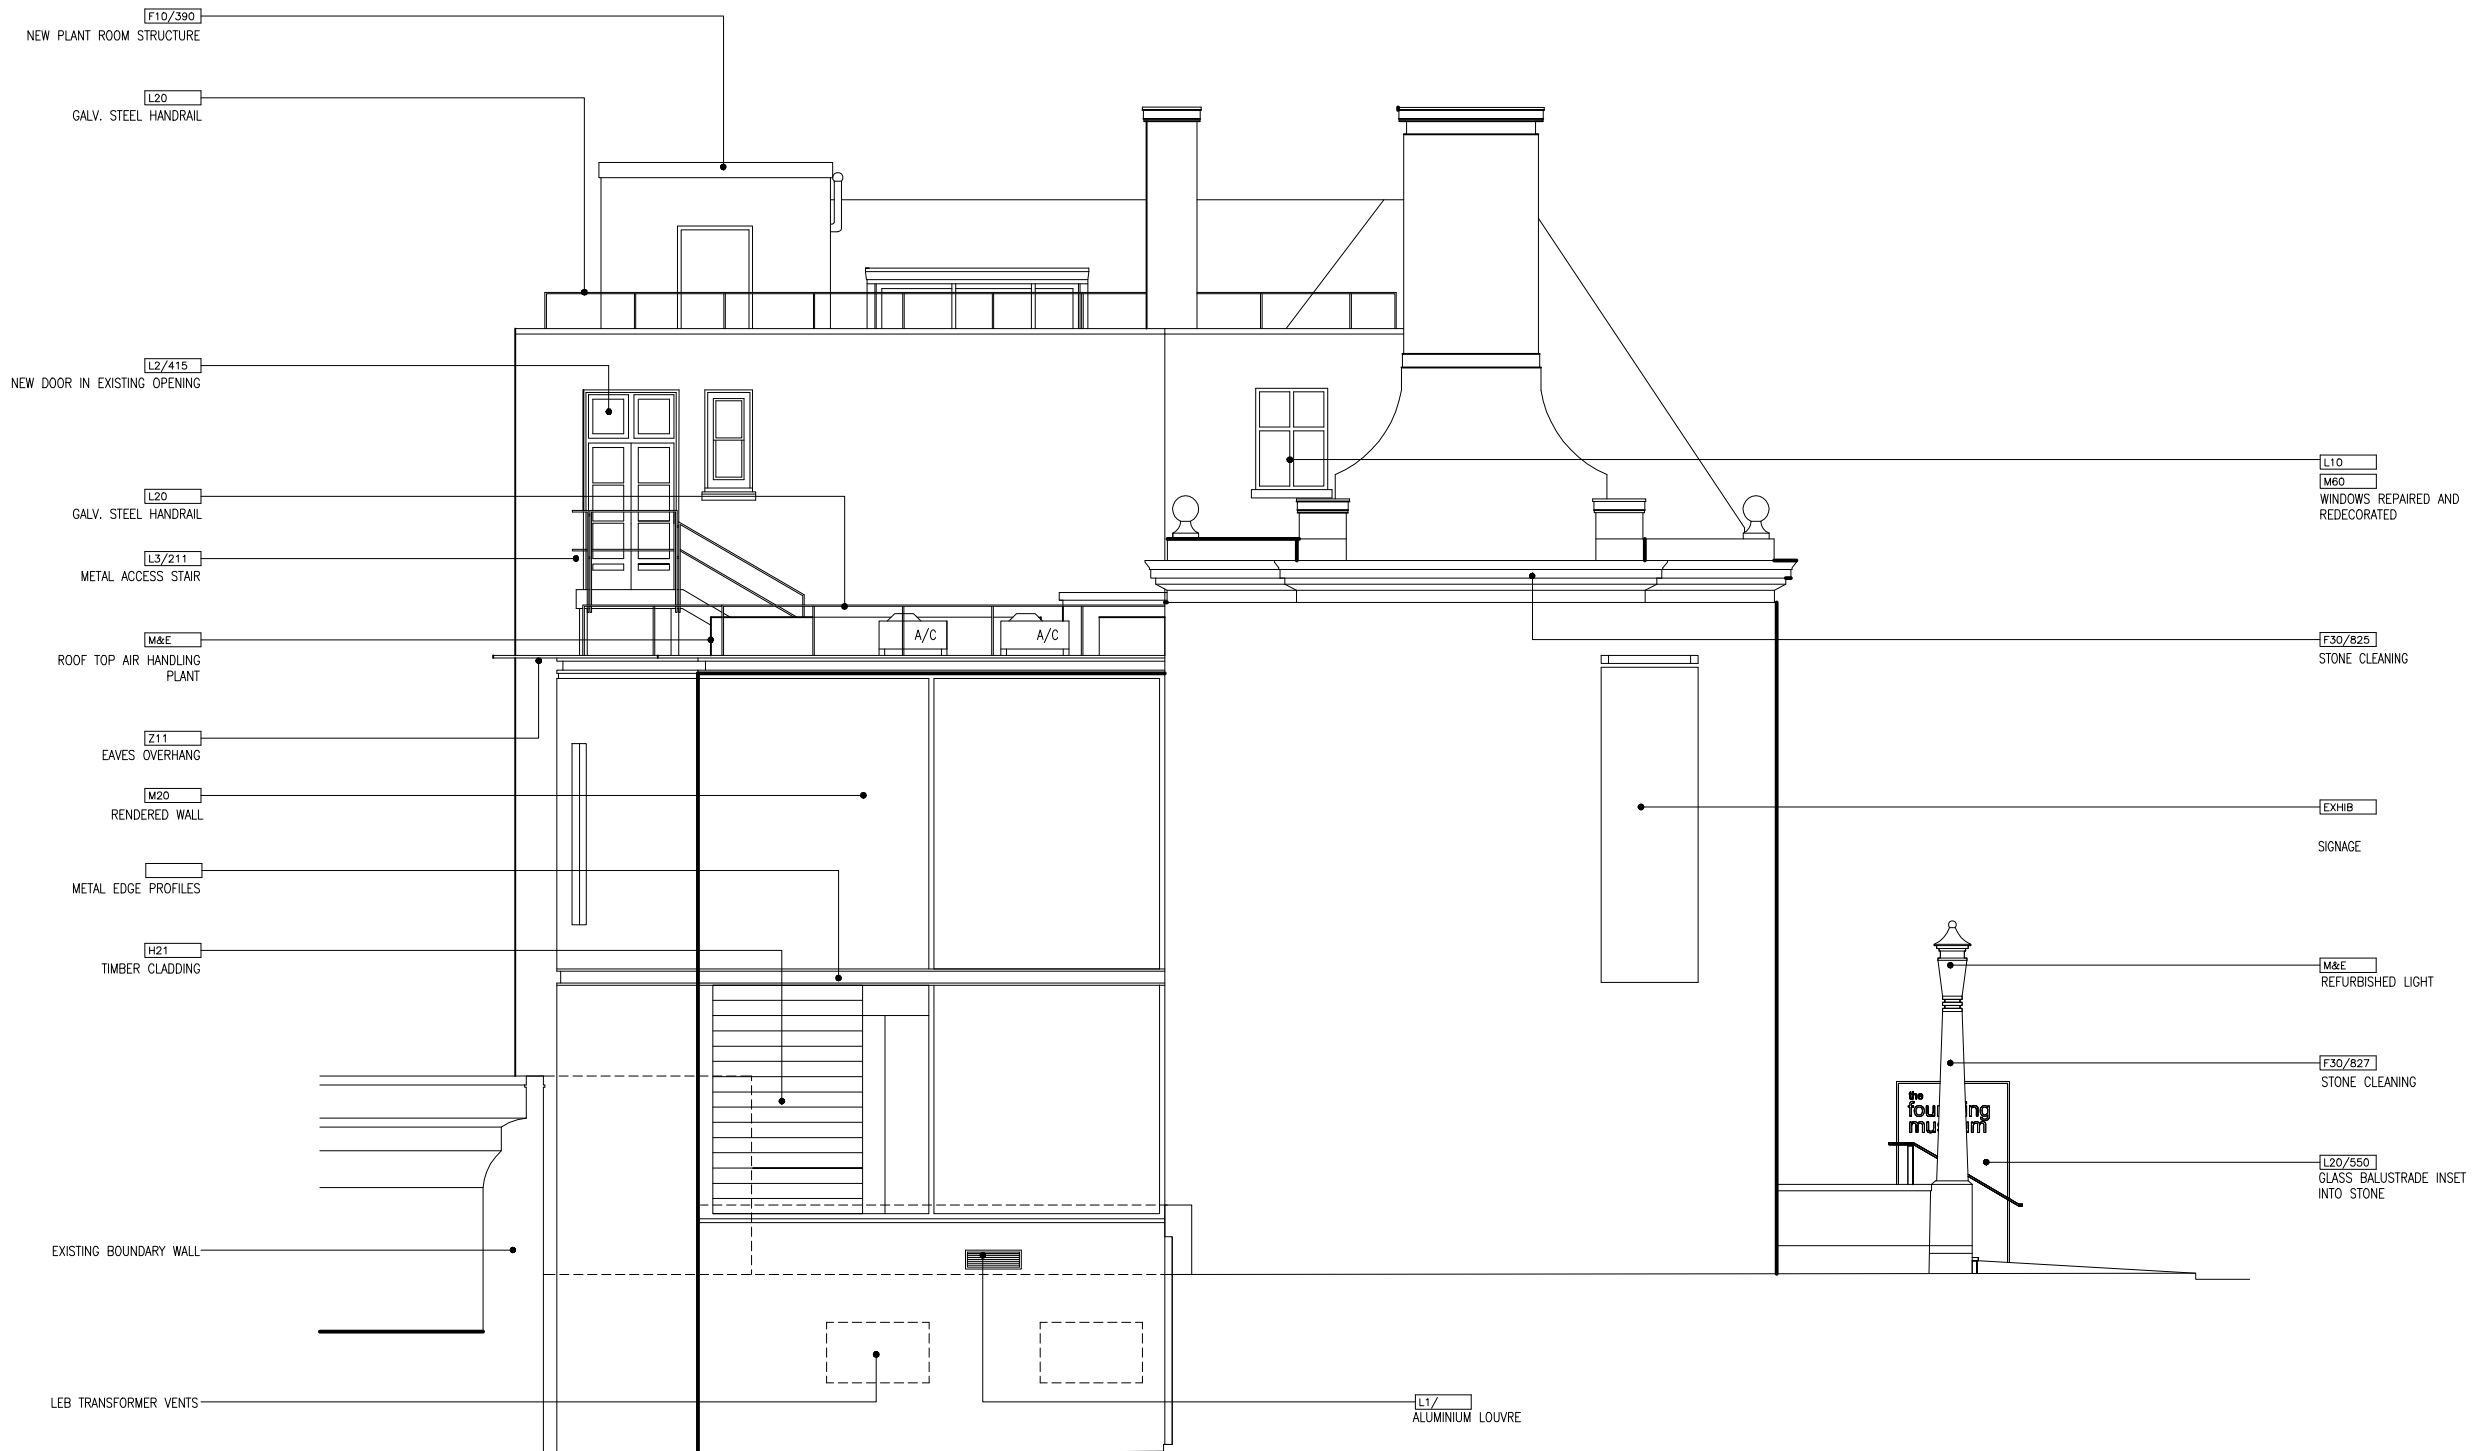

F	March 04	AS BUILT	DW	JH
E	15.07.03	CONST ISSUE UPDATE	DW	JH
D	06.05.03	PLANNING	DW	JH
C	02.05.03	CONSTRUCTION ISSUE	DW	JH
B	18.03.03	UPDATE	DW	JH
A	20.01.03	TENDER	CJM	DW
REVISED	DATE	COMMENTS	BY	CHKD

JESTICO+WHILES

1 Cobourg Street, London NW1 2HP
 Tel: 020 7380 0382 Fax: 020 7380 0511
 E mail: jw@jesticoandwhiles.co.uk
 ARCHITECTS LONDON + PRAGUE + MUNICH

JOB: THE FOUNDLING MUSEUM
 40 BRUNSWICK SQUARE, LONDON

CLIENT: THE BOARD OF TRUSTEES
 THE FOUNDLING MUSEUM

SCALE: 1:50 @A1; 1:100 @A3 DATE: DECEMBER 2002

DRAWN: CS CHECKED: JH

TITLE: PROPOSED
 WEST ELEVATION

DRAWING NO: 1764/208 REV F

PREVIOUSLY DRAWING 1764/059

WEST ELEVATION - PROPOSED
 1:50