




Section A-A as Proposed, Scale 1:10

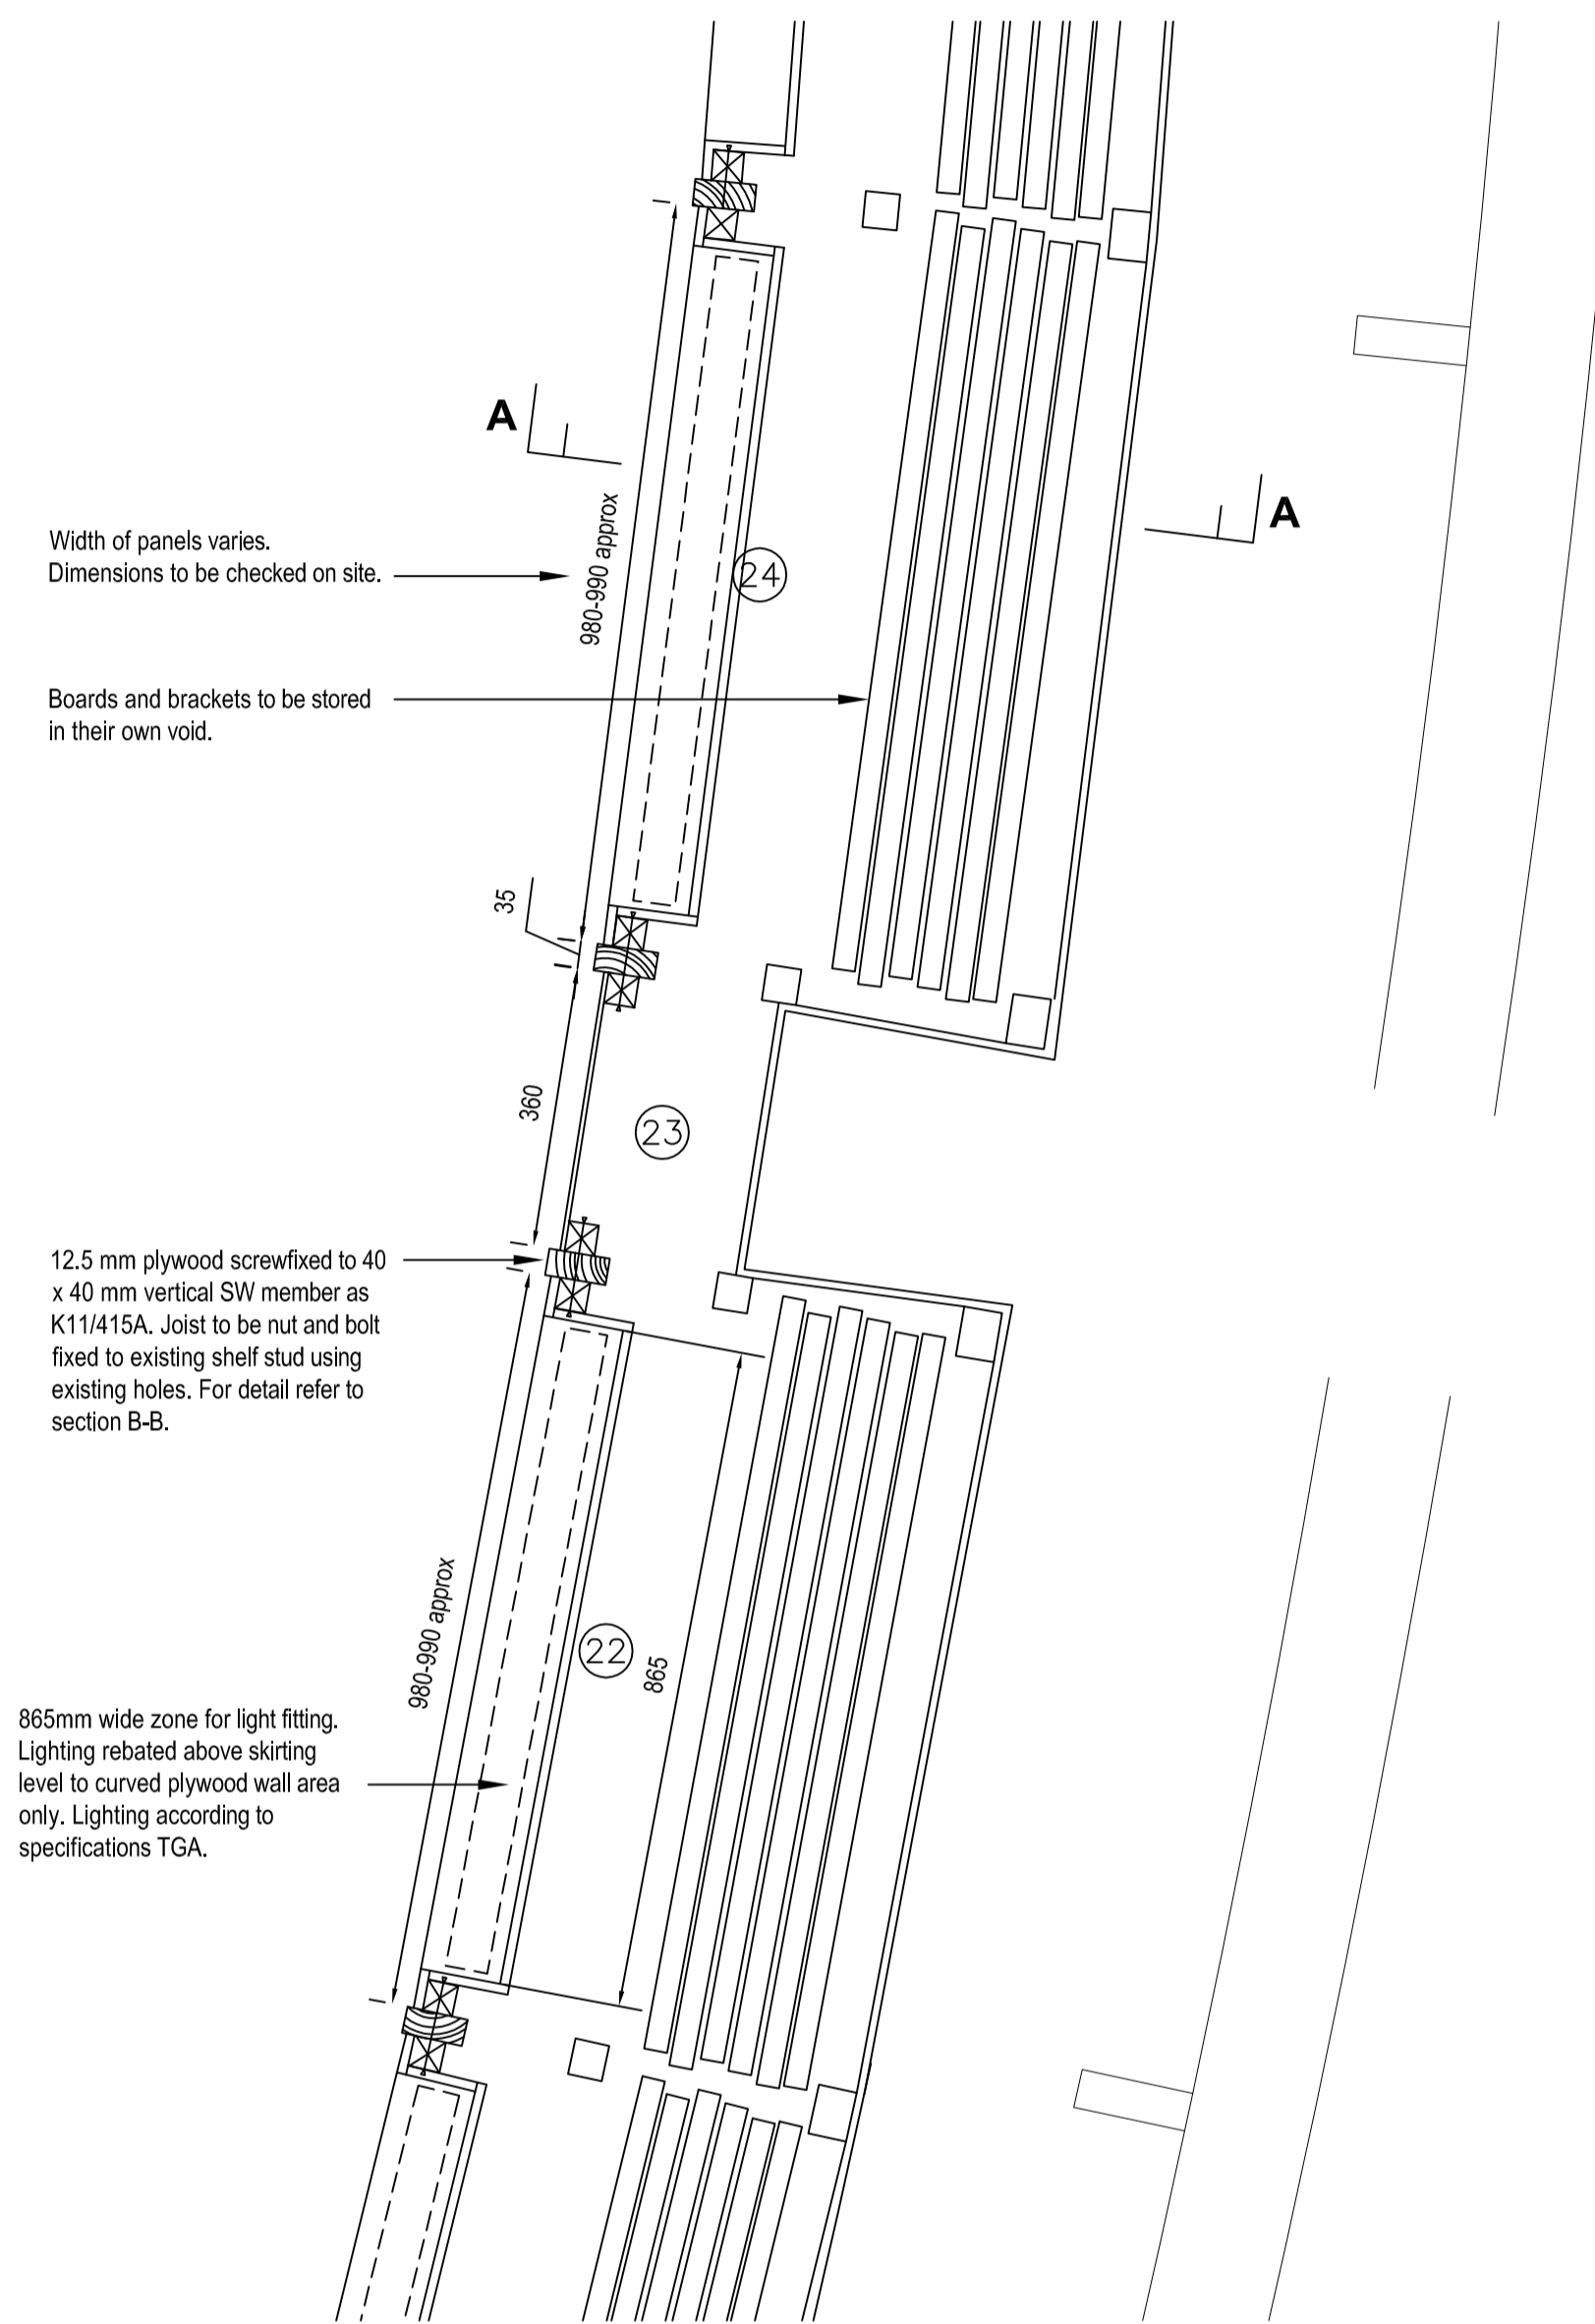

Extract from Floor Plan, Scale 1:10

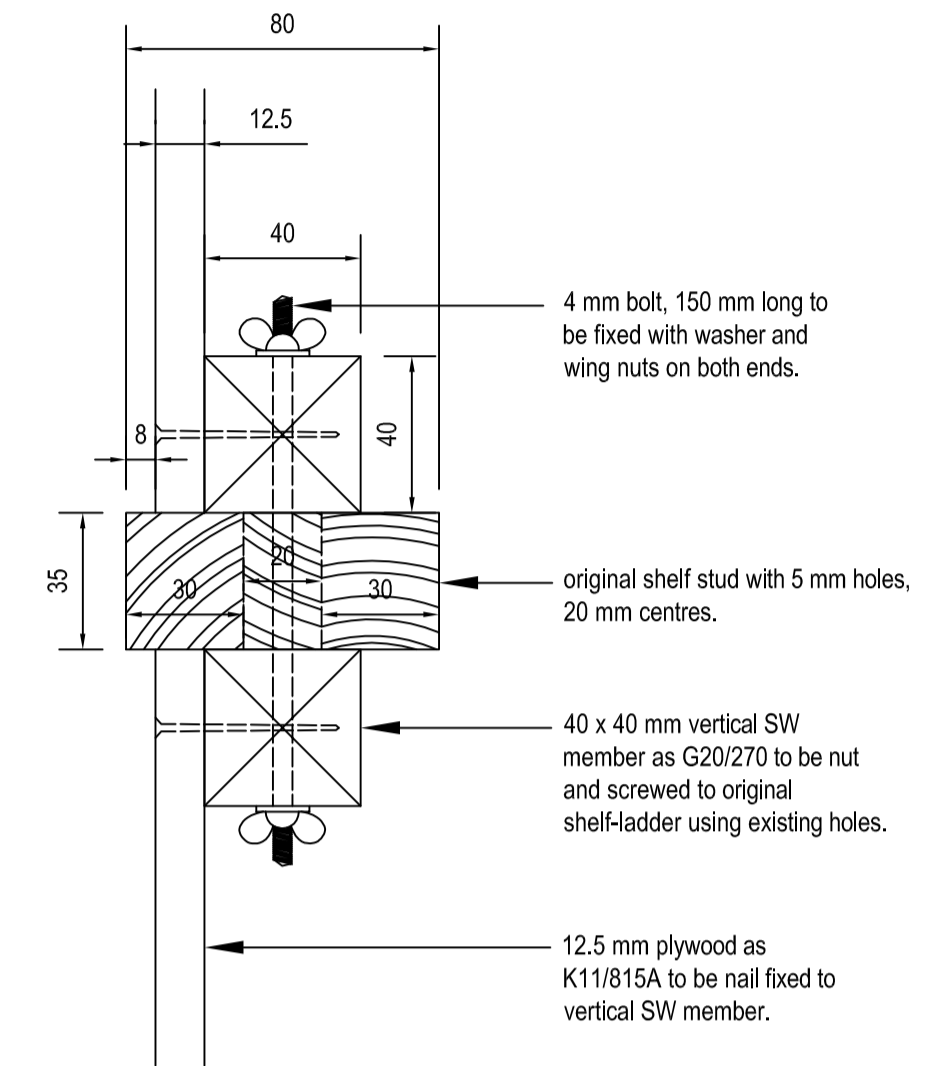

Section B-B, Scale 1:2

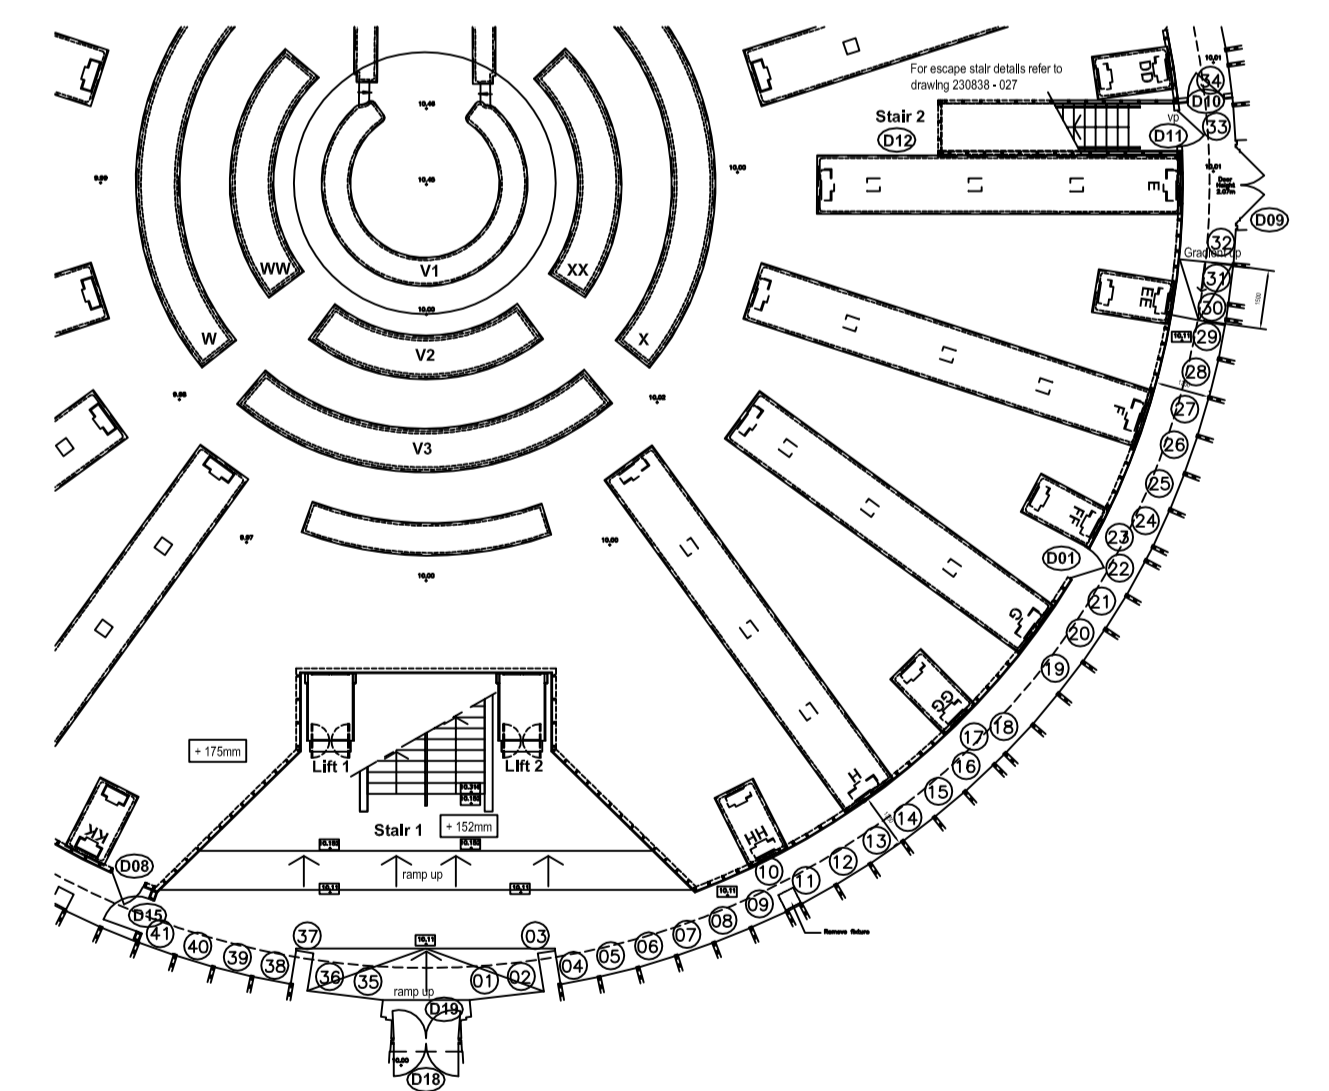

Extract Existing Ground Floor Plan, Scale 1:200

AS BUILT RECORD DRAWING

REVISION	DATE	DRAWN	CHECKED	DESCRIPTION
D	02.08.07	SP	SP	Issue of As Built Record Drawing
C	21.02.07	ML	SS	Revision to lighting within bookshelves
B	24.01.07	SP	SS	Revision to lighting within bookshelves

CLIENT	SCALE	DATE
British Museum	1:10	October 2006
PROJECT	DRAWN	CHECKED
British Museum RRR	SP	SP
DRAWING TITLE	JOB NUMBER	REVISION
Bookshelf protection (entrance corridor only)	230838	011

THE CLOVE BUILDING, MAGUIRE STREET, BUTLERS WHARF, LONDON, SE1 2ND. TEL 020 7397 7171. FAX 020 7397 7172. PURCELL MILLER TRITTON LLP IS A LIMITED LIABILITY PARTNERSHIP REGISTERED IN ENGLAND AND WALES. REGISTERED NUMBER OC110269. REGISTERED OFFICE 1 COLLEGE, NORWICH, NORFOLK, NR1 1BN. WWW.PMT.CO.UK

General notes

shelf nos.	panel size h x w	note
1-3, 35-37	as site dims	existing glass screen to be carefully removed and safely stored. Shelves removed and ply panel protection installed as shown on this drawing.
4 - 9, 11 - 14, 38-41	2320 x 980-990*	existing glass screen to be carefully removed and safely stored. Shelves removed and ply panel protection installed as shown on this drawing.
15, 16, 18 - 22, 24 - 29	2320 x 980-990*	shelves removed and ply panel protection installed as shown on this drawing.
17, 23, 30	2320 x 360	shelves removed and ply panel protection installed as shown on this drawing.
32-34	as site dims	shelves removed and ply panel protection installed as shown on this drawing.

* width varies, dimensions to be checked on site.

Skirting lighting to be located in bays 1-2, 4-9, 11-16, 18, 19-22, 24-29, 31-33, 35-36, 38-41.